


Pine- Intersection of Stockman

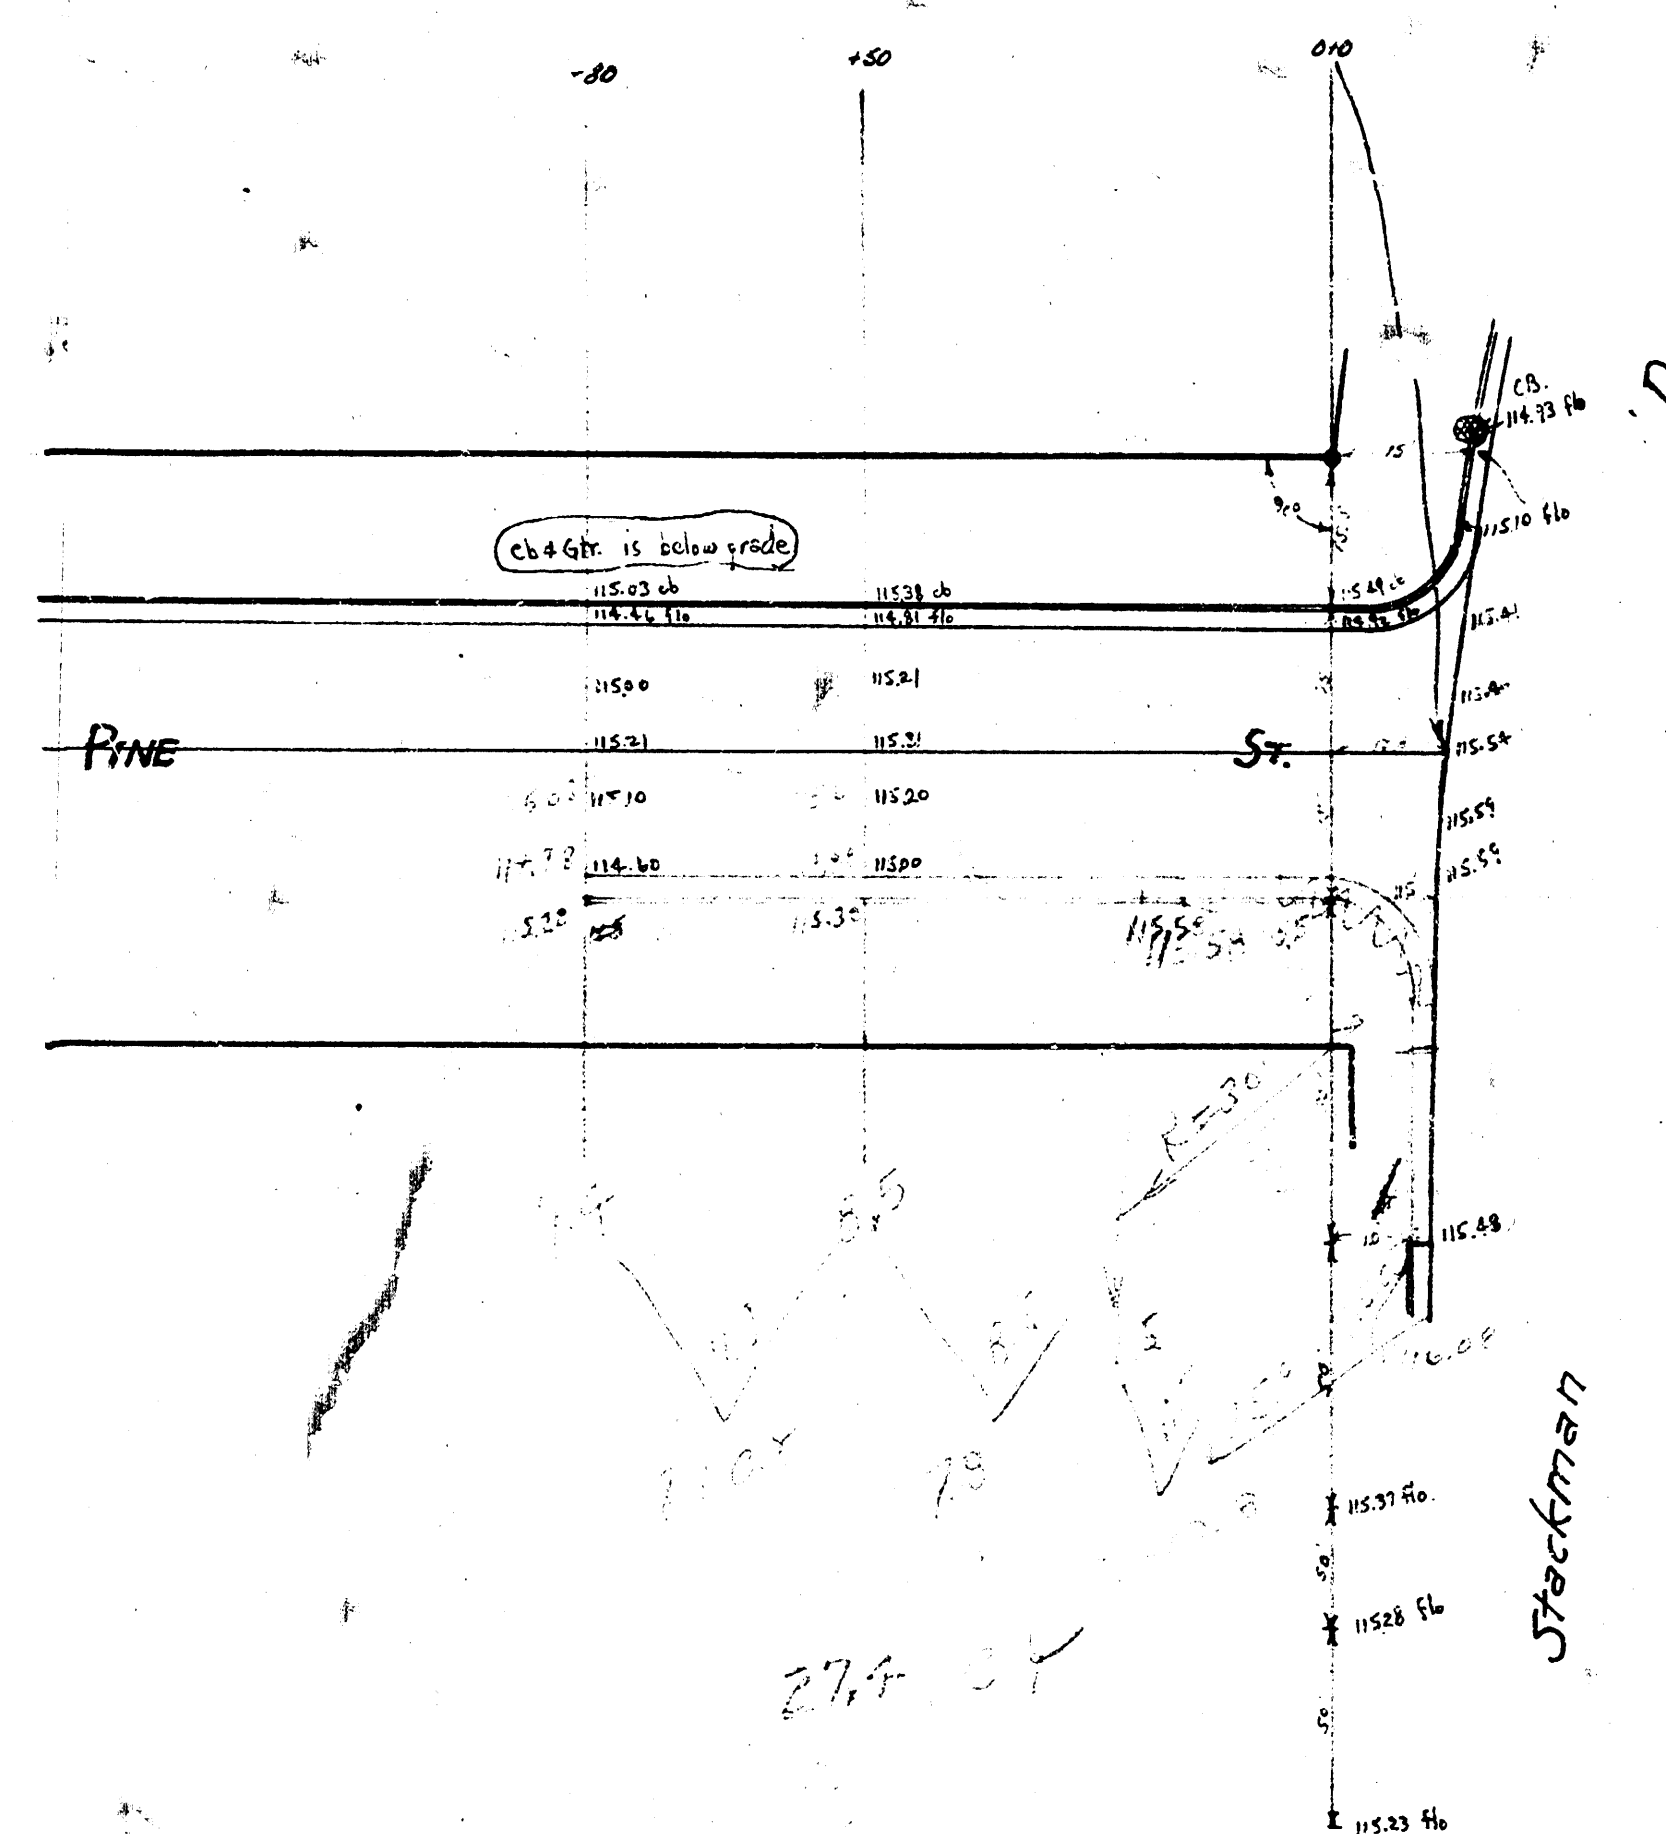

BM Elev 115.70 1/2" on walk @ curb NW cor
Stockman Dr. & Pine