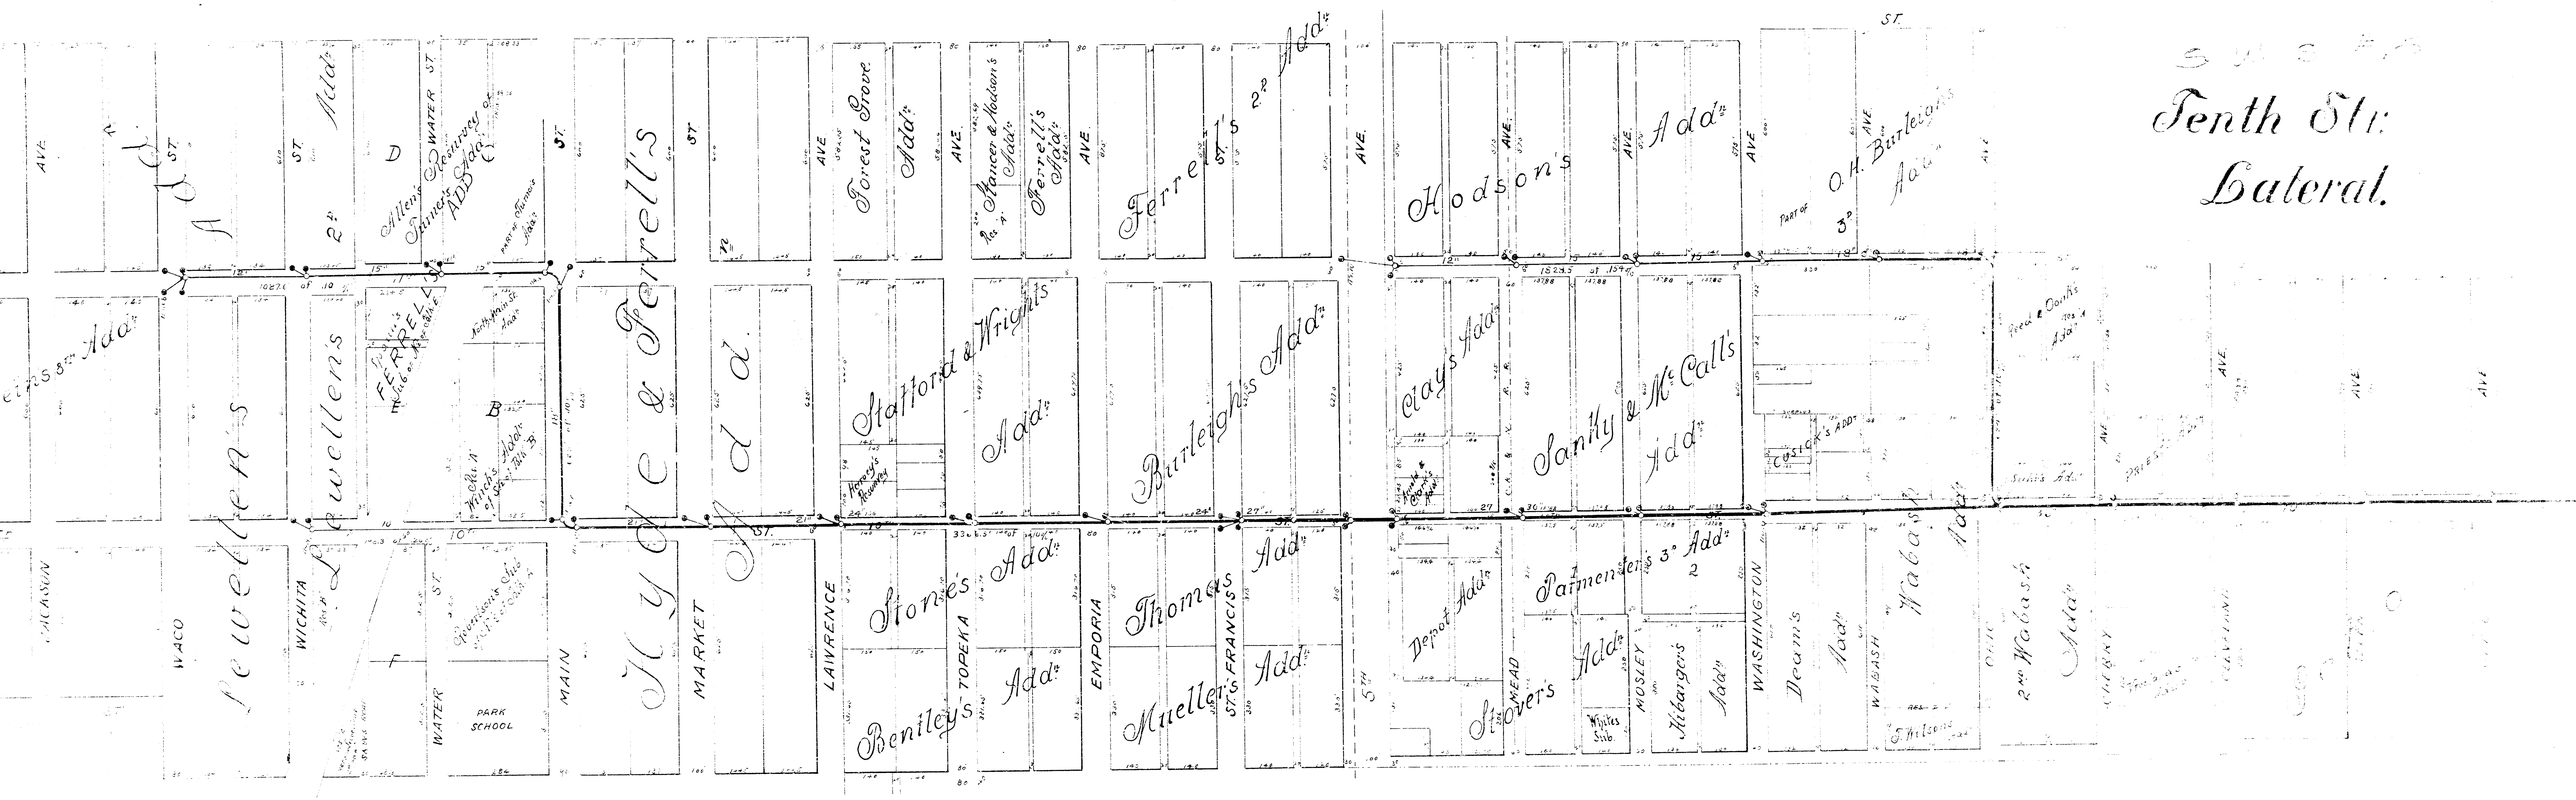Tenth St. Lateral.