

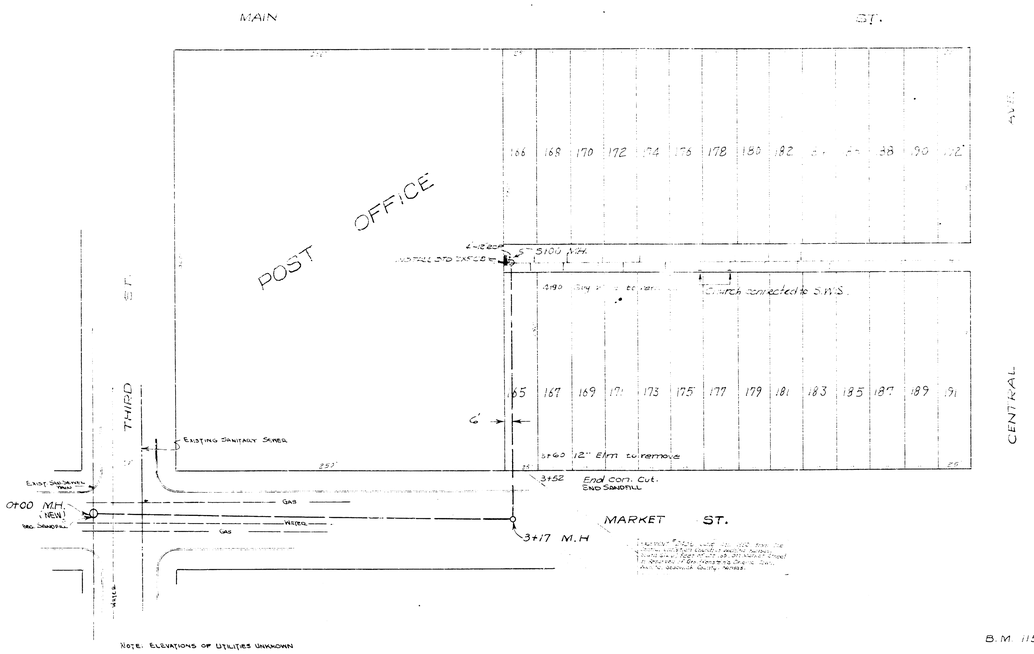


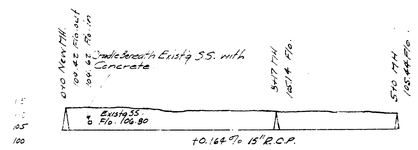



B.M. 115.25 X on Capping N. end Alley N. P.L. of P.O.

RECONSTRUCTION OF STORM WATER SEWER #7-A

CITY OF WICHITA, KANSAS
L.K. WHITE · CITY ENGINEER
DATE: 12-15-49 PROJ. NO.

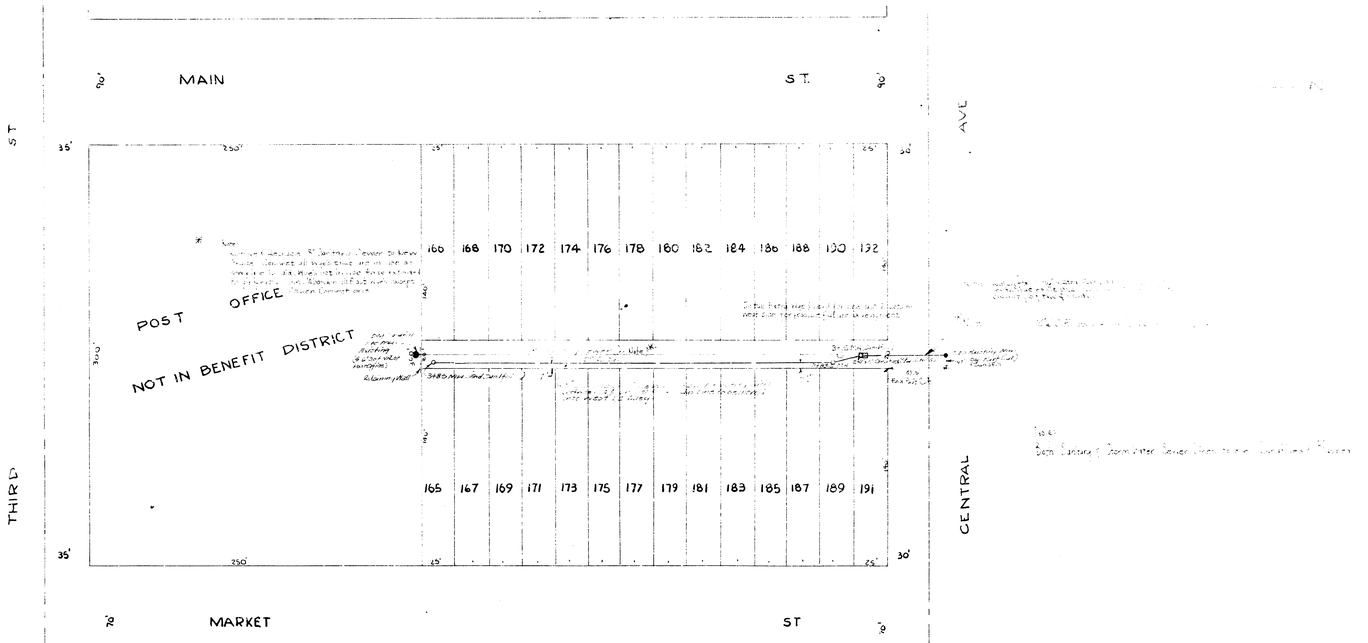

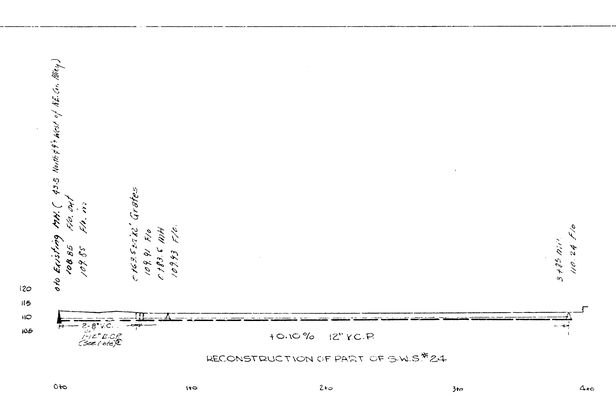

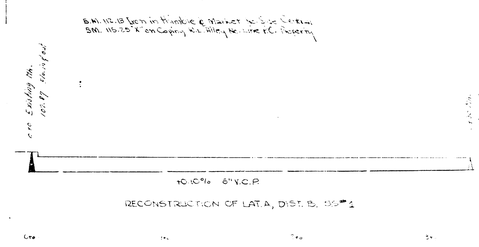

RECONSTRUCTION OF LAT. A, DIST. B, S.S.#1
RECONSTRUCTION OF PART OF S.W.S.#24
CITY of WICHITA, KANSAS

L.K. WHITE — CITY ENGINEER
JUNE 1949 — PROJ. NO. C-29-11