




STORM WATER SEWER NO. 30

WICHITA, KANSAS



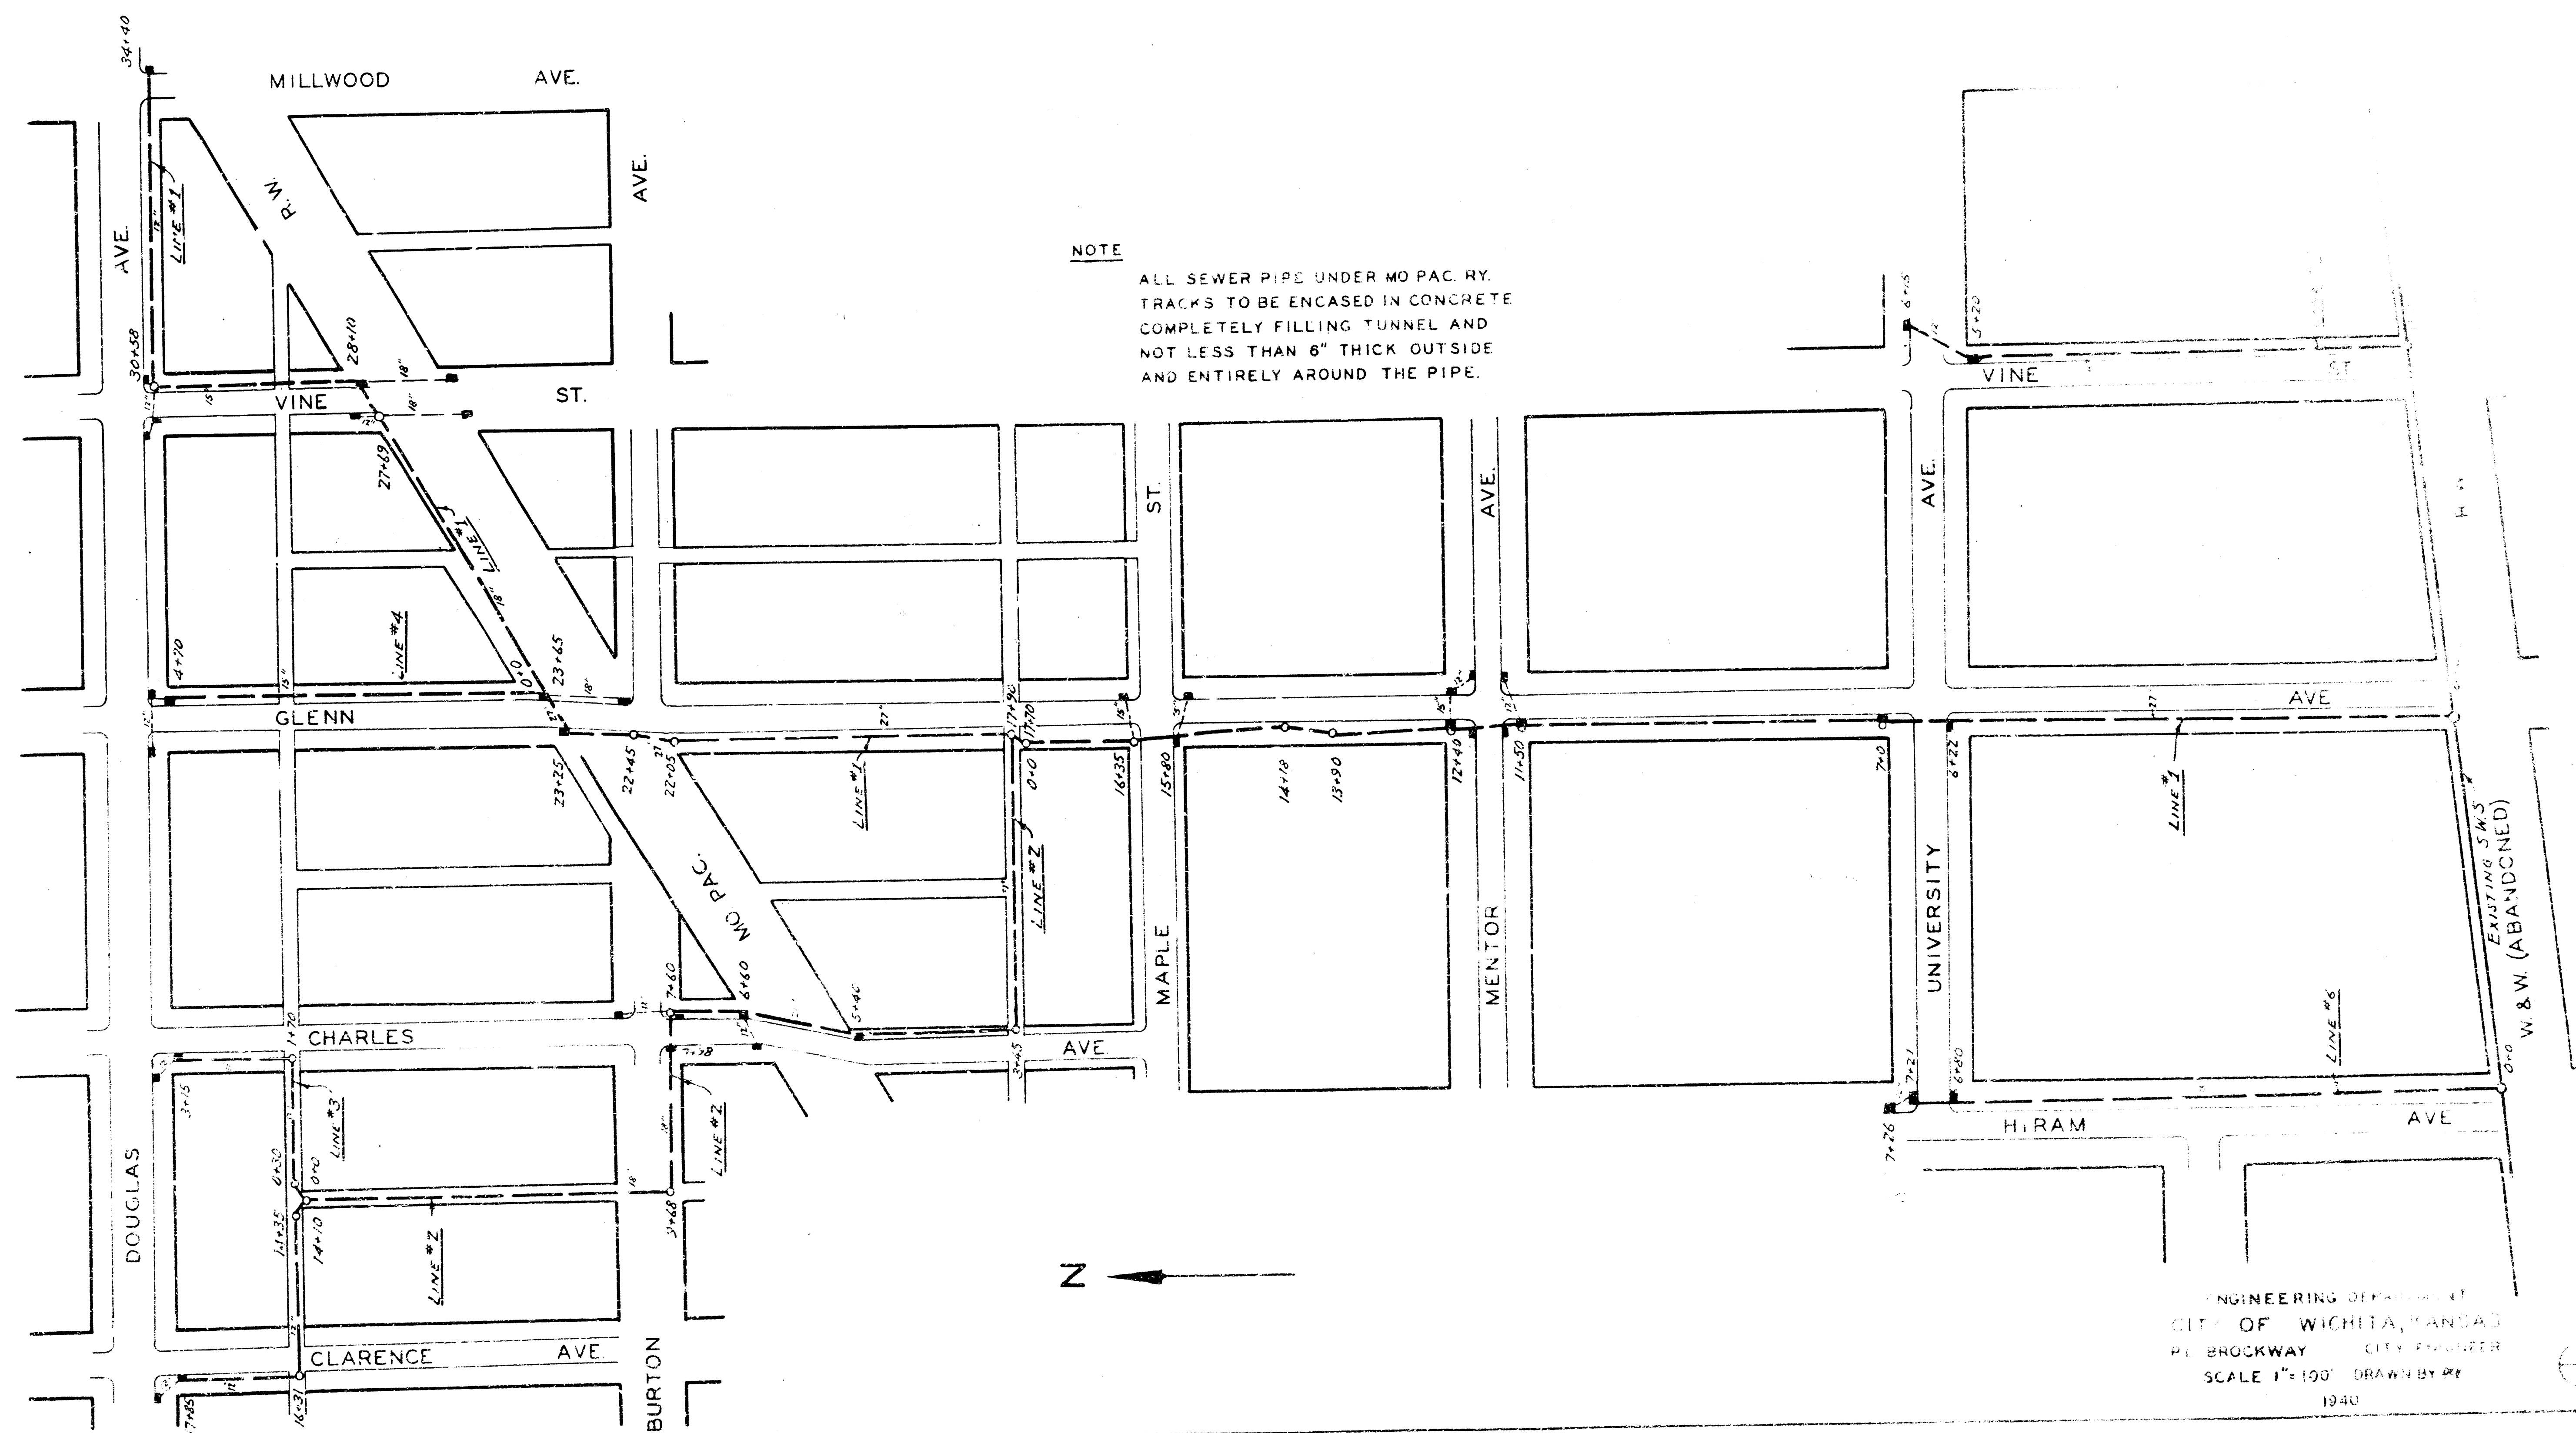


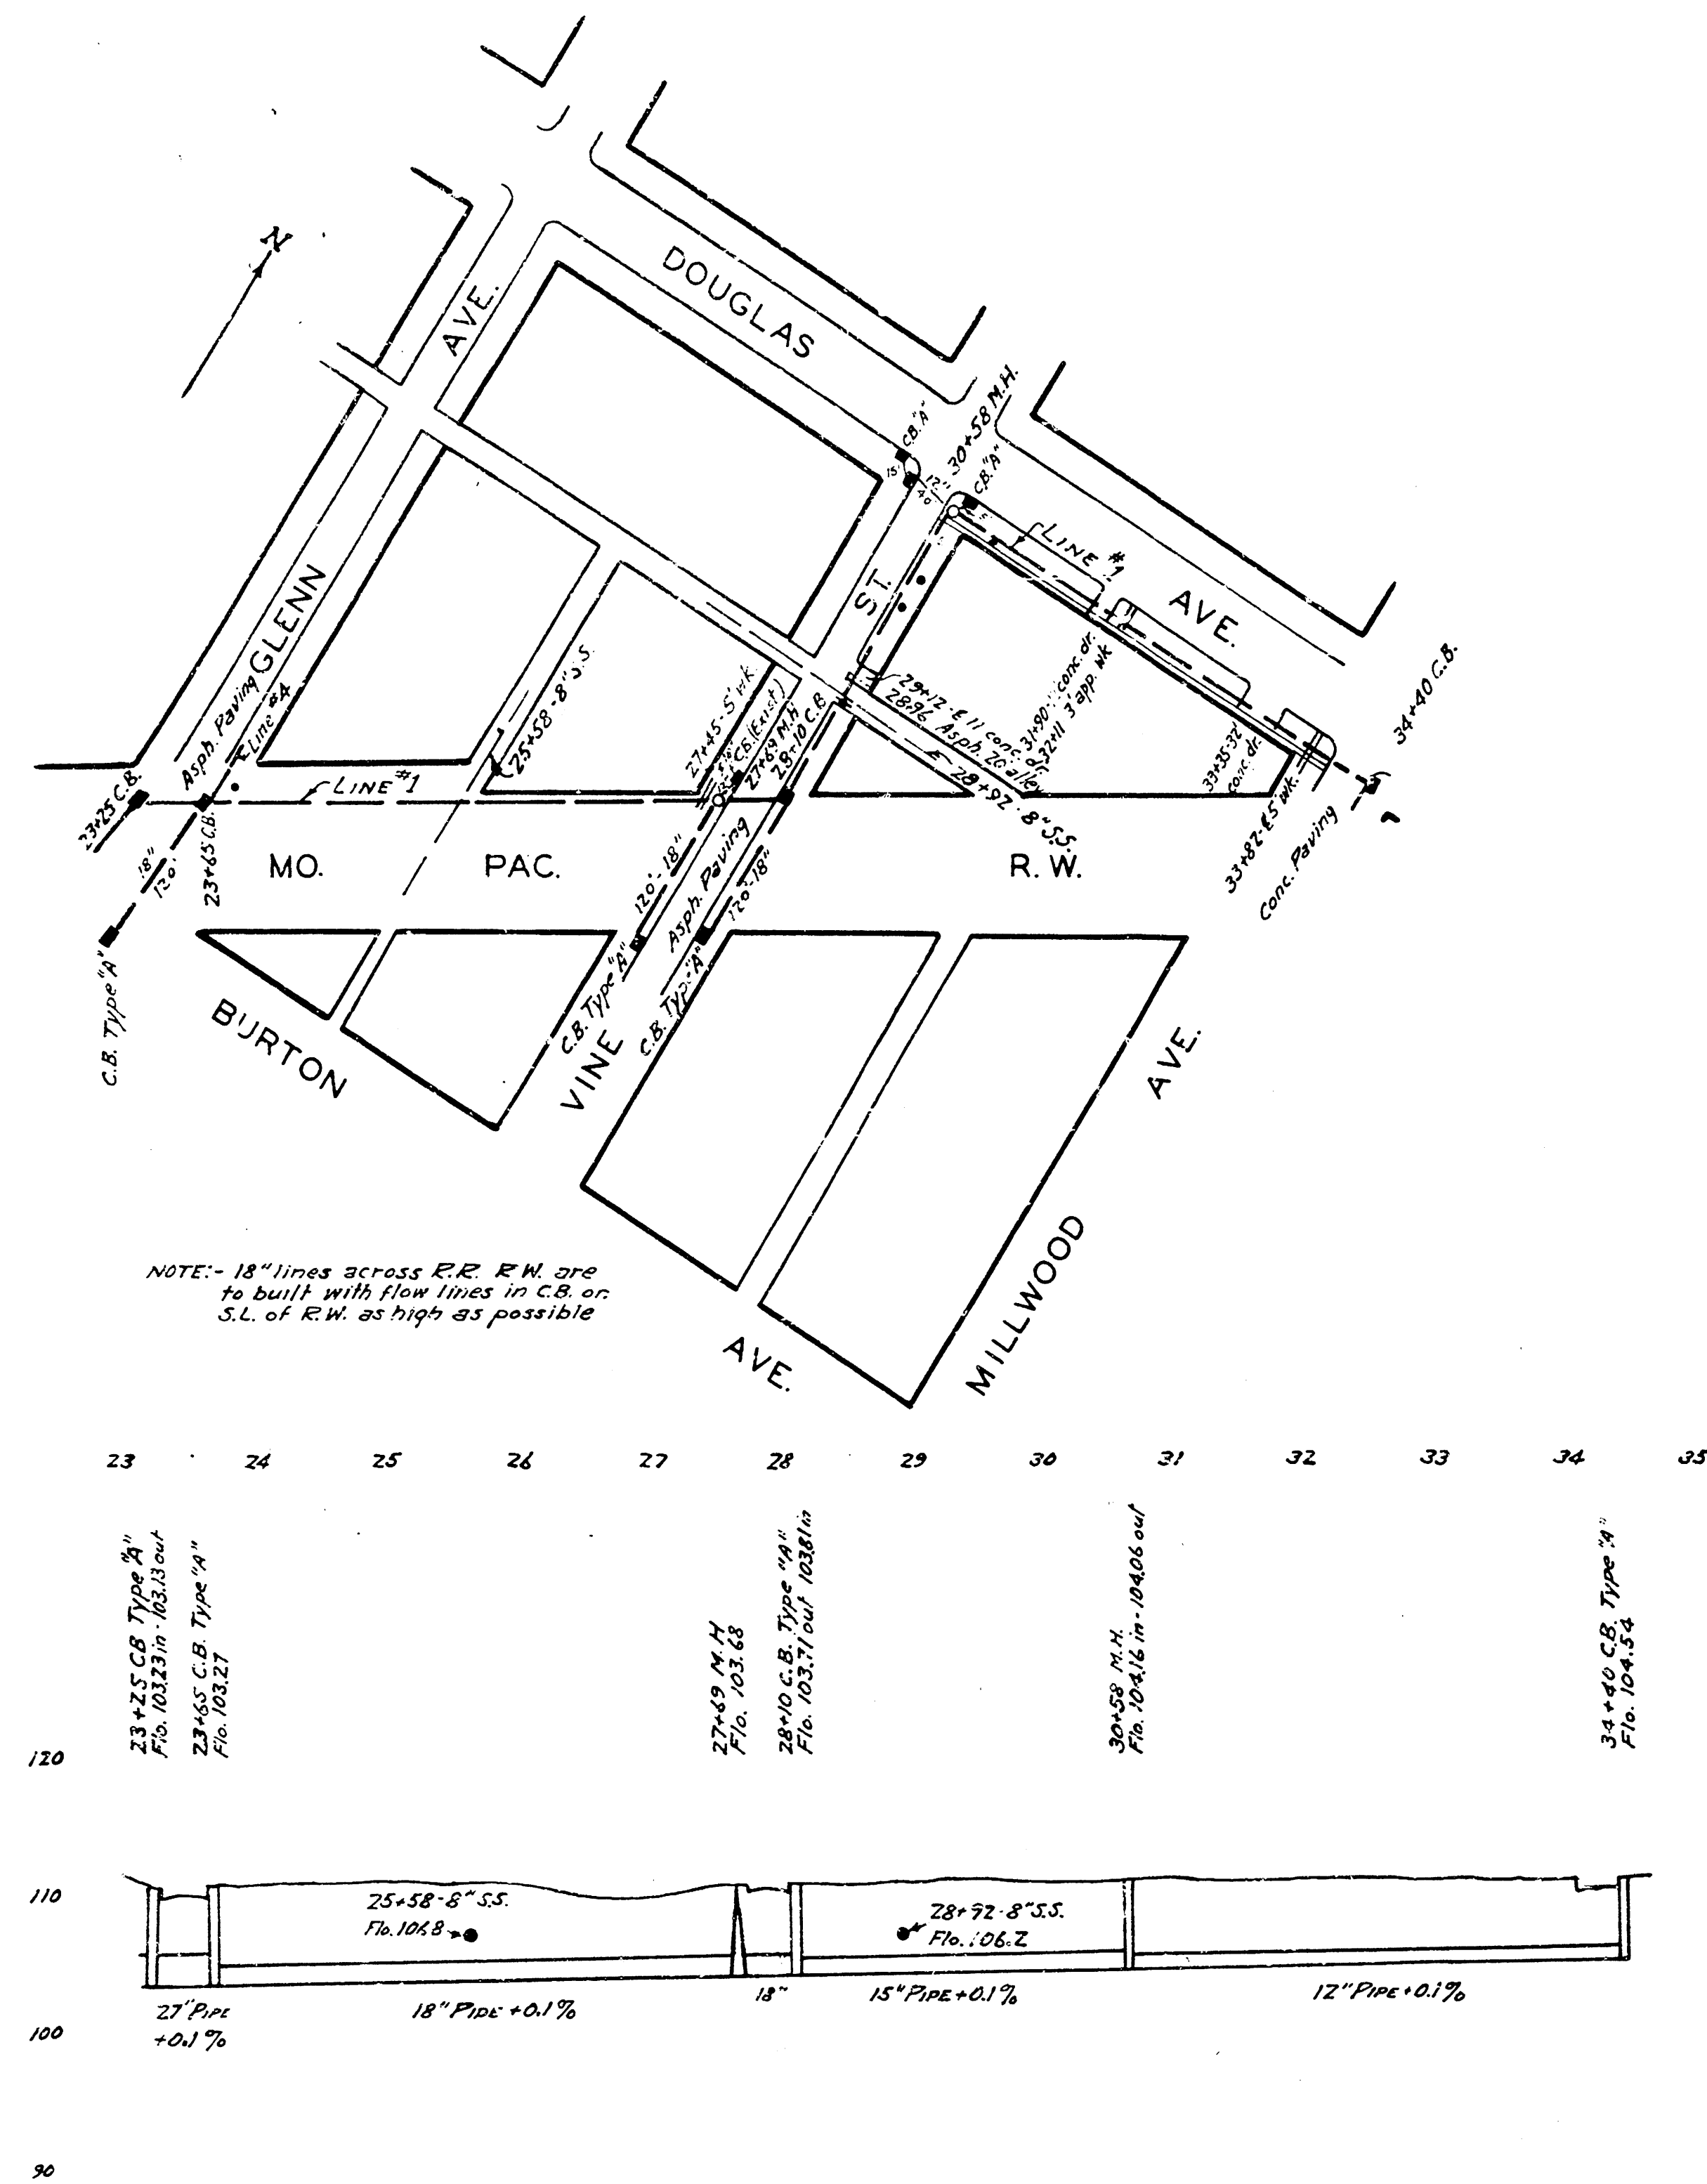

LINE 1

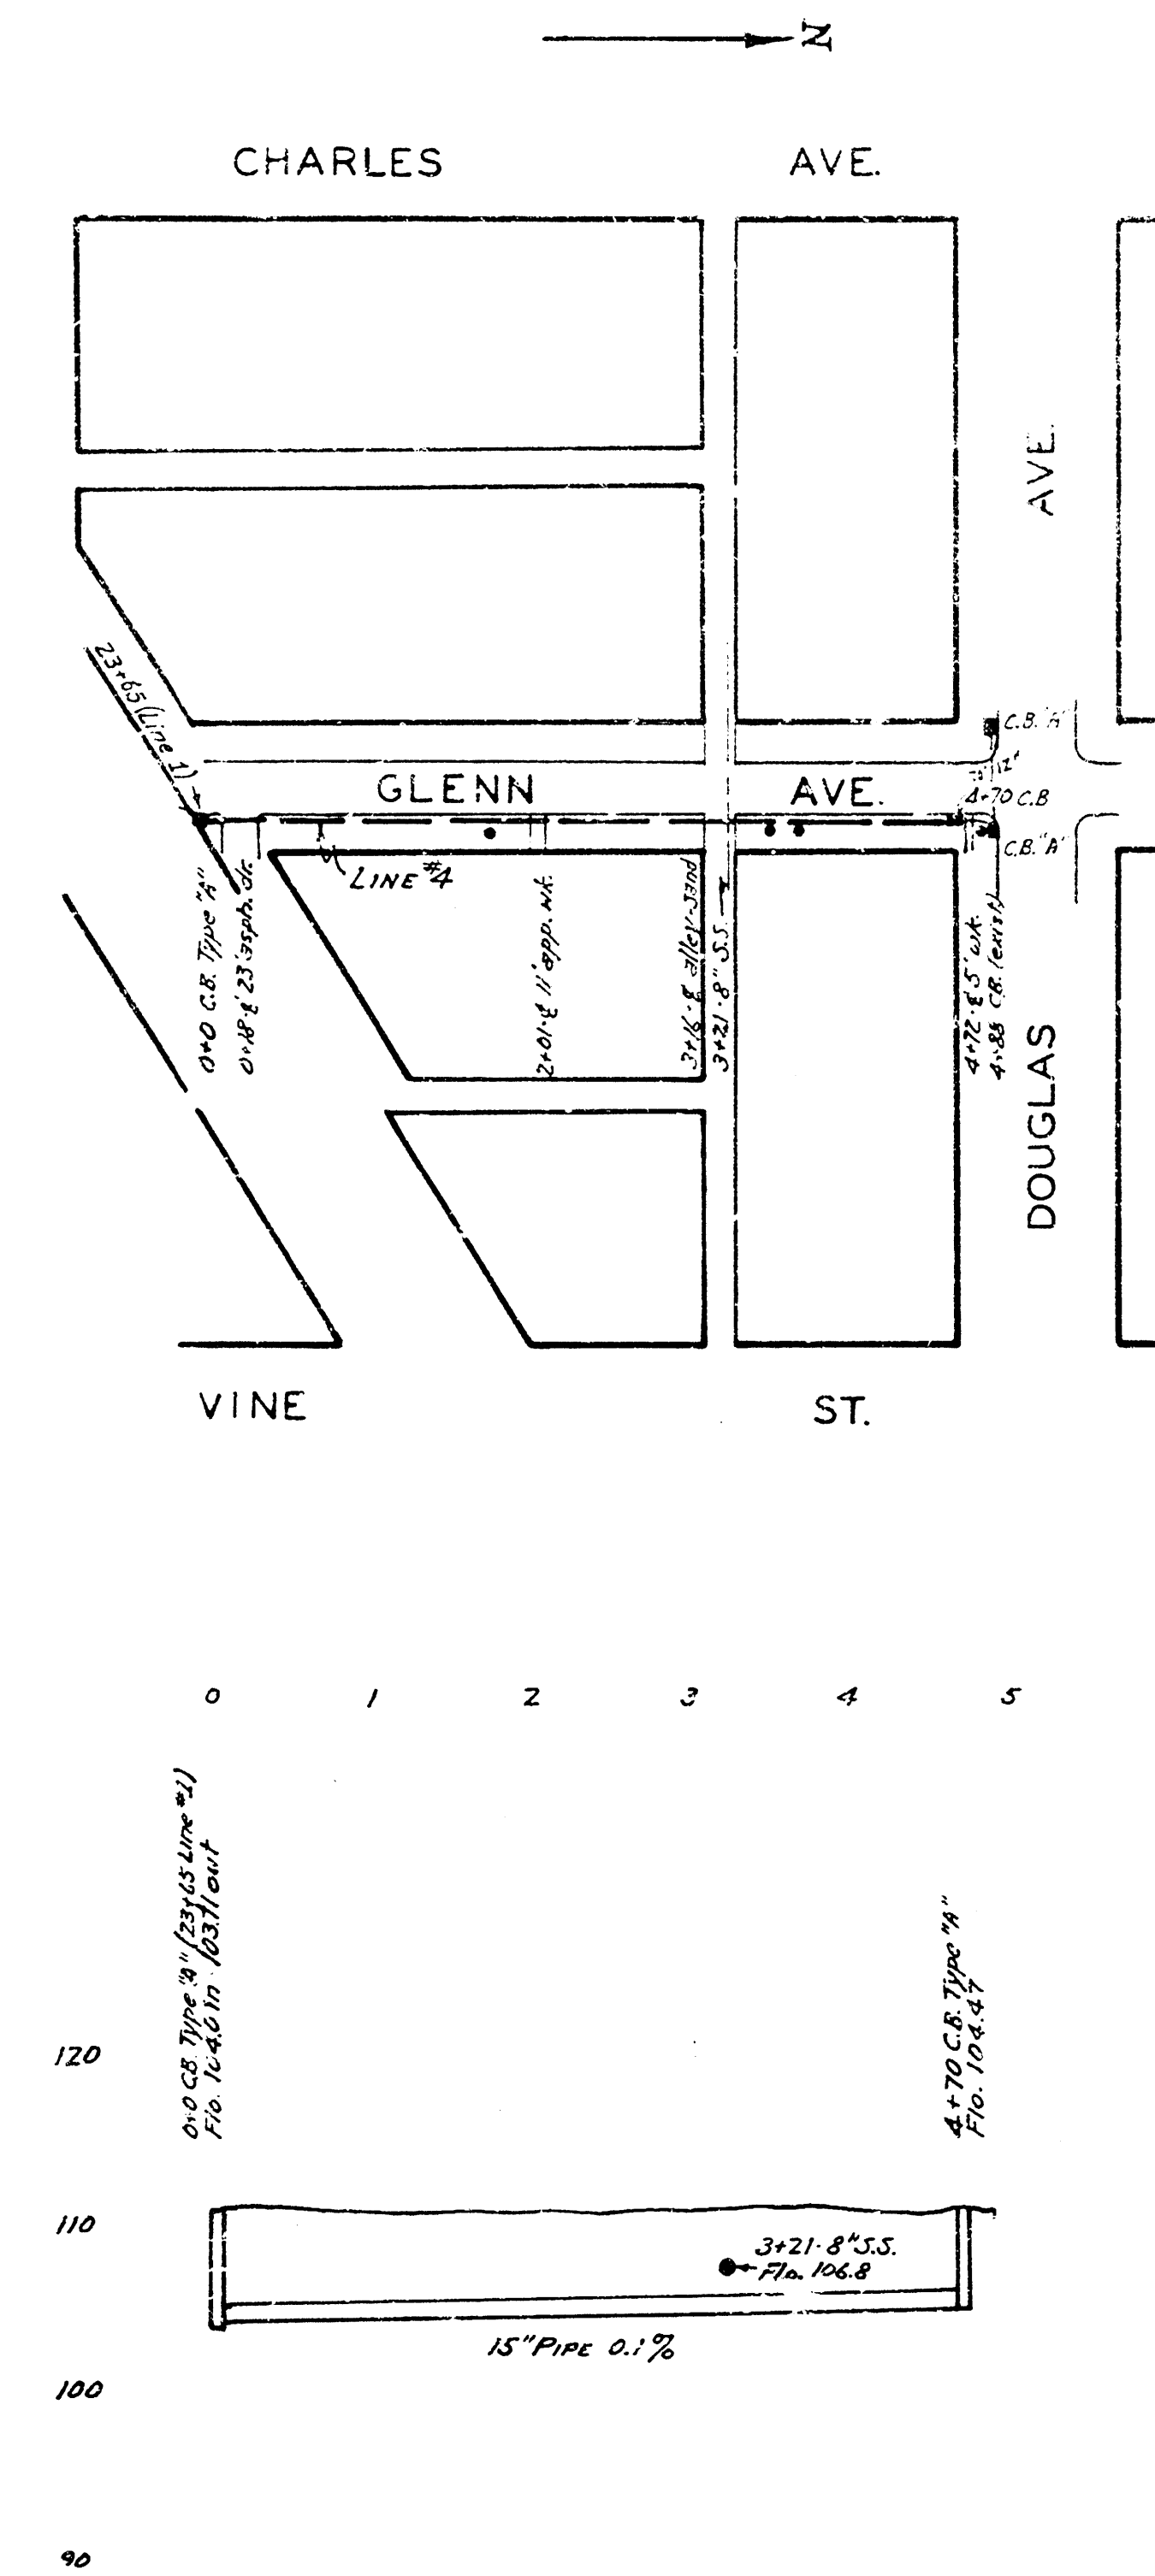

LINE 4

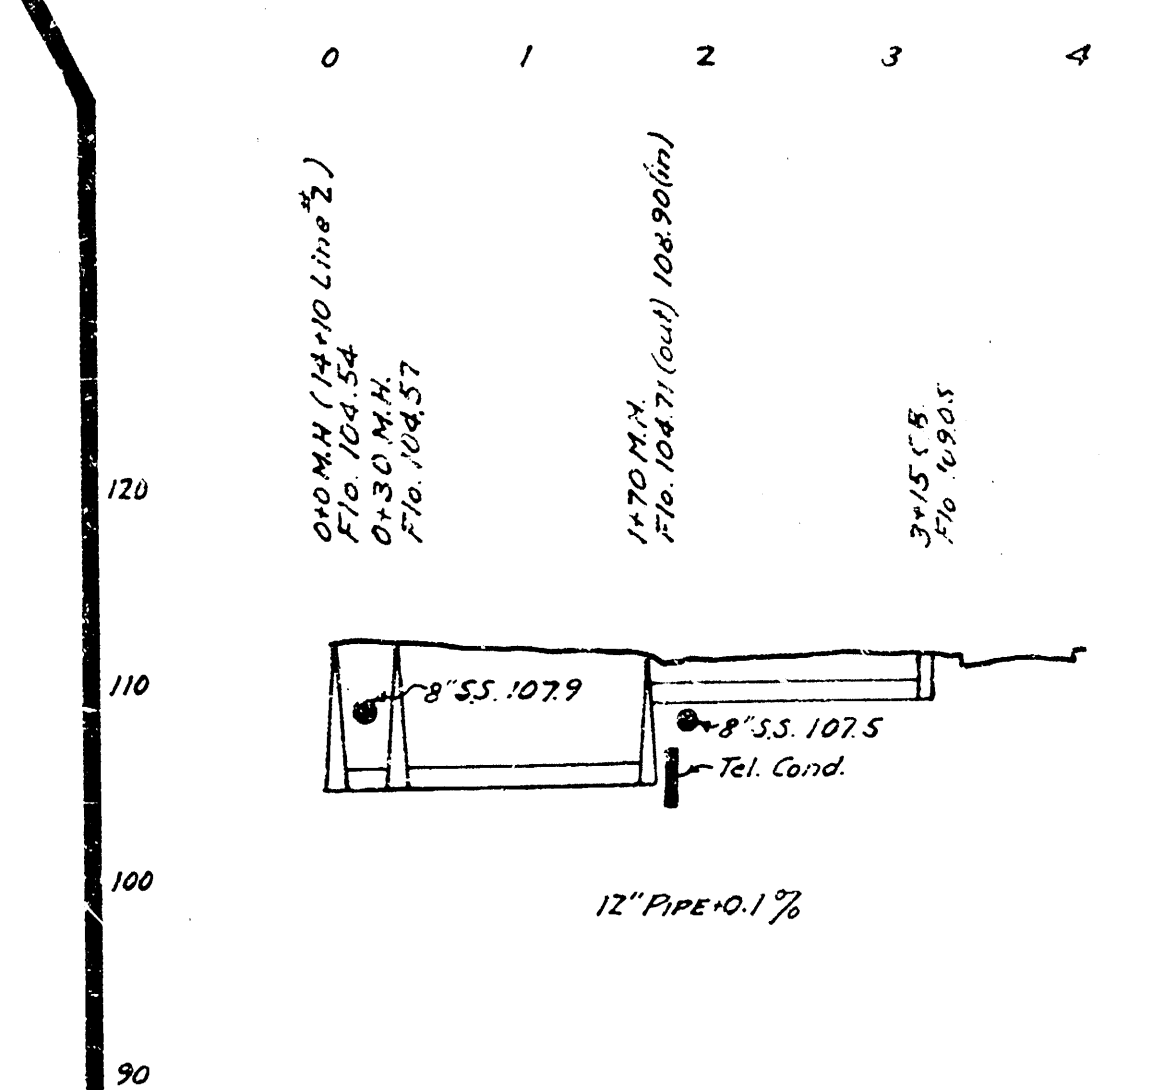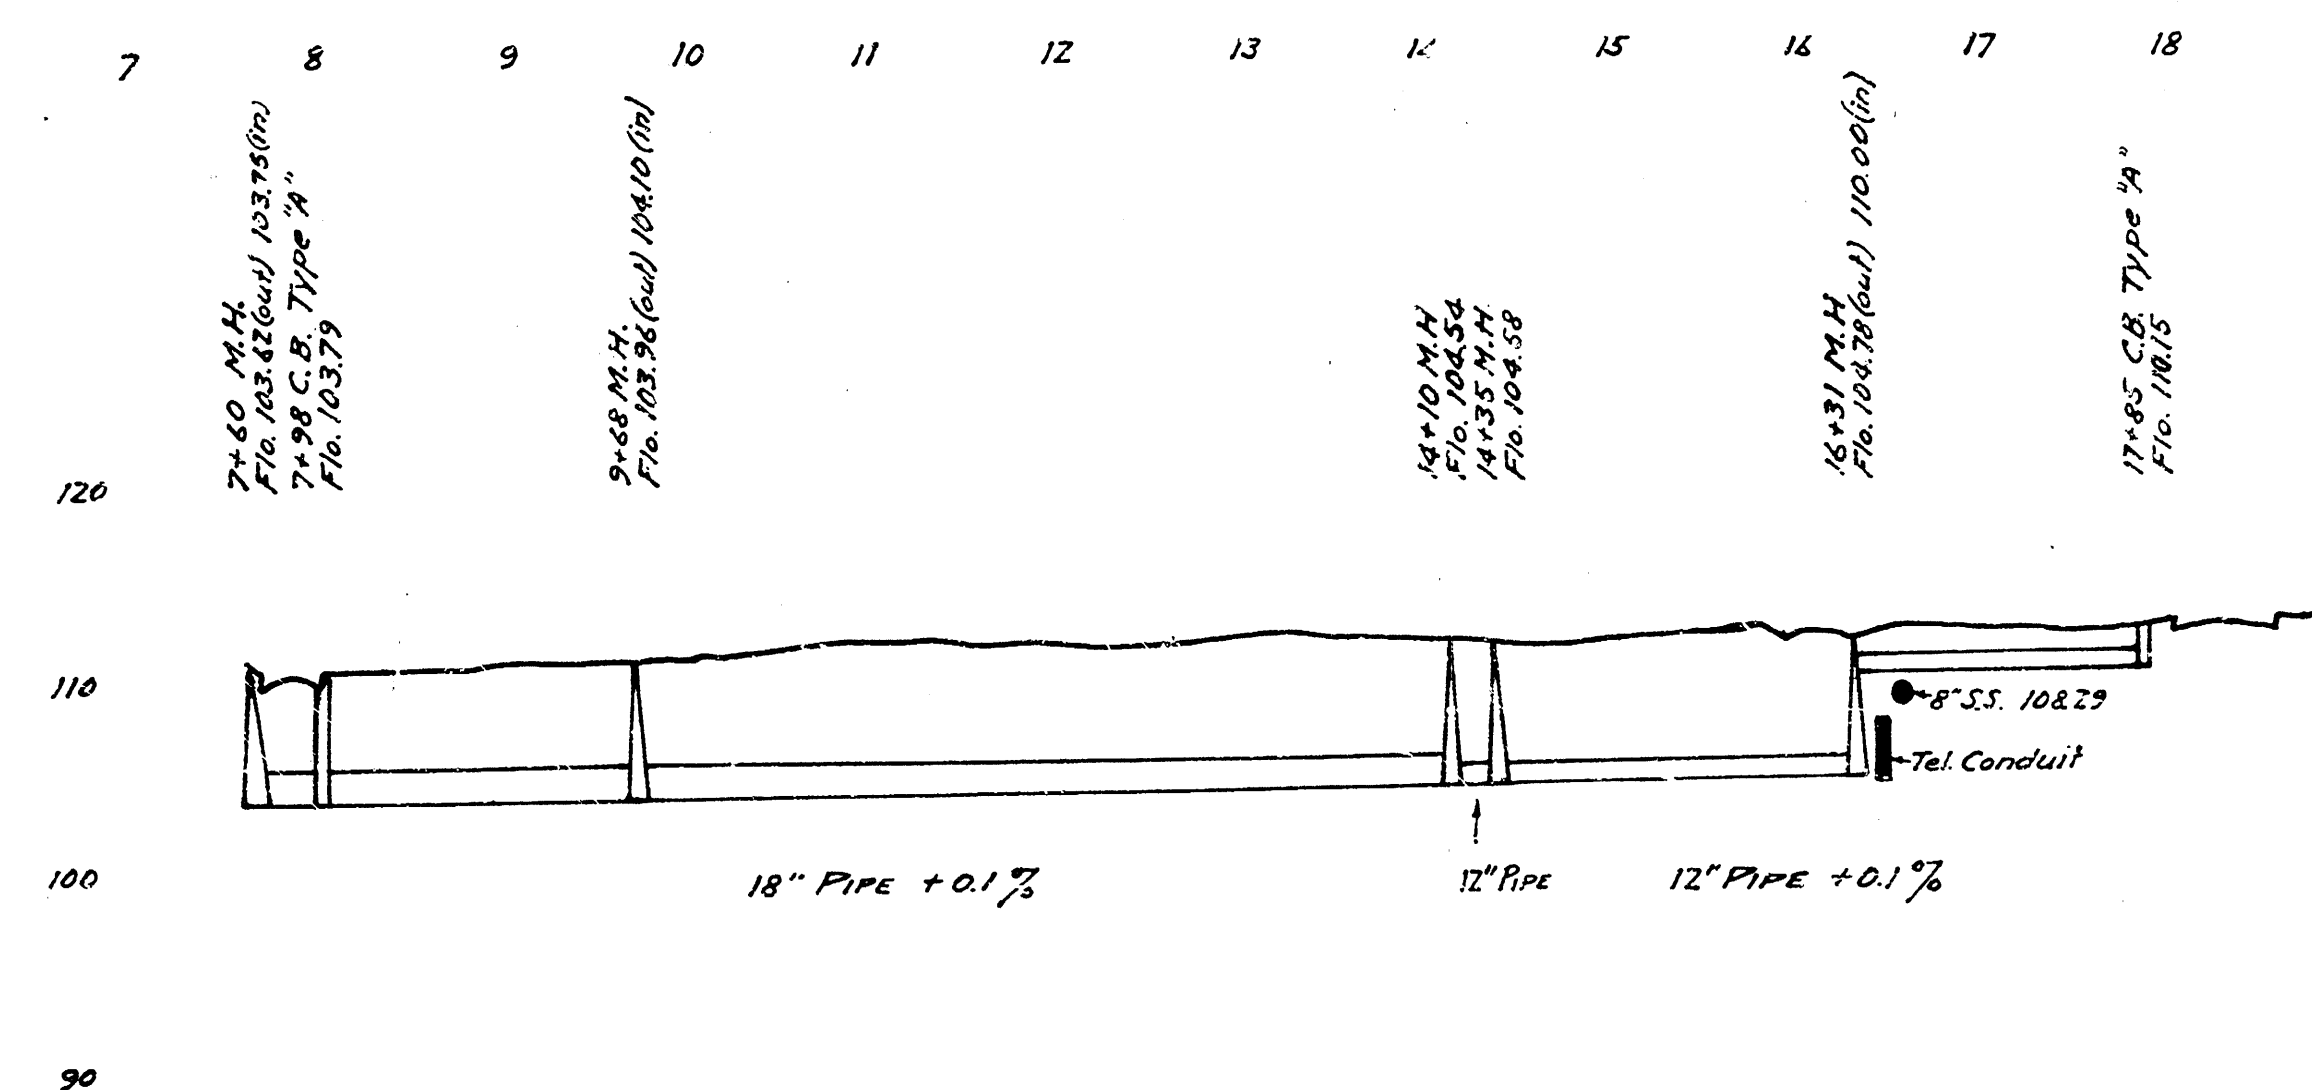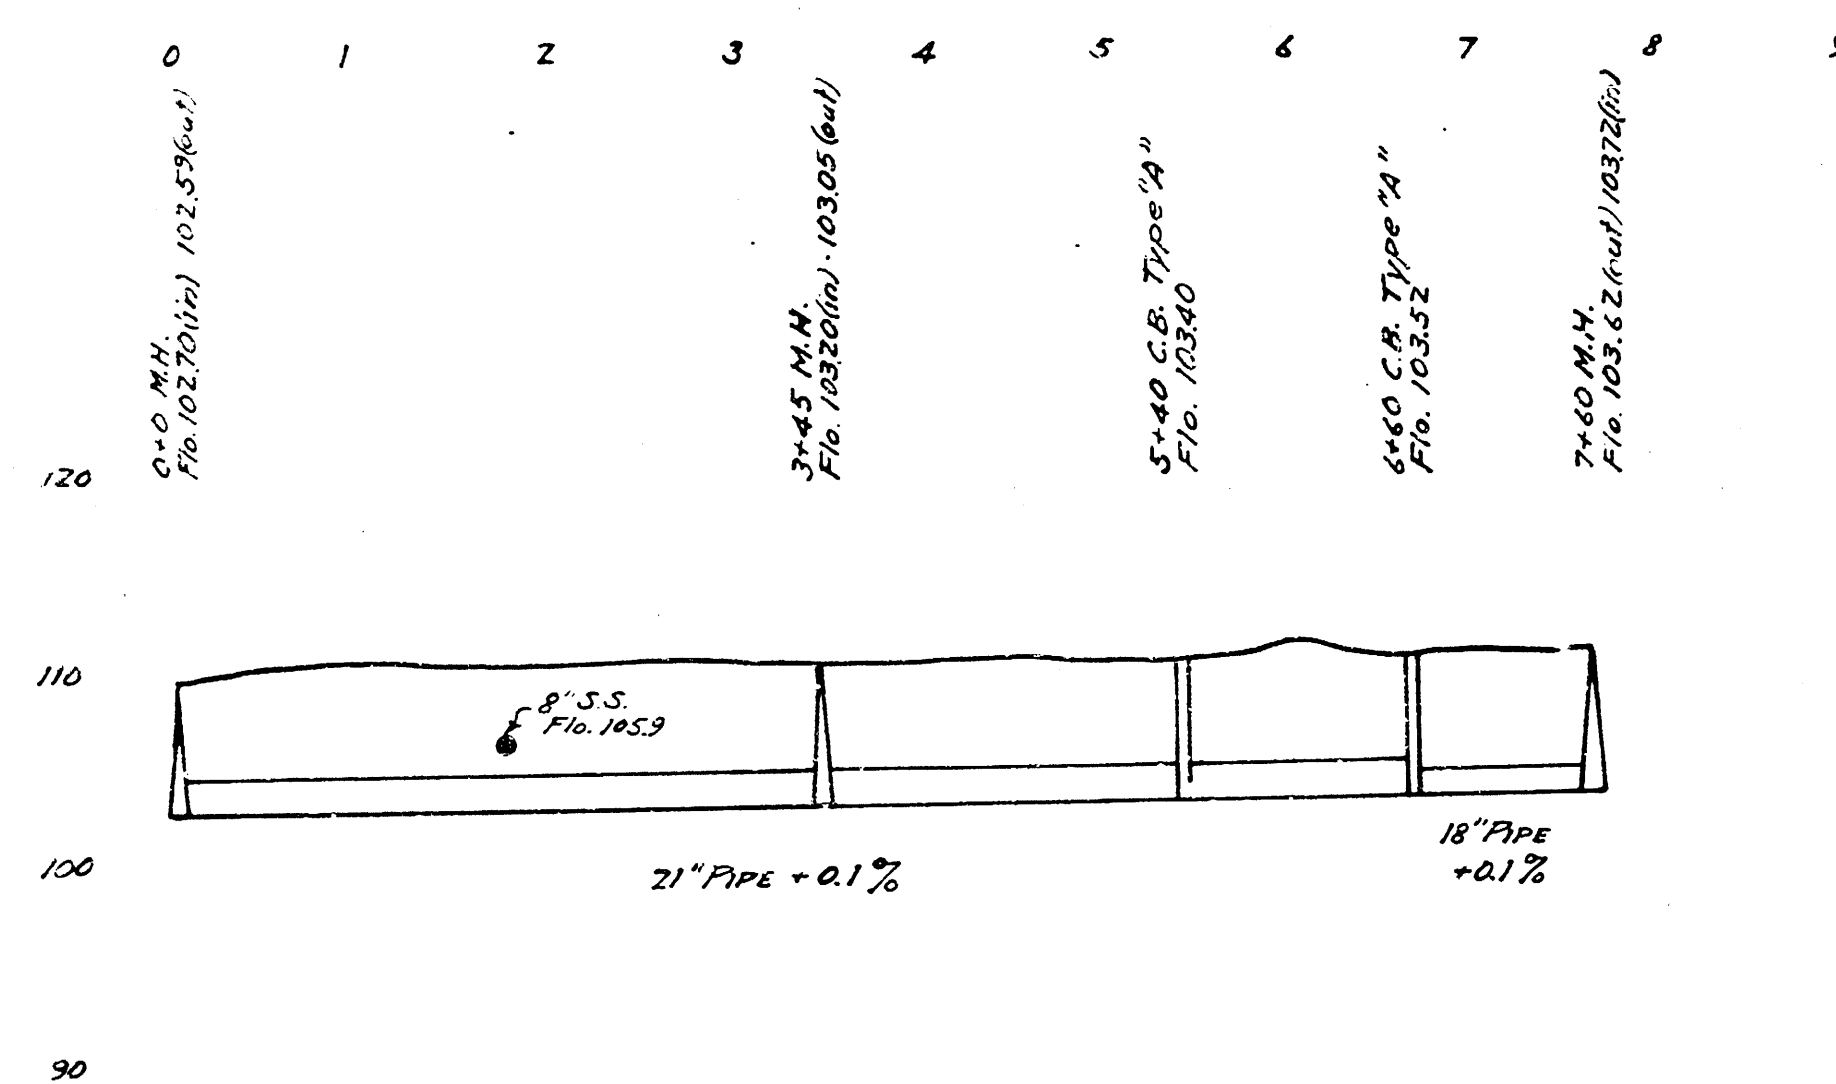

S.W.S.#30
ENGINEERING DEPARTMENT
CITY OF WICHITA, KANSAS

