
  
 Scale 1"=100'

STORM WATER SEWER DIST. NO. 42  
 CITY OF WICHITA KANSAS  
 L. K. WHITE CITY ENGINEER  
 Proj. No. C 21-62  
 SEPT. 15, 1951

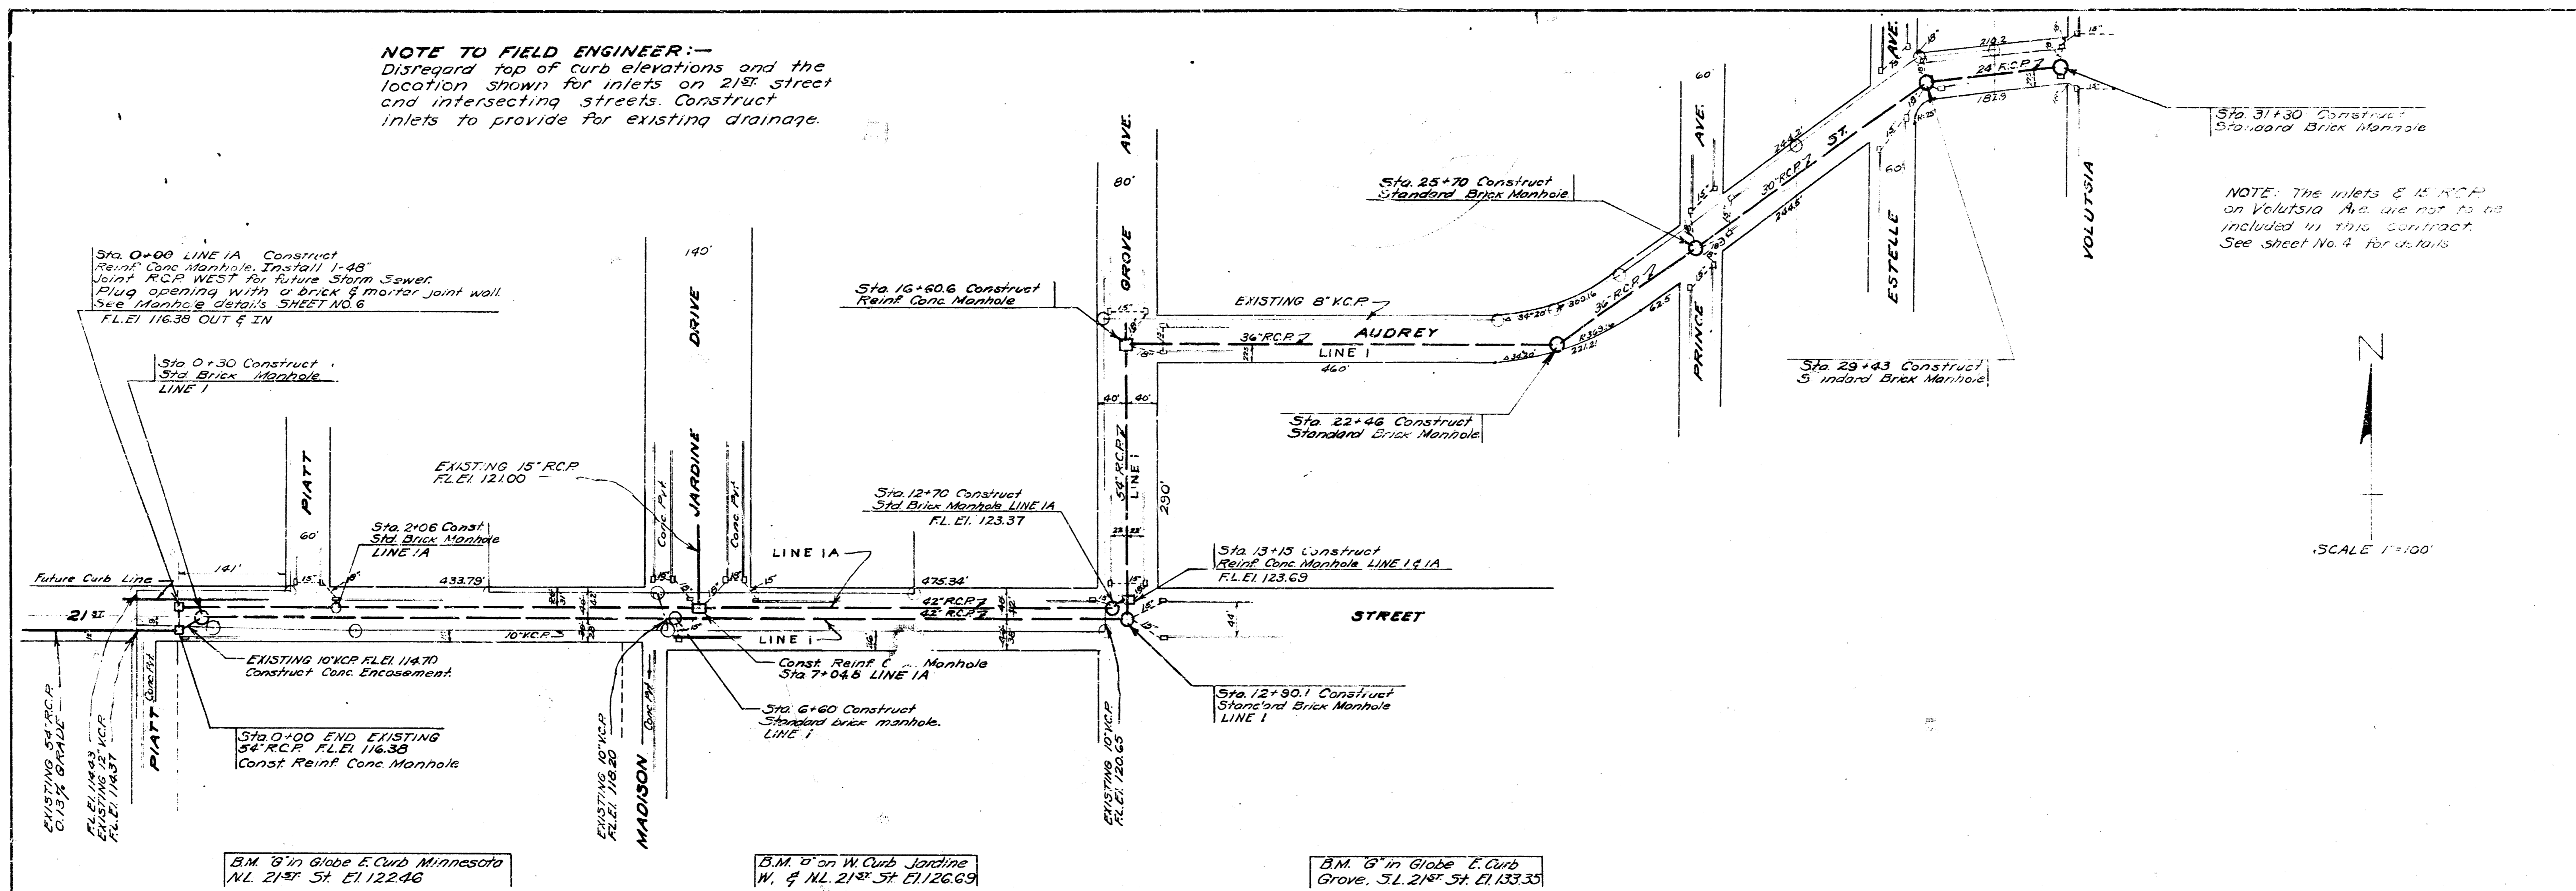

**NOTE TO FIELD ENGINEER:**—  
 Disregard top of curb elevations and the location shown for inlets on 21st street and intersecting streets. Construct inlets to provide for existing drainage.



NOTE: The inlets & R.C.P. on Volusia Ave. are not to be included in this contract. See sheet No. 4 for details.




B.M. 8" in Globe E. Curb Minnesota  
 N.L. 21st St. E.I. 122.46

B.M. 8" in W. Curb Jordine  
 W. of N.L. 21st St. E.I. 126.69


B.M. 6" in Globe E. Curb  
 Grove, S.L. 21st St. E.I. 133.35

NOTE: SAND BACKFILL ALL TRENCHES UNDER FUTURE PAVEMENT 10' OUTSIDE CURB LINE.


SCALE 1" = 100' Horiz  
 1" = 8' Vert.

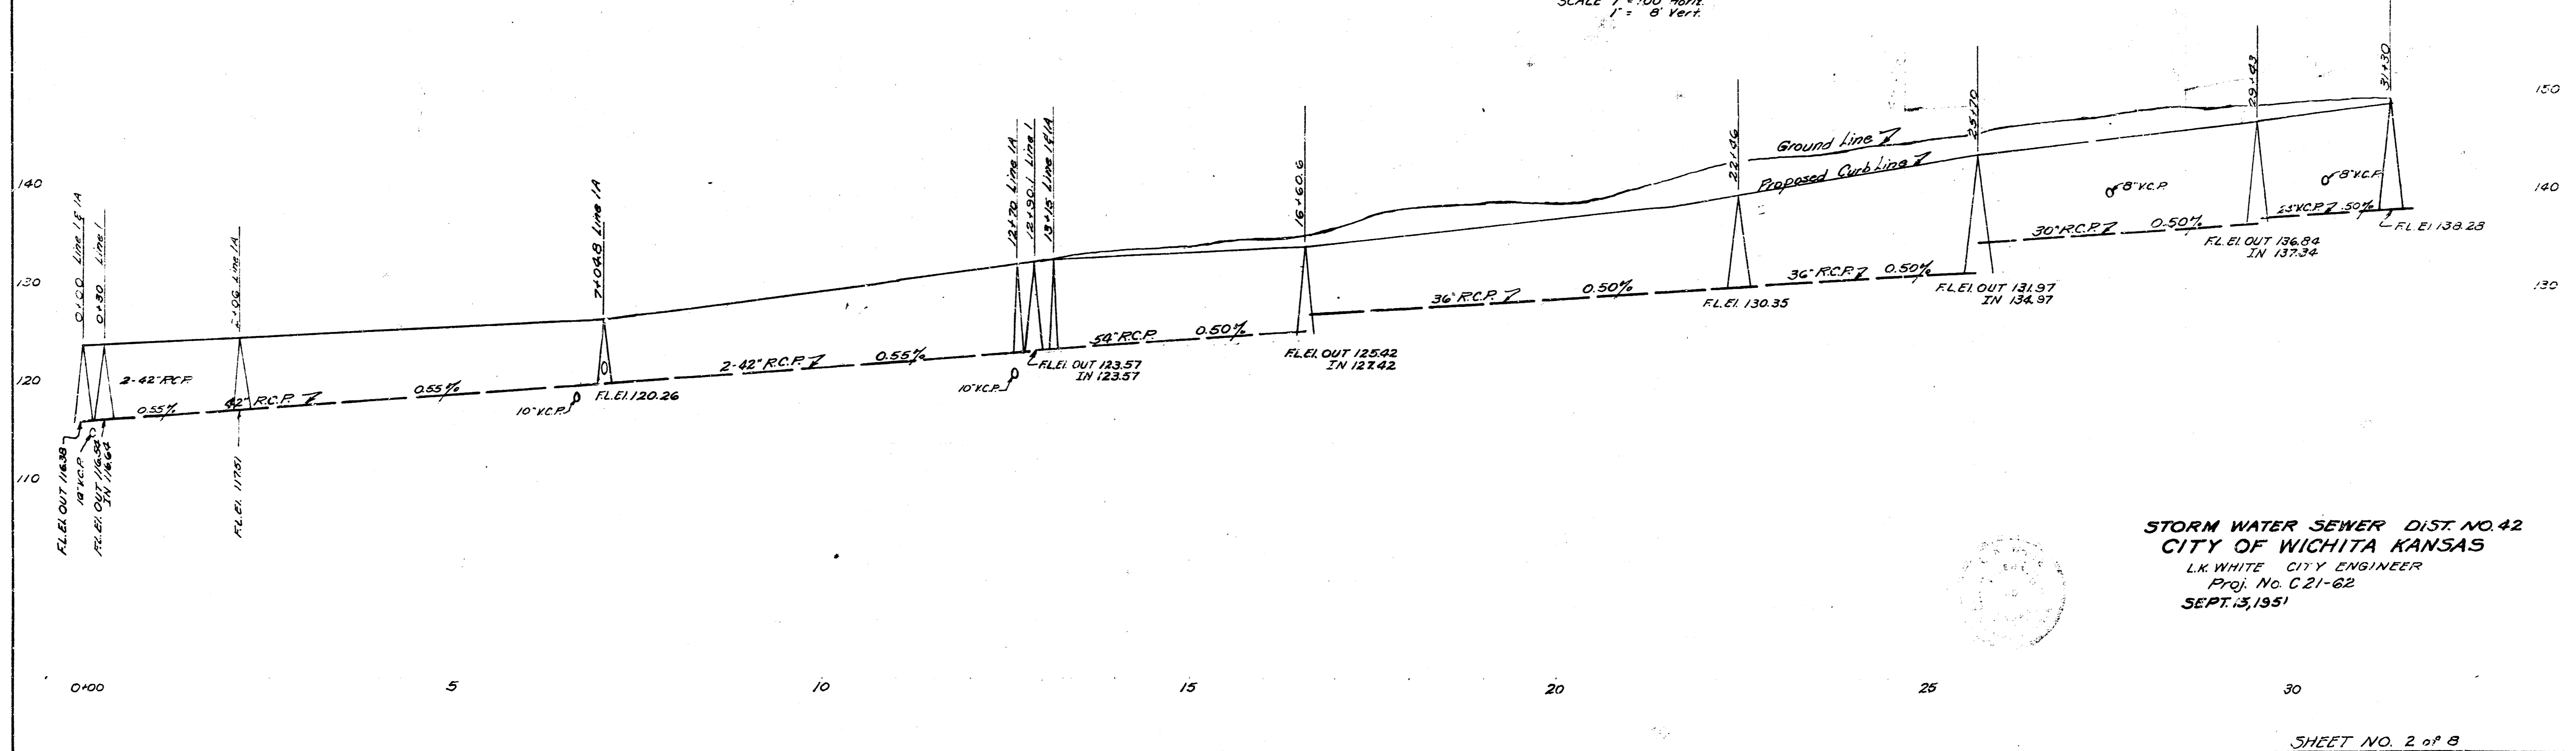

STORM WATER SEWER DIST. NO. 42  
 CITY OF WICHITA KANSAS  
 LK WHITE CITY ENGINEER  
 Proj. No. C-21-62  
 SEPT. 13, 1951

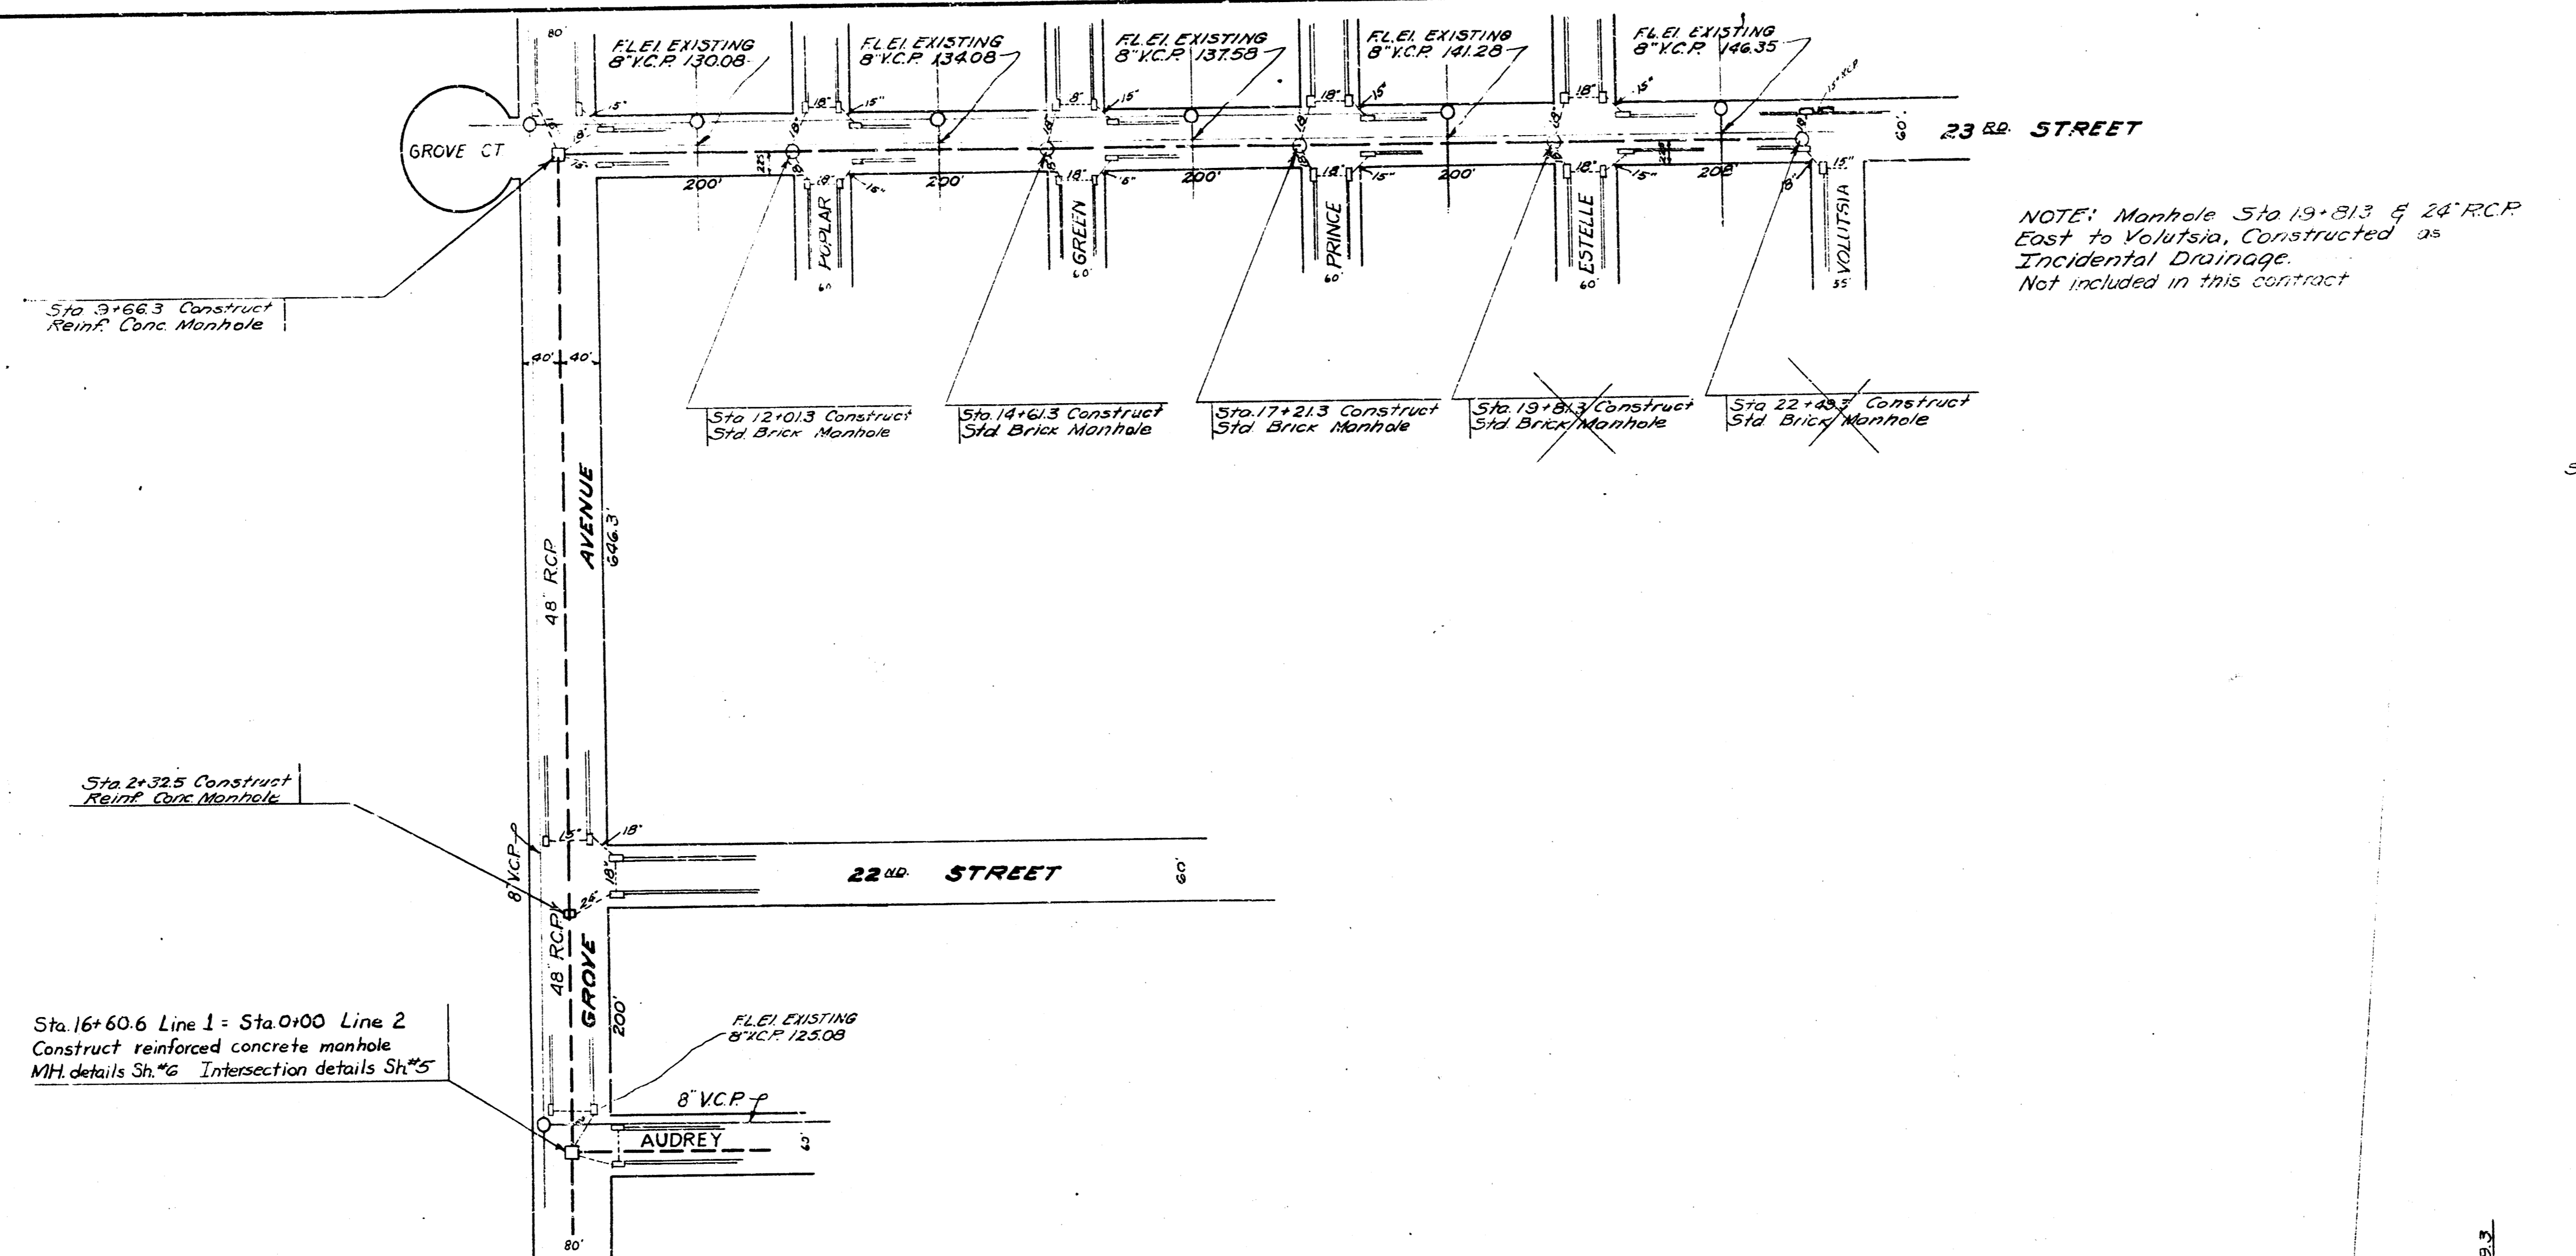


NOTE: Manhole Sta 19+31.3 & 24' RCP East to Volutsia, Constructed as Incidental Drainage. Not included in this contract.

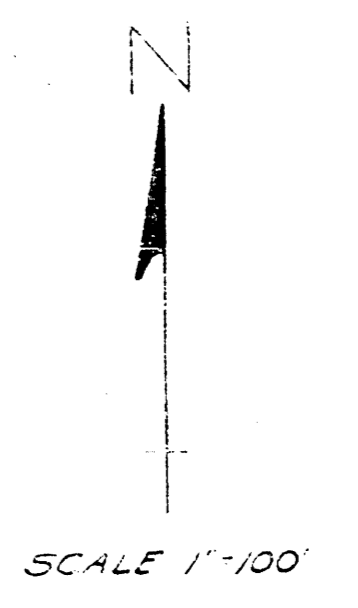

Sta. 16+60.6 Line 1 = Sta. 0+00 Line 2  
Construct reinforced concrete manhole  
MH details Sh\*2 Intersection details Sh\*5

SCALE 1" = 100 Horiz  
1" = 8 Vert

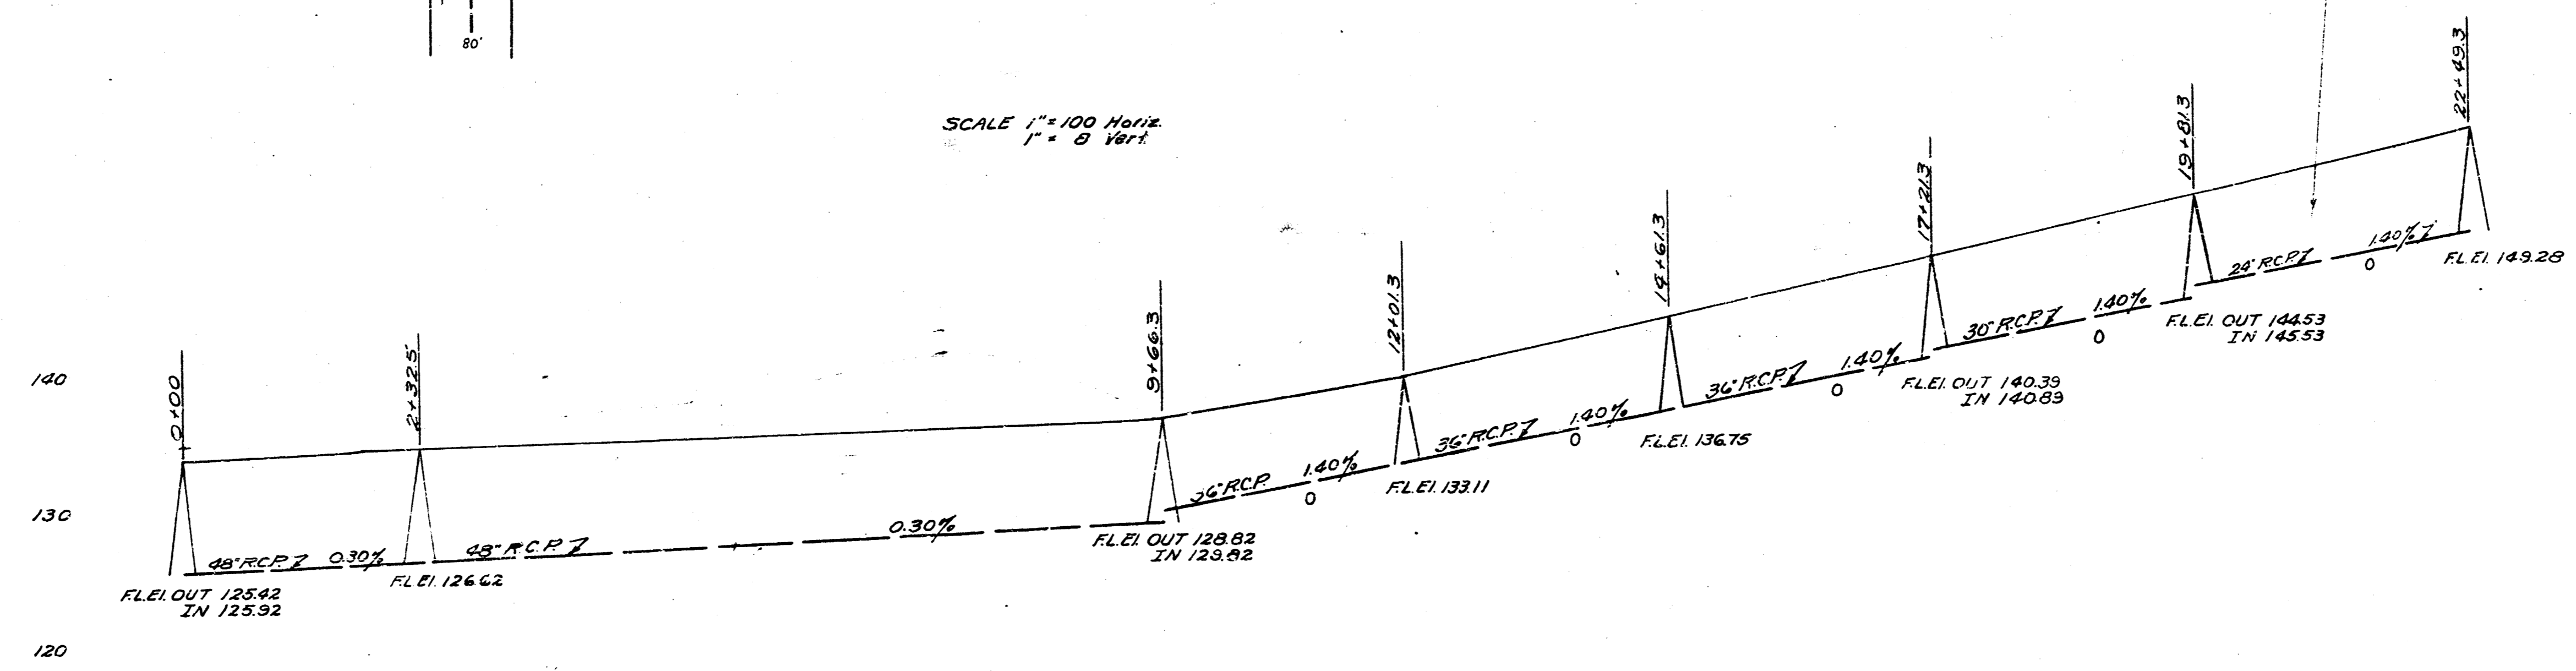

STORM WATER SEWER DIST NO. 42  
CITY OF WICHITA KANSAS  
L. K. WHITE CITY ENGINEER  
Proj. No. C21-62  
SEPT. 15, 1951

0+00


5

10


15

20


SHEET NO. 3 OF 8

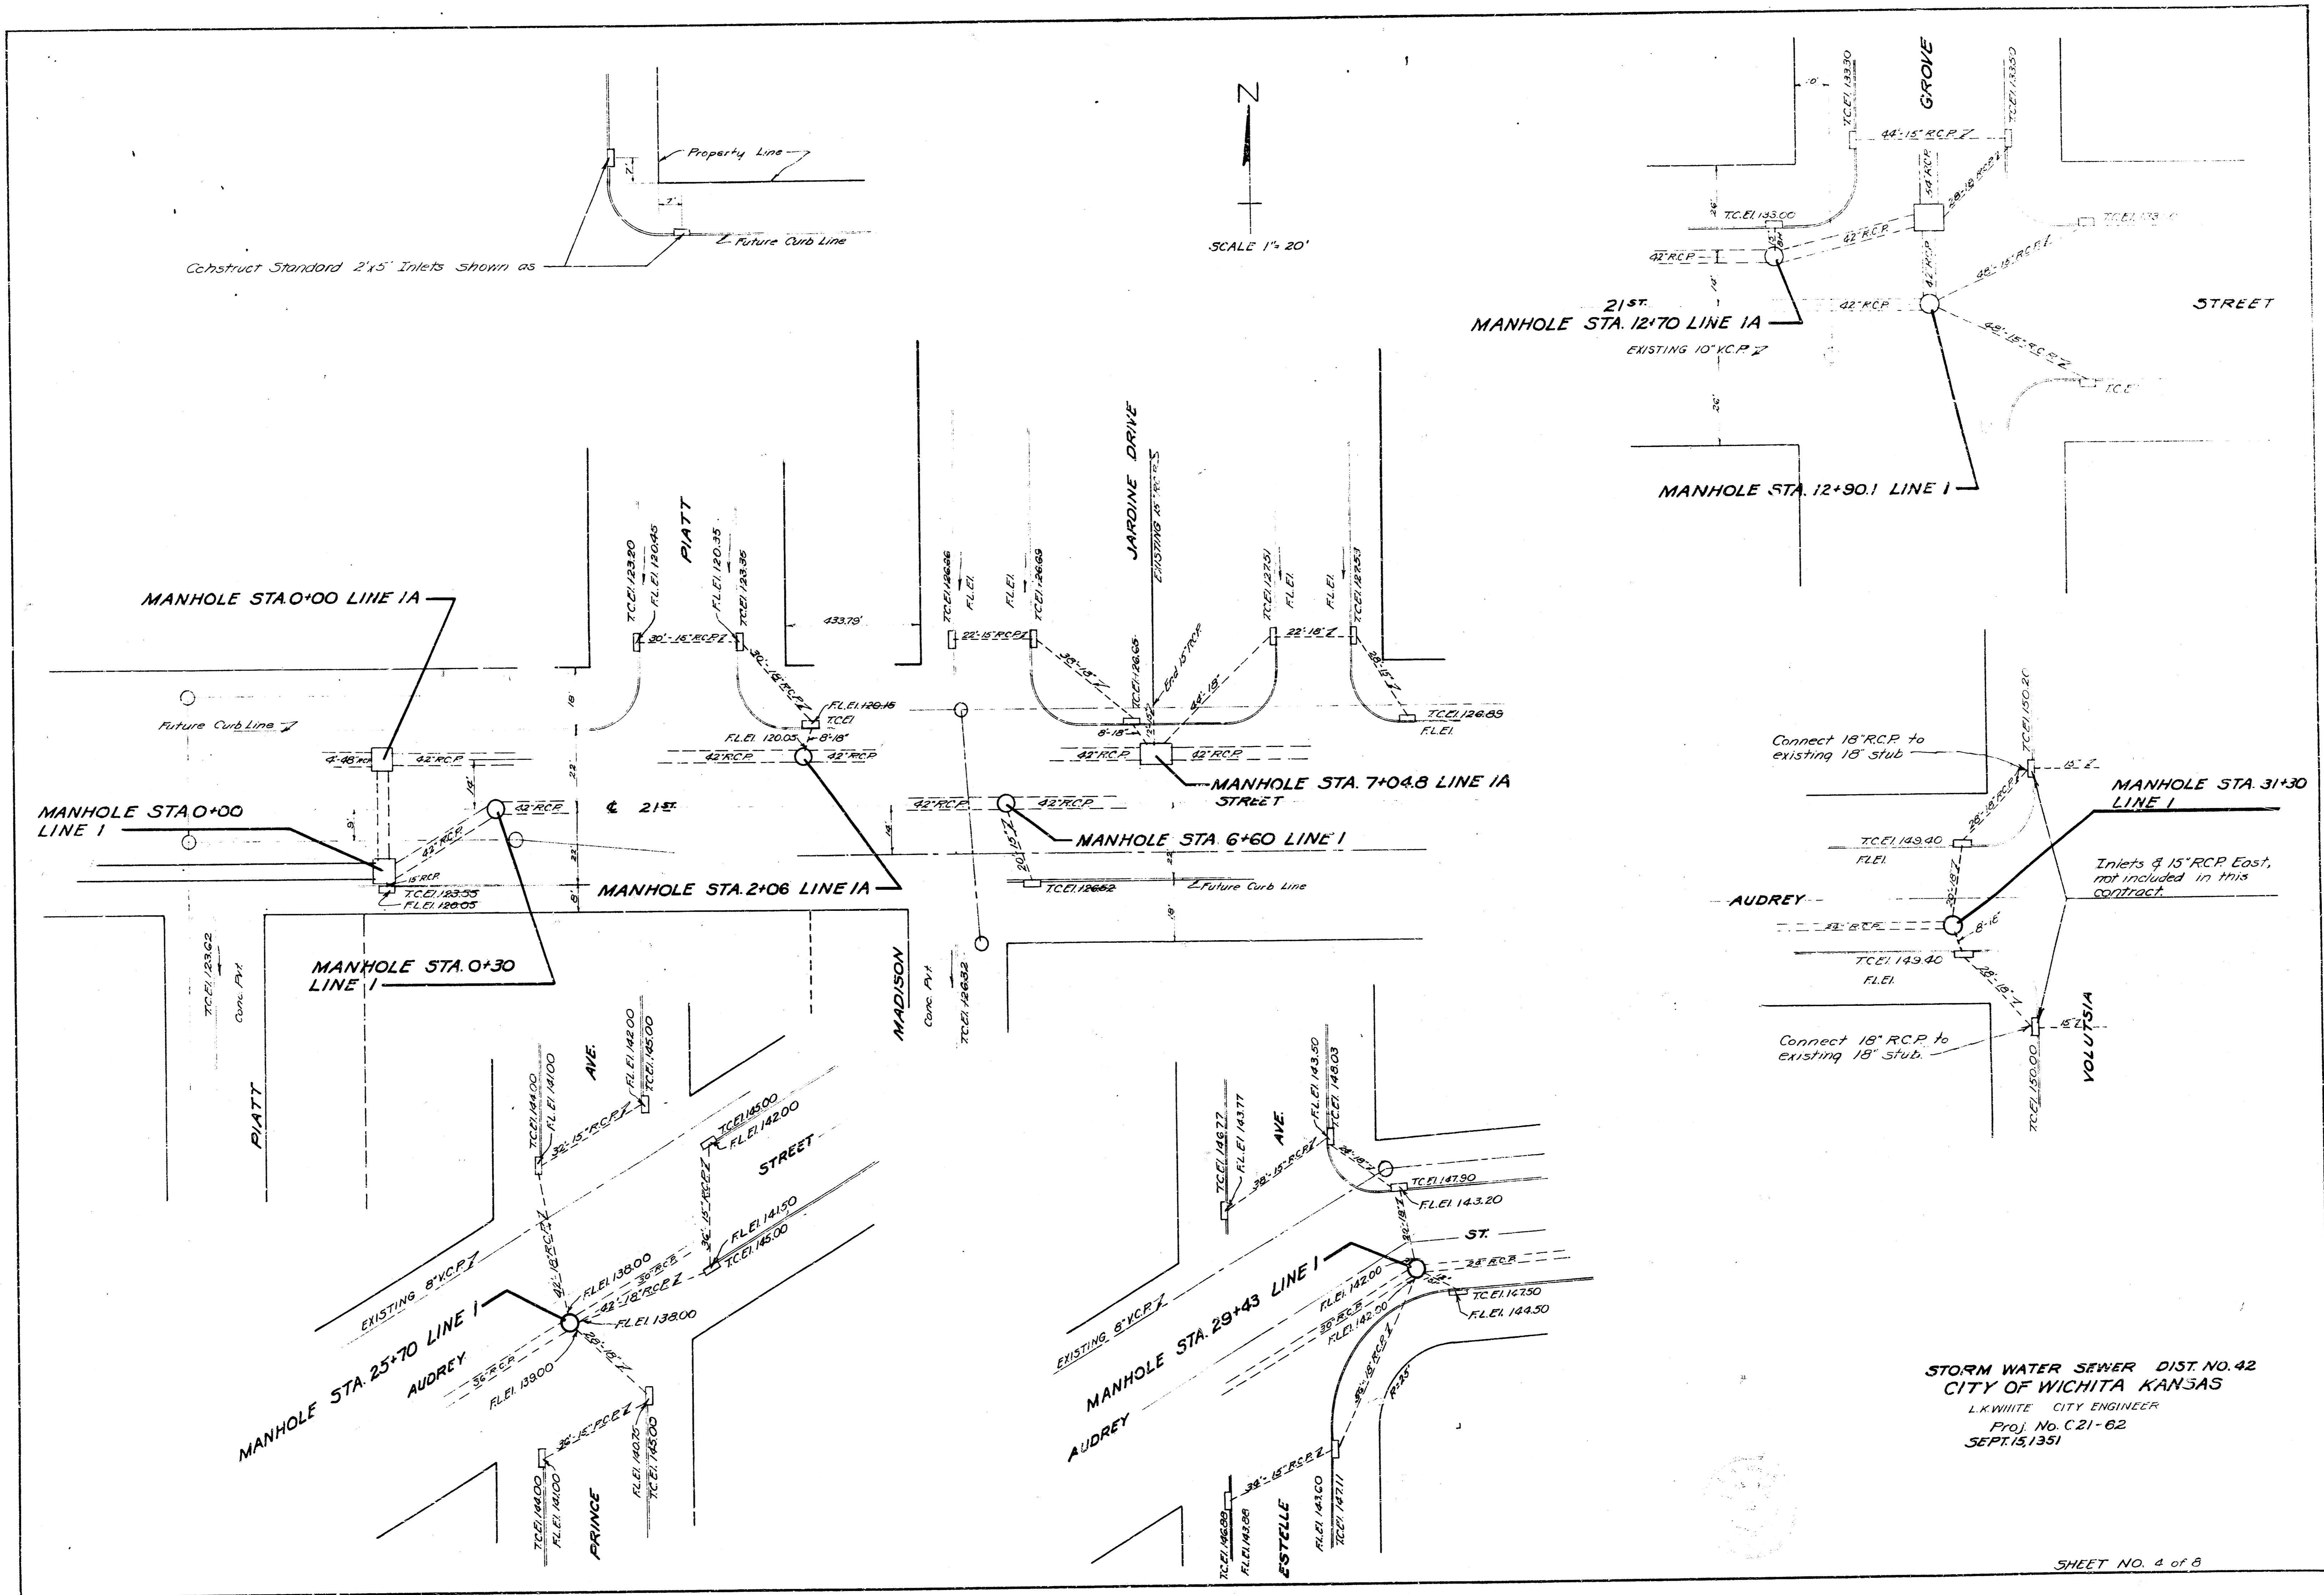

Construct Standard 2'x5' Inlets shown as


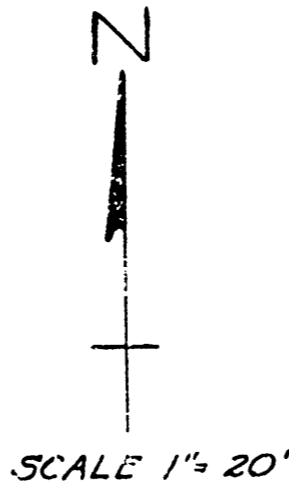


STORM WATER SEWER DIST. NO. 42  
 CITY OF WICHITA KANSAS  
 L.K. WHITE CITY ENGINEER  
 Proj. No. C 21-62  
 SEPT. 15, 1951


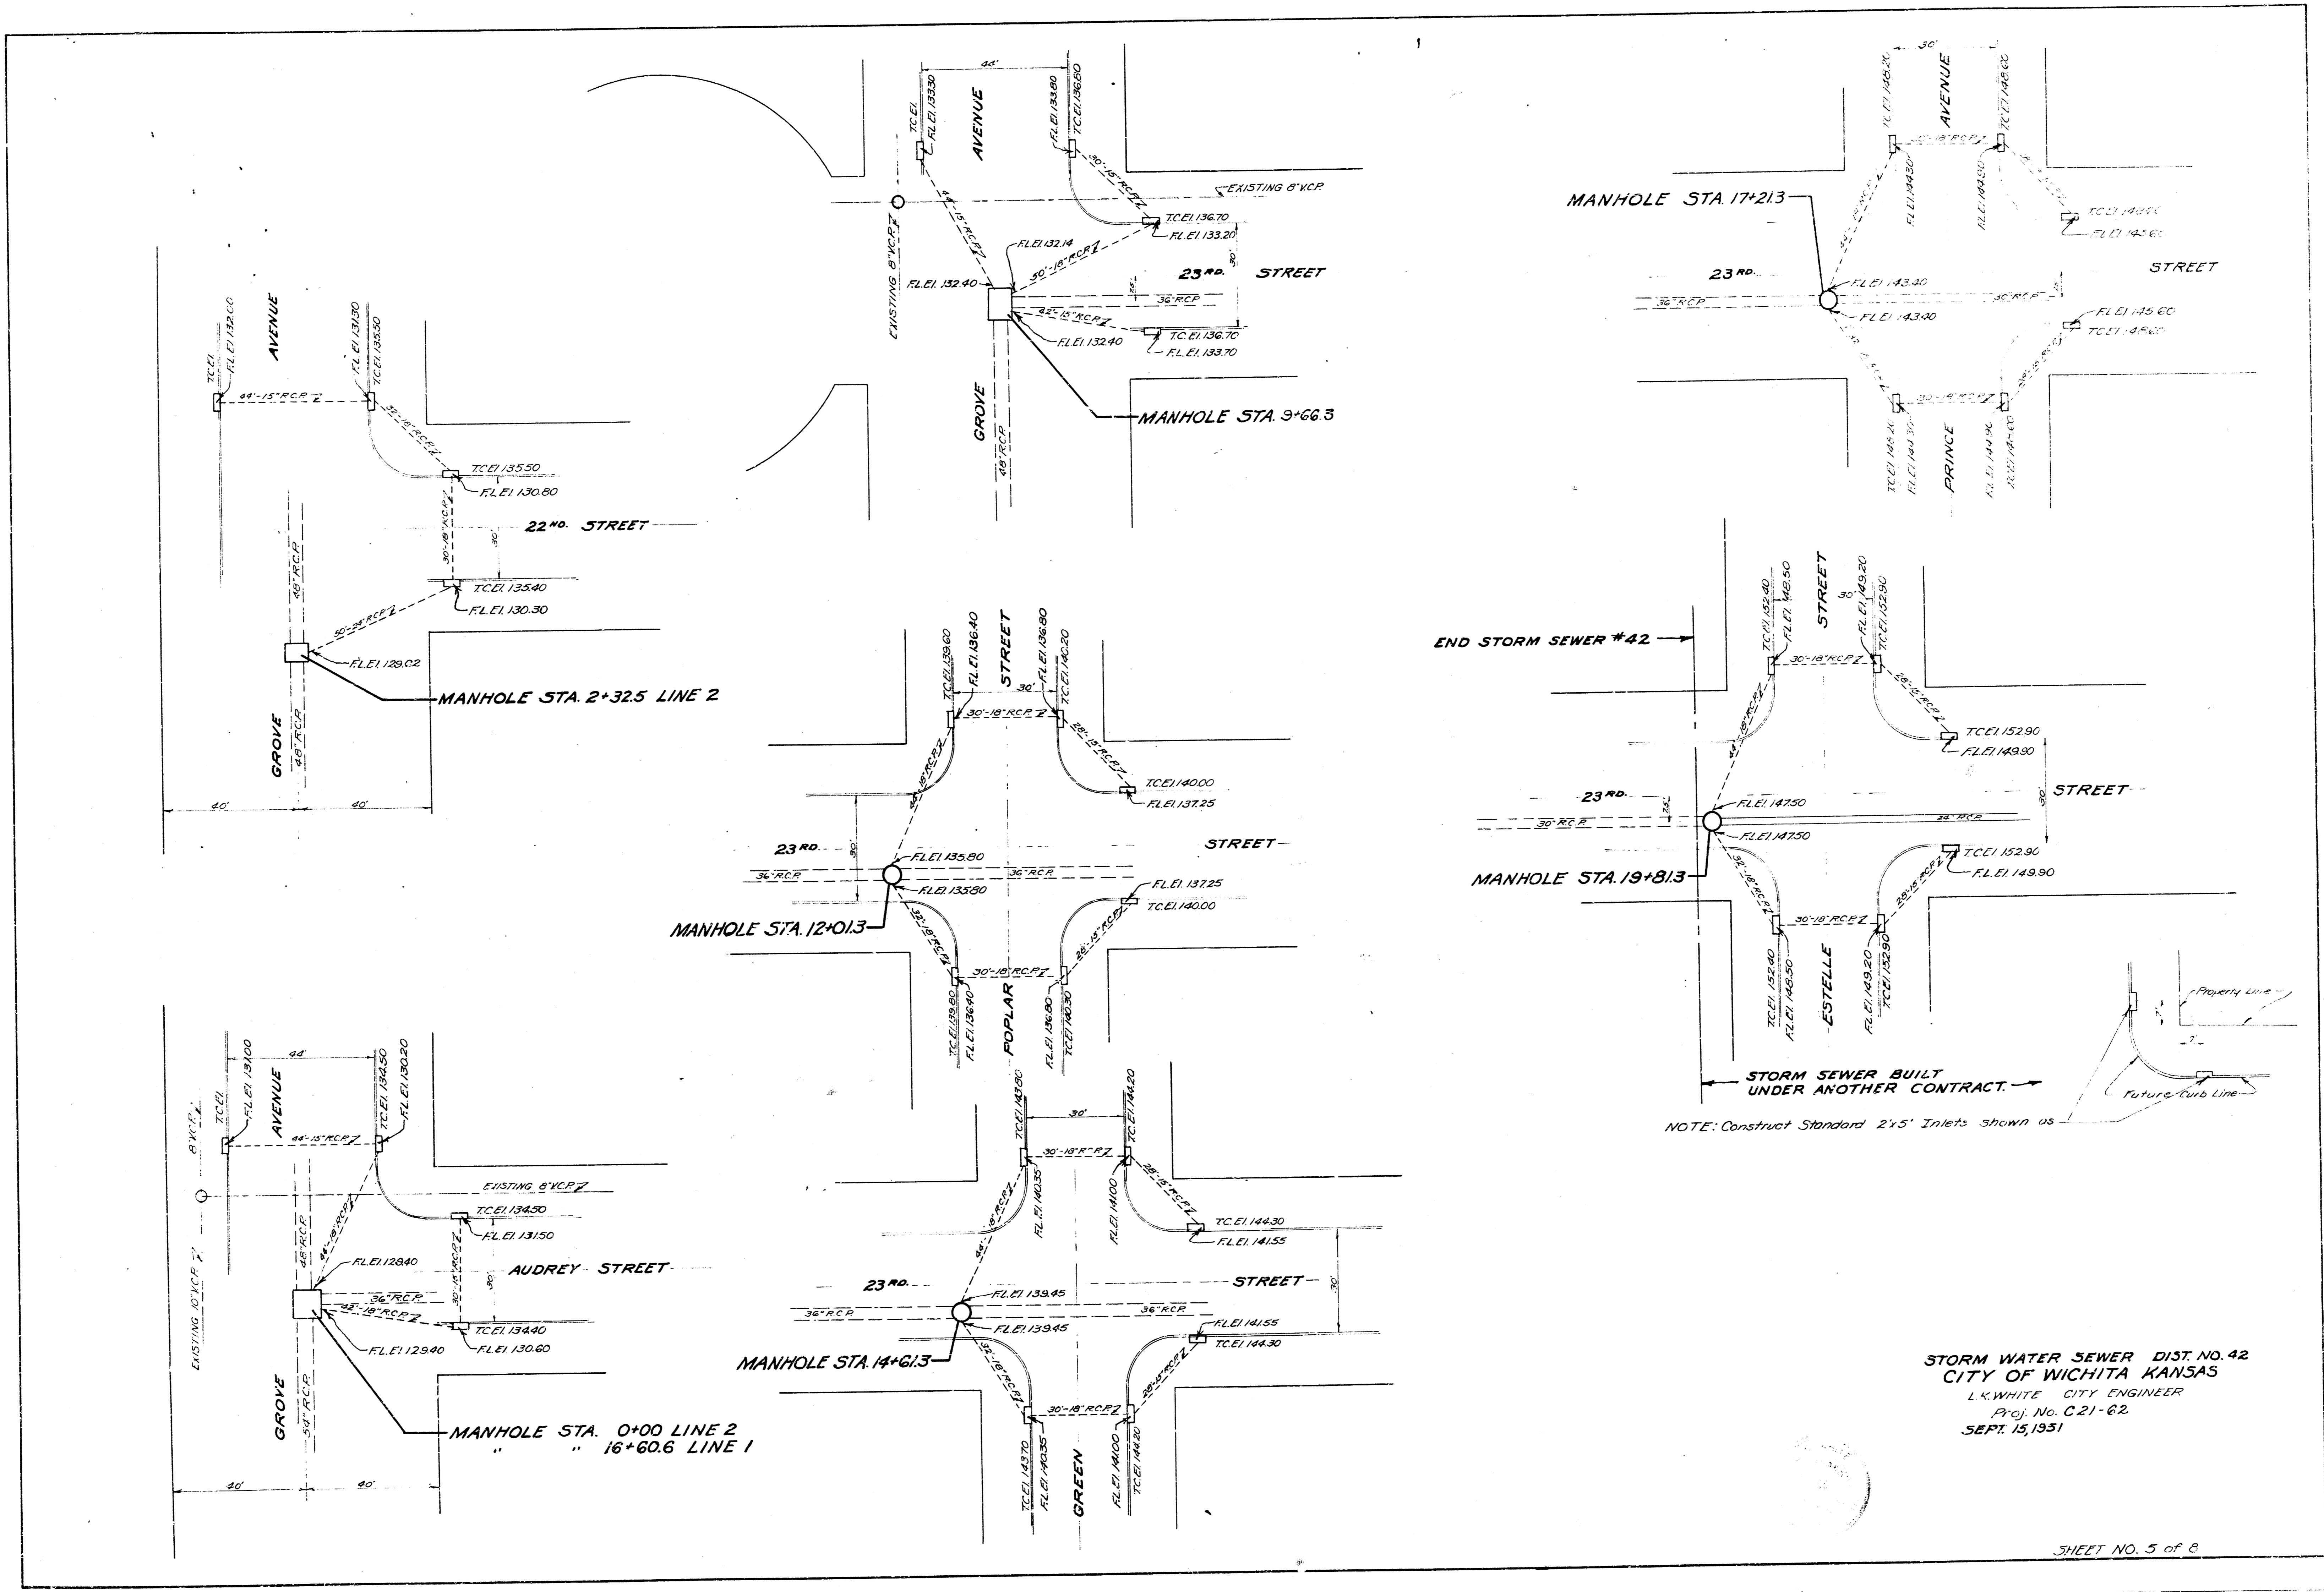


STORM WATER SEWER DIST. NO. 42  
 CITY OF WICHITA KANSAS  
 L. K. WHITE CITY ENGINEER  
 Proj. No. C-21-62  
 SEPT. 15, 1951



MANHOLE STA. 0+00 LINE 1

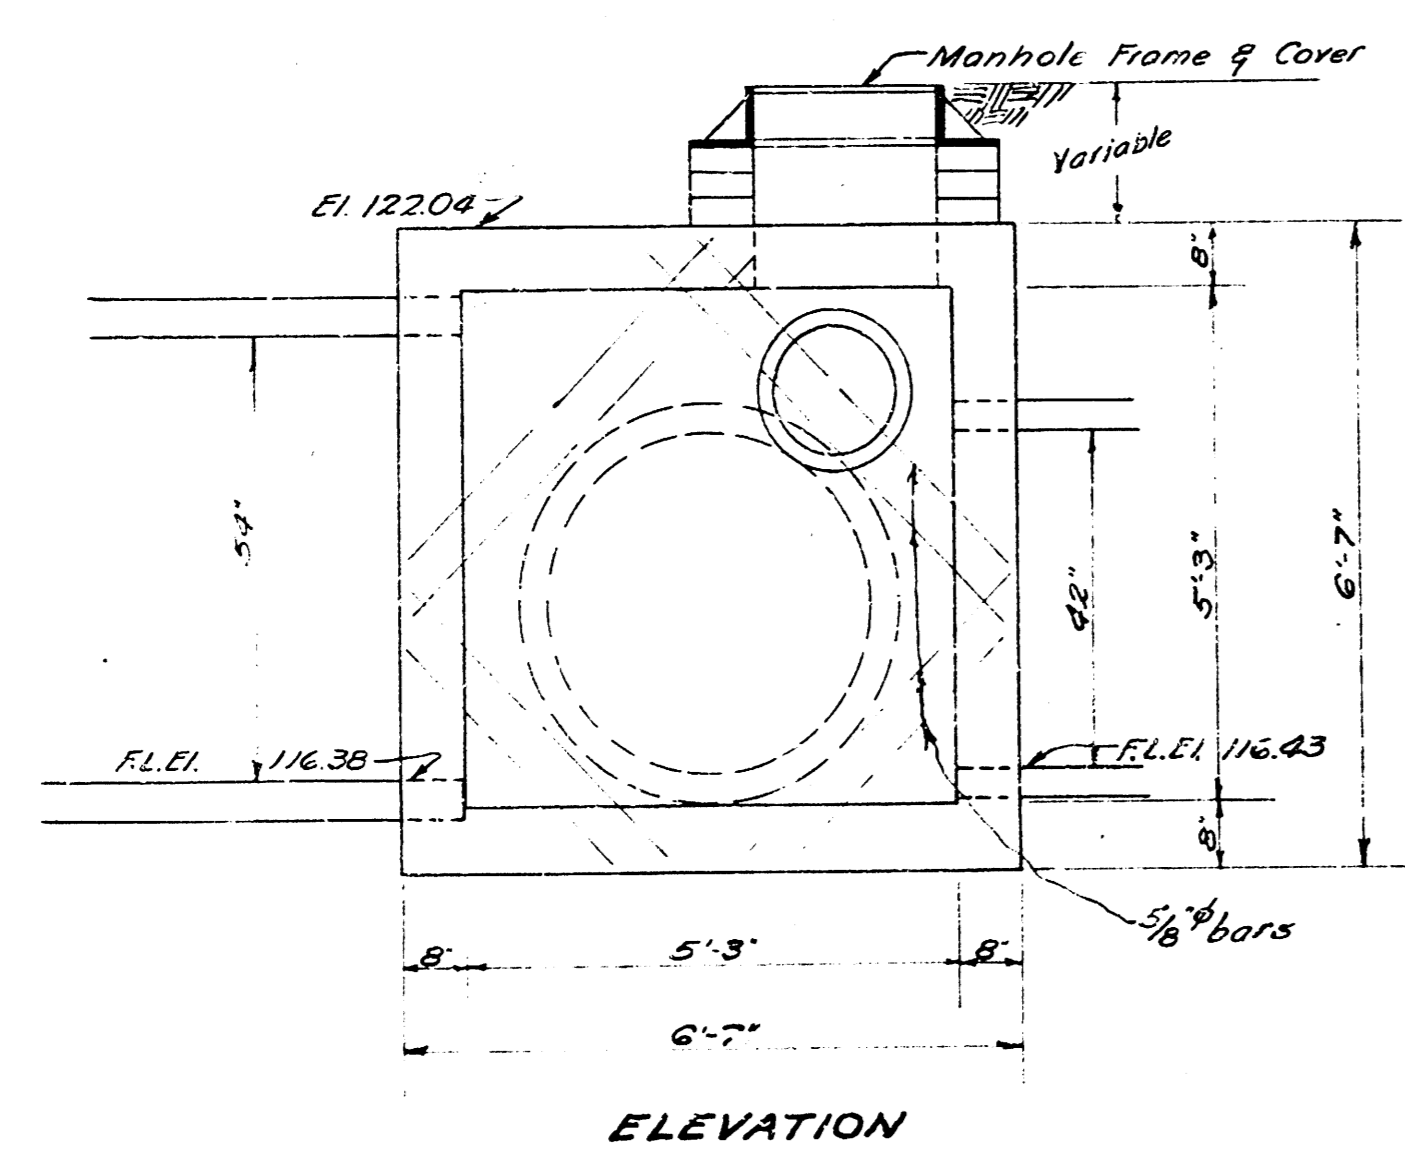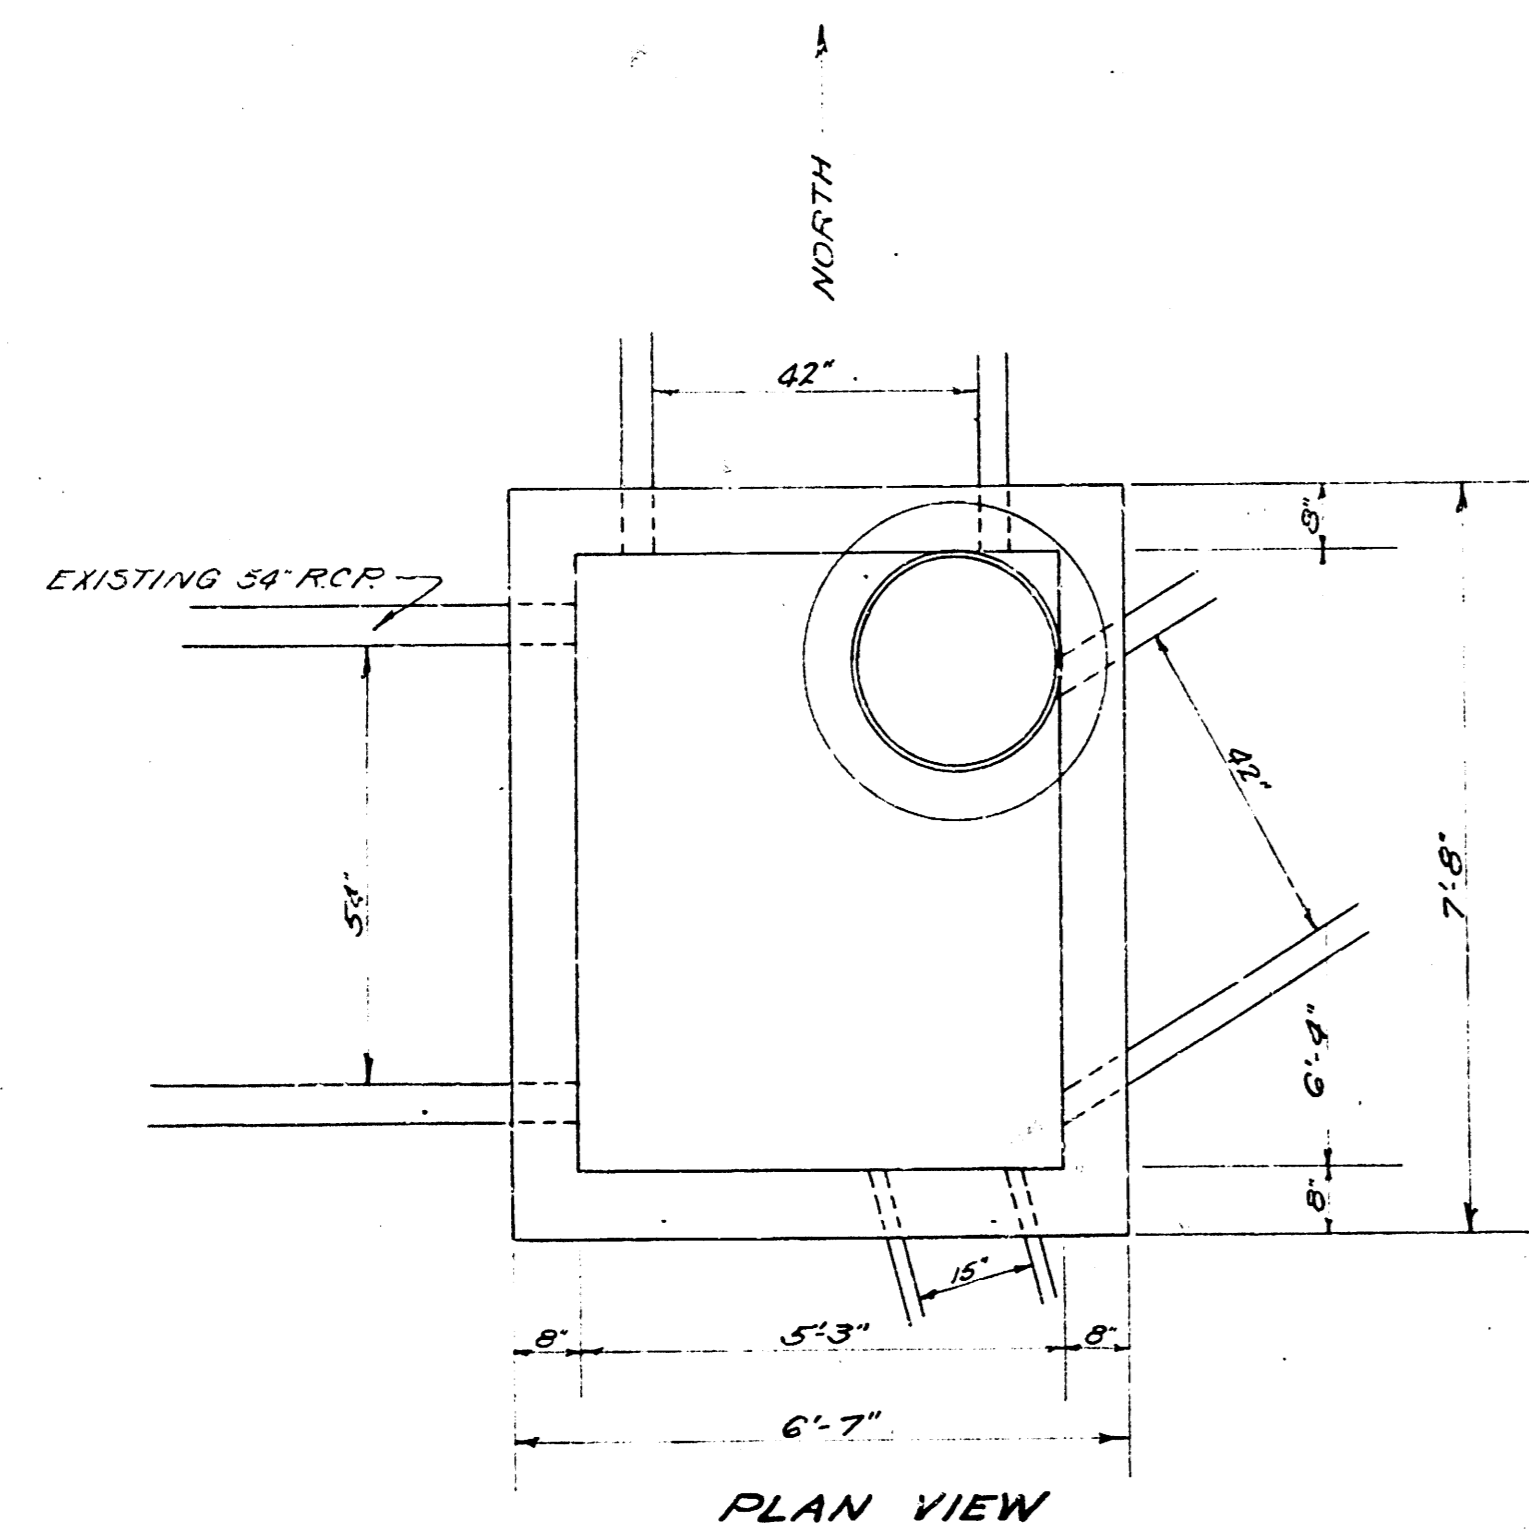



MANHOLE STA. 0+00 LINE 1A

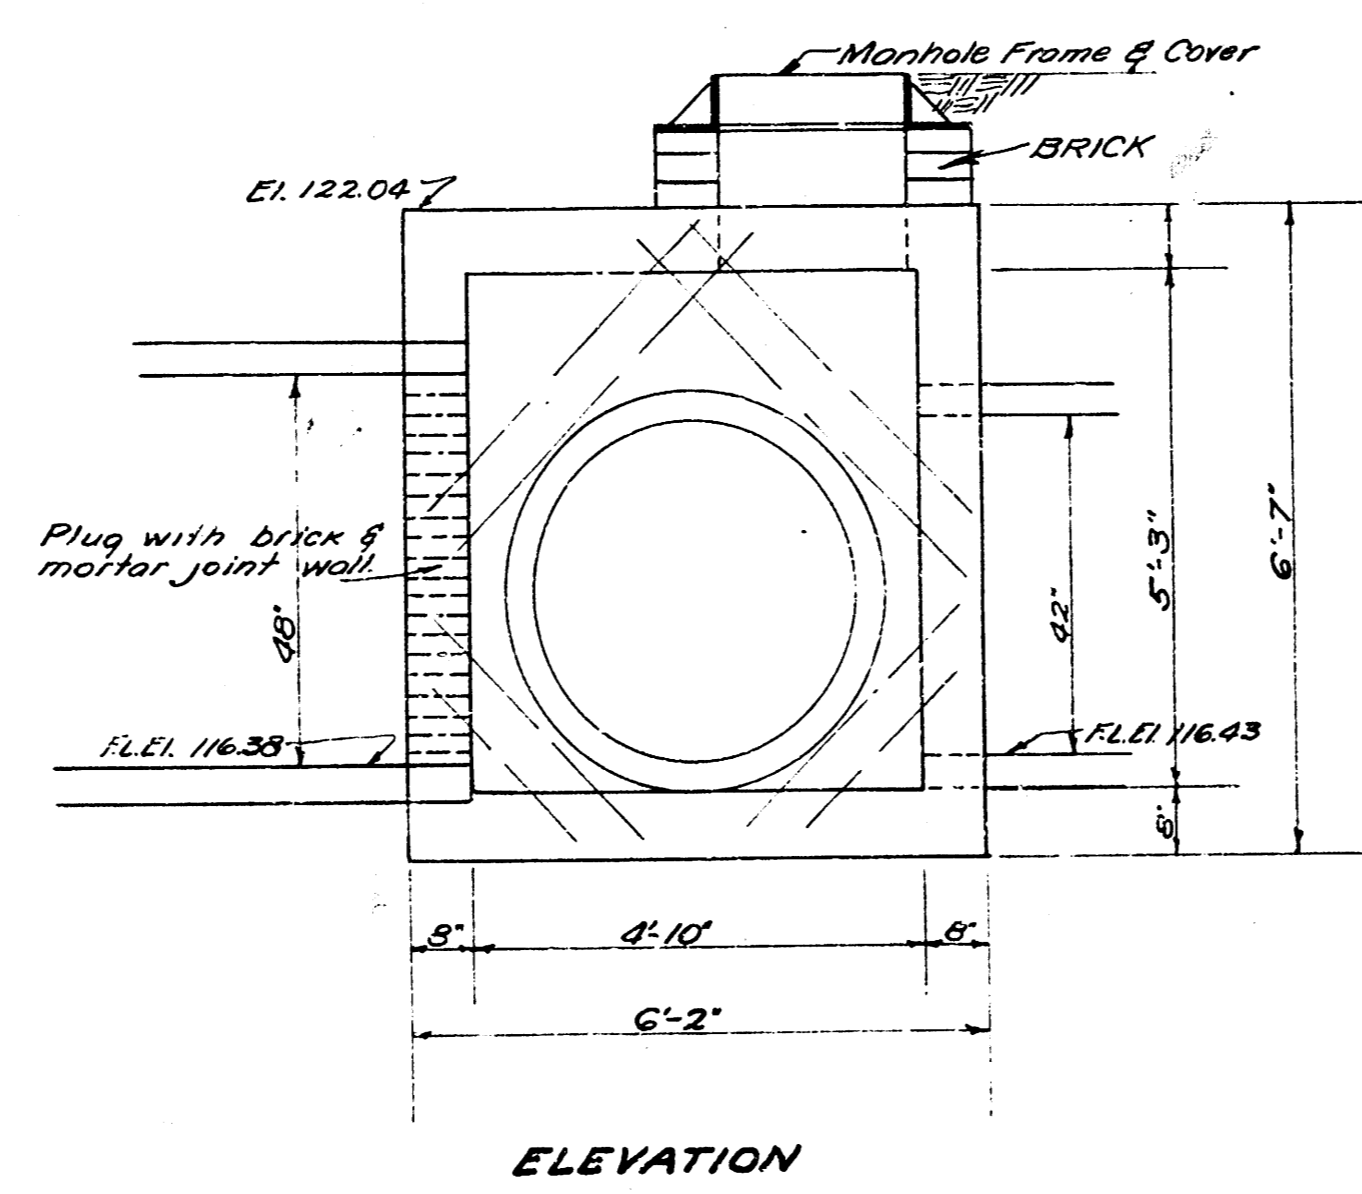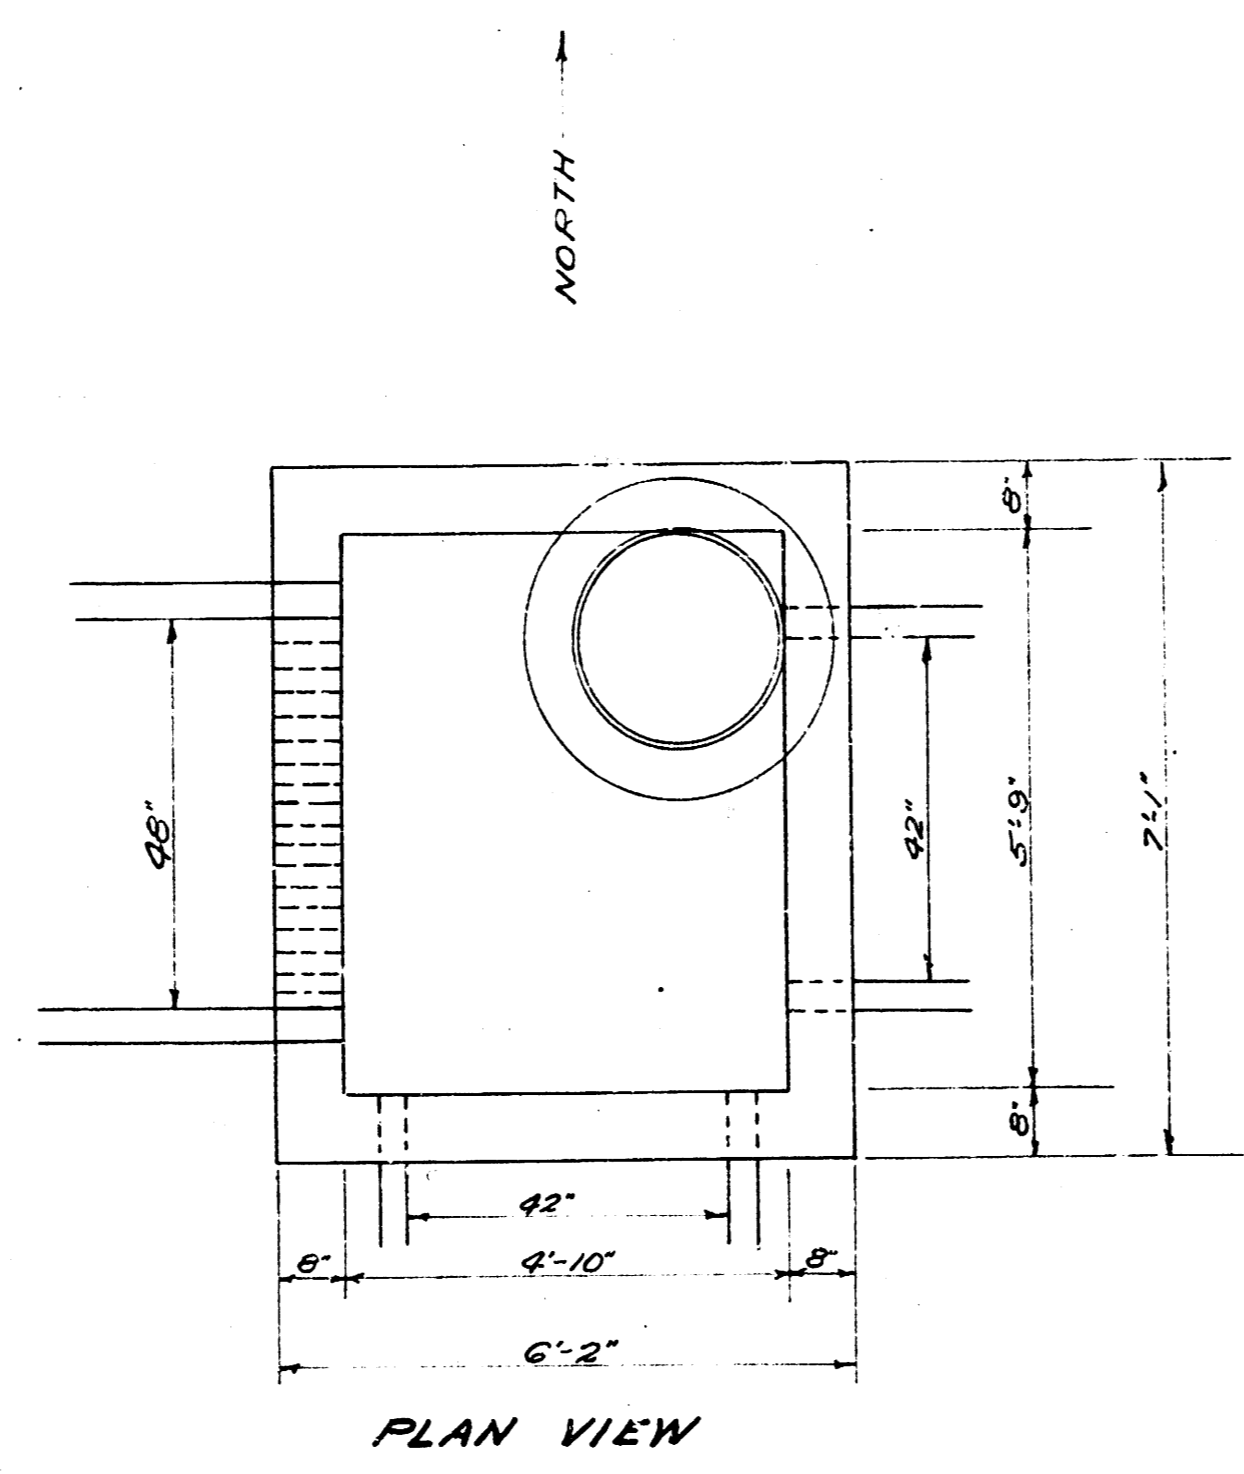

MANHOLE STA. 13+15 LINE 1 & 1A

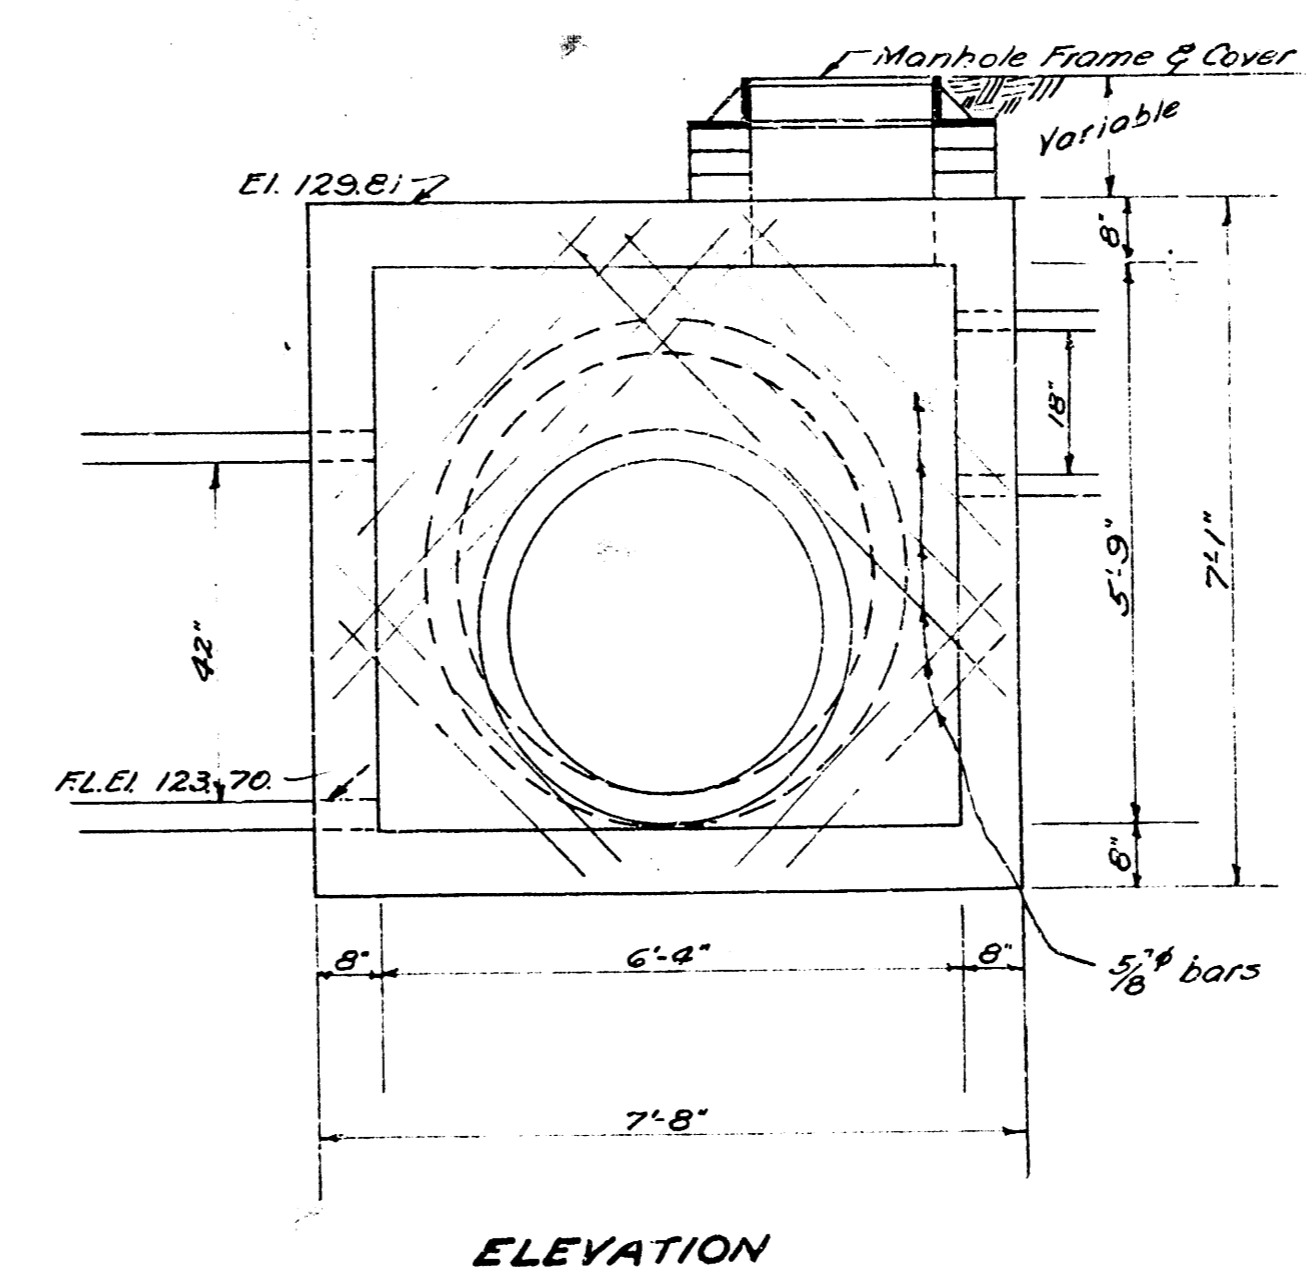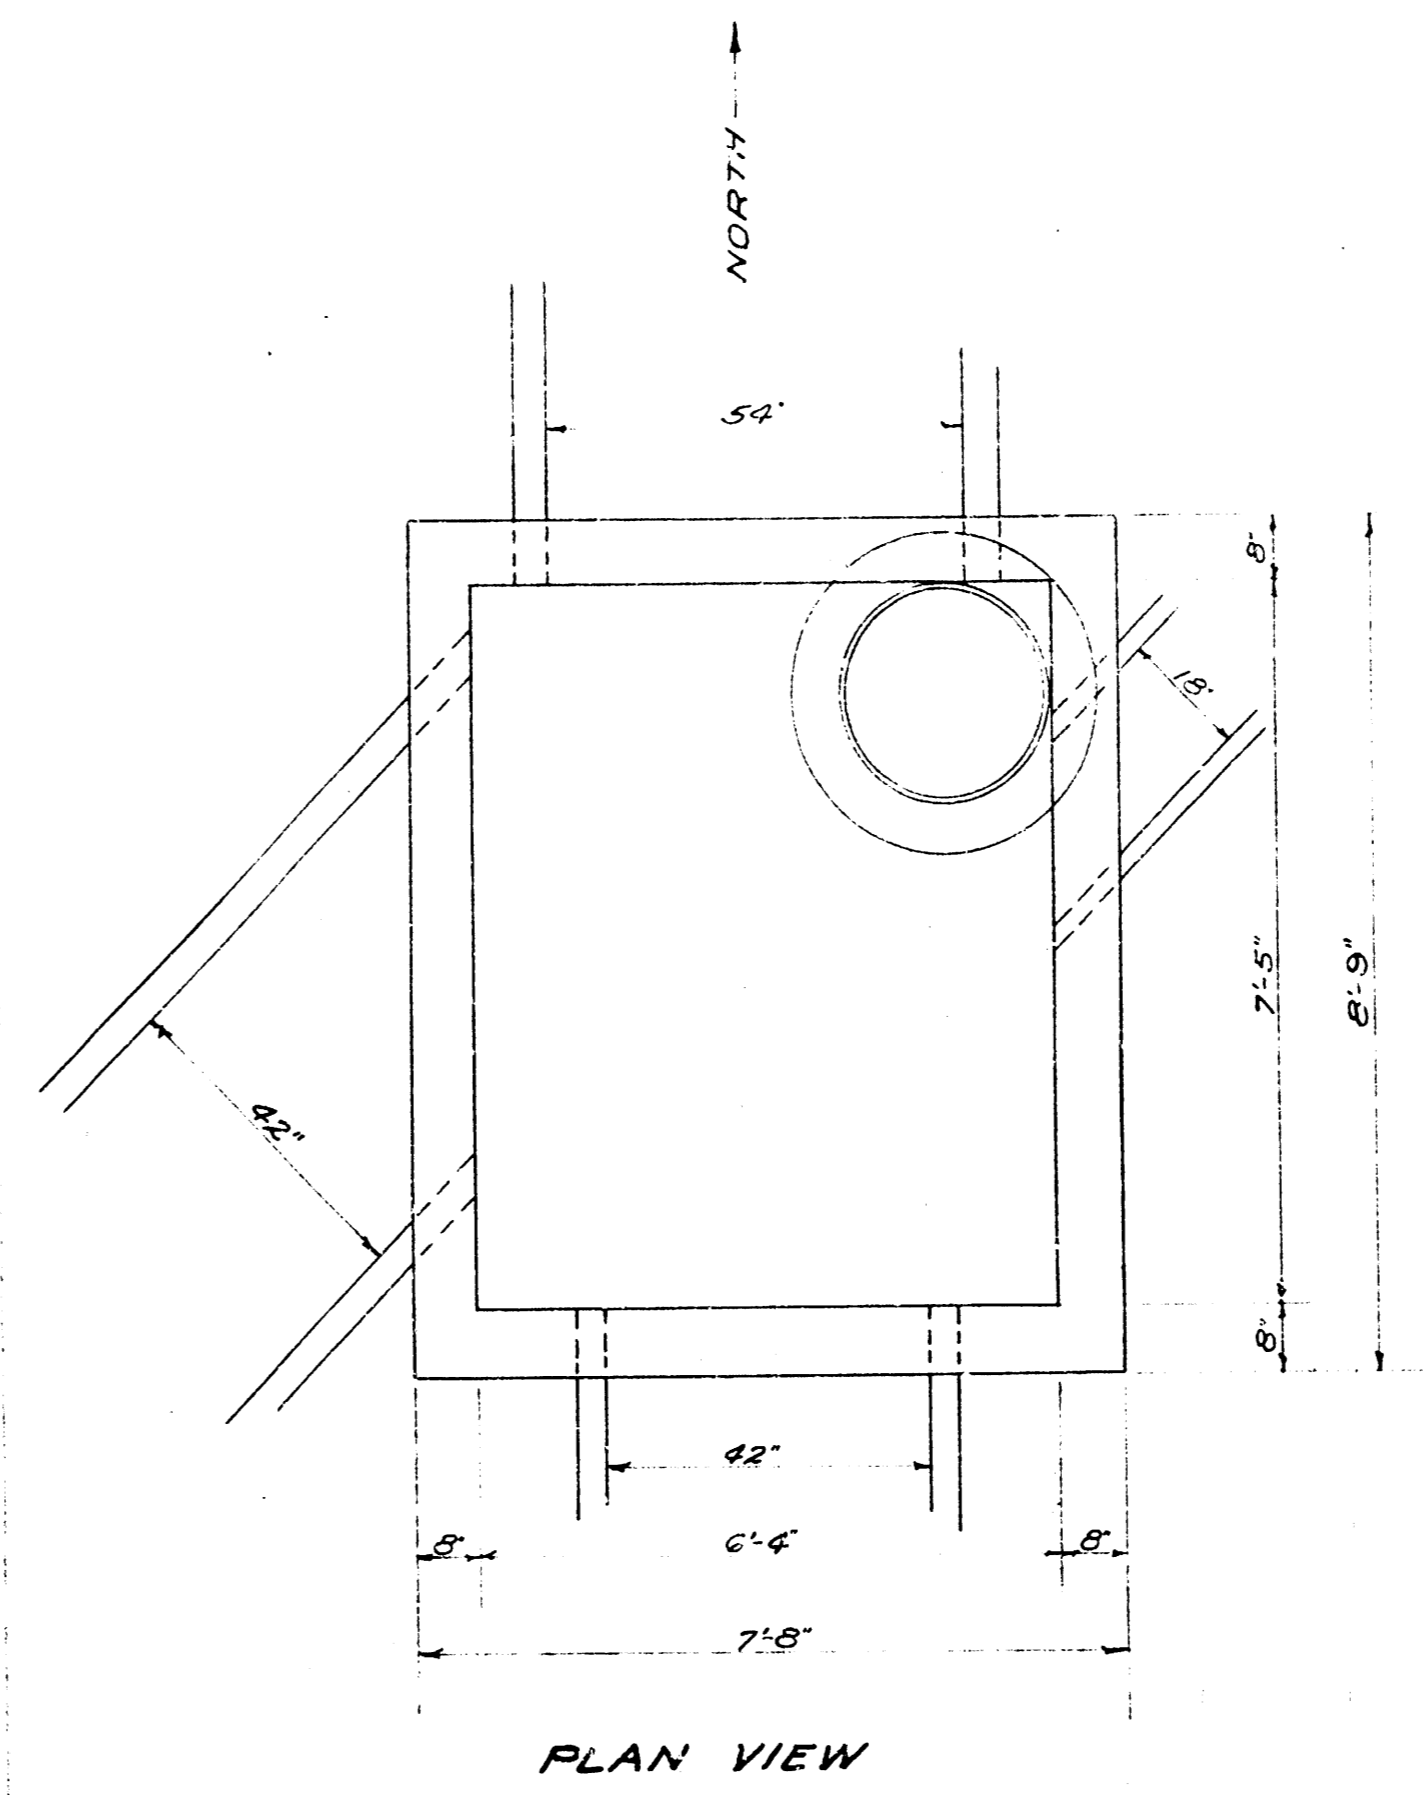








MANHOLE STA. 16+60.6 LINE 1  
0+00 LINE 2

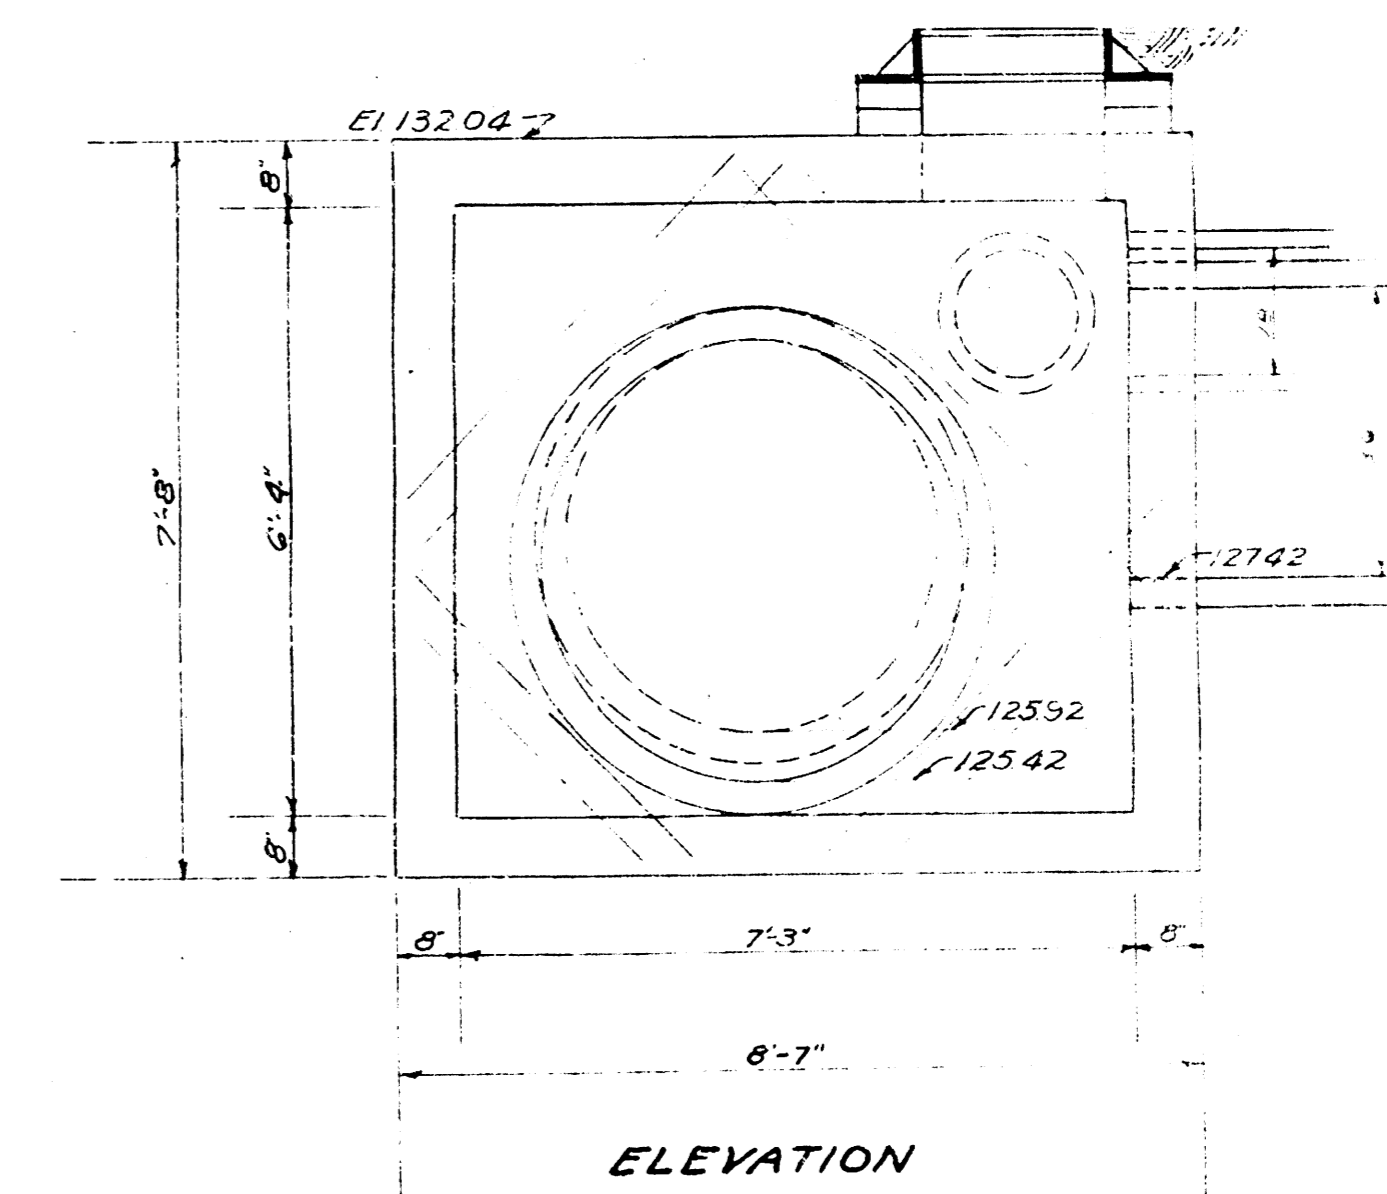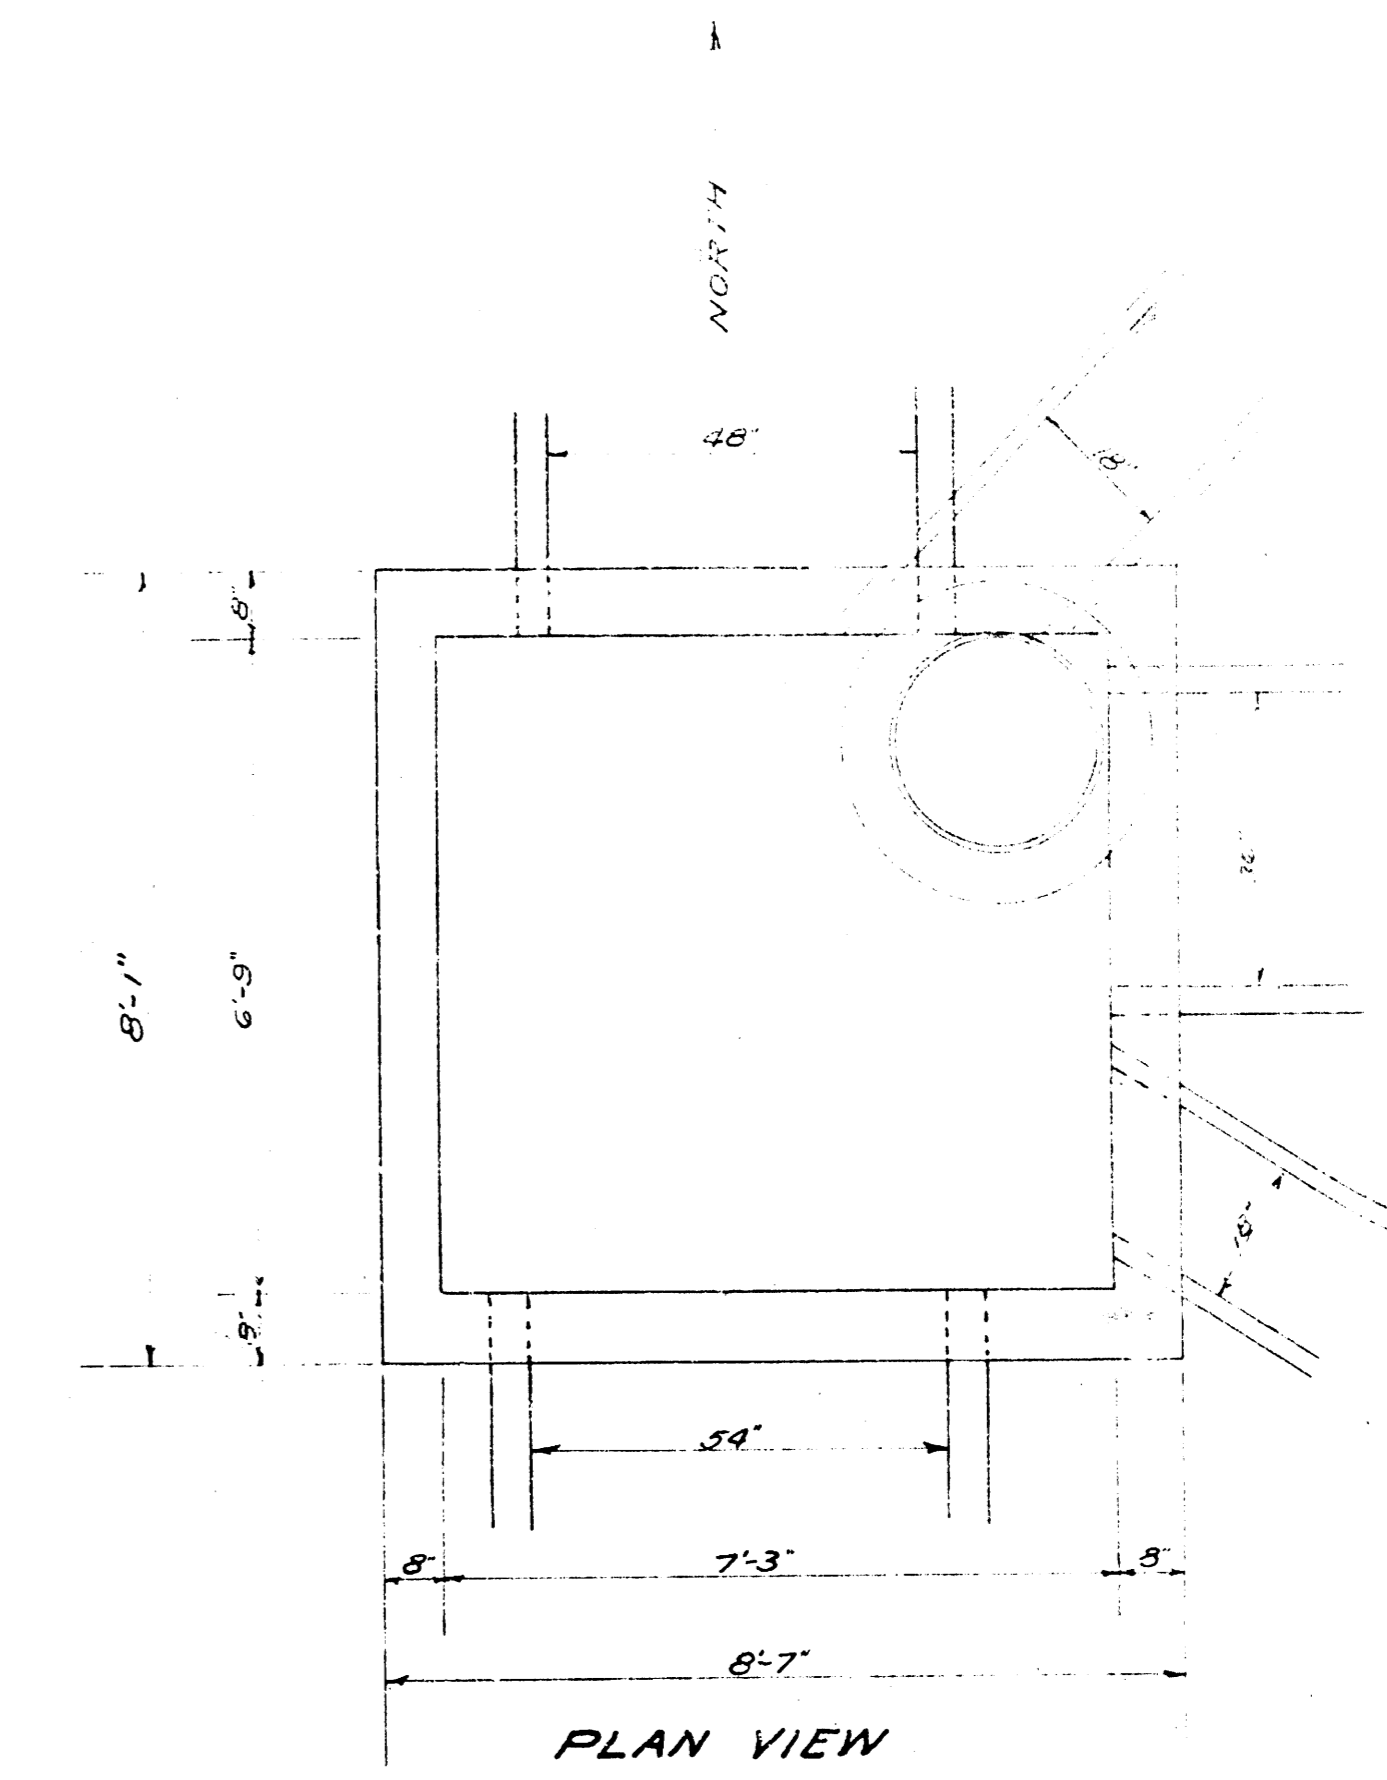

STORM WATER SEWER DIST. NO. 42  
CITY OF WICHITA KANSAS  
L. K. WHITE CITY ENGINEER  
Proj. No. C.21-62  
SEPT. 15, 1951



MANHOLE STA. 2+32.5 LINE 2

MANHOLE STA. 9+66.3 LINE 2

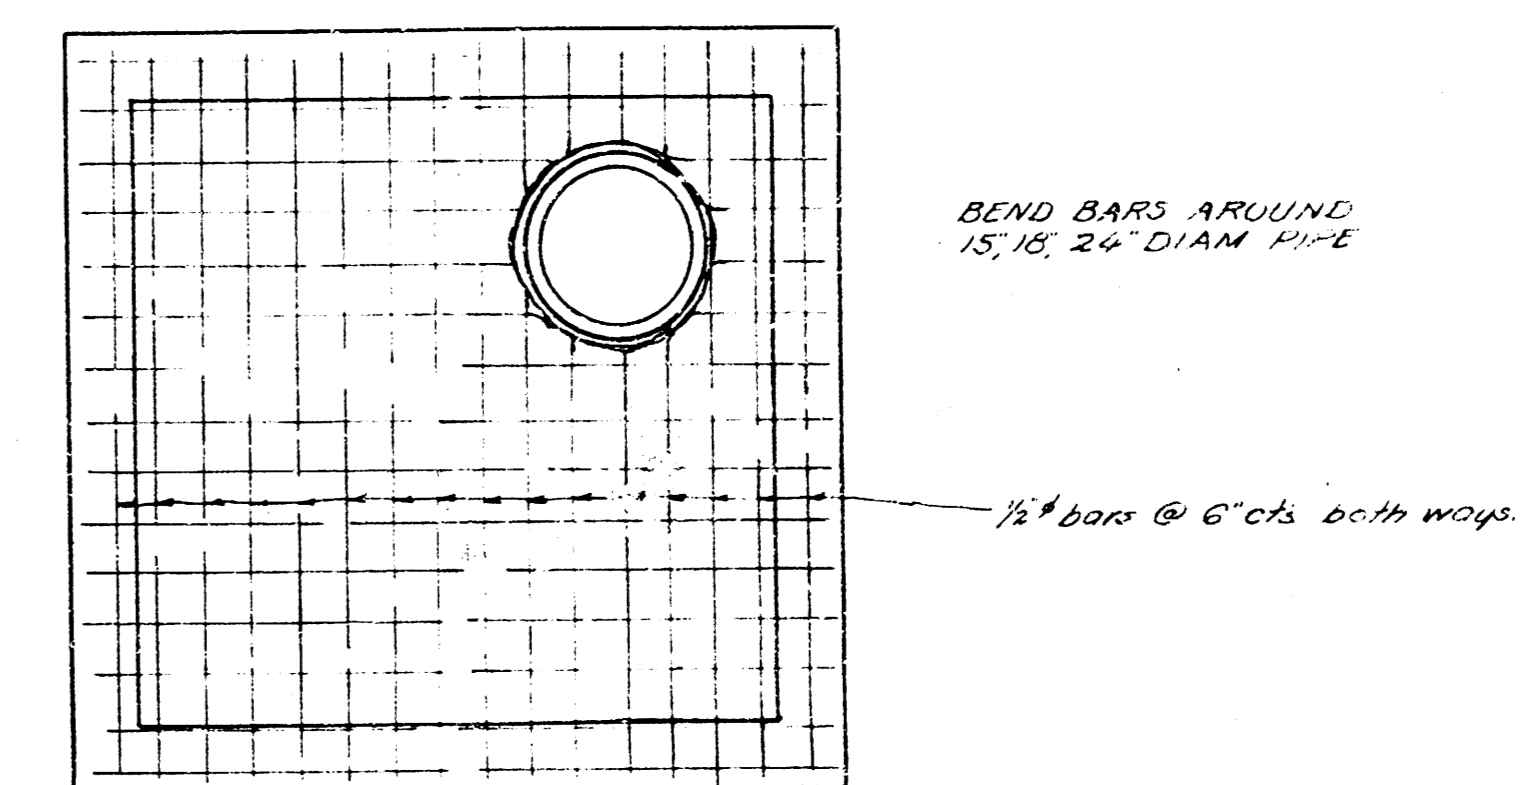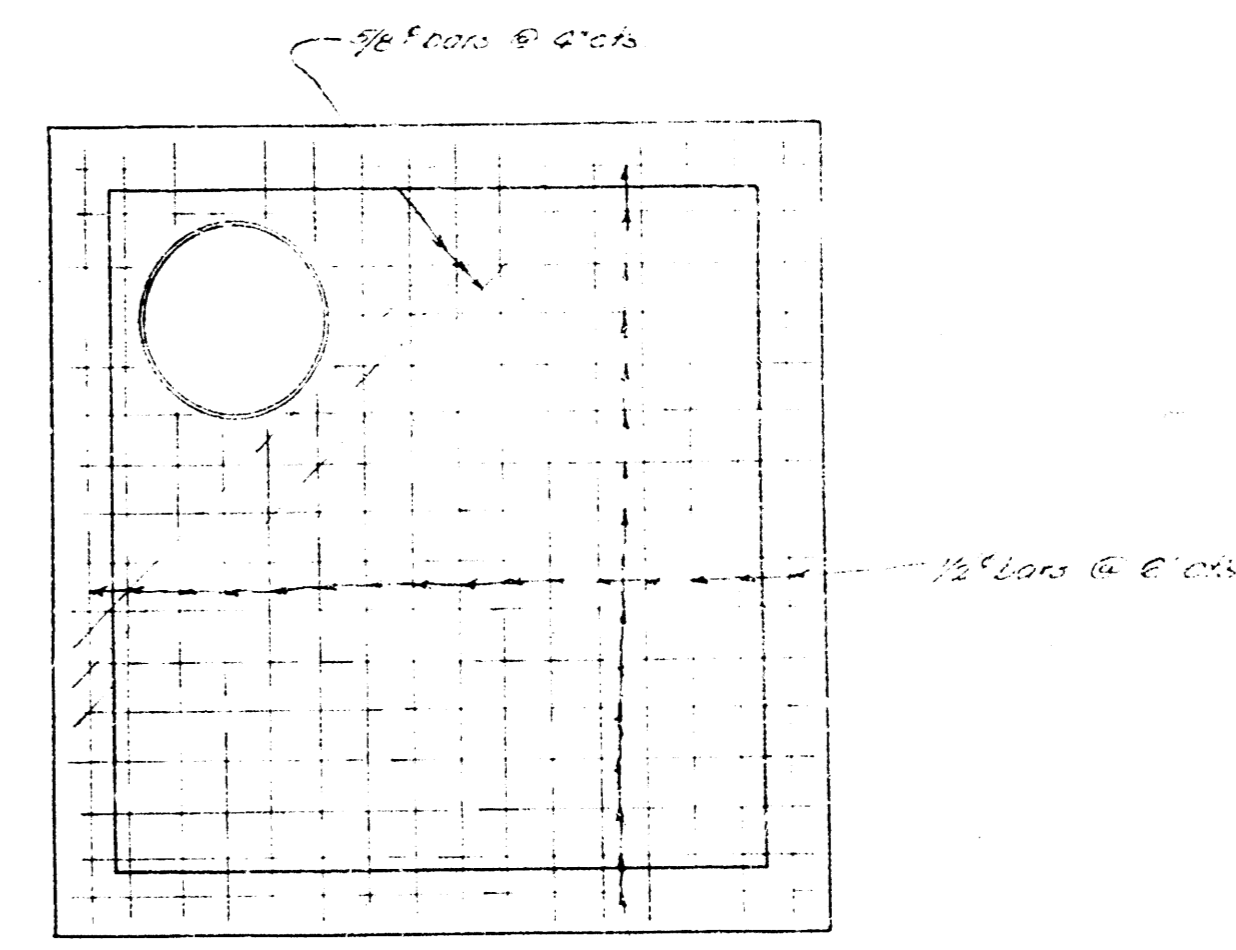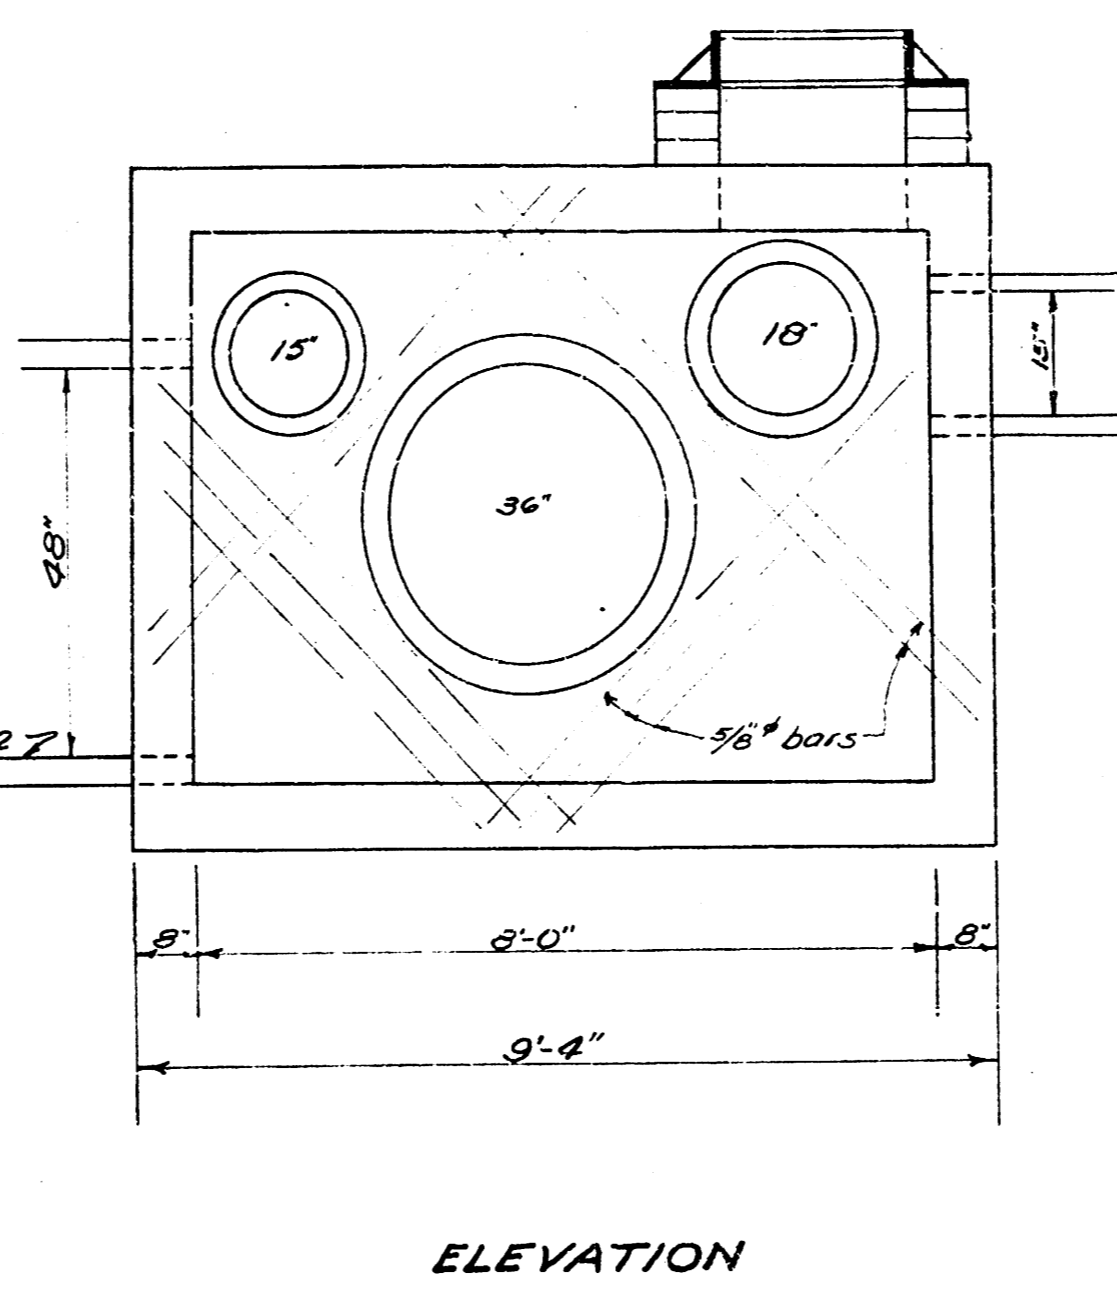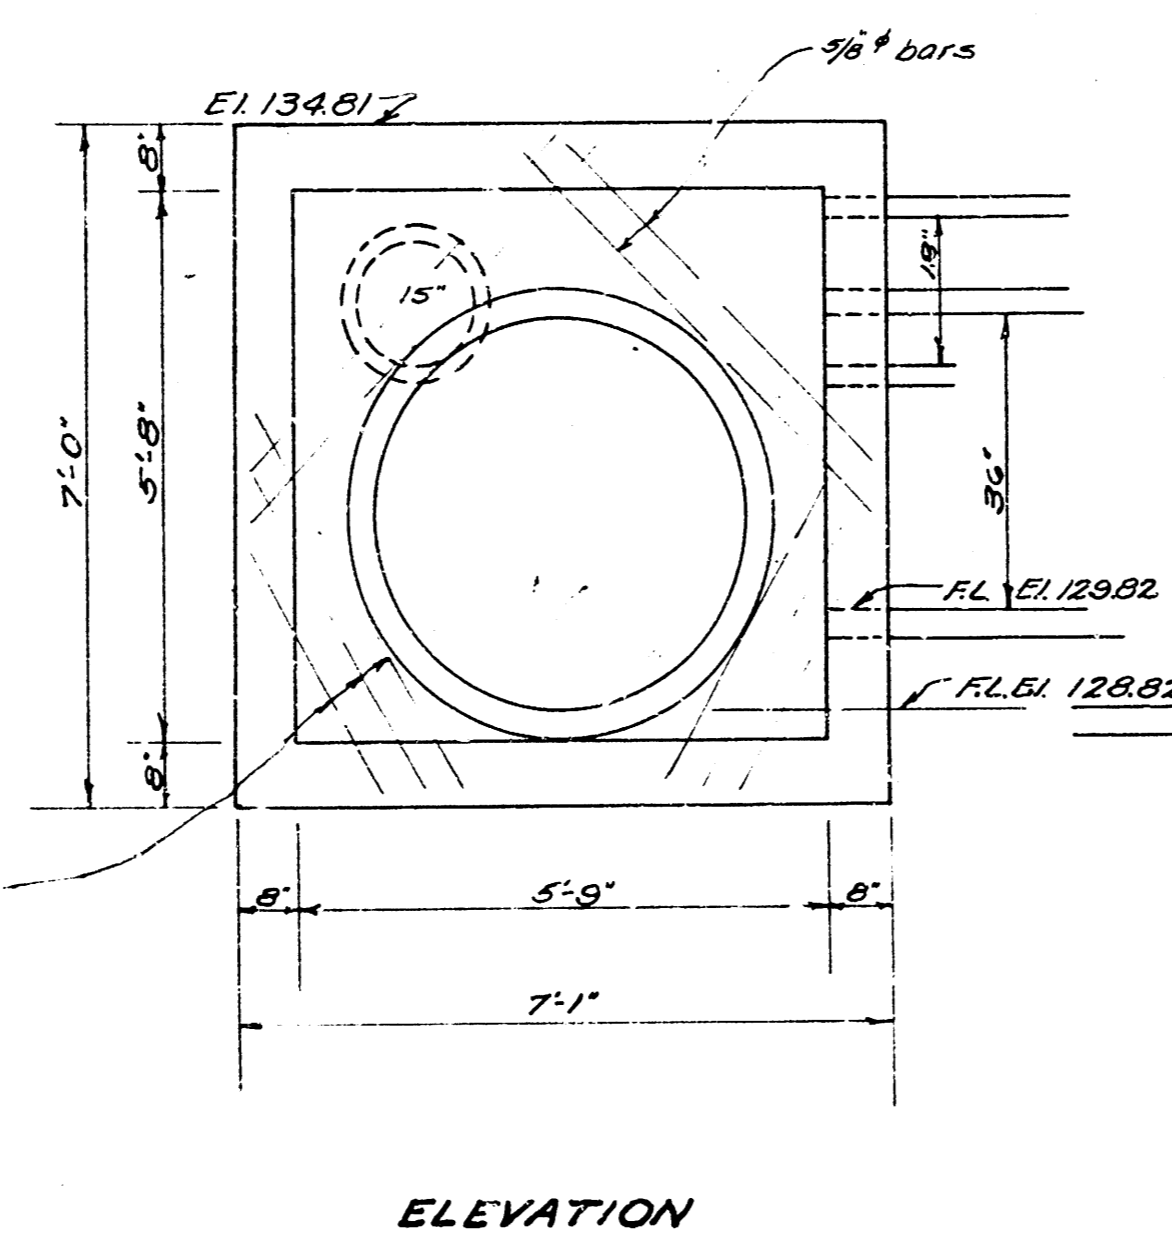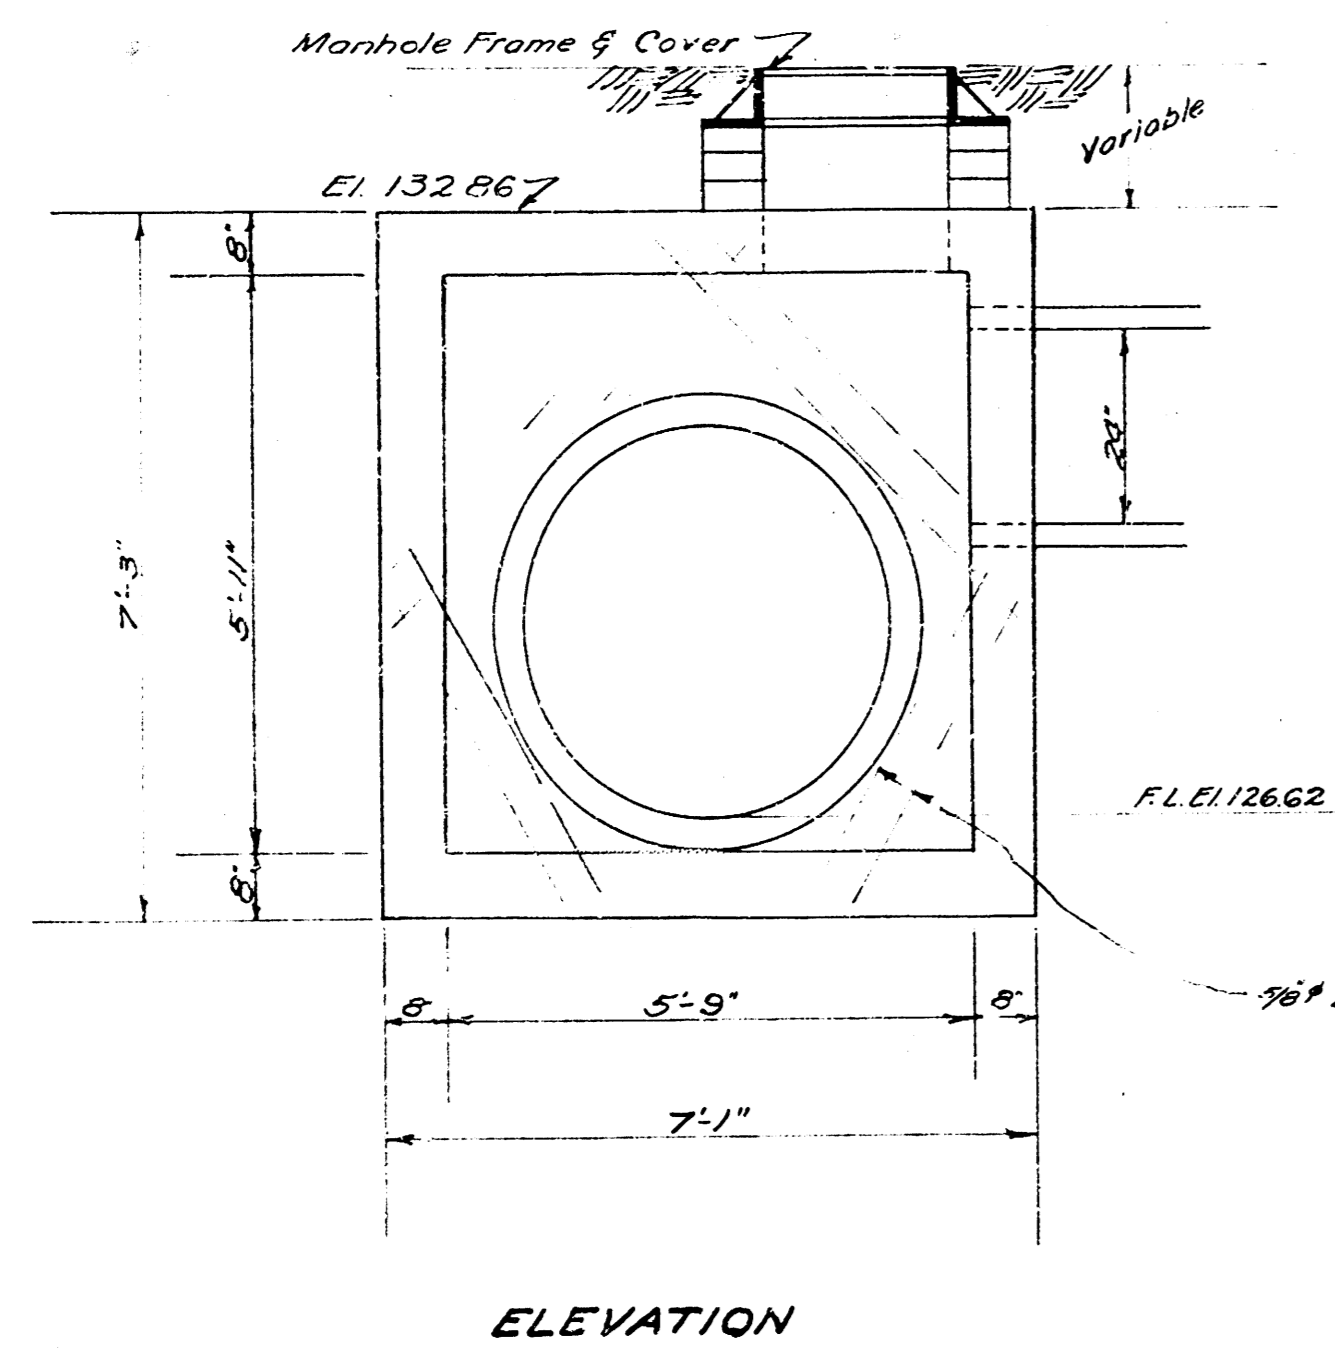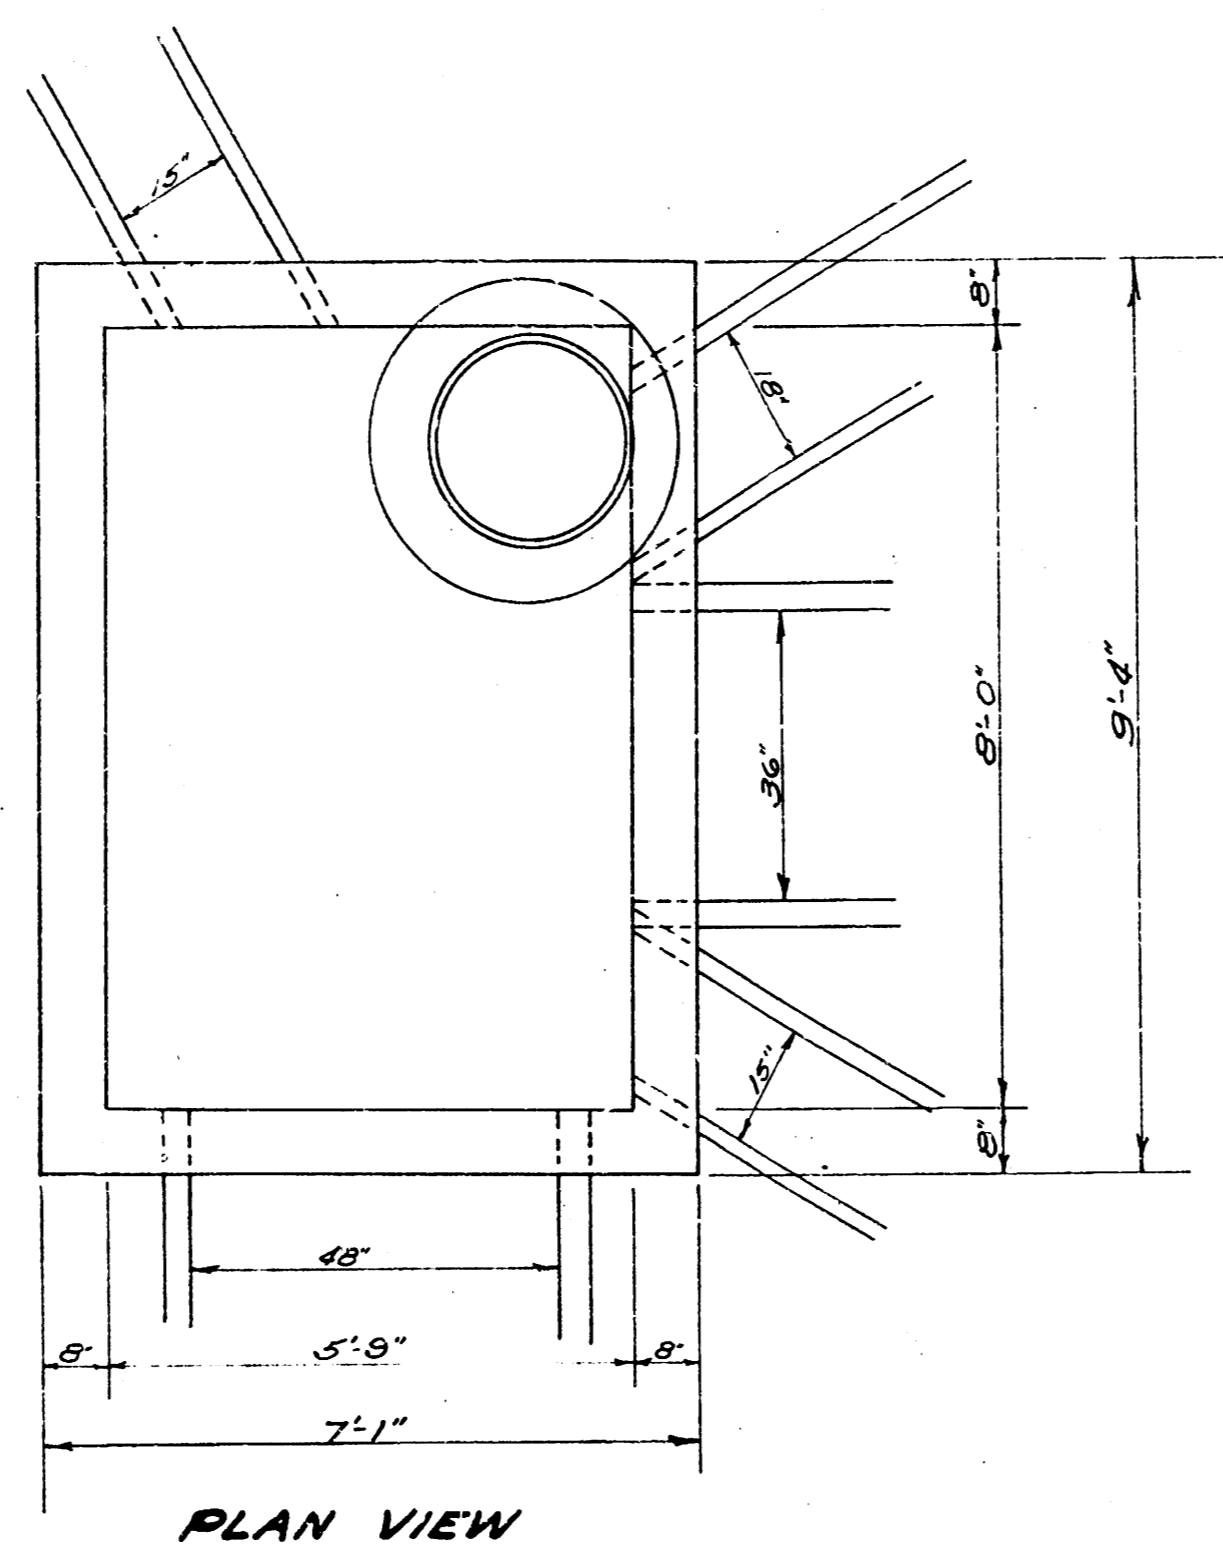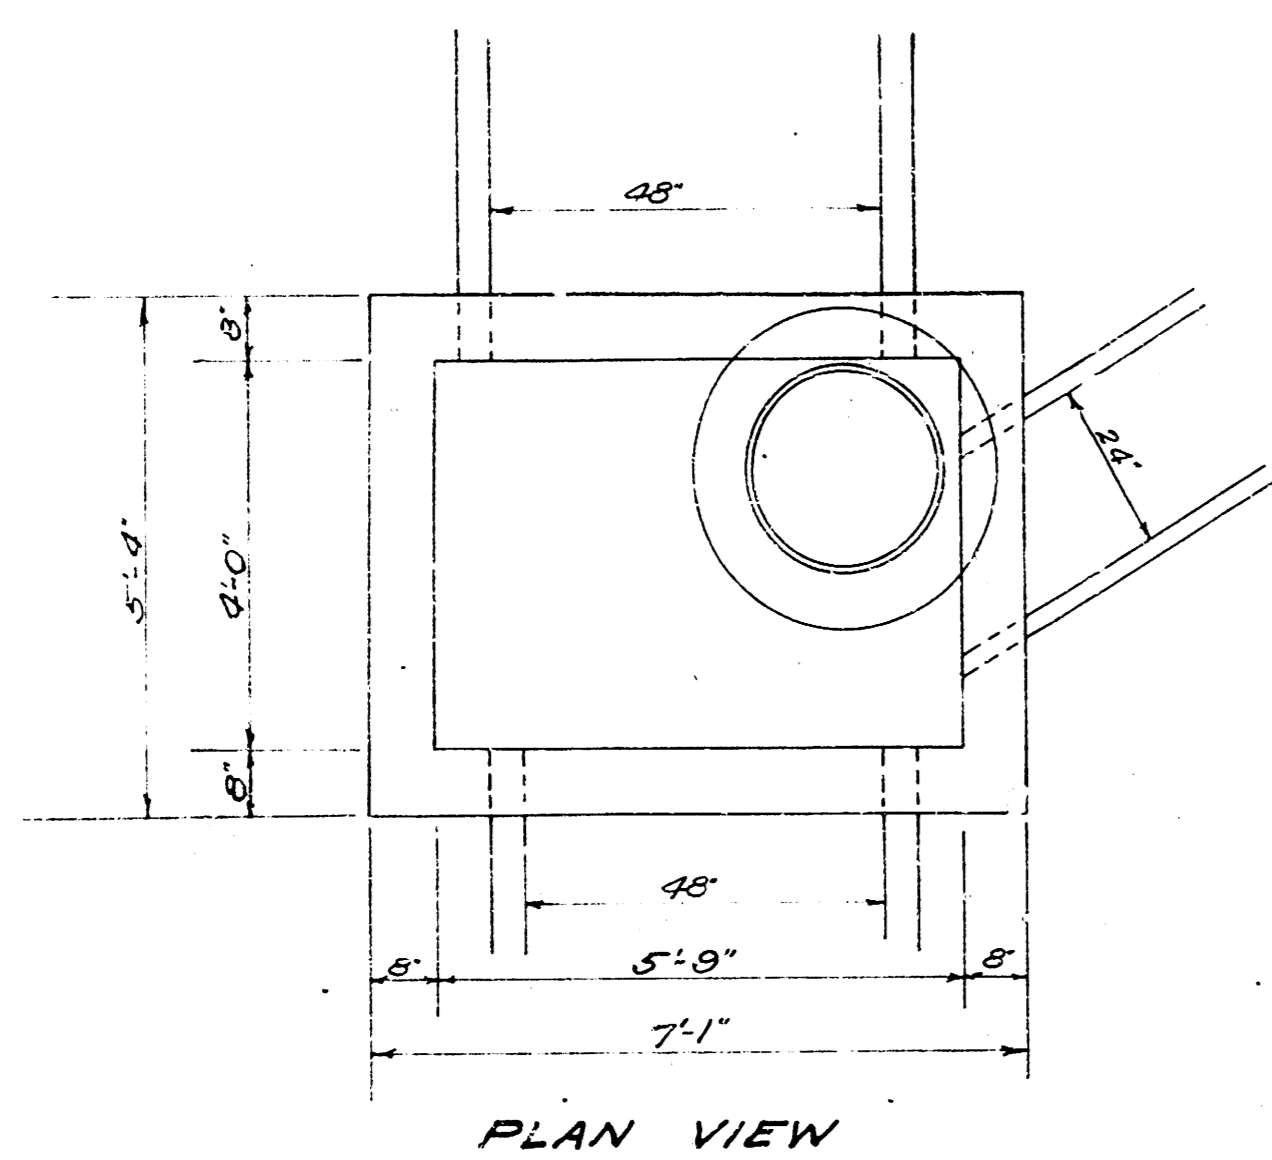


STORM WATER SEWER DIST. NO. 42  
CITY OF WICHITA KANSAS  
L. K. WHITE, CITY ENGINEER  
PROJ. NO. C21-22  
SEPT. 15, 1951

MANHOLE STA. 7+04.8 LINE 1A

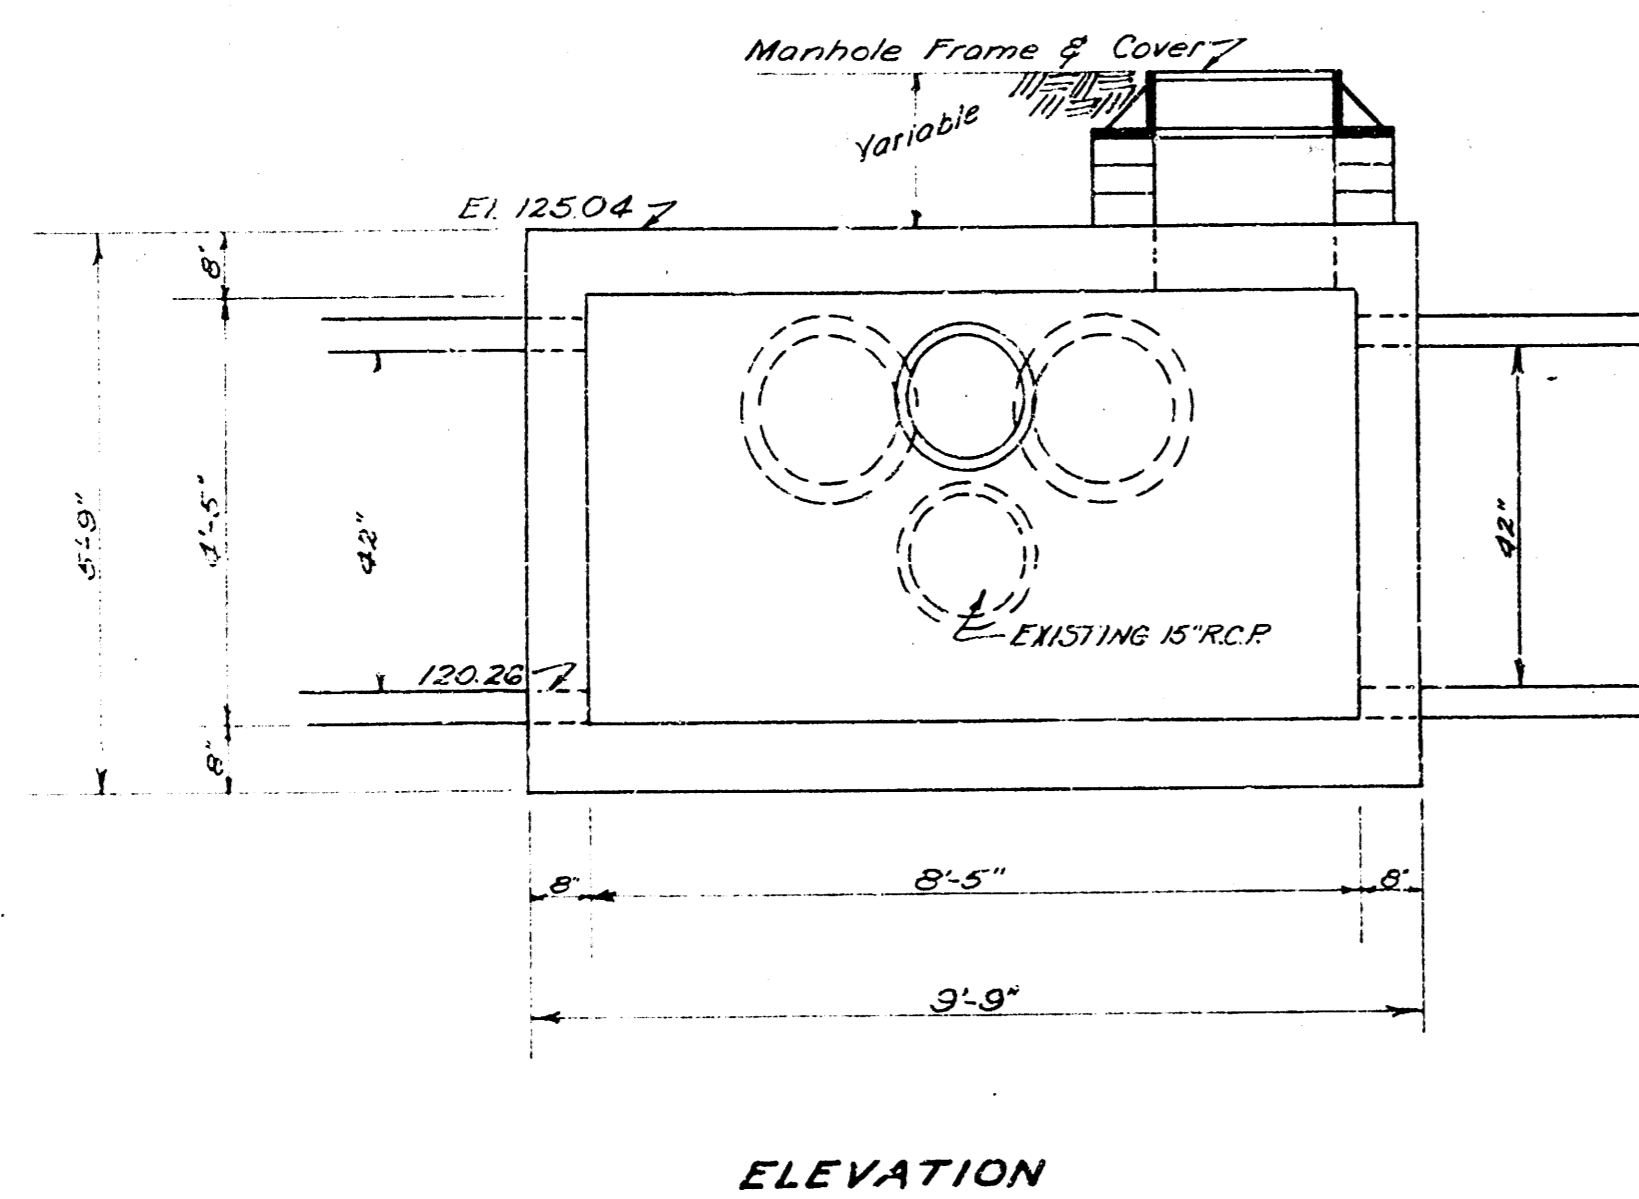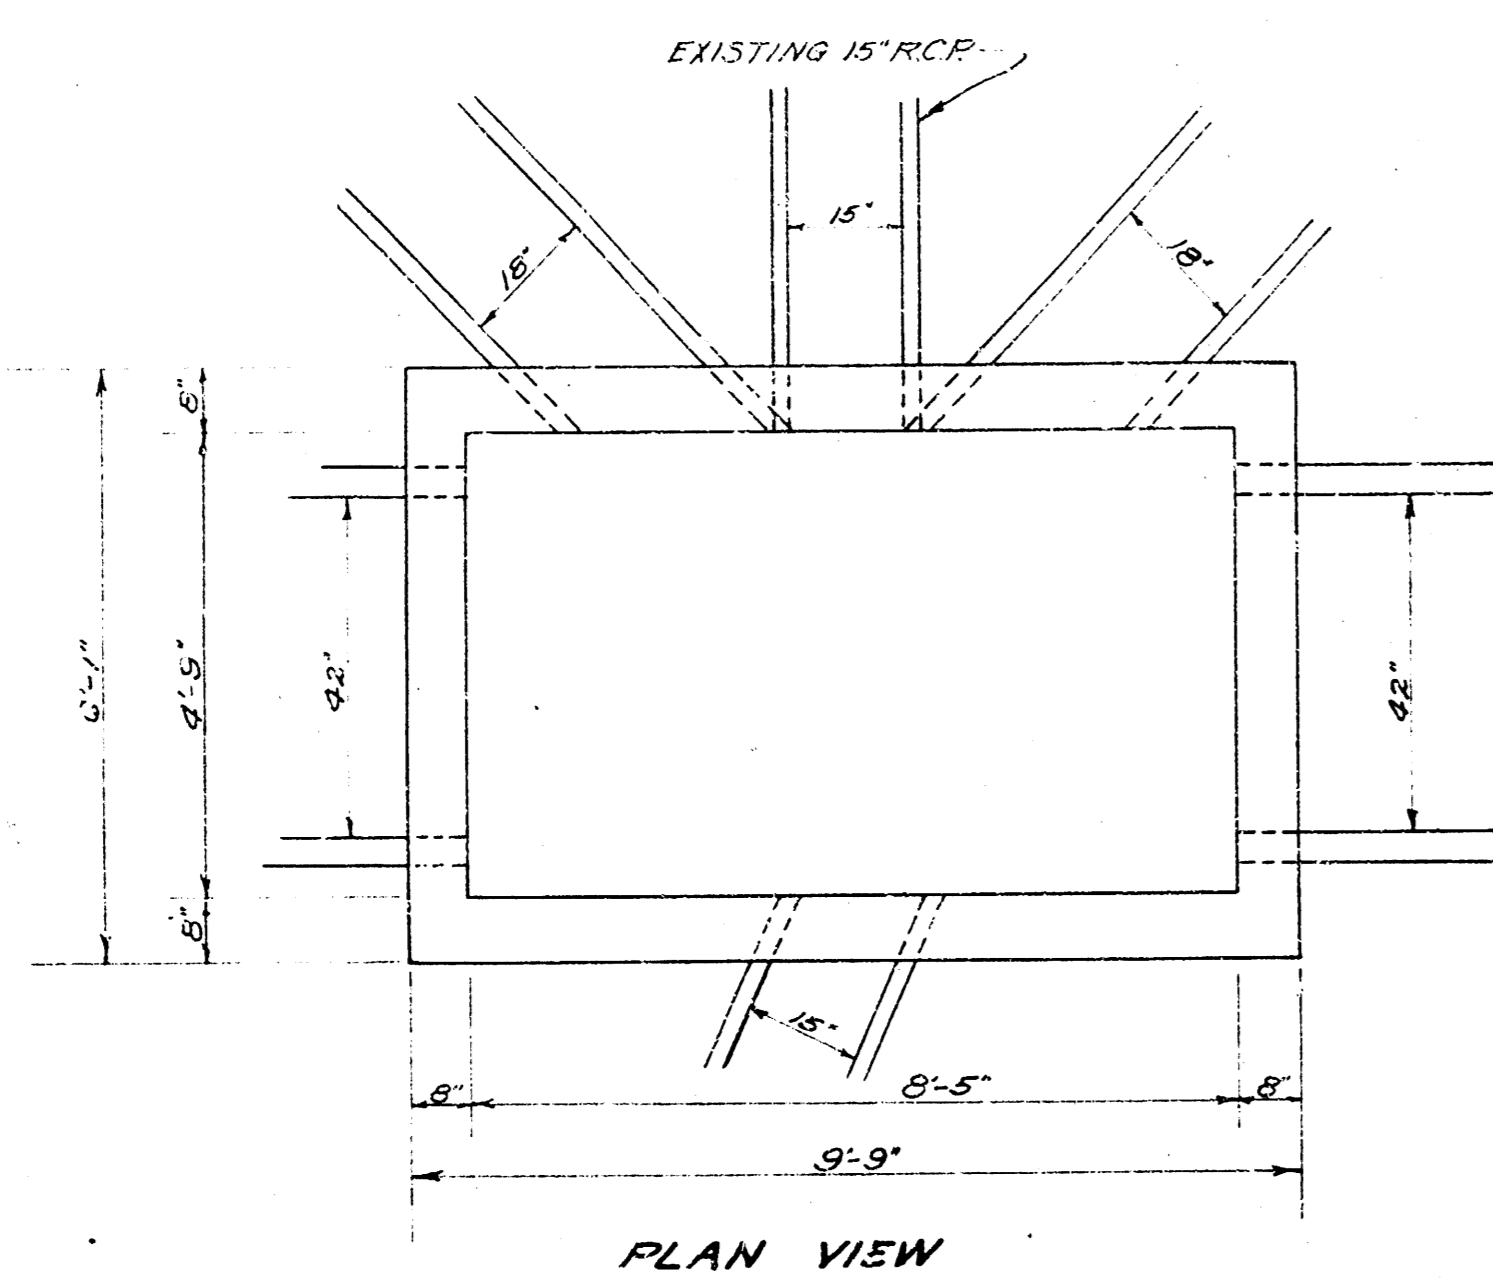

CONCRETE ENCASEMENT DETAIL  
No Scale

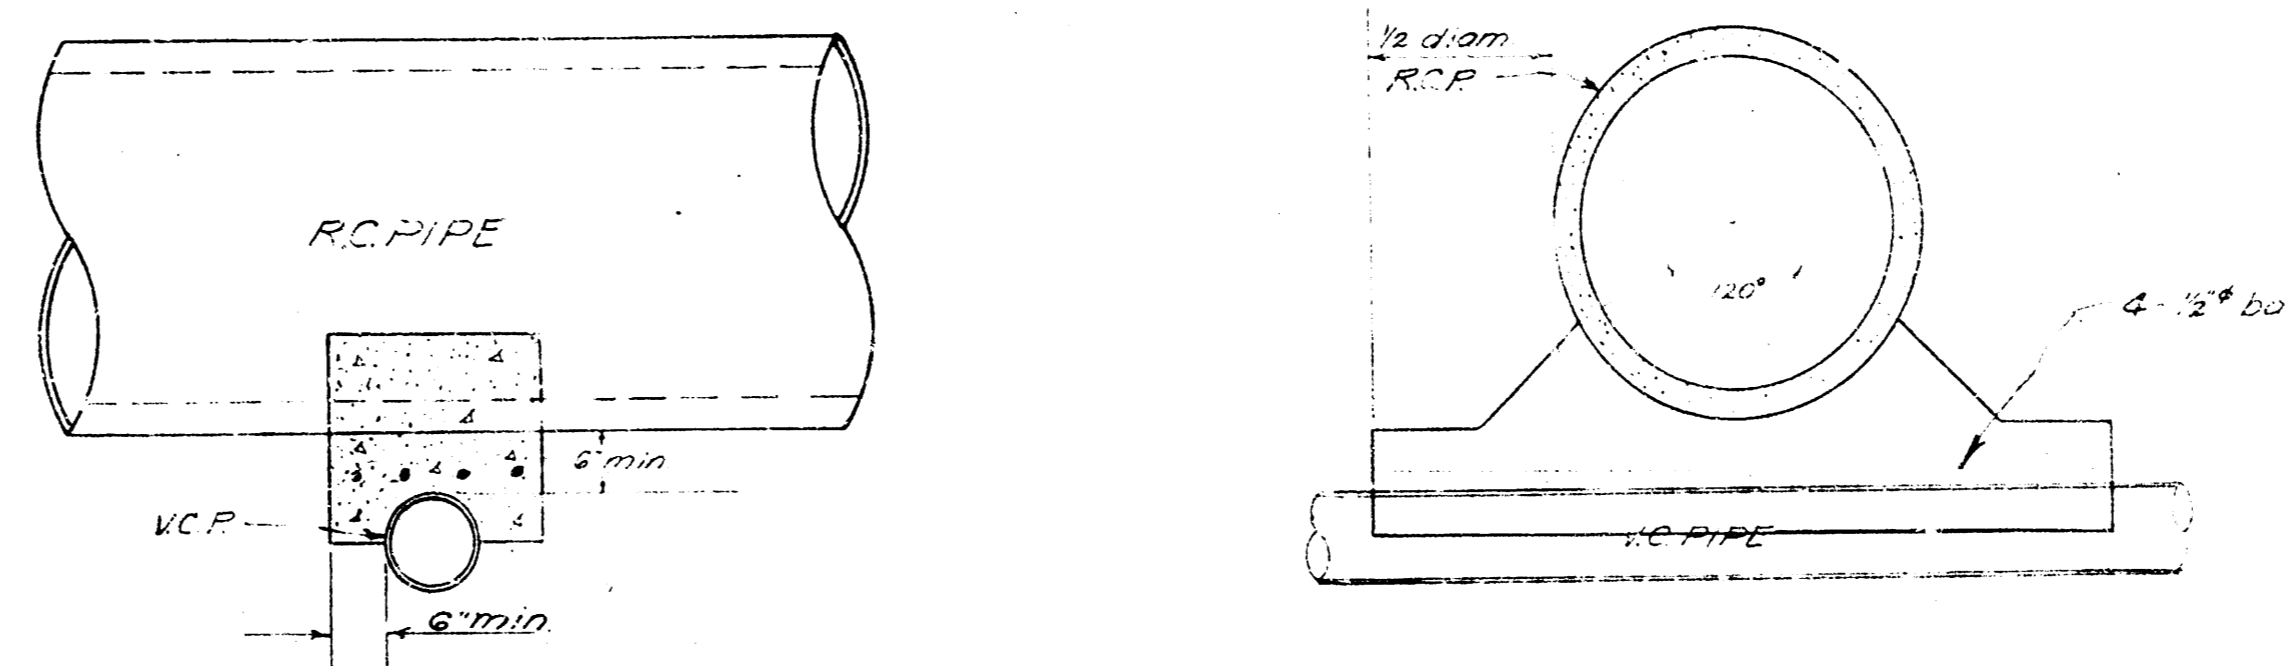

Concrete encasement of VCP pipe at all points where RCP pipe crosses, as required by the field engineer.

Concrete for manholes shall contain not less than 165 lbs of cement per cubic yard of concrete. In no event shall the total water content exceed 6.25 gallons per sack of cement. The mixture of fine and coarse aggregate shall be such as will produce a maximum density of the most workable mixture.

IN GENERAL: Pipes will enter and leave the manholes at various angles and elevations. Where possible bend reinf bars around pipes (24" diam or less). Where pipes are large use #6 diagonal bars as shown. The floor of the manhole is to be shaped for flow and drainage with concrete. No deduction in conc quantities shall be made for pipe openings. No addition in conc quantities shall be made for shaping manhole floor. An internal vibrator is to be used for placing concrete.

STORM WATER SEWER DIST. NO. 42  
CITY OF WICHITA KANSAS  
L. K. WHITE CITY ENGINEER  
Proj. No. C.21-62  
SEPT. 15, 1951