STORM WATER SEWER NO. 146

PART I

GENERAL NOTES

1. FOR ADDITIONAL LAYOUT INFORMATION, SEE WESTLINK LAKES ESTATE PLAT AND THE STREET PAVING PLANS.

2. LOCATE CURB INLETS TO CORRESPOND WITH BACK OF CURBS AS SHOWN ON STREET PAVING PLANS.

3. FIELD ENGINEER SHALL TAKE TIES ON IRONS WHICH MAY BE DISTURBED DURING CONSTRUCTION. SUCH ALTERED IRONS SHALL BE REPLACED TO ORIGINAL LOCATION BY FIELD ENGINEER.

4. THE RIP-RAP SHALL BE TYPE 3. THE TYPE 3 RIP-RAP SHALL BE 12" RIP-RAP ON 6" SAND AND GRAVEL BEDDING. THE ROCK FOR RIP-RAP AND GRAVEL PROTECTION SHALL BE HARD, DENSE, DURABLE AND SHALL BE REASONABLY WELL GRADED. THE SIZE RANGE OF ROCK USED FOR RIP-RAP SHALL HAVE A MAXIMUM SIZE OF ONE CUBIC FOOT AND A MINIMUM SIZE OF 1½ INCH. THE 6 INCH SAND AND GRAVEL BEDDING SHALL BE A CONTINUOUS LAYER OF SAND AND GRAVEL OR SAND AND CRUSHED ROCK, REASONABLY WELL GRADED.

5. END SECTIONS AT PIPE OUTFALL SHALL BE CONSTRUCTED TO ALIGN WITH THE SLOPE OF BANK IN ORDER THAT END SECTION PROTRUSION IS MINIMUM. WHERE SUCH PROTRUSION CANNOT BE AVOIDED, FILL AROUND THE END SECTIONS AT APPROXIMATELY 3:1 SIDE SLOPED SO END SECTION APPEARS ENTIRELY RECESSED.

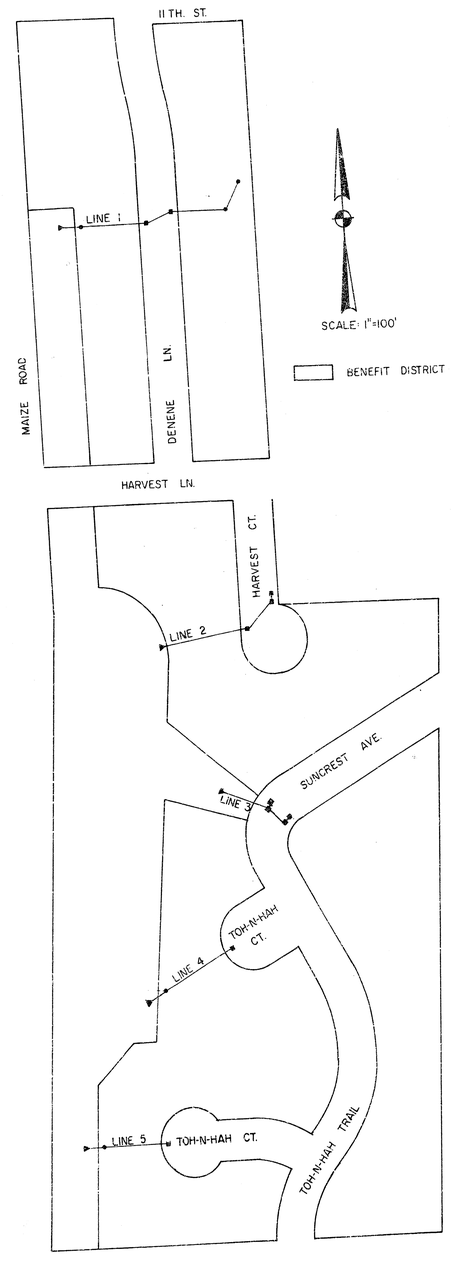

CITY OF WICHITA, KANSAS

R. W. LINN, CITY ENGINEER

PROJECT NO. 468-76-245-80649-000-000-001

DATE: [illegible]

PLAN — SCALE: 1"=20' — NOTE BOOK — PAGE NO.

PROFILE — SCALE: — NOTE BOOK — PAGE NO.

B.M. 154.15 'O' ctr. E. lowguard RCB on Maize Rd. bet. 11th St. & Harvest Ln.

BM 152.28 Maize Rd. & 9th St. No. City of Wichita sta. disc. 32' N. & 38' E of ¼ sec cor.

Lot 4, Blk 2
Westlink Lakes Estate

℄ 20' Utility Easement

Sta. 3+11 Constr. Type 1A Curb Inlet w= 4'2" (Paving Sta. 2+46.88)

Install Type 3 Rip-Rap

Install End-Section, To be paid for as L.F. of Pipe

8" San. Sewer by Others

Sta. 1+40 E.L. Drainage Dedication

Sta. 0+72 Start Pipe

℄ 2+00 E.L. Street

DENENE LN.

℄ 8" San. Sewer by Others

℄ 2+61 E.L. Street

Lot 4, Blk 1
Westlink Lakes Estate

Sta. 3+82 Constr. Manhole See Detail 3 This Sheet

Remove End-Section @ no additional cost.

Existing 36" RCP SWS #459

Sta. 2+50 Constr. Type 1A Curb Inlet w= 8'6" (Paving Sta. 2+74.08)

Drainage Easement Line

Install 36" Pipe

Install 8'7"@ Pipe

Install 8'7"@ Pipe

Drainage Easement Line

Sta. 3+36 Constr. Field Inlet See Detail 2 This Sheet

Drainage Easement Line

Sta. 1+10 Constr. Field Inlet See Detail 1 This Sheet

Note: Mound earth 1' over pipe when pipe is exposed above ground line. This to be done at no additional cost.

70' Drainage Dedication

Channel by Others

Lot 5, Blk 2
Westlink Lakes Estate

Lot 5, Blk 1
Westlink Lakes Estate

Scale: 1"=20'

E.L. Westlink Lakes Estate

8'0" Dia.

Use City of Wichita Standard Manhole Type B with 24" top clear opening in precast conc. top slab with Beehive inlet.

TOP SLAB PLAN

8'0" Dia.

#4 rebars throughout @ 6" cts., 2" cl. of bottom & 2' dia. opening, cut bars 2" cl. all sides.

TOP SLAB PLAN

Std. Type 1A Curb Inlet Ring & Cover
Elev. 151.90

Std. Type 1A Curb Inlet Ring with Beehive Cover
Elev. 151.00

Precast Concrete slab w. ring & Beehive cover

R 144.88
R 144.85
Shape Bottom

Natural Top

Sta. 3+22 Type B 6' dia. Manhole

R 147.00
R 146.96
Shape Bottom

Existing 36" Pipe

SECTION
DETAIL 2 FIELD INLET @ 3+36
Scale: ⅛"=1'0"

To be paid for as Type B 6' dia. Manhole

SECTION
MANHOLE @ 3+22, DETAIL 3
Scale: ⅛"=1'0"

NOTE: Beehive cover to be Neenah R-2560-F1 Beehive Grate or approved equal.

Use City of Wichita Standard Reinforced Conc. Manhole Box with precast conc. Top Slab Type 1A Curb Inlet ring and Beehive Cover.

TOP SLAB PLAN

Std. Type 1A Curb Inlet Ring with Beehive Cover

Natural Top

Elev. 150.48

#4 rebars throughout @ 6" cts., 2" cl. of bottom & 2' dia. opening, cut bars 2" cl. all sides.

Precast Concrete top slab w. ring and Beehive Cover

Std. Reinf. Manhole

Reinf. Conc.

Fl. 146.67
Shape Bottom

To be paid for as Reinf. Conc. Manhole

SECTION
FIELD INLET @ 1+10, DETAIL 1
Scale: ⅛"=1'0"

PROFILE

C.L.30 E.L. Maize Rd. w/ Drainage Dedication

DWS 147.62 (100 yr. storm)

DWS Channel @ (6.12 sides 4:1) E 145.30 by Others

0+72 Start Pipe

15" Maintenance Storm by Others, Elev. 150.59

1+40 E.L. Drainage Dedication

Lot Line

1+10 Constr. Field Inlet Top 150.48

Approx. Future Lot Grade By Others

Approx. Future Bldg. Grade 153.3

Approx. Future Lot Grade By Others

2+00 Lot Line W.L. Street

2+11 Constr. Curb Inlet Top 152.00

DENENE LN

2+50 Constr. Curb Inlet Top 152.20

2+61 E.L. Street Lot Line

Approx. Future Lot Grade By Others

Approx. Future Bldg. Grade 153.8 by Others

Approx. Future Lot Grade By Others

3+36 Constr. Field Inlet, Top 151.00

3+82 Constr. Manhole Top 151.90

Ground Line

Ground Line

150

145

140

Install Type 3 Rip-Rap

146.62

8" San. Sewer by Others

Install End-Section, To be paid for as L.F. Pipe

146.67

146.62
146.36

8" San. Sewer by Others

146.62
146.36

146.85
146.86

8" San. Sewer by Others

146.76
146.76

146.98
147.00

Existing 36" RCP

Install 137' of 34"x53" HERCP @ +0.18%
Alt. 49"x33" RMPA (fully paved) @ +0.14%

Install 39' of 34"x53" HERCP @ +0.14%
Alt. 49"x33" RMPA (fully paved) @ +0.18%

Install 86' of 34" RCP @ +0.18%
Alt. 86' of 34" CMP (fully paved) @ +0.18%

Install 44' of 36" RCP @ +0.14%
Alt. 44' of 36" CMP (fully paved) @ +0.18%

Existing 34" RCP @ +0.14%

LINE 1

0 1 2 3 4

146.36 146.60 146.80

SWS #144, Part I, Line 1

Sheet 2 of 2/11

PLATE 1, PLAN-PROFILE

BM (See BM's for Line 1 and Line 3

Lot 1

LOT 2

LOT 3, Blk. 3
WESTLINK LAKES ESTATE

Approximate Proposed Shore Line
of Lake 1 by Others

E.L. MAIZE Rd.?

Type 3 Rip-Rap

Pipe Begin Sta. 0+81.65

Sta. 0+99.99

Install 18" Pipe? & 20' Drainage Easement

N.W. Cor. Lot 4
2.00' Rt. Sta. 1+00.00

N.E. Cor. Lot 4
2.00 Rt. Sta. 2+19.74

Iron 19.6' Rt. Sta 2+16.9
Street Paving Sta. 0+00

Install End-Section. To be paid for as L.F. Pipe

& 20' Utility Easement

Drainage Easement

Reserve "A"

LOT 4, Blk. 3
WESTLINK LAKES ESTATE

60' R/W

31' B/B

10' Utility Easement

8" San. Sewer by Others

Sta. 2+81.02

8" SS by Others

S.S. R 146.64

Constr. Curb Inlet Top 152.70
Street Paving Sta. 0+64.77

Install 8' of 15" Pipe
USFL 149.20; DSFL 149.10

Constr. Curb Inlet Top 152.70
Street Paving Sta. 0+54.77

Iron, Street Paving Sta. 0+48.99

USFL 149.00; DSFL 148.50

Sta. 2+31.65 Constr. Curb Inlet Top 152.70
Street Paving Sta. 0+21.59

NOTE: All Curb Inlet this sheet are Std. Type 1A Curb Inlet w=4'2"

Scale: 1"=20'

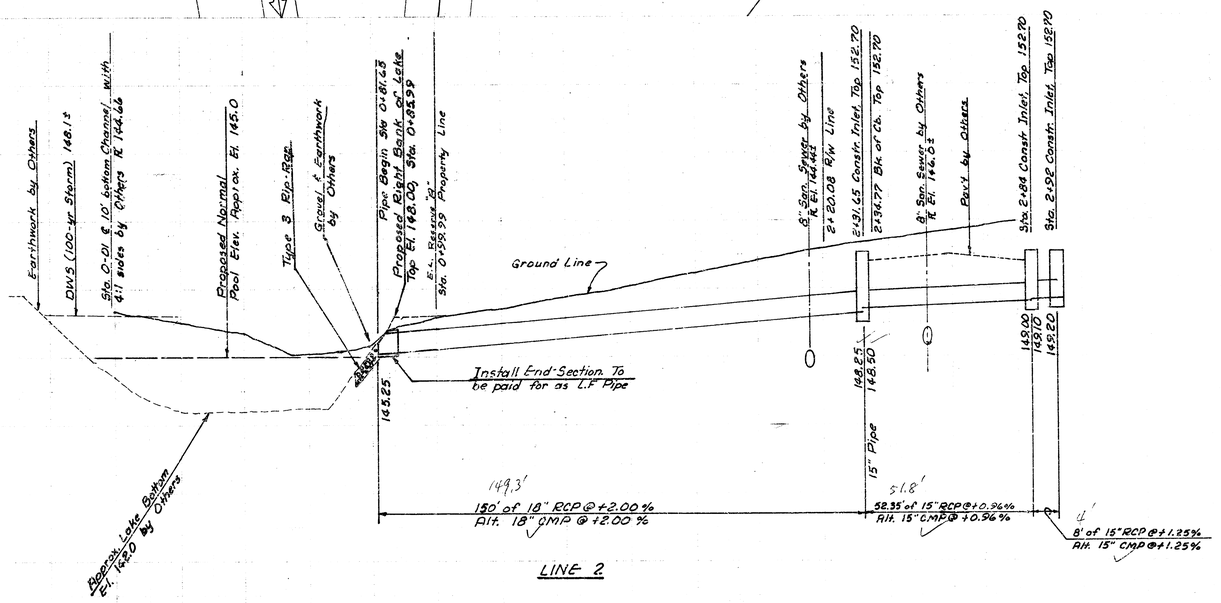

LINE 2

SWS #144, Part I, Line 2 Sheet 3 of

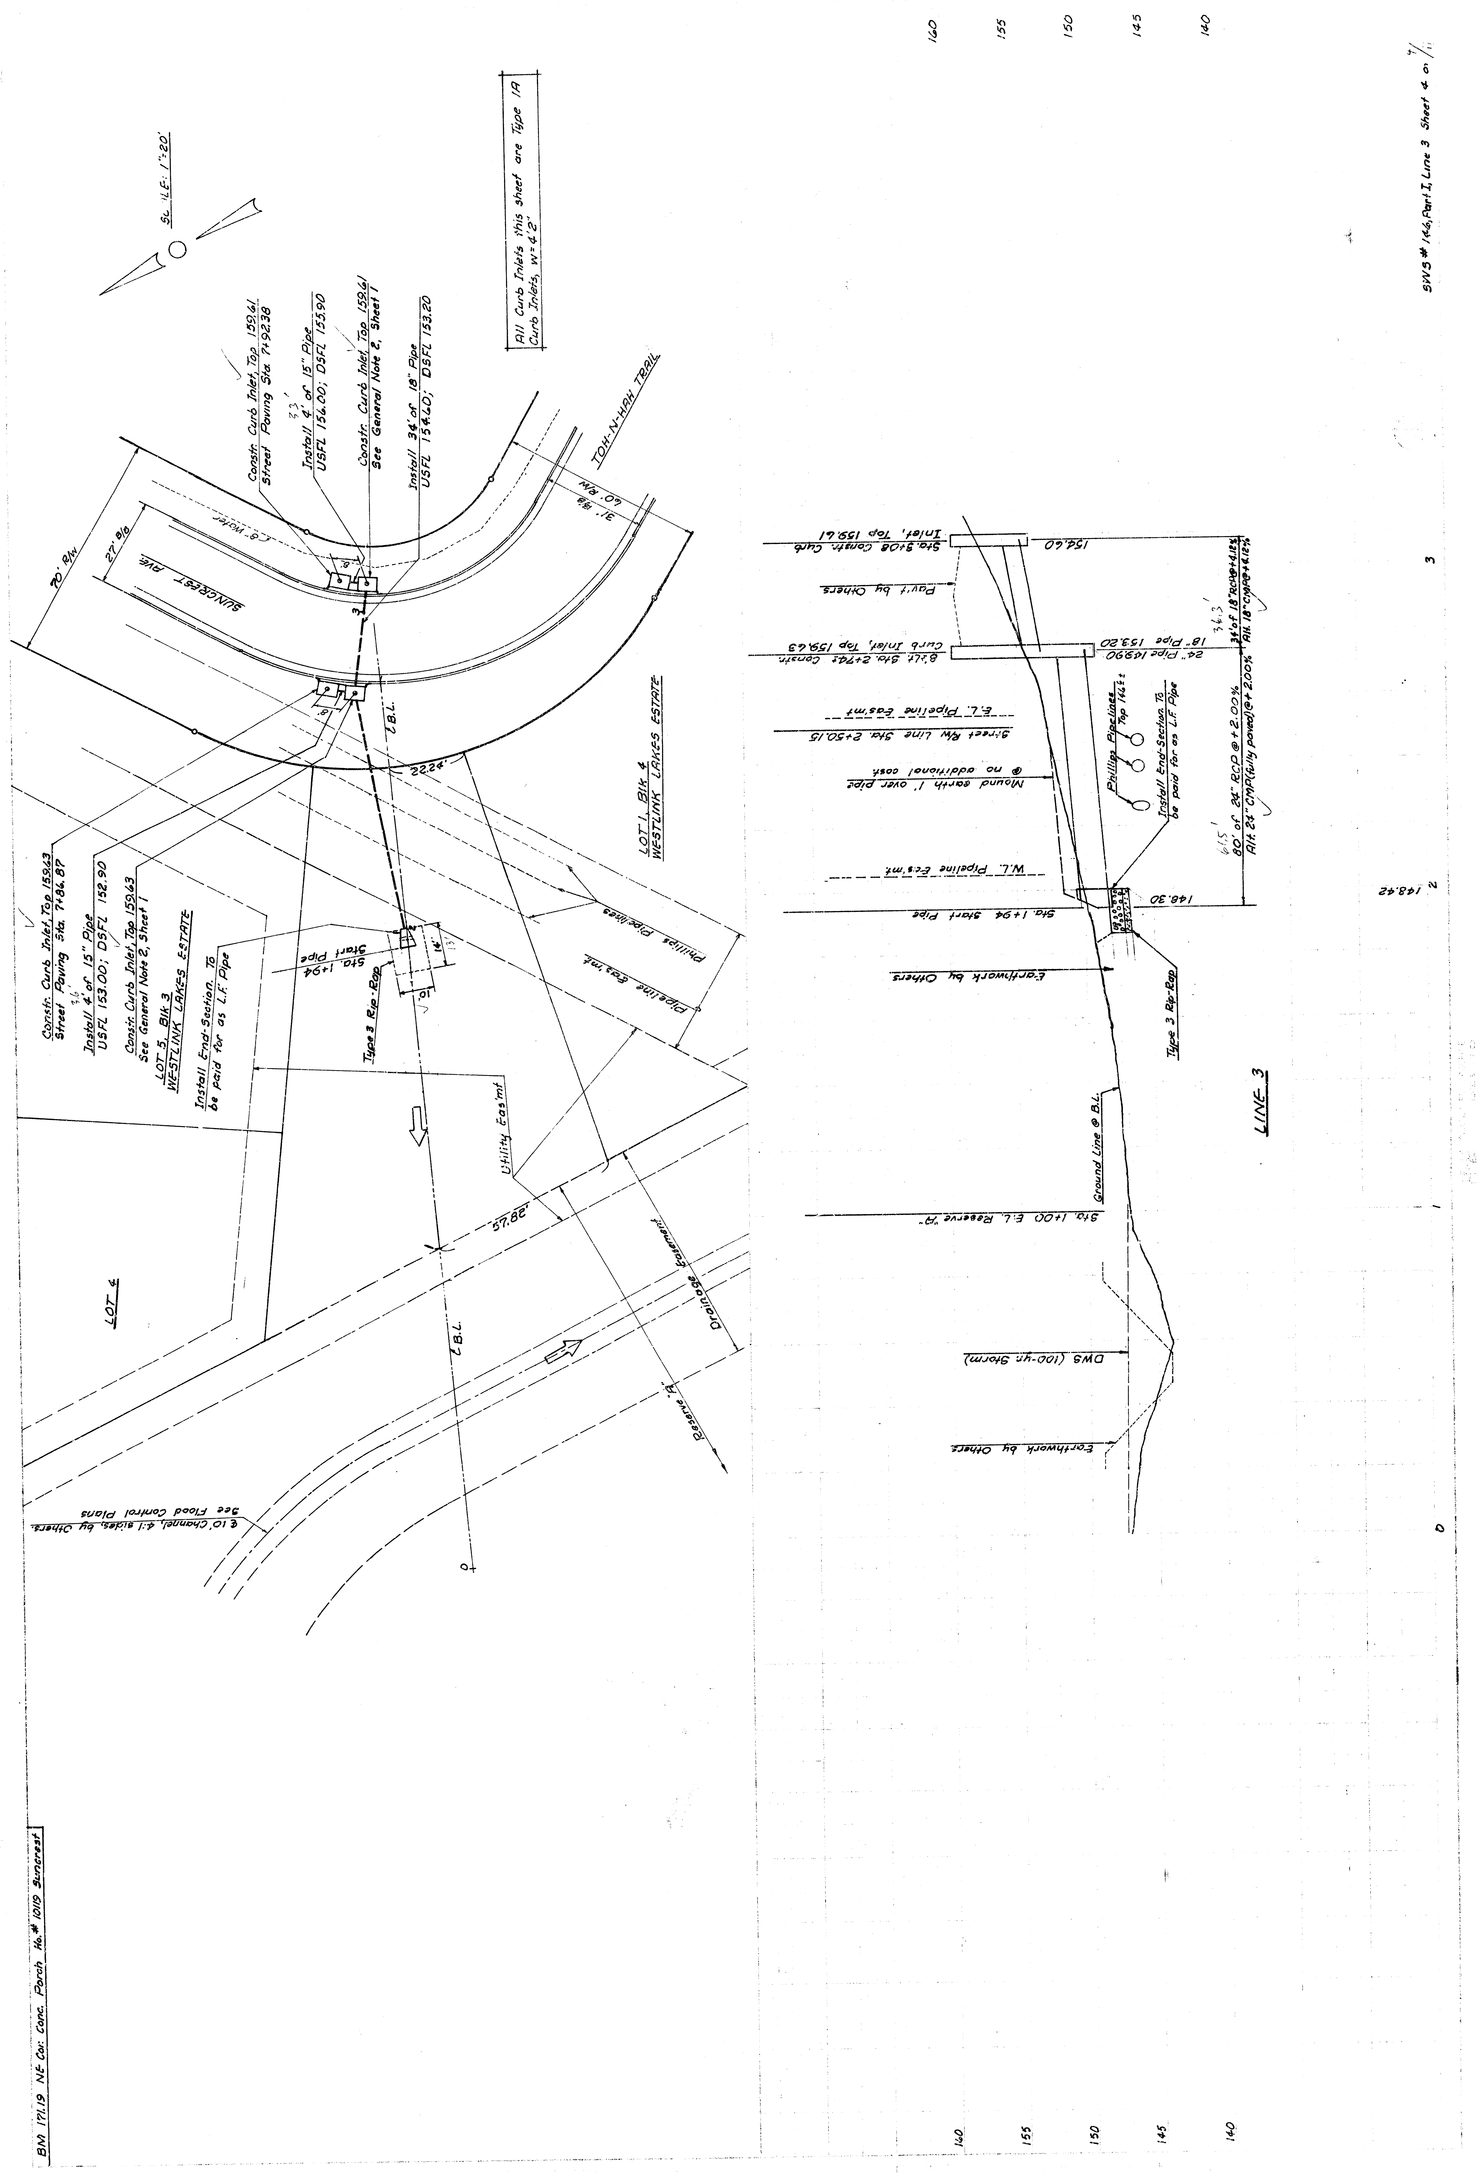

SCALE: 1"=20'
All Curb Inlets this sheet are Type 1A Curb Inlets, W=4'2"
Constr. Curb Inlet, Top 159.61 Street Paving Sta. 7+92.38
Install 4' of 15" Pipe USFL 156.00; DSFL 155.90
Constr. Curb Inlet, Top 159.61 See General Note 2, Sheet 1
Install 34' of 18" Pipe USFL 154.60; DSFL 153.20
TOH-N-HAH TRAIL
SUNCREST AVE.
70' R/W
27' B/B
31' B/B
60' R/W
22.24'
LOT 1, BLK 4 WESTLINK LAKES ESTATE
Constr. Curb Inlet, Top 159.63 Street Paving Sta. 7+86.87
Install 4' of 15" Pipe USFL 153.00; DSFL 152.90
Constr. Curb Inlet, Top 159.63 See General Note 2, Sheet 1
LOT 5, BLK 3 WESTLINK LAKES ESTATE
Install End-Section. To be paid for as L.F. Pipe
Sta. 1+94 Start Pipe
Type 3 Rip-Rap
Phillips Pipelines
Pipeline Eas'mt
Utility Eas'mt
57.82'
Drainage Easement
Reserve "A"
LOT 4
℄ B.L.
℄ 10' Channel, 4:1 sides, by Others. See Flood Control Plans
Sta. 3+08 Constr. Curb Inlet, Top 159.61
154.60
Pav't by Others
Curb Inlet, Top 159.63
18" Pipe 153.20
24" Pipe 149.90
Street R/W Line Sta. 2+50.15
E.L. Pipeline Eas'mt
Mound earth 1' over pipe @ no additional cost
Phillips Pipelines Top 146±
Install End-Section. To be paid for as L.F. Pipe
W.L. Pipeline Eas'mt
Sta. 1+94 Start Pipe
148.30
Earthwork by Others
Type 3 Rip-Rap
Ground Line @ B.L.
Sta. 1+00 E.L. Reserve "A"
DWS (100-yr. Storm)
Earthwork by Others
LINE 3
160
155
150
145
140
148.42
SWS # 146, Part I, Line 3 Sheet 4 of 7
BM 171.19 NE Cor. Conc. Porch Ho. # 10119 Suncrest
DLK 356 WSK

BM (See BM's for Line 3 and Line 5

NOTE:
PROPOSED FINISH GRADE ON STORM SEWER MAY BE HIGHER THAN EXISTING GROUND. FOR CHANNEL PORTION, CONTRACTOR SHALL CONTACT DEVELOPER, MR. CHARLES BRODIE, PH: 262-0031, ABOUT INSTALLING DUMPED RIP-RAP ON CHANNEL BOTTOM AND SLOPES. RIP-RAP ON LAKE SHORE SLOPE SHALL EXTEND AT LEAST 2.0 FEET BELOW THE NORMAL LAKE ELEVATION.

Reserve "A"

Drainage Easement

Proposed Approximate Shore Line of Lake 2 by Others

Lot 2, Blk 4 Westlink Lakes Estate

℄ 20' Utility Easement

8" San. Sewer by Others

Constr. 15" Pipe @ ℝ ℄ 20' Drainage Easement

8" Water

Location

Blk. of Cb. @ Sta. 2+40.03, For See general note 2, Sheet 1

Sta. 0+75 Begin Pipe

Type 3 Rip-Rap

B.L. J

40'

18'

16'

B.L. J

2

Sta. 2+25.53

Sta. 1+06 Constr. Field Inlet
See Detail this sheet

B.L. Sta. 1+00

Sta. 2+36.95 Constr. Type 1A Curb Inlet, w=6'2"

E.L. Norse Rd.

TOH-N-HAH CT

Lot 3, Blk. 4 Westlink Lakes Estate

TOH-N-HAH TRAIL

SCALE: 1"=20'

SCALE: 1"=20'

PLAN

DLK 376
WS K

Normal Water Surface Lake 2 Approx. 149.0

D.W.S. 146.20 (100 yr. Storm)

Install Type 3 Rip-Rap up to 2.0' below approximate normal pool El. Sta. 0+75 Begin Pipe

Install End Section To be paid for as L.F. Pipe

E.L. Reserve A Sta. 1+06 Constr. Field Inlet Top 148.8

Sta. 2+25.53 Property Line R/W Line, Toh-N-Hah Ct.

Sta. 2+36.95 Type 1A Curb Inlet Top 132.96

Sta. 2+40.03 Blk. of Cb. Top 151.36

Proposed Street by Others

Ground Line

8" Water

132.76

144.84

145.40

149.50

130.2'

130.95' of 15" RCP @ +4.00%
Alt. 15" CMP @ +4.00%

39.3'

31' of 15" RCP @ +1.81%
Alt. 15" CMP @ +1.81%

3:1

Approx. Earthwork Line & Lake bottom El. 139.0 by Others

8" San. Sewer by Others
℞ El. 136.5±

LINE 4

140
135
150
165
140

145.89

151.86

0
1
2

May use brick structure with precast top. See Sheet 2

54" Dia.

15" Pipe

2' Dia.

15" Pipe

To be paid for as Type A 4' dia. Manhole

TOP SLAB PLAN

Use #4 rebars throughout @ 6" cts., 2" cl. of bottom & 2' dia. opening; cut bars 2" cl. all sides.

Std. Type 1A Curb Inlet Ring with Beehive Cover

Modified Top

Elev. 149.8

9"

Std. Type A 4'ø Manhole

3'10"

15" Pipe

℞ 149.50

℞ 145.40 Shape Bottom

15" Pipe

SECTION

Beehive cover to be Neenah R-2560-E1 Beehive grate or approved equal.

FIELD INLET @ 1+06

Scale: 1/2" = 1'0"

SWS #144, Part I, Line 4 Sheet 5 of 31

BM 147.00 "+" NW Cor E. Hdw RCB on Maize Rd 1000'± S. of 9th St.

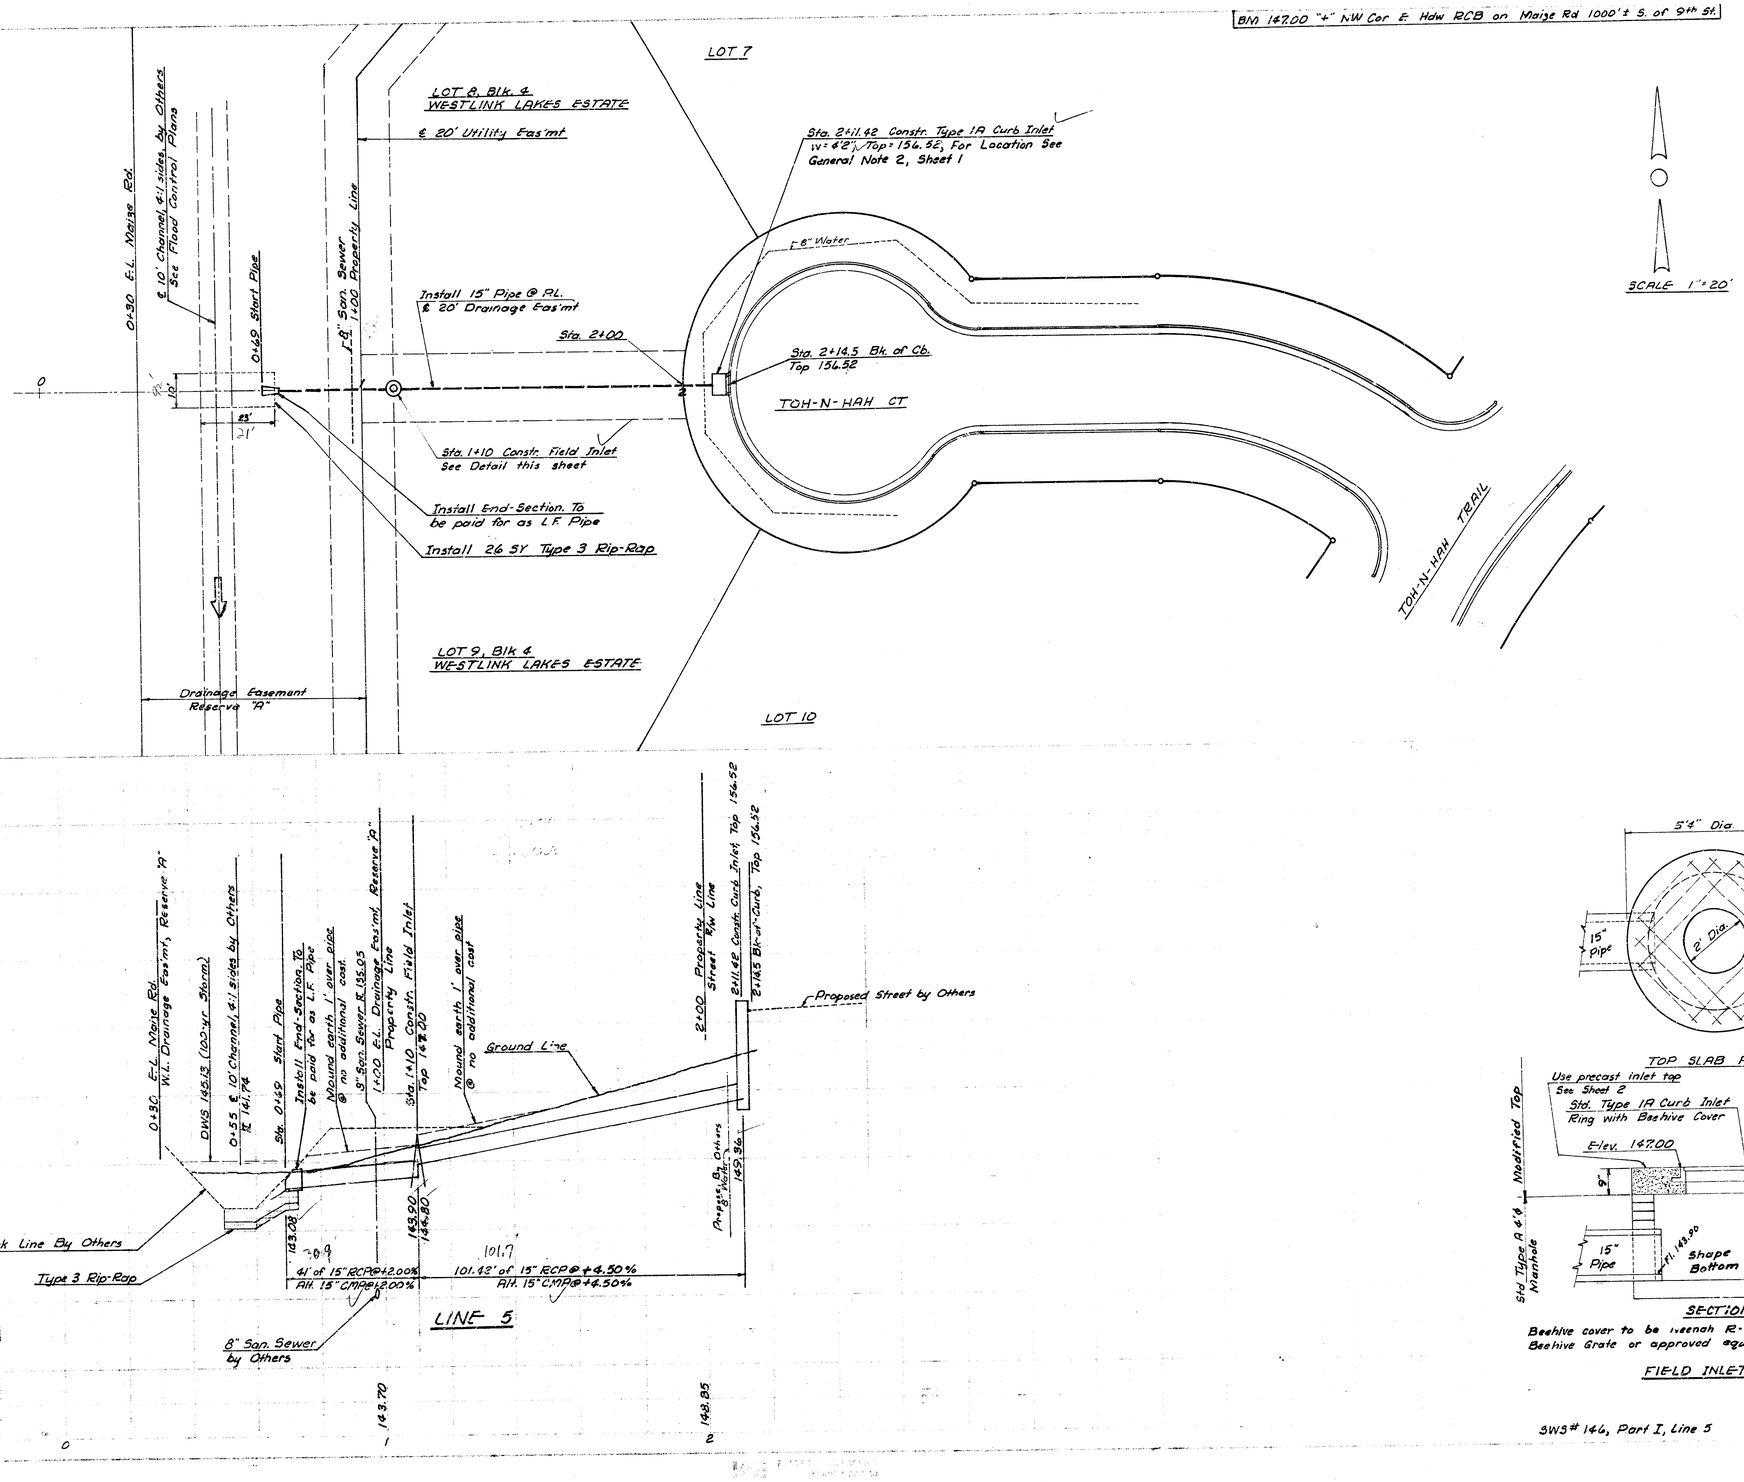

To be paid for as Type A 4' dia. Manhole

TOP SLAB PLAN

Use precast inlet top
See Sheet 2
Std. Type 1A Curb Inlet
Ring with Beehive Cover

Use #4 rebars throughout @ 4" cts, 2" cl. of bottom & 2" dia. opening, cut bar 2" cl. all sides.

SECTION

Beehive cover to be Iveenah R-2560-E1 Beehive Grate or approved equal.

FIELD INLET @ 1+10
Scale: ½" = 1'0"

SWS # 146, Part I, Line 5

Sheet 6 of 6/11

STORM WATER SEWER NO. 146

PART II

2—6'x4.5' R.C.B.C.

WESTLINK LAKES ESTATE

HARVEST LANE AT MAIZE RD.

CITY OF WICHITA, KANSAS

R.W. LINN CITY ENGINEER

PROJ. NO. 468 76 245 80649 000 000 001

DATE:

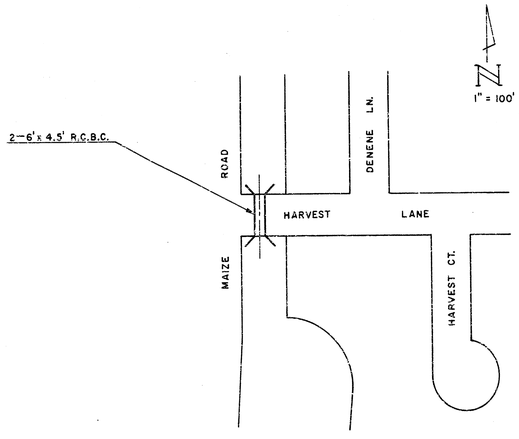

9/11

B.M. 1511.67 R.R. SPK E. face P.P. N.E. Corner Harvest Lane & Maize Rd., 18' N. of N.L. Harvest Lane

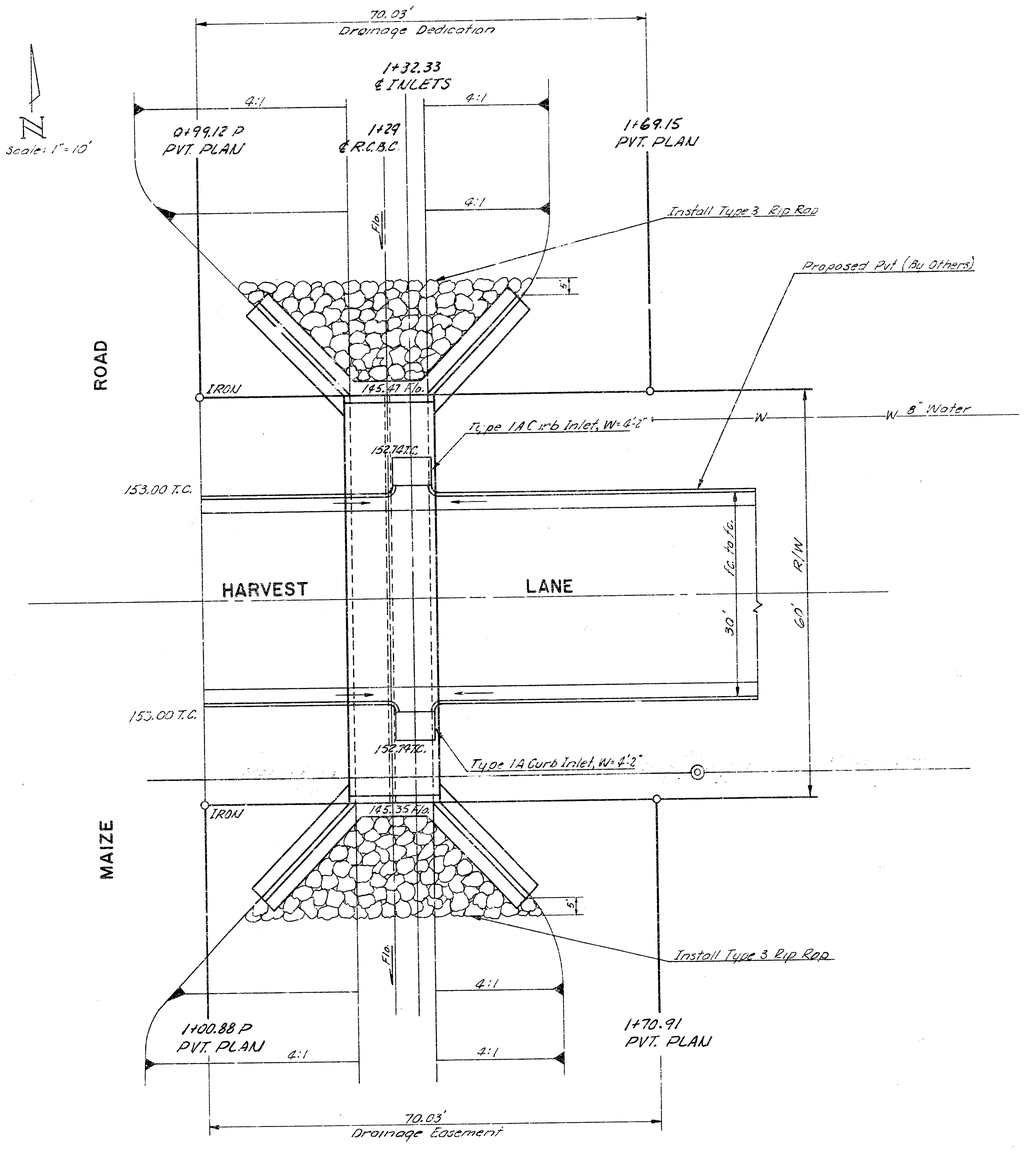

STORM WATER SEWER NO. 146
PART II
2 – 6'x 4.5' R.C.B.C.
WESTLINK LAKES ESTATE
HARVEST LANE AT MAIZE RD.
CITY OF WICHITA, KANSAS

R.W. LINN CITY ENGINEER

DATE 10/13

PROJ. NO. 468 76 245 80549 000 000 001

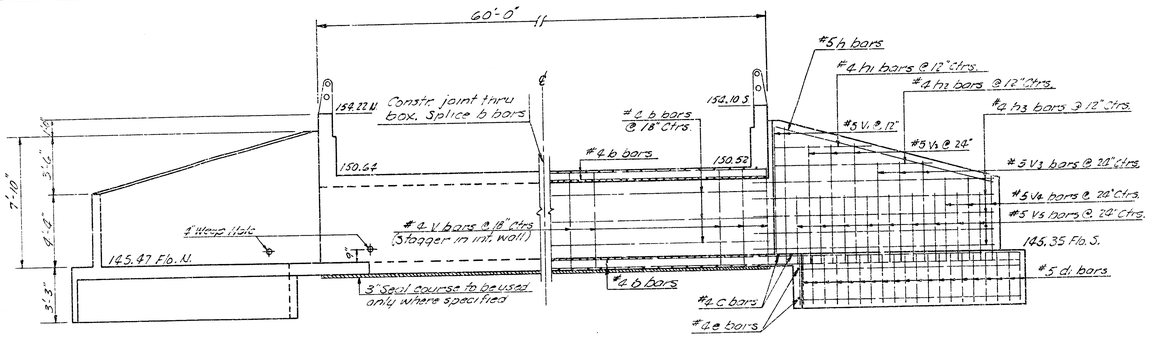

ELEVATION AND SECTION
1/4" = 1' 0"

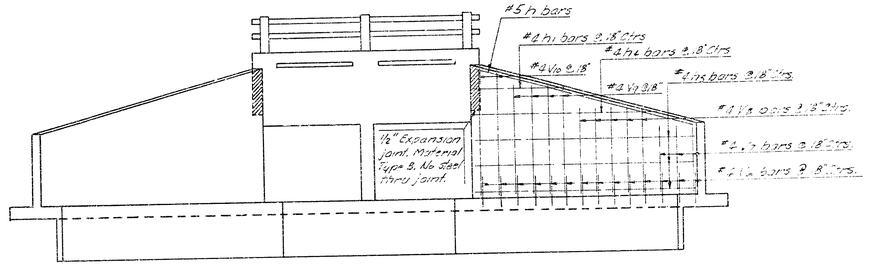

ELEVATION AND SECTION
1/4" = 1' 0"

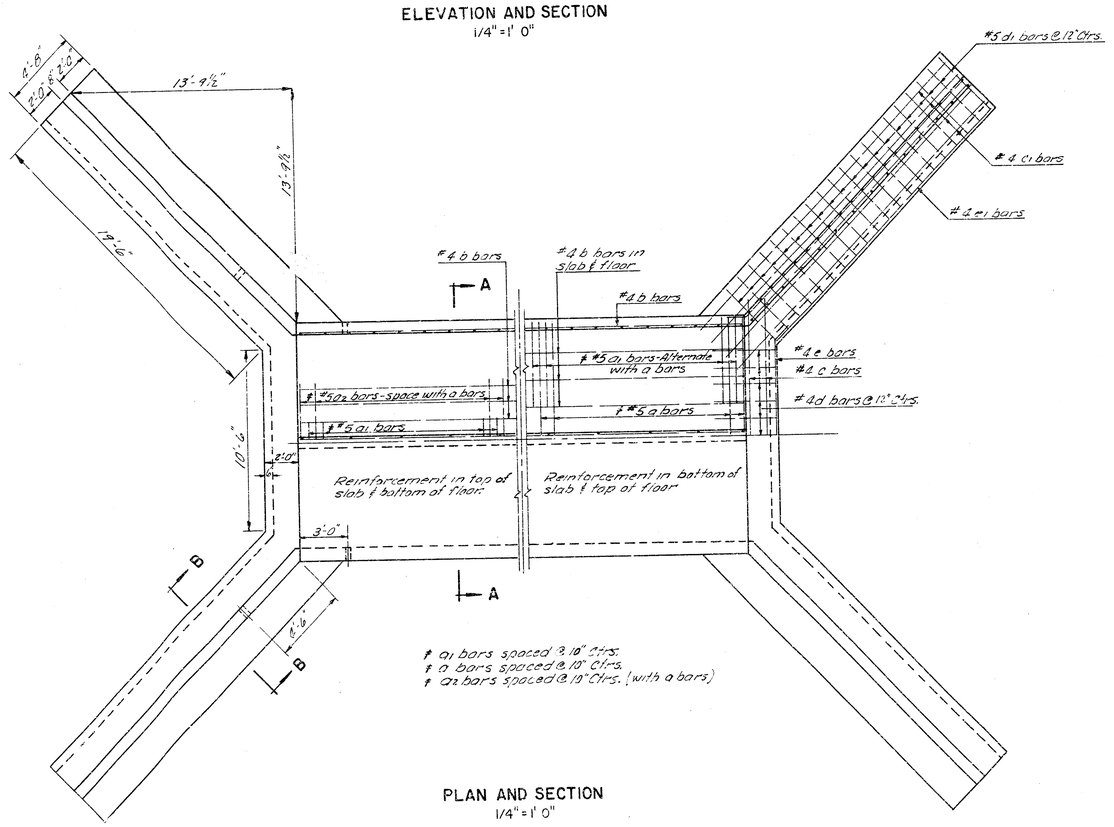

PLAN AND SECTION
1/4" = 1' 0"

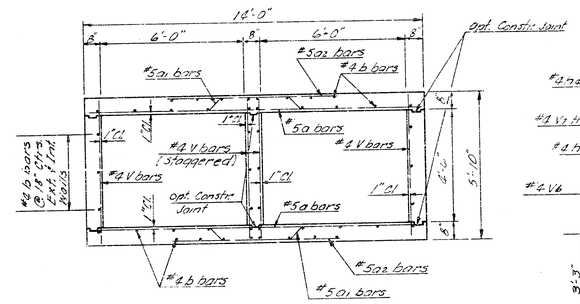

SECTION A–A
3/8" = 1' 0"

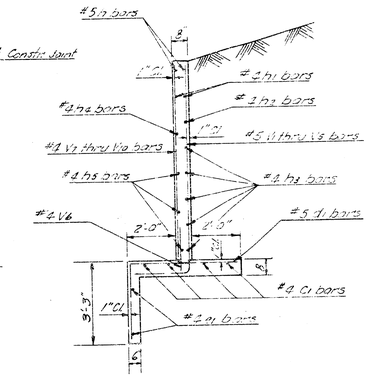

SECTION B–B
3/8" = 1' 0"

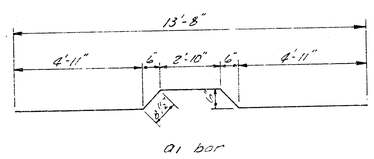

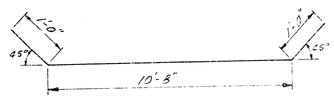

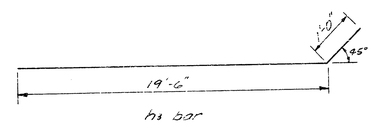

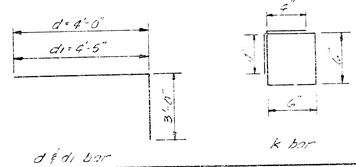

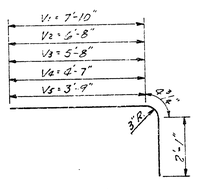

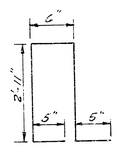

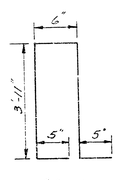

BENDING DIAGRAMS No Scale
All dimensions out to out of bars

STORM WATER SEWER NO. 146
PART II
2 - 6'x4.5' R.C.B.C
WESTLINK LAKES ESTATE
HARVEST LANE AT MAIZE RD.
CITY OF WICHITA, KANSAS
R.W. LINN CITY ENGINEER
DATE
PROJ. NO. 468 76 245 80649 000 000 001

11/13

9/

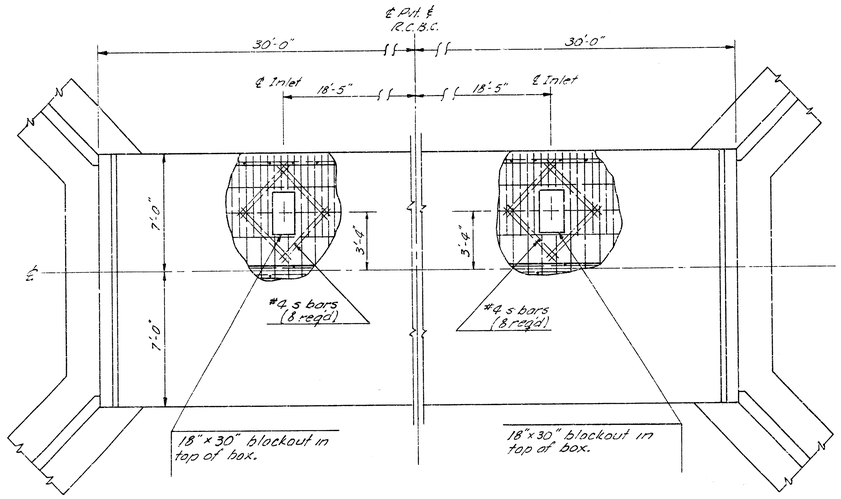

PLAN—INLET LOCATION
1/4"=1' 0"

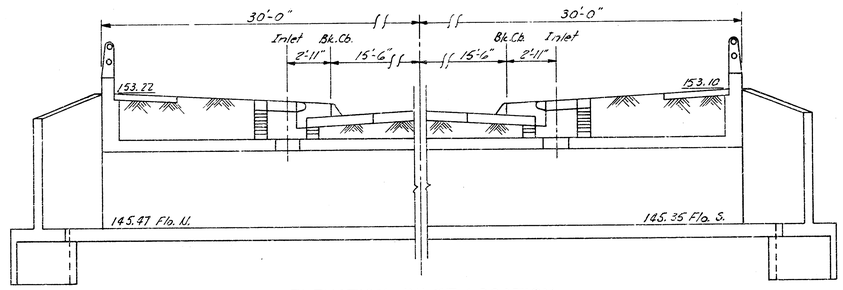

ELEVATION—INLET LOCATION
1/4"=1' 0"

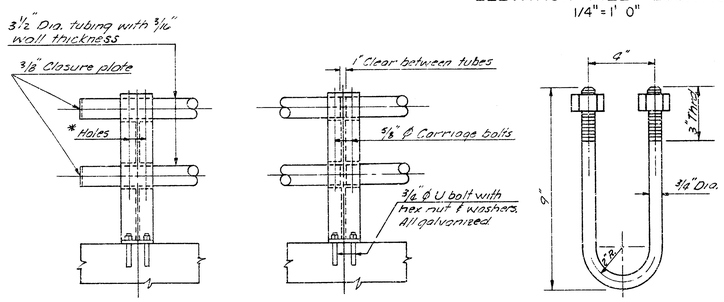

* Holes: 11/16" square holes in post under head and 11/16" round holes under nuts for 5/8" Ø x 5½" carriage bolts with hex nuts.

DETAIL—ALUMINUM RAILING
No Scale

Note: Aluminum Handrail

Aluminum posts shall be Reynolds Aluminum Highway Products Bridge Railing System No 2R19A or equal.

Top & bottom rails shall be 3½" O.D. x 3/16" wall tube of 6063-T6 Aluminum.

Aluminum shims between concrete and post base may be used. The space below posts shall be thoroughly caulked with Alumilastic compound or other approved material.

GALVANIZED U BOLT
No Scale

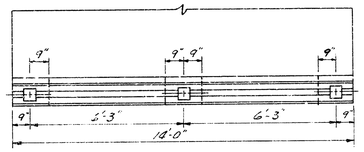

PLAN—RAILING
3/8"=1' 0"

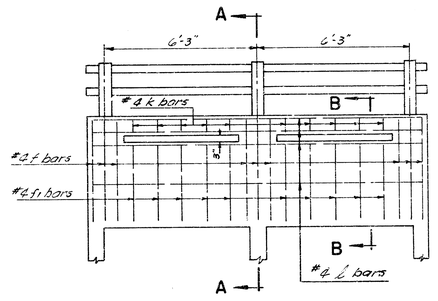

SECTION—RAILING
3/8"=1' 0"

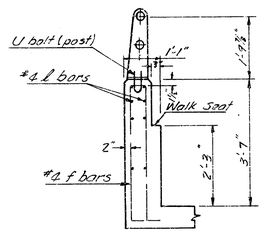

SECTION A—A
1/2"=1' 0"

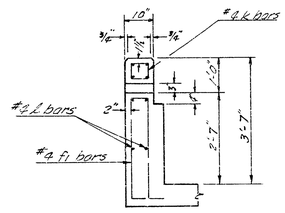

SECTION B—B
1/2"=1' 0"

Revised No. & Wt. 7-26-79
" " " " " "
" " " " " "

BAR SCHEDULE

BAR	SIZE	LENGTH	NO.	SHAPE	WEIGHT
a	#5	13'9"	144	—	2065.14
a1	#5	14'1"	144	⌒	2114.79
a2	#5	7'0"	149	—	1045.38
b	#4	31'0"	88	—	1822.80
c	#4	10'3"	4	—	42.75
c1	#4	22'3"	14	—	233.14
d	#4	7'0"	22	⌐¬	102.87
d1	#5	7'5"	60	⌐¬	277.12
e	#4	1'8"	4	⌐¬	33.85
e1	#4	1'9"	6	—	17.76
f	#4	9'2"	18	⊓	110.16
f1	#4	7'2"	20	⊓	75.19
h	#5	11'2"	8	—	104.11
h1	#4	7'7"	8	—	47.51
h2	#4	13'5"	6	—	34.09
h2	#4	20'6"	20	⌐¬	273.85
h4	#4	14'7"	4	—	42.15
h5	#4	19'3"	12	—	156.91
k	#4	2'5"	20	□	35.27
ℓ	#4	13'9"	16	—	146.91
s	#6	6'1"	16	—	98.10
V	#4	5'7"	163	—	607.57
V1	#5	10'3½"	6	—	81.03
V2	#5	7'1¾"	12	⌐¬	114.21
V3	#5	8'1½"	12	⌐¬	132.71
V4	#5	7'0½"	12	⌐¬	95.34
V5	#5	4'-2½"	36	—	233.73
V6	#4	11'9"	36	—	155.84
V7	#4	8'3"	12	—	82.14
V8	#4	5'0"	20	—	66.85
V9	#4	2'4"	16	—	62.44
V10	#4	7'2"	8	—	38.17

GENERAL NOTES

1. CLASS A-AE - CONCRETE SHALL BE USED THROUGHOUT ON THE STRUCTURE. ALL REINFORCING STEEL SHALL CONFORM TO A.S.T.M. SPECIFICATIONS.
2. EARTHWORK - ALL EARTHWORK SHALL BE CONSIDERED AS "COMMON EXCAVATION" EXCEPT FOR THE TOEWALL. ALL EXCAVATION SHALL BE INCLUDED IN "LUMP SUM BID".
3. BACKFILL - ALL BACKFILL AND EXCAVATION TO EXTEND TO (2') BEYOND SIDES OF BOX AND WING-WALLS.
4. BEVEL - ALL EXPOSED EDGES OF CONCRETE WITH 3/4" TRIANGULAR MOULDING.
5. WEEPHOLES - COURSE AGGREGATE SHALL BE DEPOSITED BEHIND EACH WEEPHOLE TO OCCUPY A SPACE EXTENDING (15") IN ALL DIRECTIONS ABOVE WEEPHOLE FLOW LINE. THIS WORK SHALL NOT BE PAID FOR DIRECTLY, BUT SHALL BE CONSIDERED A PART OF THE EXCAVATION WORK.
6. SEAL COURSE - A SEAL COURSE CONSISTING OF 3" CLASS "A" CONCRETE SHALL BE CONSTRUCTED ONLY WHERE SPECIFIED ON THE PLANS OR BY THE ENGINEER. NO REINFORCING SHALL BE PLACED UNTIL THE SEAL COURSE HAS GAINED SUFFICIENT STRENGTH TO PERMIT WORKING UPON IT WITHOUT DAMAGE.
7. BUILDING OF CULVERT - THE CULVERT SHALL BE BID AS A "LUMP SUM BID".
8. THE QUANTITIES SHOWN IN THE "BILL OF MATERIALS OR ITEMS" WHICH ARE INCLUDED IN THE "LUMP SUM BID" OF THE CULVERT ARE FOR "INFORMATION PURPOSES ONLY". THE CONTRACTOR MUST SATISFY HIMSELF AS TO THE "QUANTITIES" AND THE ENGINEER ASSUMES NO RESPONSIBILITIES FOR THEIR ACCURACY. THE CONTRACTOR WILL HAVE THE FULL RESPONSIBILITY FOR PROVIDING ALL MATERIALS ON THE DETAILED PLANS NECESSARY TO COMPLETE THE PROJECT.

BILL OF MATERIALS

ITEMS	QUANTITY	UNIT
Class A-AE Concrete	92.3	C.Y.
Reinforcing Steel	10,839.7	LB.S
Hand Excavation	14.3	C.Y.
Aluminum Handrail	28.0	L.F.
Class A Concrete - Seal Course	7.8	C.Y.
Excavation	472.5	C.Y.
Compacted Fill	35.1	C.Y.

Revised quantity 7-26-79

12/13

STORM WATER SEWER NO. 146
PART II
2-6'x4.5' R.C.B.C.
WESTLINK LAKES ESTATE
HARVEST LANE AT MAIZE RD.
CITY OF WICHITA, KANSAS
R.W. LINN CITY ENGINEER
DATE
PROJ. NO. 4-8 75 245 80649 000 000 001

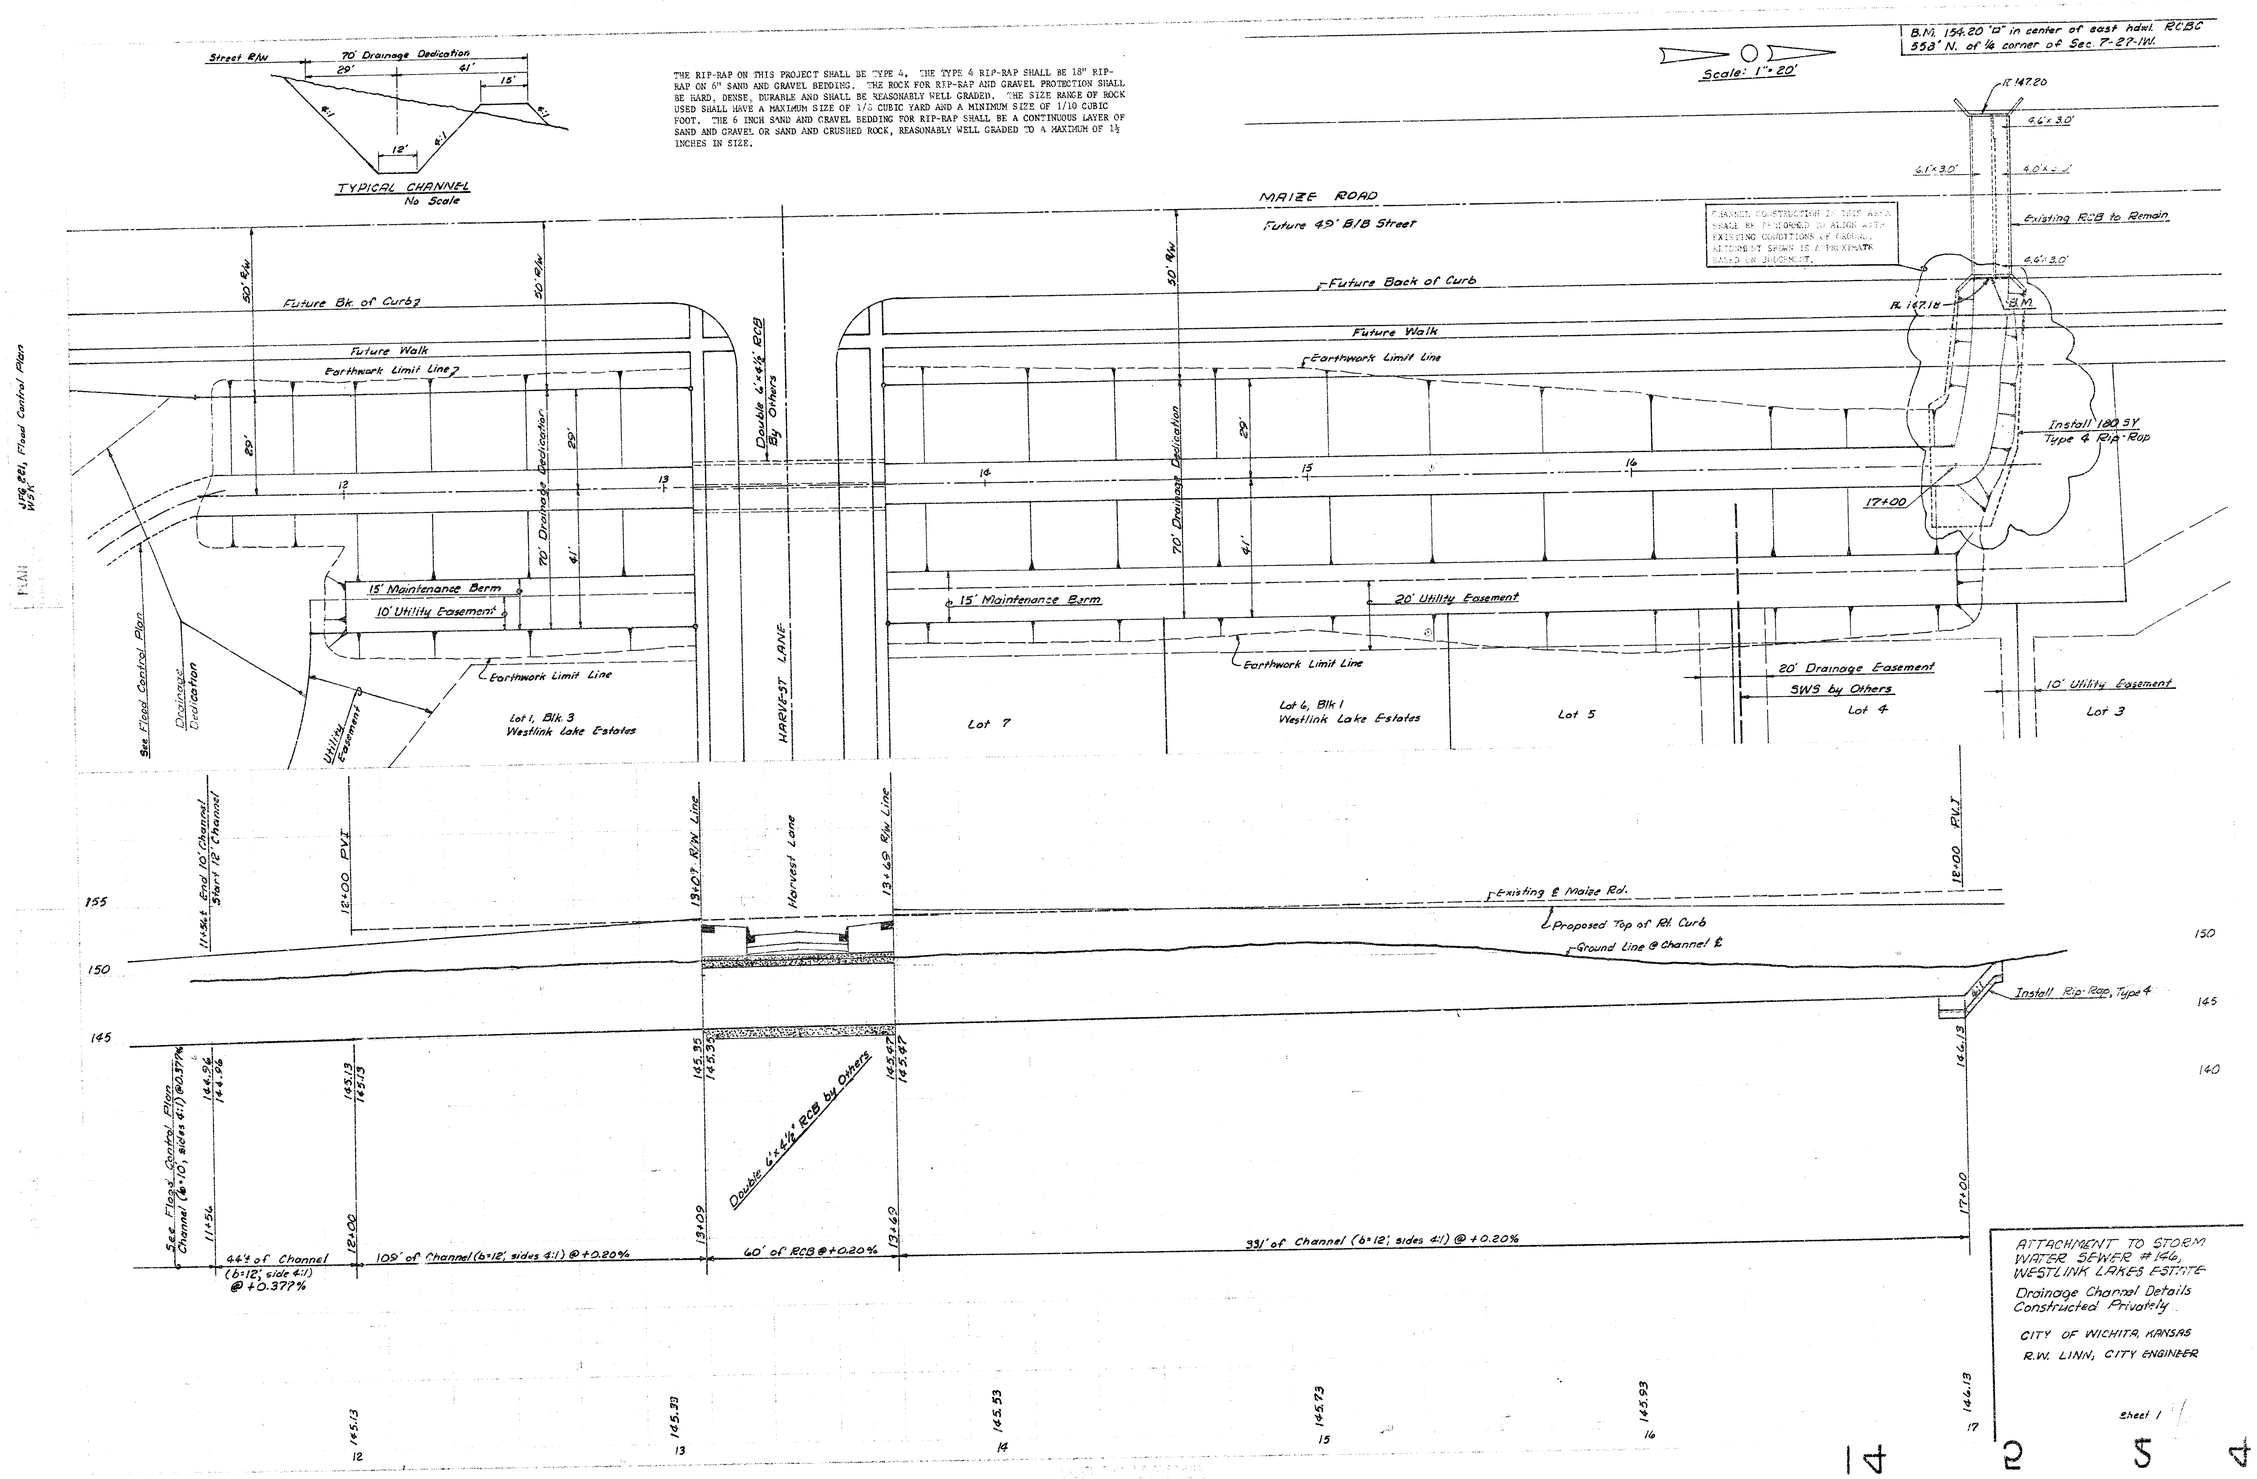

THE RIP-RAP ON THIS PROJECT SHALL BE TYPE 4. THE TYPE 4 RIP-RAP SHALL BE 18" RIP-RAP ON 6" SAND AND GRAVEL BEDDING. THE ROCK FOR RIP-RAP AND GRAVEL PROTECTION SHALL BE HARD, DENSE, DURABLE AND SHALL BE REASONABLY WELL GRADED. THE SIZE RANGE OF ROCK USED SHALL HAVE A MAXIMUM SIZE OF 1/8 CUBIC YARD AND A MINIMUM SIZE OF 1/10 CUBIC FOOT. THE 6 INCH SAND AND GRAVEL BEDDING FOR RIP-RAP SHALL BE A CONTINUOUS LAYER OF SAND AND GRAVEL OR SAND AND CRUSHED ROCK, REASONABLY WELL GRADED TO A MAXIMUM OF 1½ INCHES IN SIZE.

ATTACHMENT TO STORM WATER SEWER #146, WESTLINK LAKES ESTATE

Drainage Channel Details Constructed Privately

CITY OF WICHITA, KANSAS

R.W. LINN, CITY ENGINEER

Sheet 1

14 2 5 4