


STORM WATER SEWER NO. 146

PART I

- GENERAL NOTES
- FOR ADDITIONAL LAYOUT INFORMATION, SEE WESTLINK LAKES ESTATE PLAT AND THE STREET PAVING PLANS.
 - LOCATE CURB INLETS TO CORRESPOND WITH BACK OF CURBS AS SHOWN ON STREET PAVING PLANS.
 - FIELD ENGINEER SHALL TAKE TIES ON IRONS WHICH MAY BE DISTURBED DURING CONSTRUCTION. SUCH ALTERED IRONS SHALL BE REPLACED TO ORIGINAL LOCATION BY FIELD ENGINEER.
 - THE RIP-RAP SHALL BE TYPE 3. THE TYPE 3 RIP-RAP SHALL BE 12" RIP-RAP ON 6" SAND AND GRAVEL BEDDING. THE ROCK FOR RIP-RAP AND GRAVEL PROTECTION SHALL BE HARD, DENSE, DURABLE AND SHALL BE REASONABLY WELL GRADED. THE SIZE RANGE OF ROCK USED FOR RIP-RAP SHALL HAVE A MAXIMUM SIZE OF ONE CUBIC FOOT AND A MINIMUM SIZE OF 1 1/2 INCH. THE 6 INCH SAND AND GRAVEL BEDDING SHALL BE A CONTINUOUS LAYER OF SAND AND GRAVEL OR SAND AND CRUSHED ROCK, REASONABLY WELL GRADED.
 - END SECTIONS AT PIPE OUTFALL SHALL BE CONSTRUCTED TO ALIGN WITH THE SLOPE OF BANK IN ORDER THAT END SECTION PROTRUSION IS MINIMUM. WHERE SUCH PROTRUSION CANNOT BE AVOIDED, FILL AROUND THE END SECTIONS AT APPROXIMATELY 3:1 SIDE SLOPED SO END SECTION APPEARS ENTIRELY RECESSED.

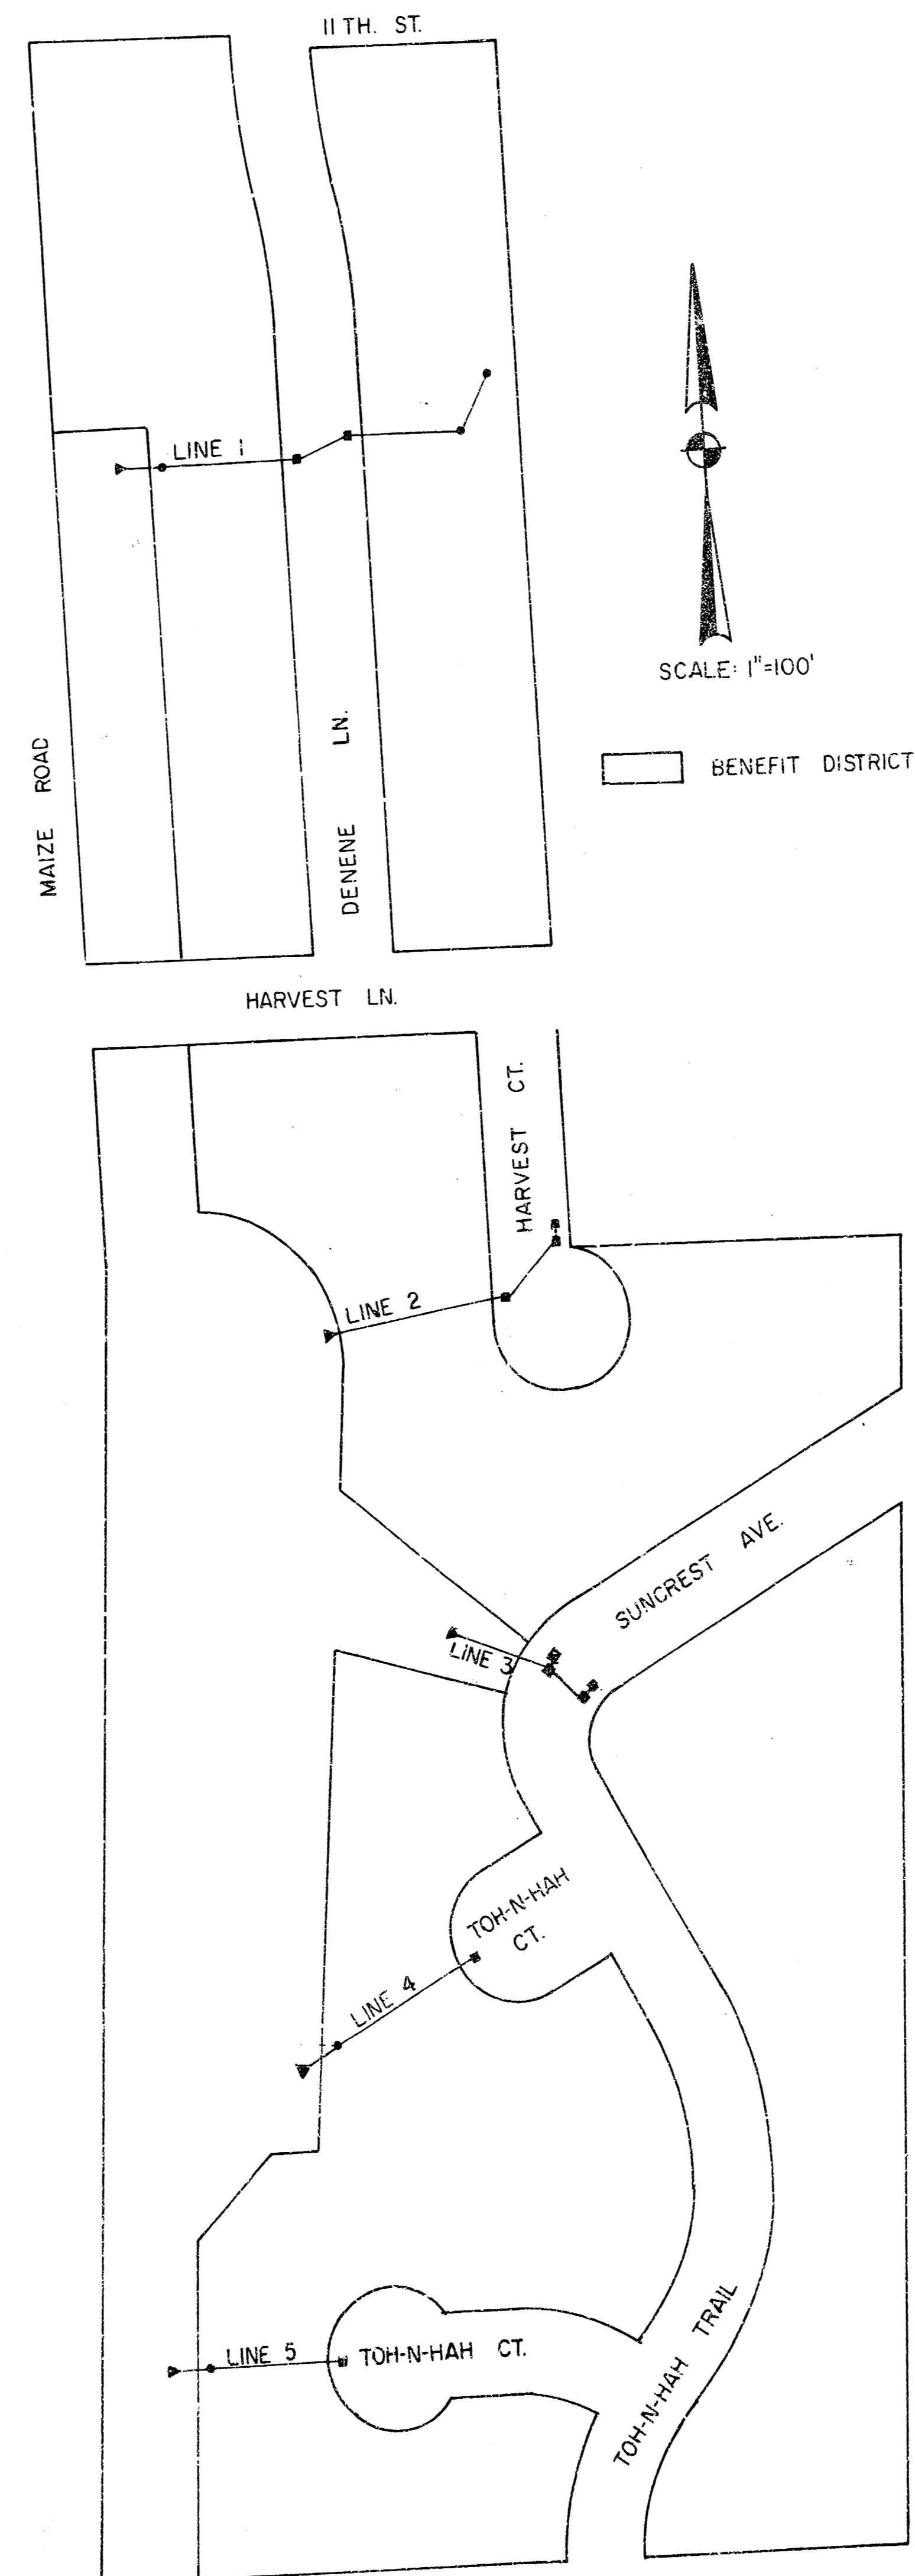

CITY OF WICHITA, KANSAS

R. W. LINN, CITY ENGINEER

PROJECT NO. 468-76-245-80649-000-000-001

DATE: July 14, 1974
Jan 20, 1975

BM (See BM's for Line 1 and Line 3)

Lot 1

Lot 2

LOT 3, Blk. 3
WESTLINK LAKES ESTATE

LOT 4, Blk. 3
WESTLINK LAKES ESTATE

Approximate Proposed Shore Line
of Lake 1 by Others

Type 3 Rip-Rap

Install 18" Pipe
& 20' Drainage Easement

N.W. Cor. Lot 4
2.00' Rt. Sta. 2+00.00

N.E. Cor. Lot 4
2.00' Rt. Sta. 2+19.76

Install End Section To
be paid for as L.F. Pipe
& 20' Utility Easement

Reserve "A"

Drainage Easement

NOTE: All Curb Inlet this sheet are Std. Type 1A Curb Inlet w=4'2"

Constr. Curb Inlet Top 152.70
Street Paving Sta. 0+64.77


Install 8" of 15" Pipe
USFL 149.20; D5FL 149.10

Constr. Curb Inlet Top 152.70
Street Paving Sta. 0+56.77

Iron, Street Paving Sta. 0+48.99

Install 52.35' of 15" Pipe
USFL 149.00; D5FL 148.50

Sta. 2+31.65 Constr. Curb Inlet Top 152.70
Street Paving Sta. 0+21.59

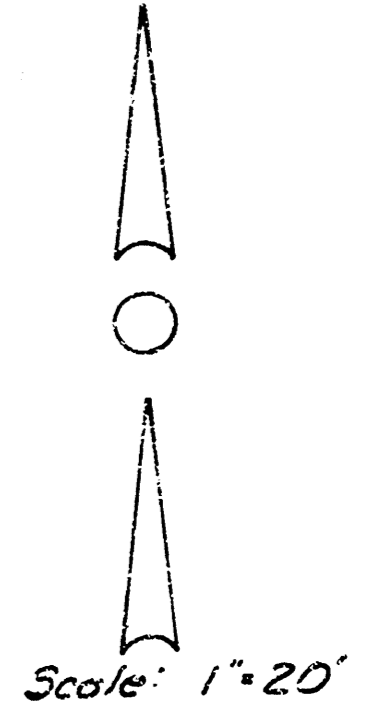

Scale: 1" = 20'

155
150
145
140

155
150
145
140

Earthwork by Others

DWS (100-yr Storm) 148.1+
Sta. 0+01.6 to 10' bottom Channel, with
4:1 sides by Others R 144.46

Proposed Normal
Pool Elev. Approx. El. 145.0

Type 3 Rip-Rap
Gravel & Earthwork
by Others

Pipe Begin Sta 0+81.63
Proposed Right Bank of Lake
Top El. 148.00 Sta. 0+81.59
El. 145.25
Sta. 0+59.29 Property Line

Ground Line

Install End Section To
be paid for as L.F. Pipe

8" San. Sewer by Others
R. El. 144.46
2+20.08 R/W Line

2+31.65 Constr. Inlet Top 152.70
2+34.77 Blk. of Ch. Top 152.70

8" San. Sewer by Others
R. El. 146.02
Paved by Others

Sta. 2+84 Constr. Inlet Top 152.70
Sta. 2+92 Constr. Inlet Top 152.70

Approx. Lake Bottom
El. 142.0 by Others

149.3'

150' of 18" RCP @ +2.00%
Rt. 18" CMP @ +2.00%

52.35' of 15" RCP @ +0.96%
Rt. 15" CMP @ +0.96%

8' of 15" RCP @ +1.25%
Rt. 15" CMP @ +1.25%

LINE 2



145.25

147.62


3

BM 171.19 NE Cor. Conc. Porch No. 1019 Suncress

PLAN
D&S 256
WSK

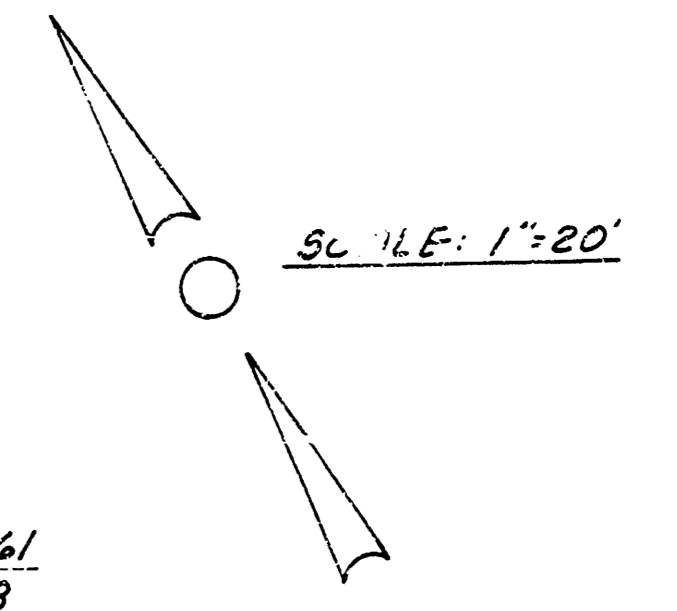
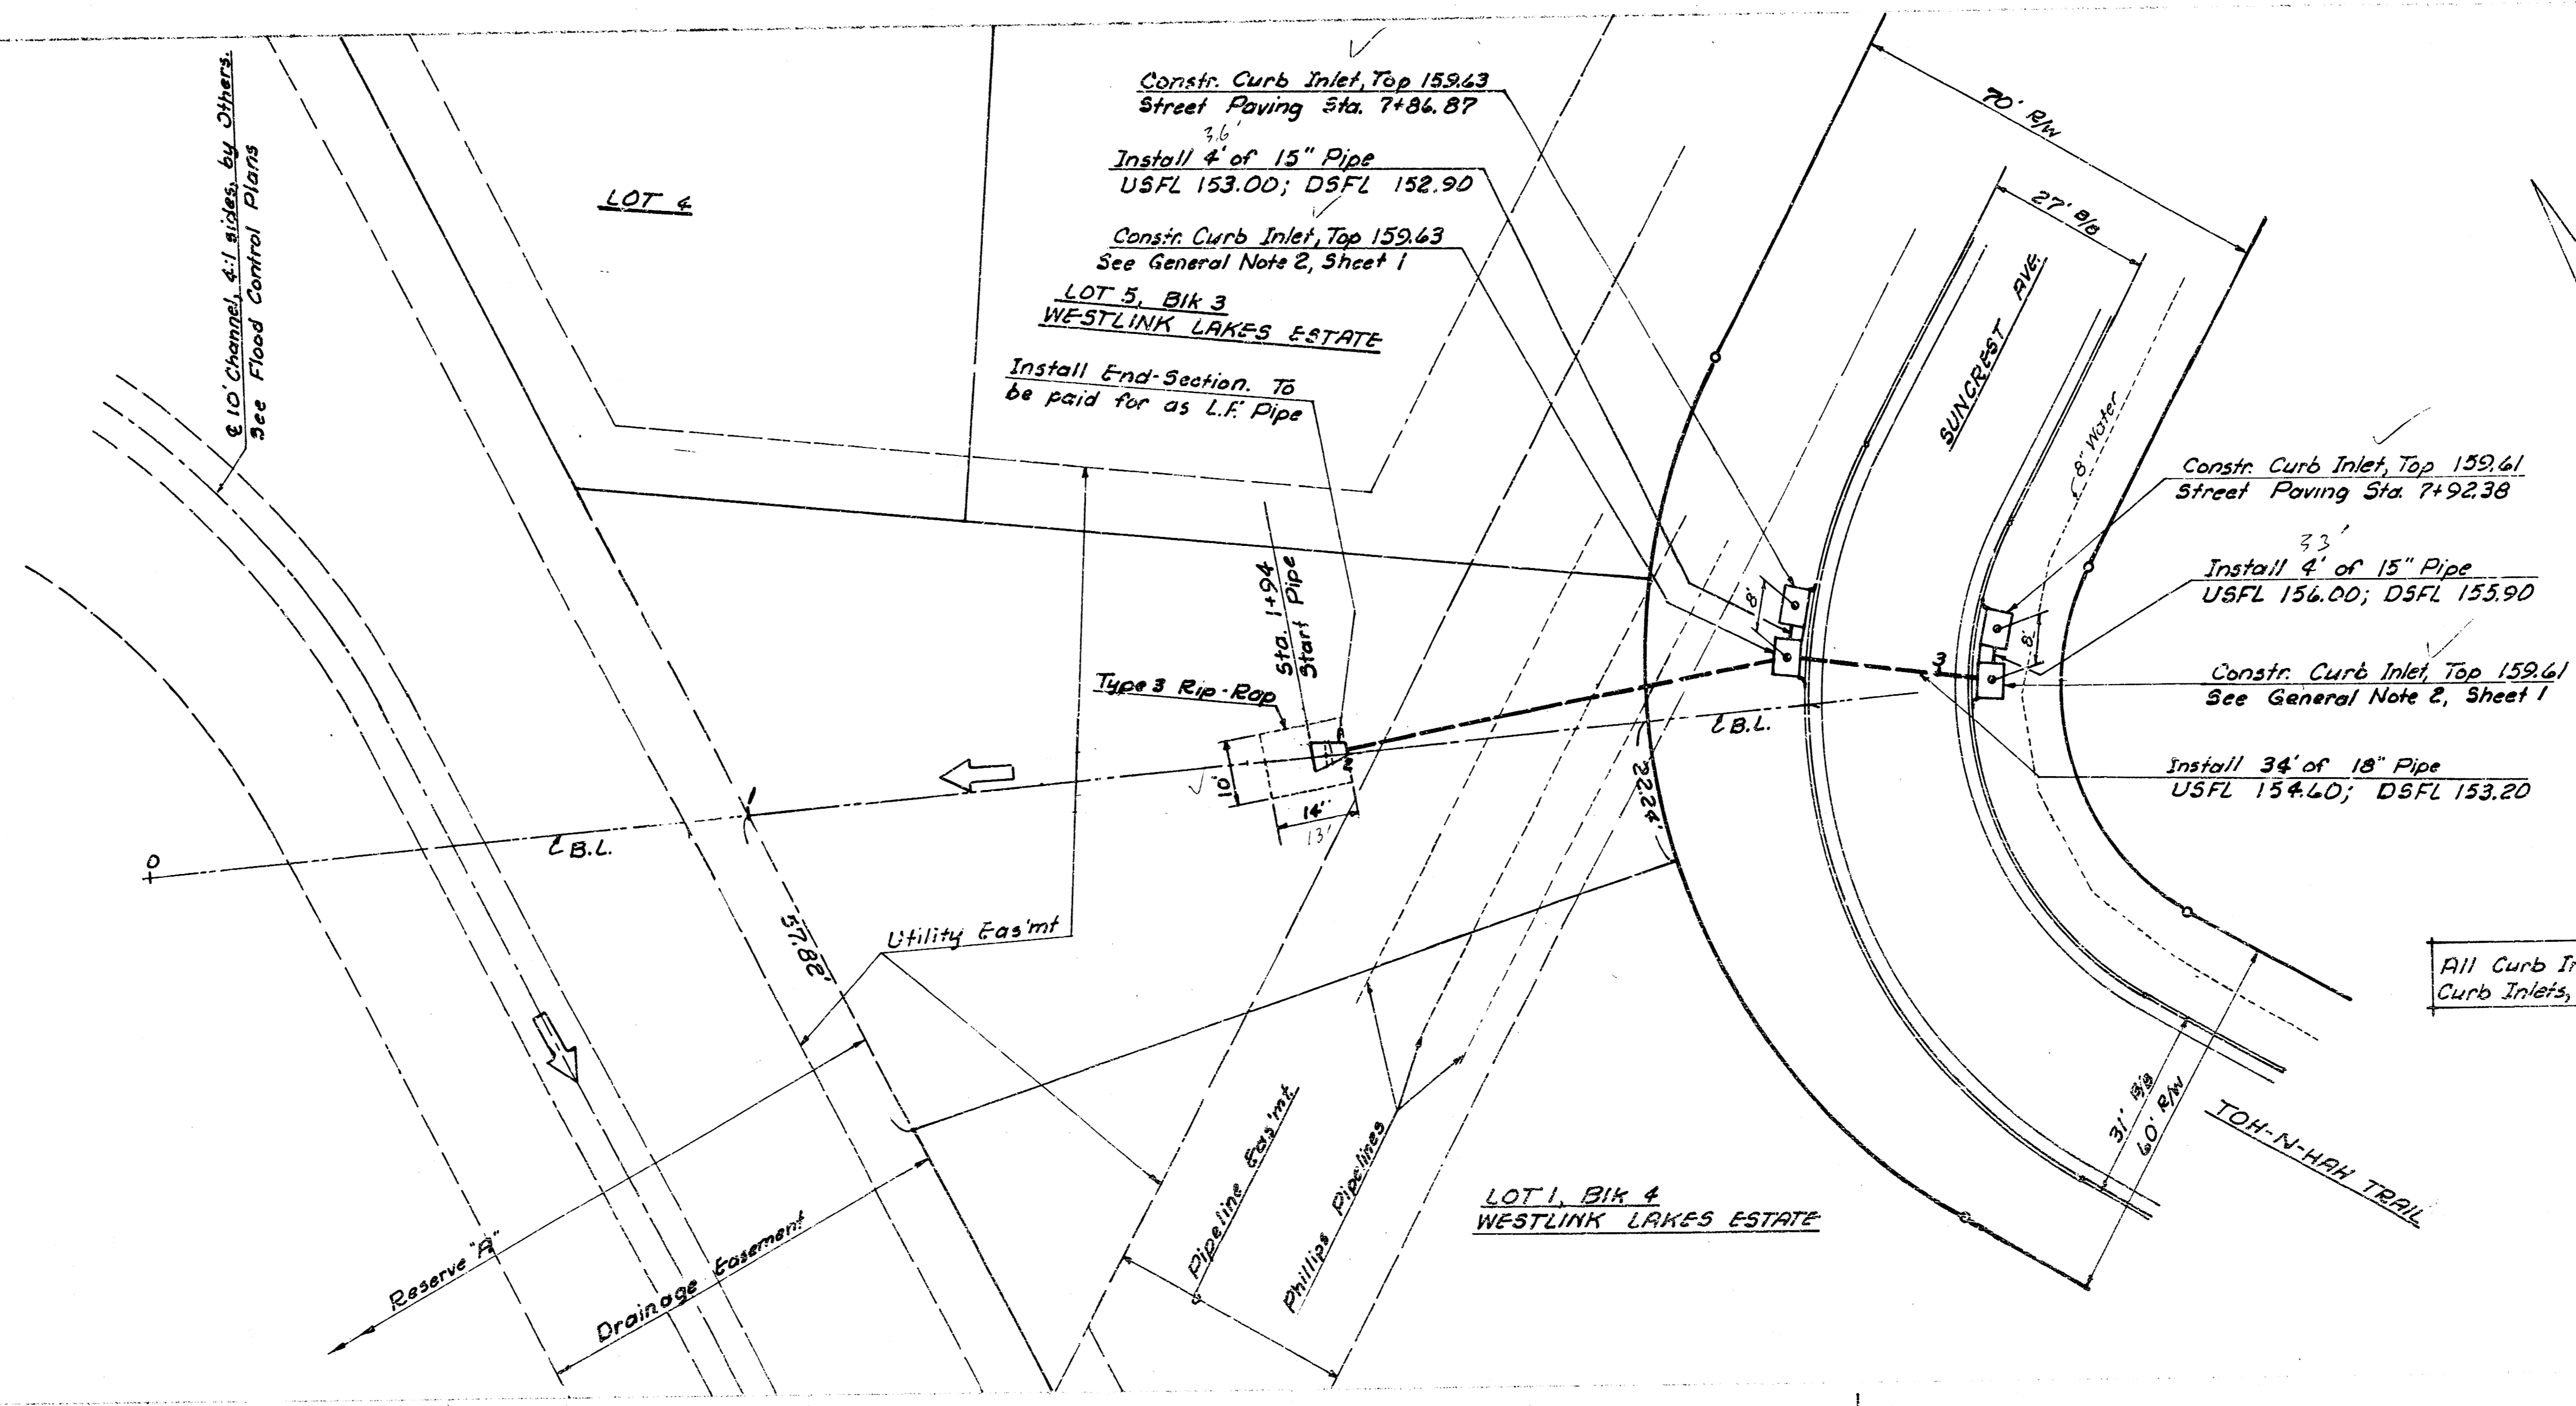


All Curb Inlets this sheet are Type 1A Curb Inlets, w=4'2"


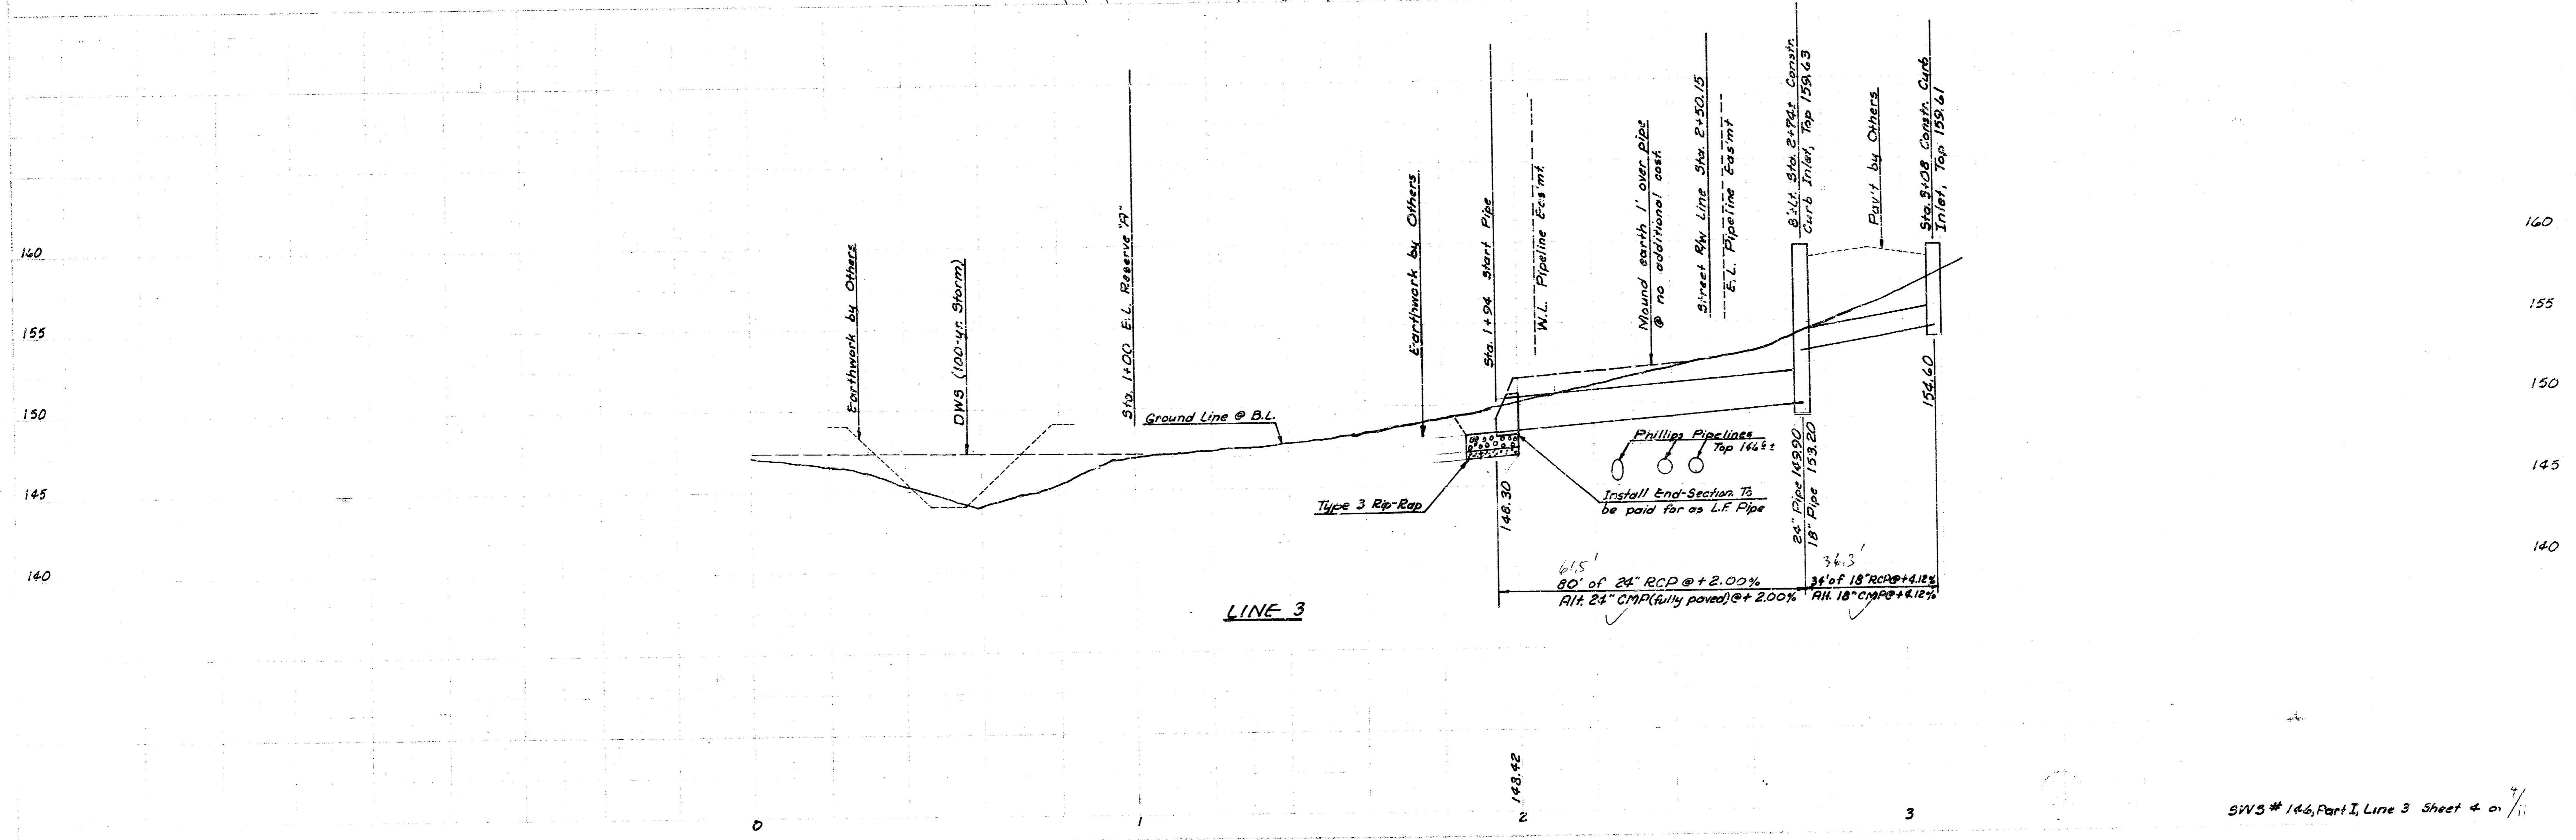


BH (See BM's for Line 3 and Line 5)


NOTE: PROPOSED FINISH GRADE OF STORM SEWER MAY BE HIGHER THAN EXISTING GROUND. FOR CHANNEL PORTION, CONTRACTOR SHALL CONTACT DEVELOPER, MR. CHARLES BRODIE, P.O. 262-0031, ABOUT INSTALLING DUMPED RIP-RAP ON CHANNEL BOTTOM AND SLOPES. RIP-RAP ON LAKE SHORE SLOPE SHALL EXTEND AT LEAST 2.0 FEET BELOW THE NORMAL LAKE ELEVATION.

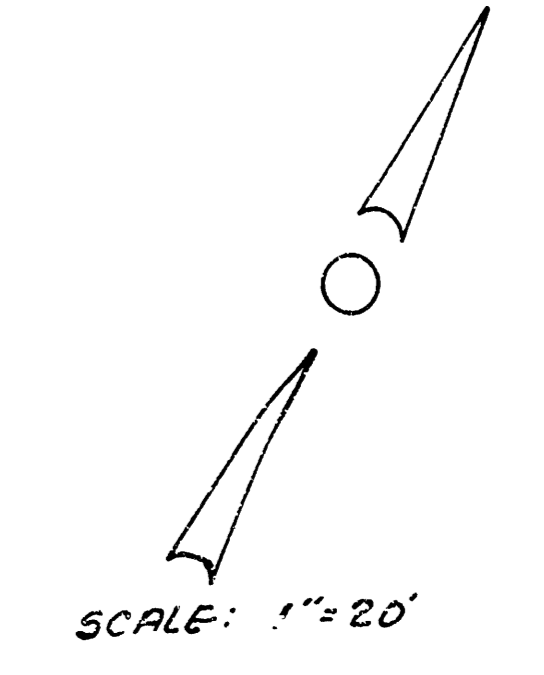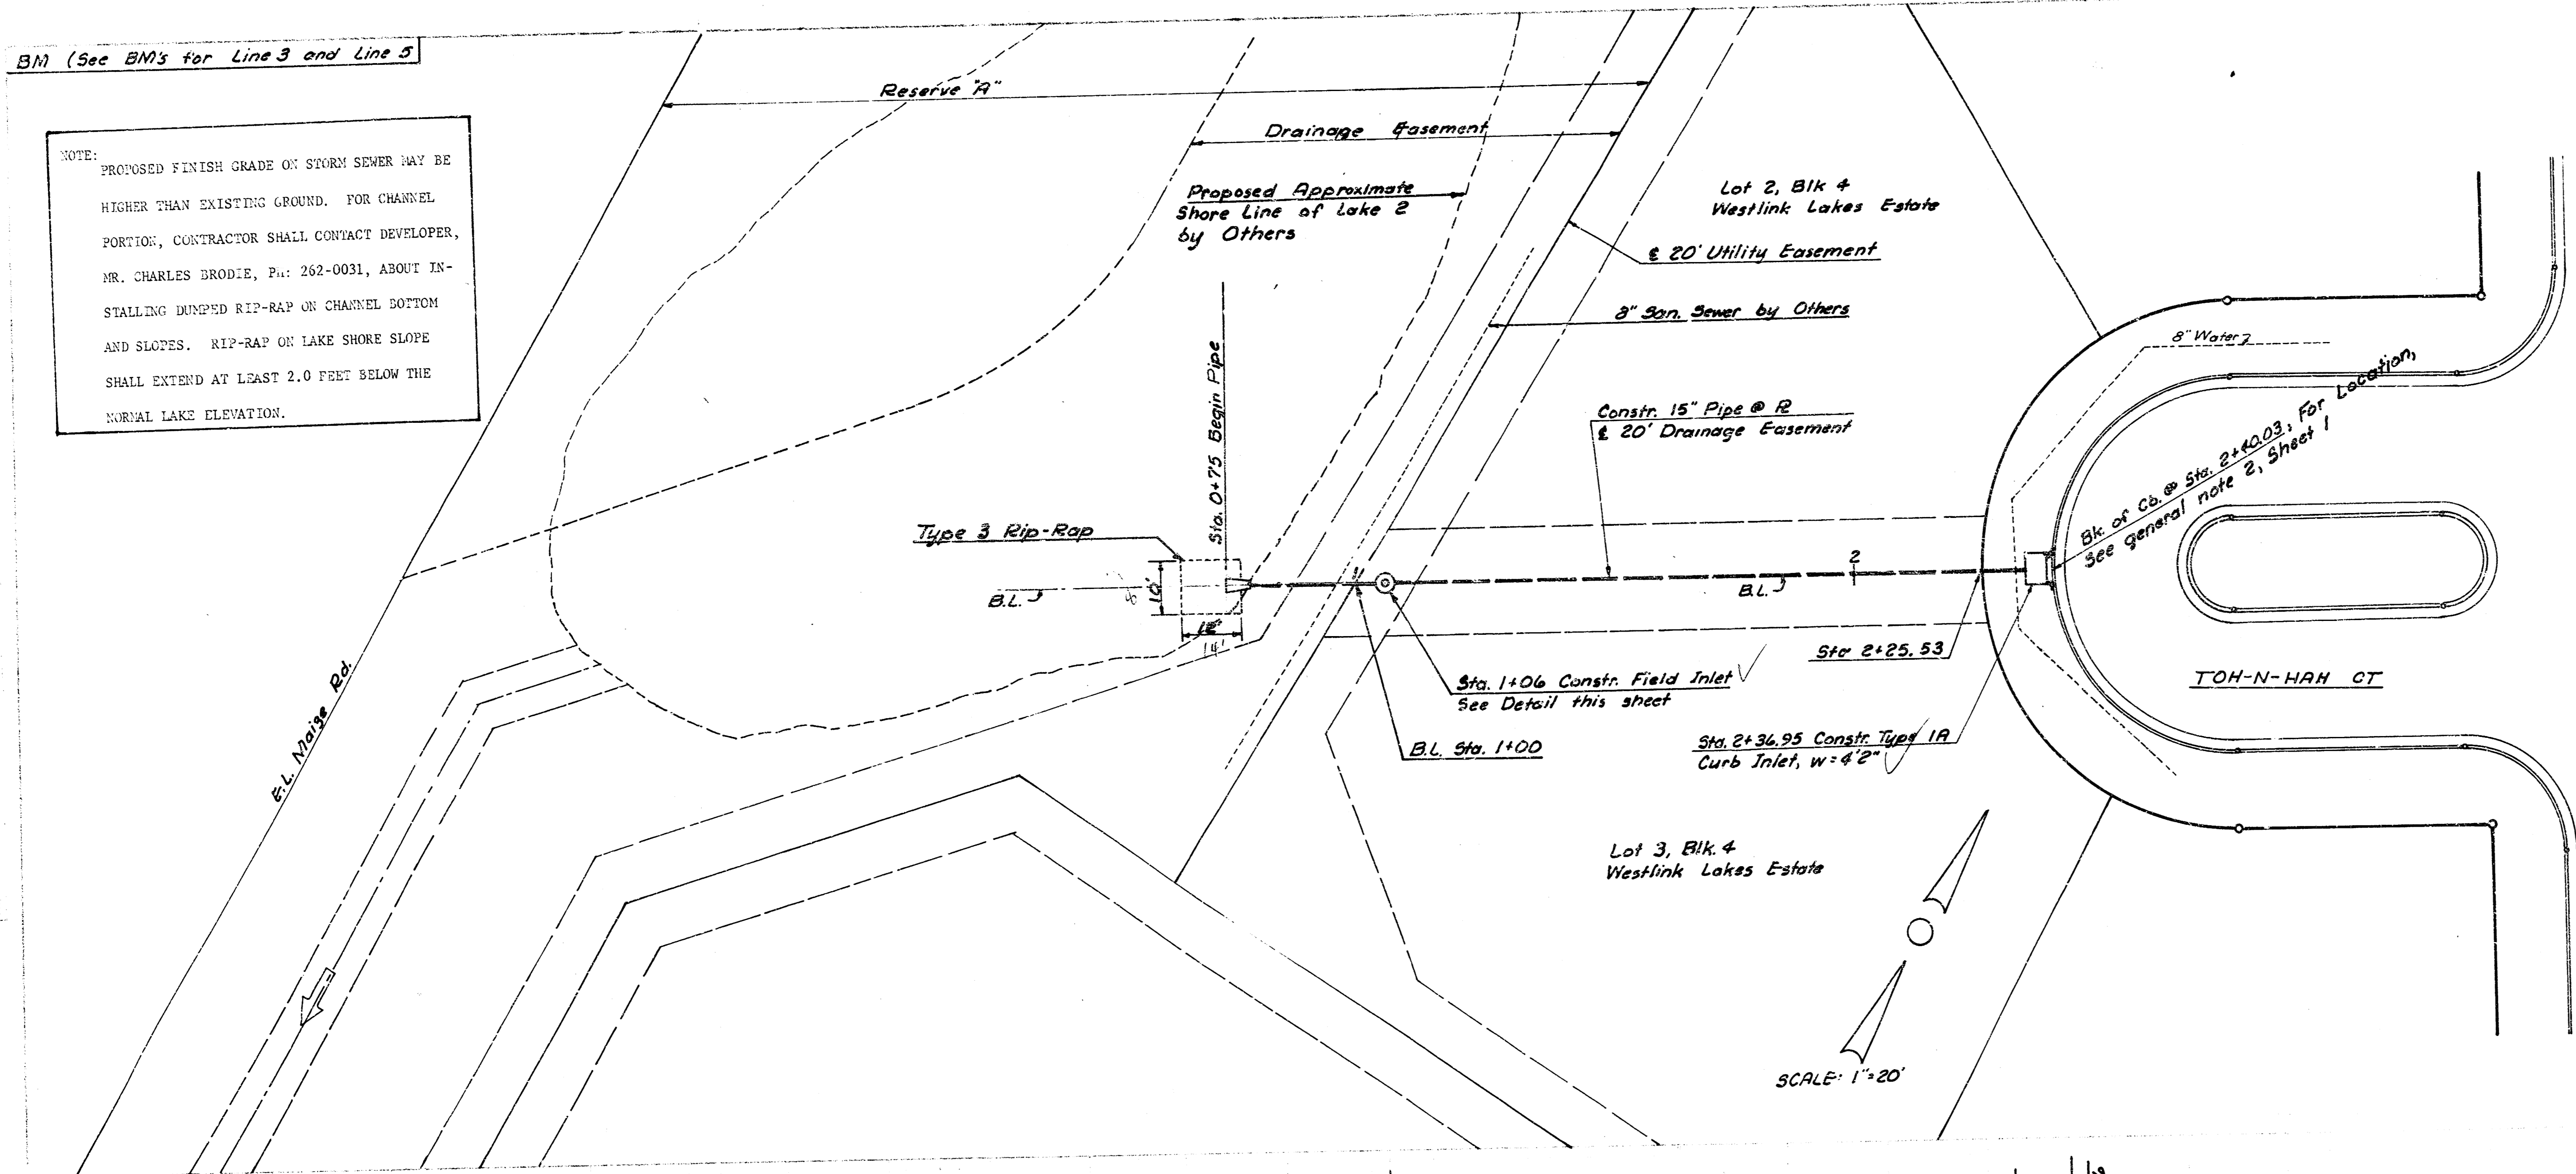

SCALE: 1"=20'

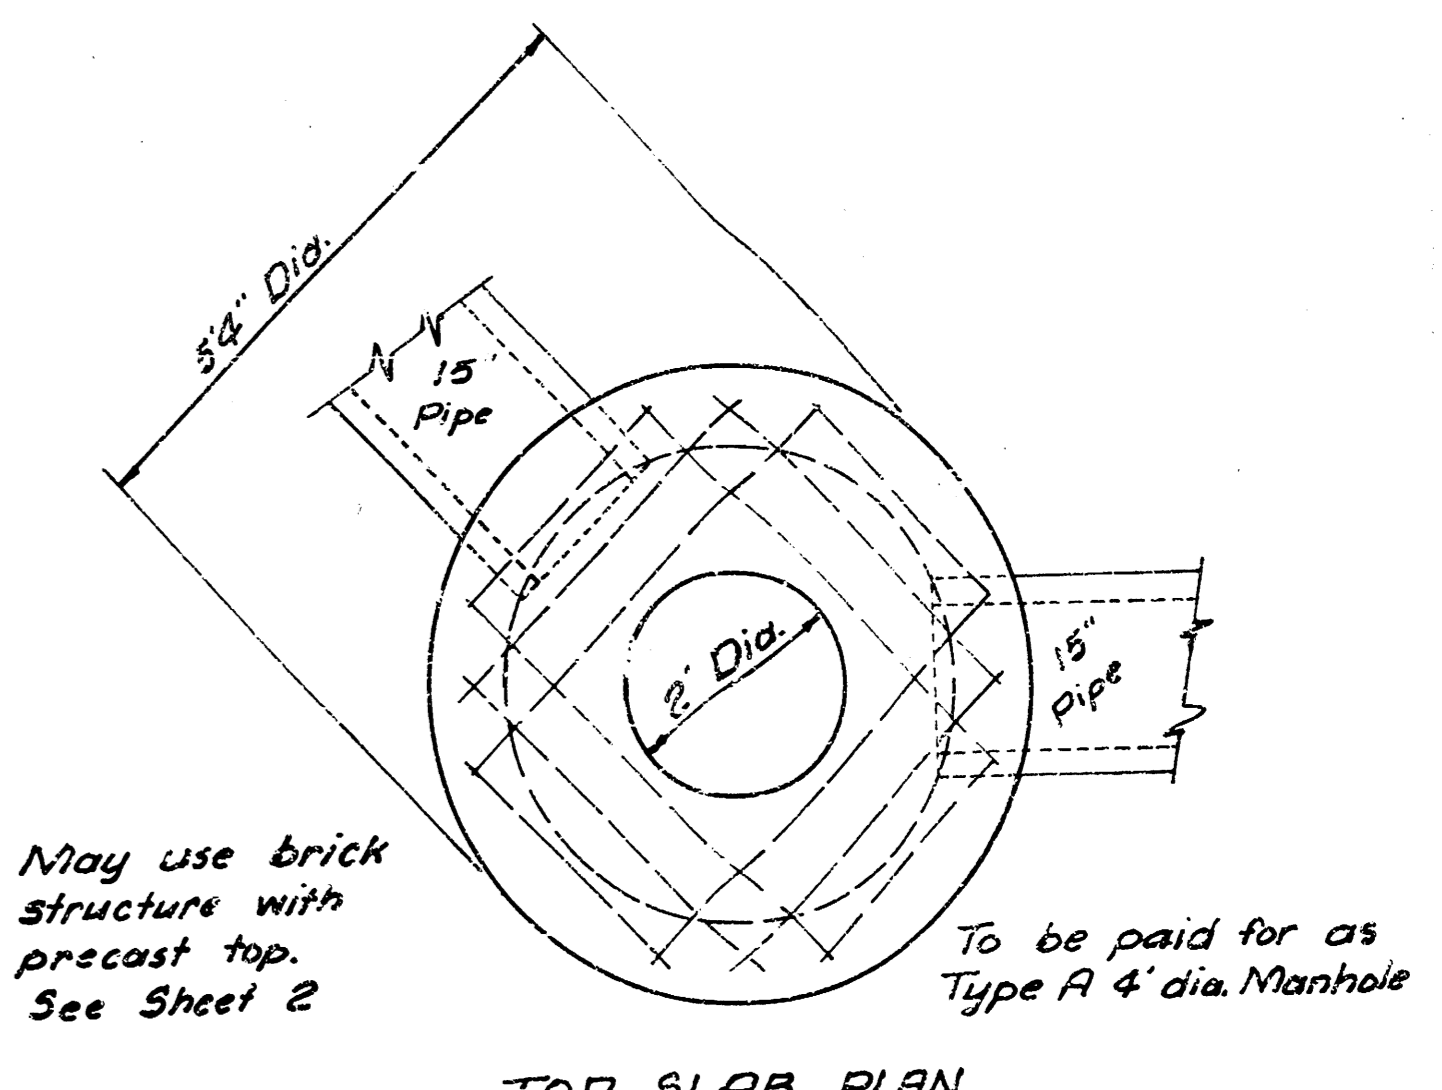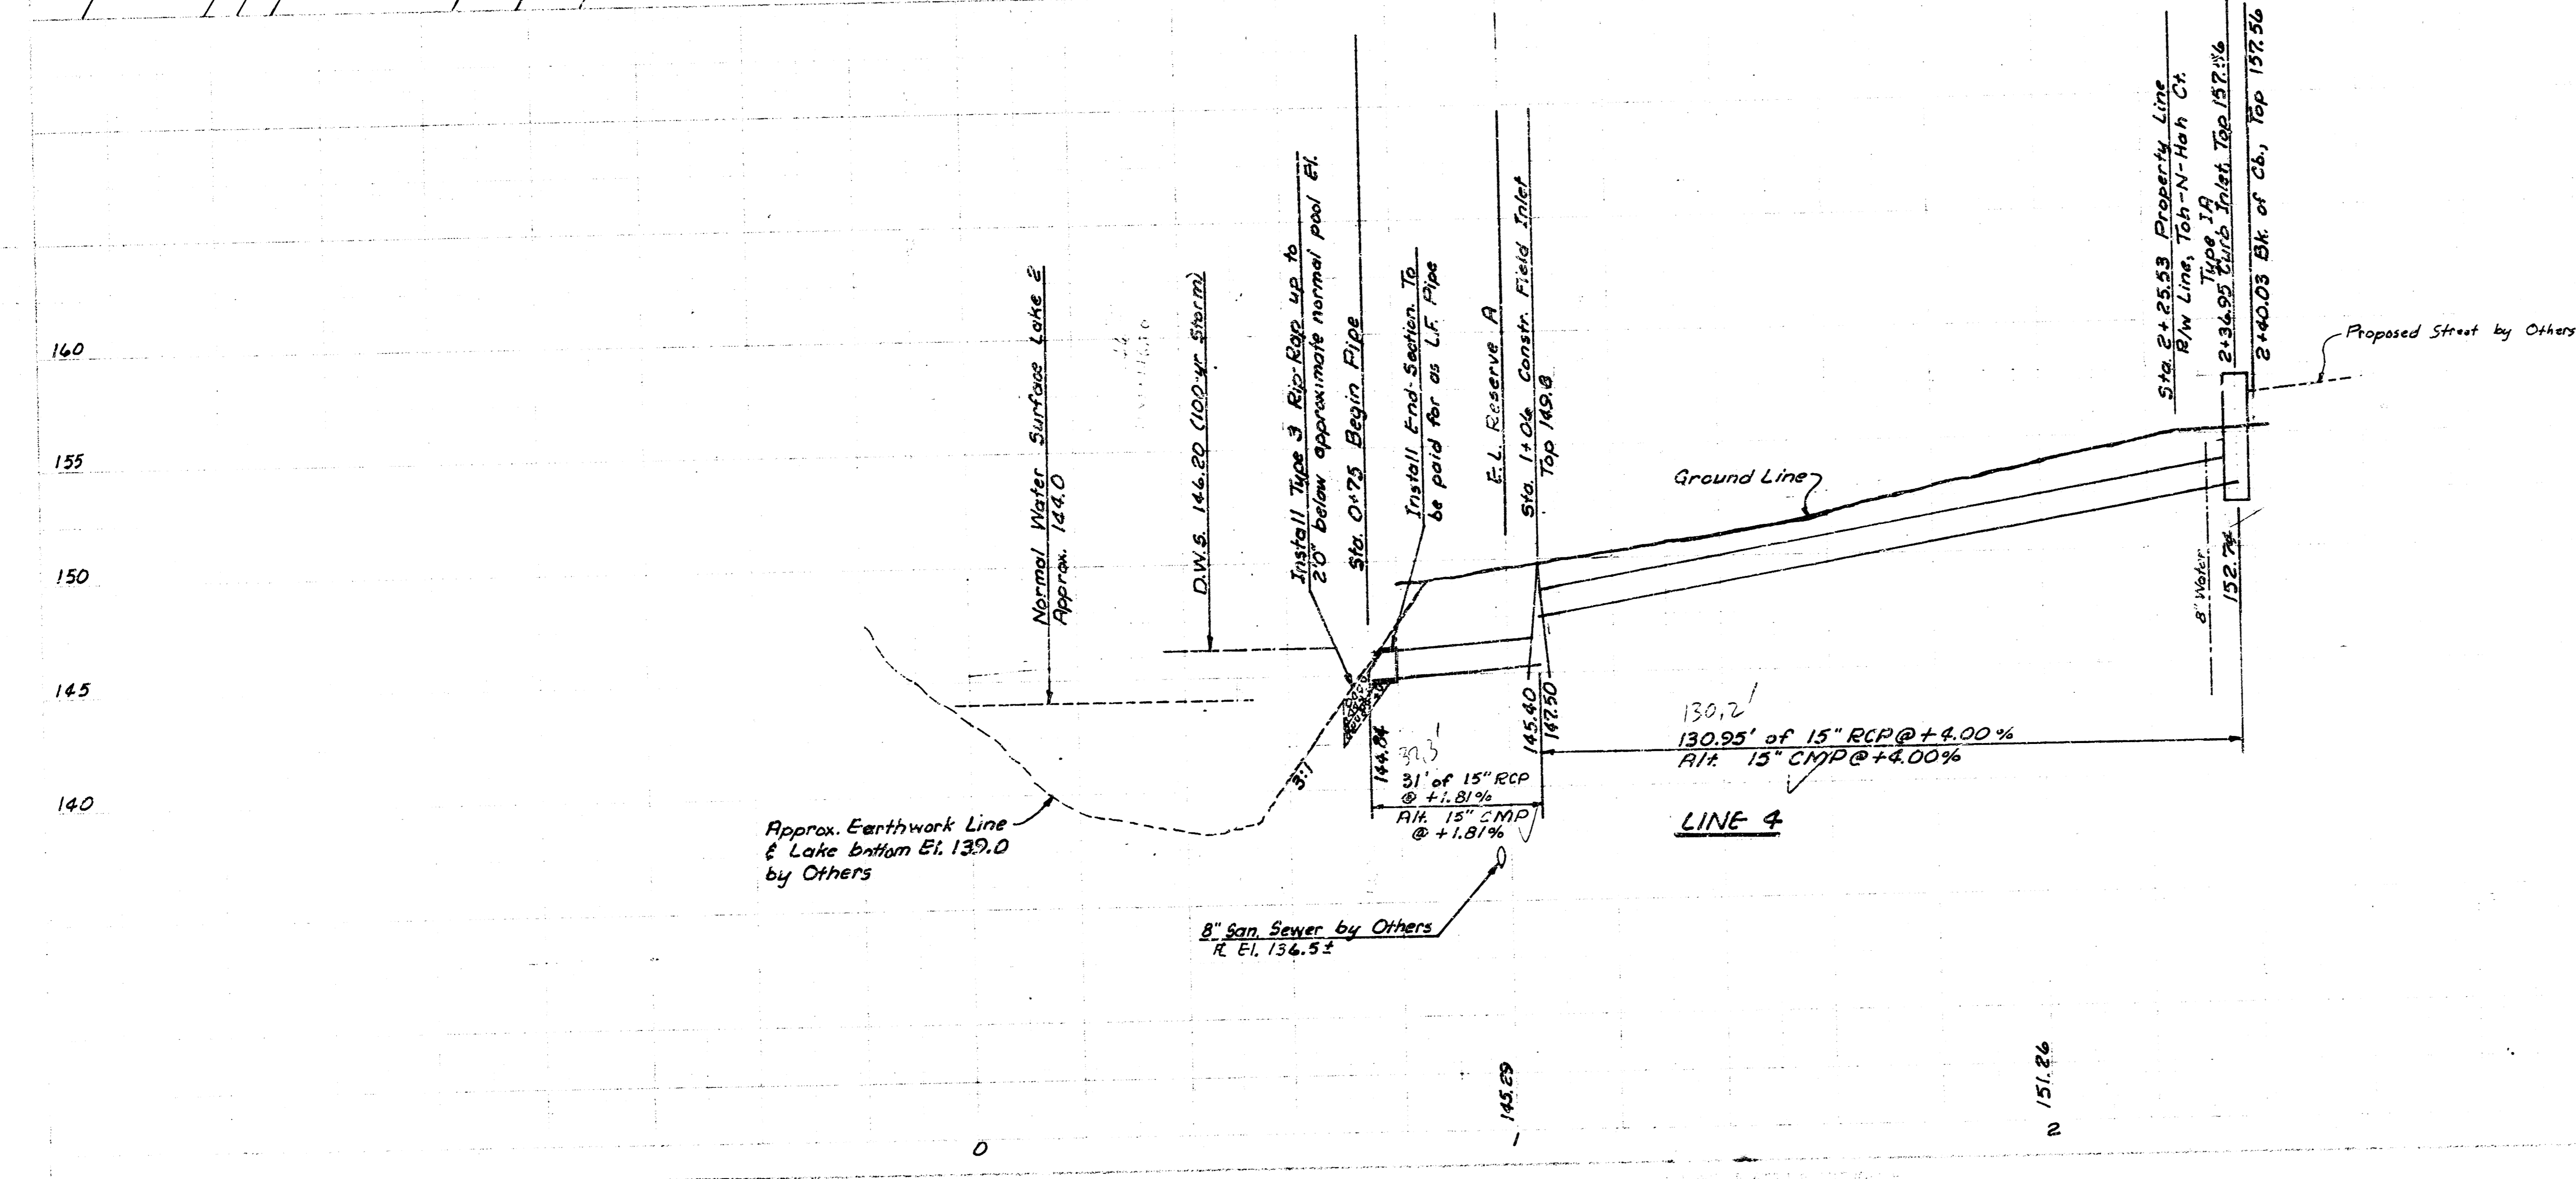

May use brick structure with precast top. See Sheet 2. To be paid for as Type A 4' dia. Manhole.

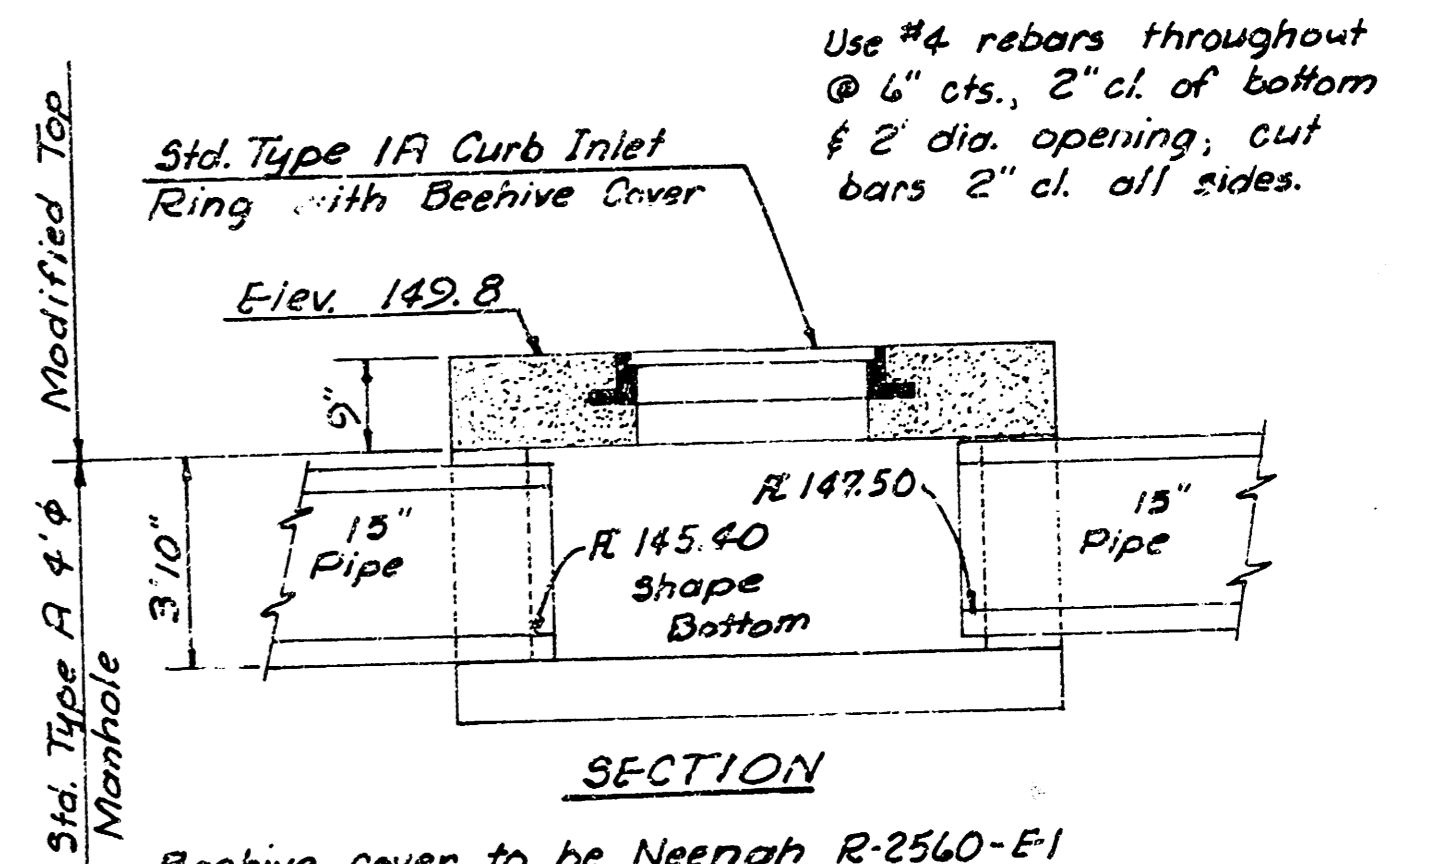

Use #4 rebar throughout @ 6" cts., 2" cl. of bottom & 2" dia. opening, cut bars 2" cl. all sides. Beehive cover to be Neenah R-2560-E1 Beehive grate or approved equal.

STORM WATER SEWER NO. 146

PART II

2-6'x4.5' R.C.B.C.



WESTLINK LAKES ESTATE
HARVEST LANE AT MAIZE RD.


CITY OF WICHITA, KANSAS

R.W. LINN CITY ENGINEER


PROJ. NO. 468 76 245 80649 000 000 001

DATE:

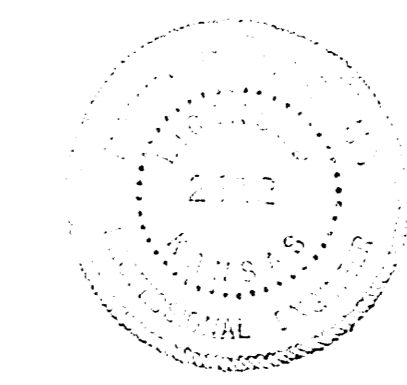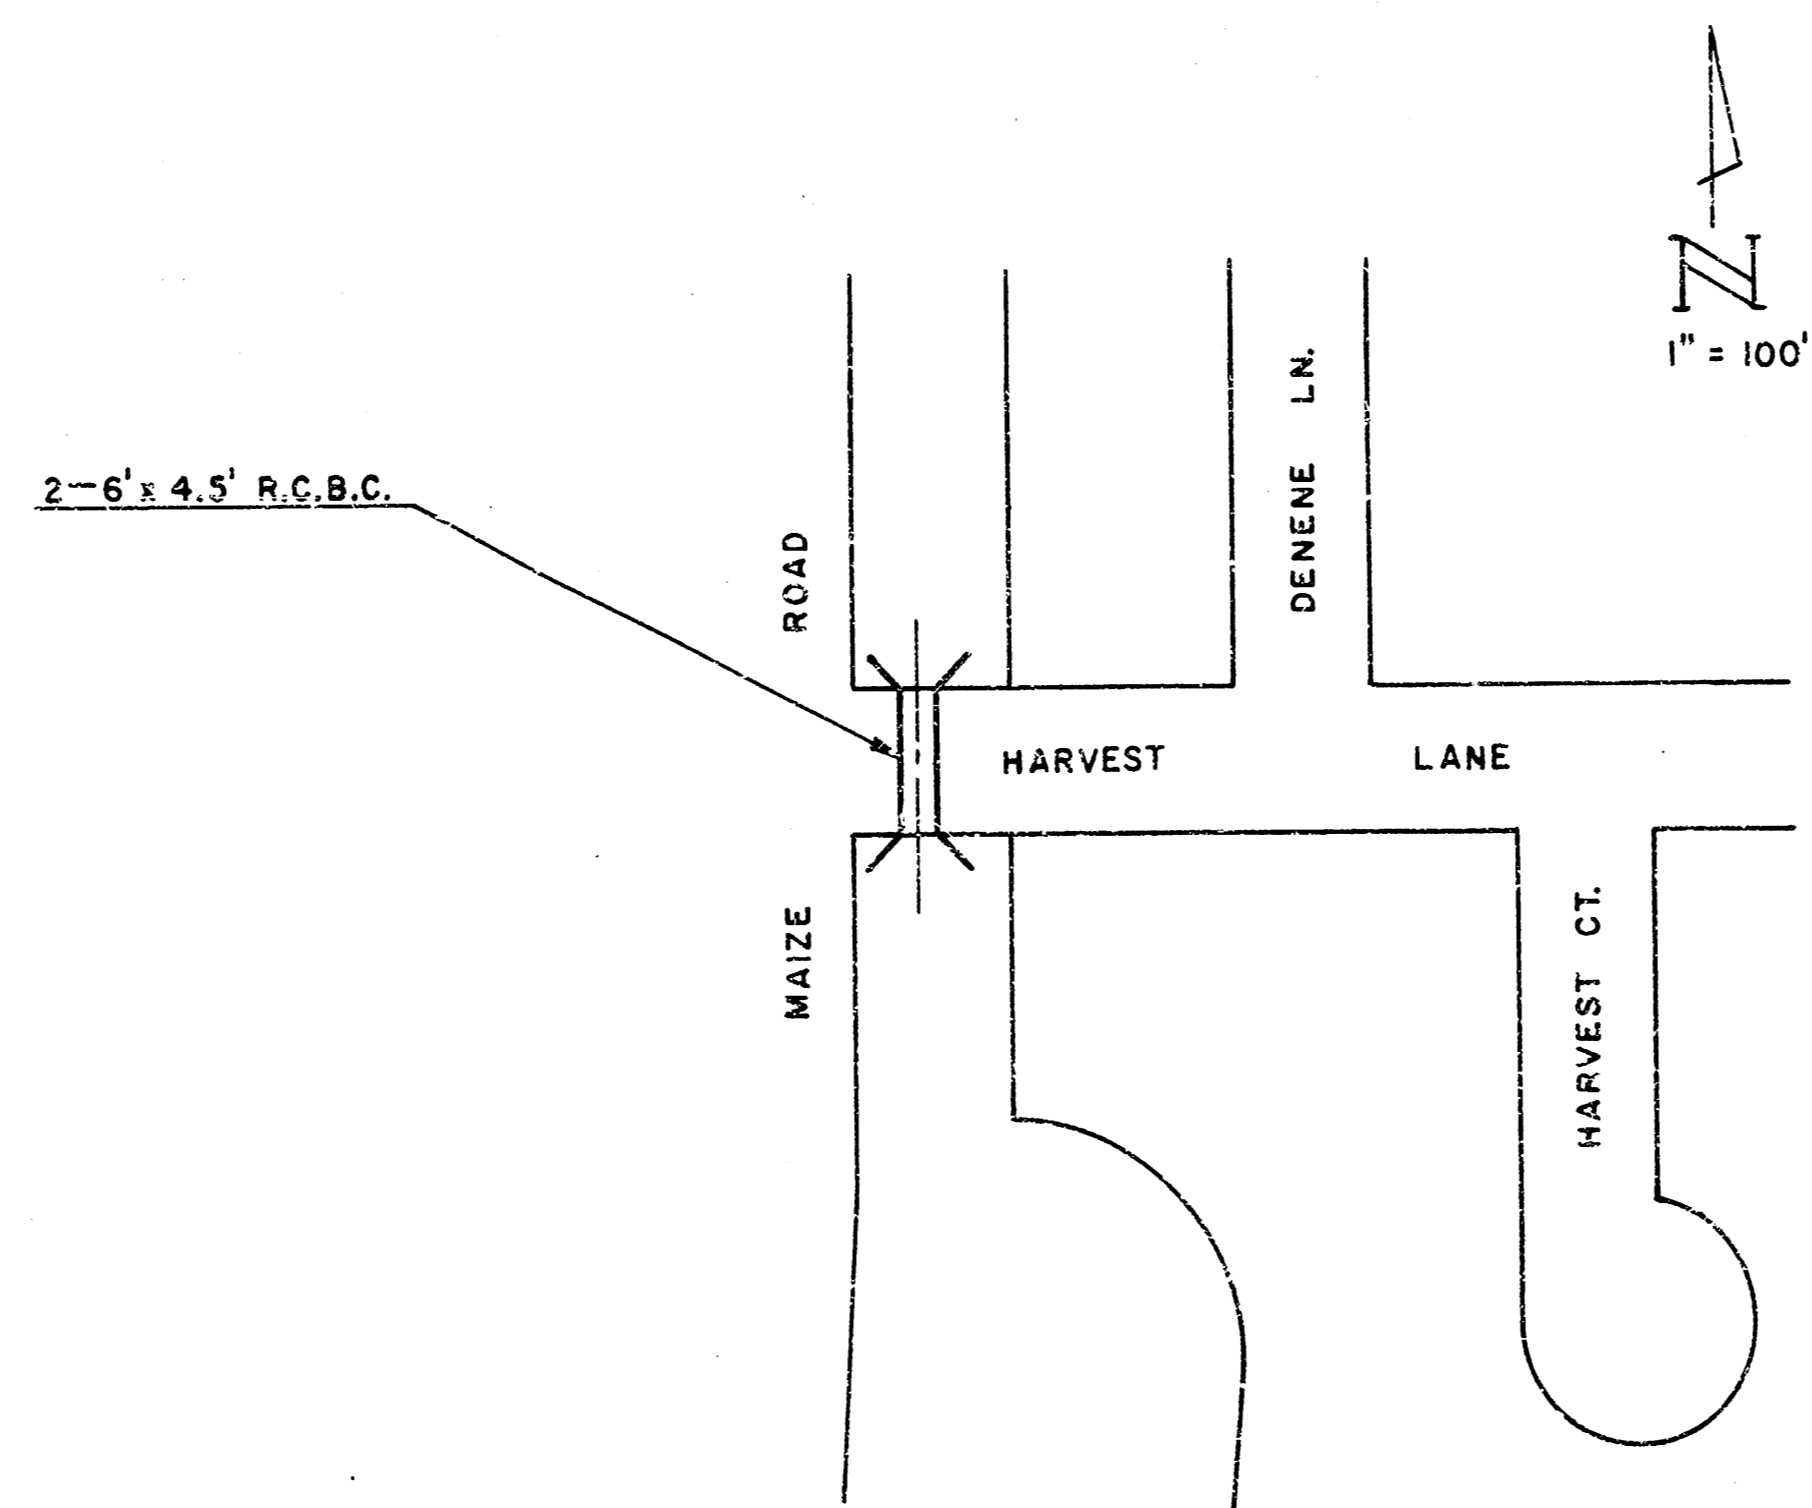

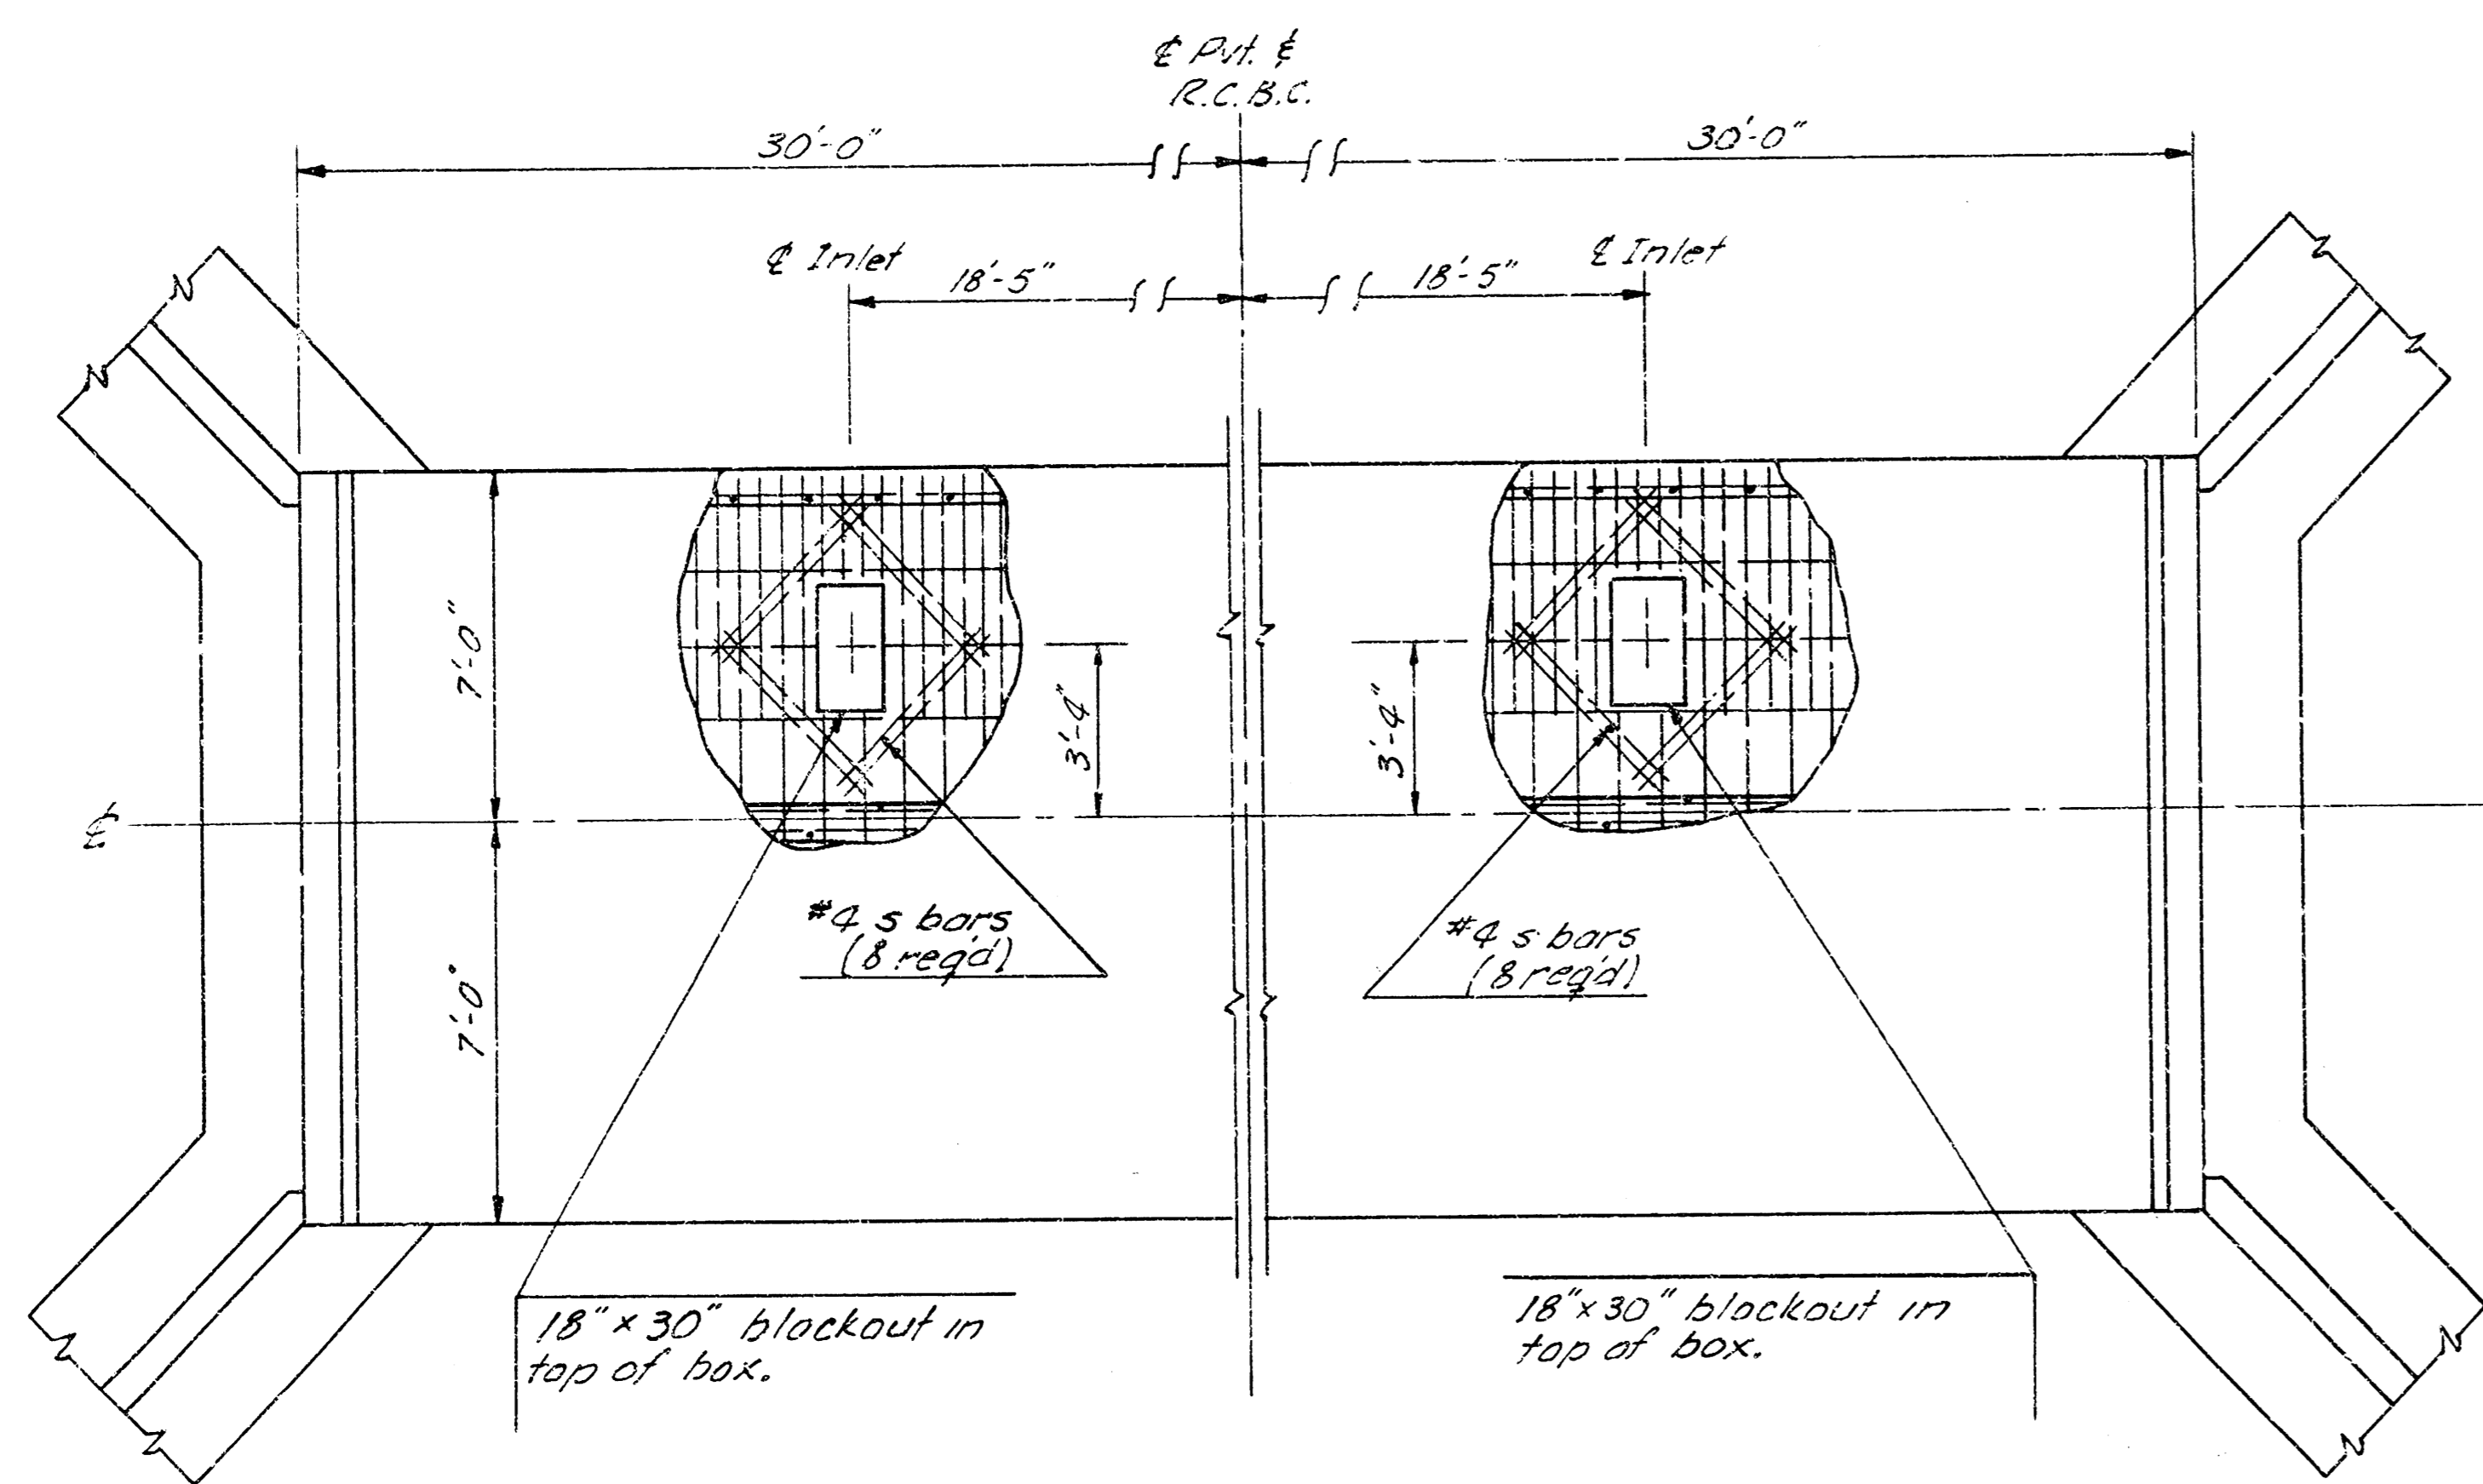


PLAN-INLET LOCATION
1/4"=1' 0"

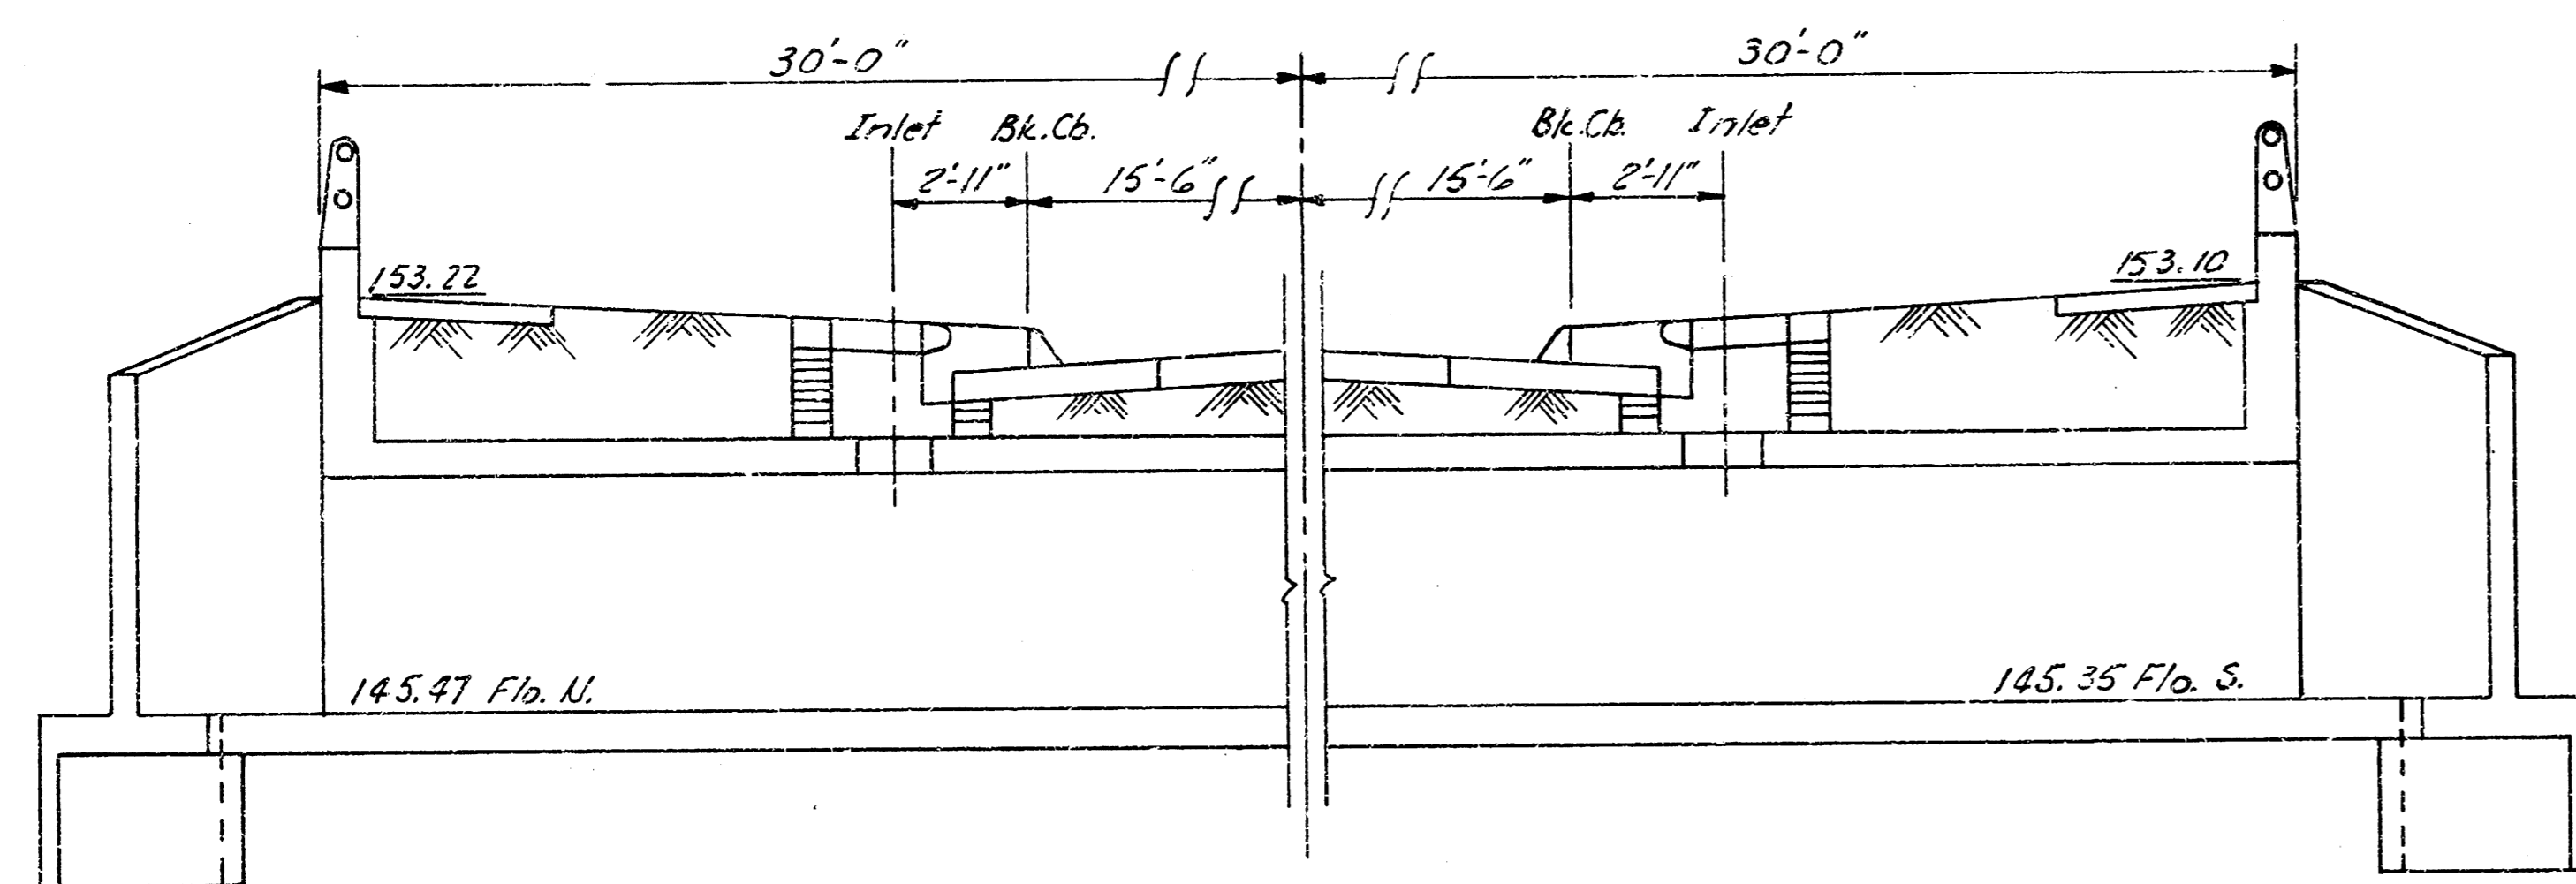


ELEVATION-INLET LOCATION
1/4"=1' 0"

3 1/2" Dia. tubing with 3/16" wall thickness

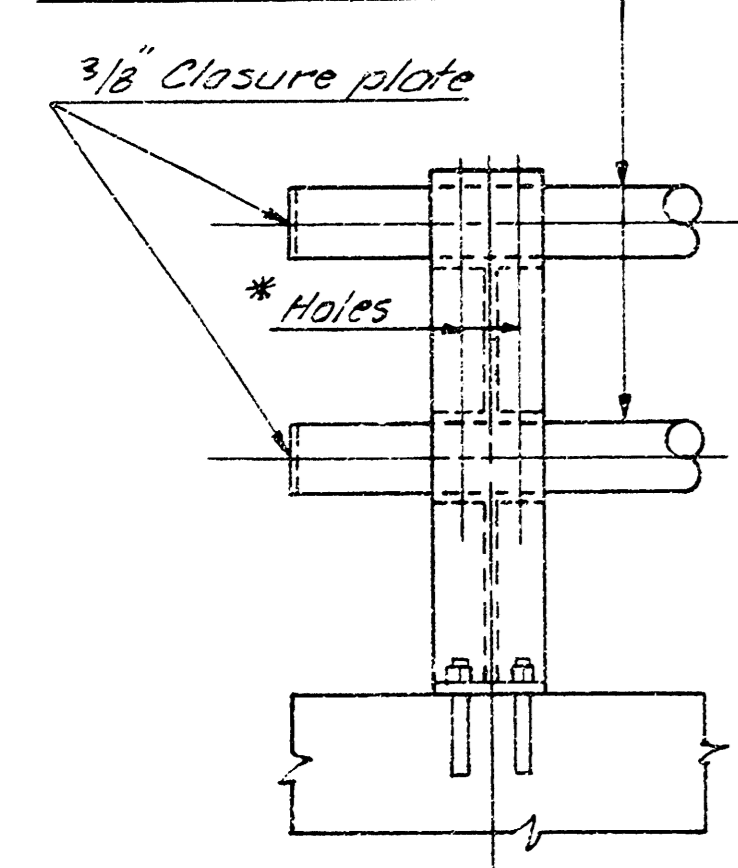


DETAIL-ALUMINUM RAILING
No Scale


Note: Aluminum Handrail
Aluminum posts shall be Reynolds Aluminum Highway Products Bridge Railing System N^o 2R19A or equal.
Top & bottom rails shall be 3 1/2" O.D. x 3/16" wall tube of 6063-T6 Aluminum.
Aluminum skids between concrete and post base may be used.
The space below posts shall be thoroughly caulked with Alumastic compound or other approved material.

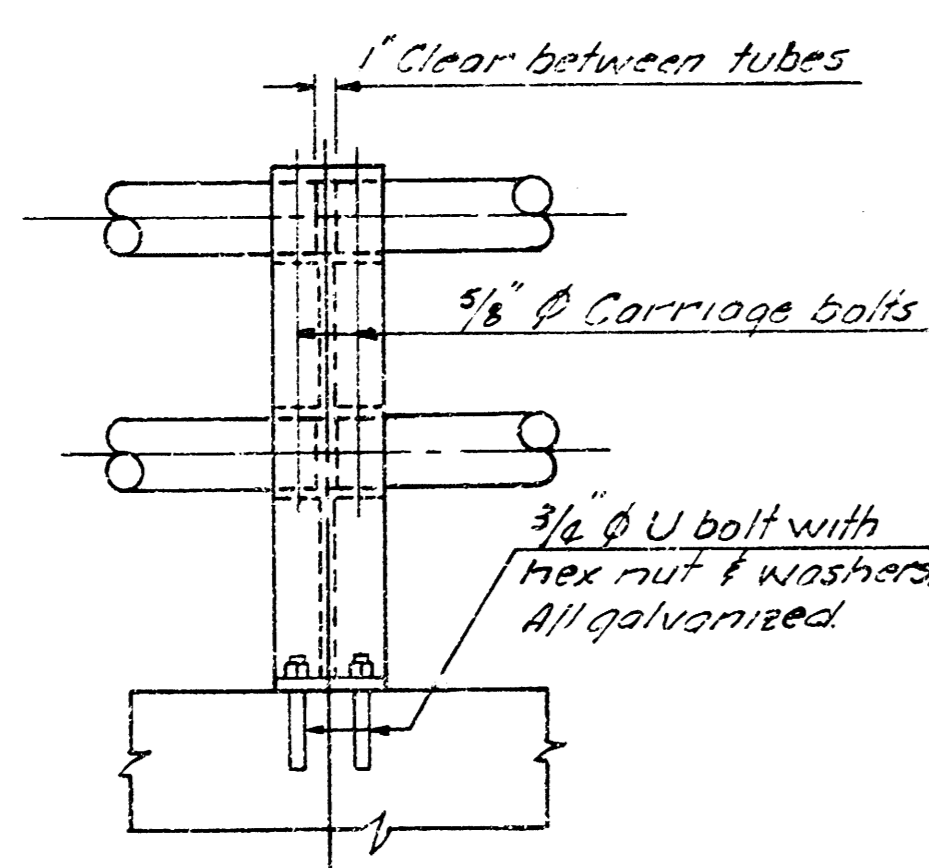


GALVANIZED U BOLT
No Scale

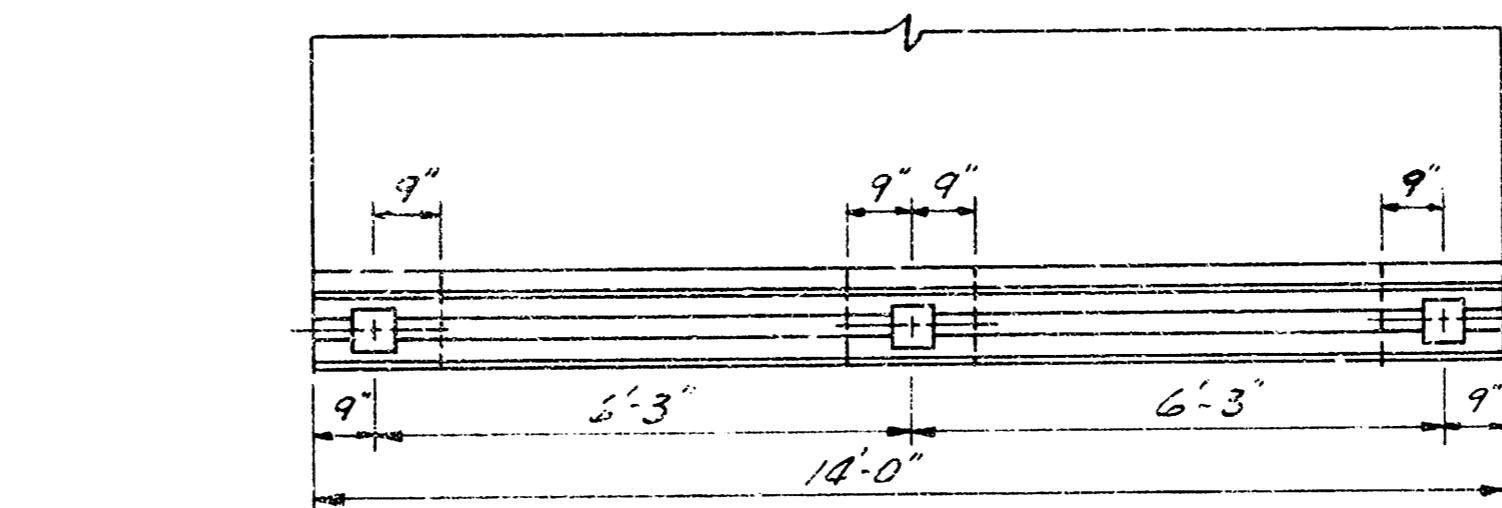


PLAN-RAILING
3/8"=1' 0"

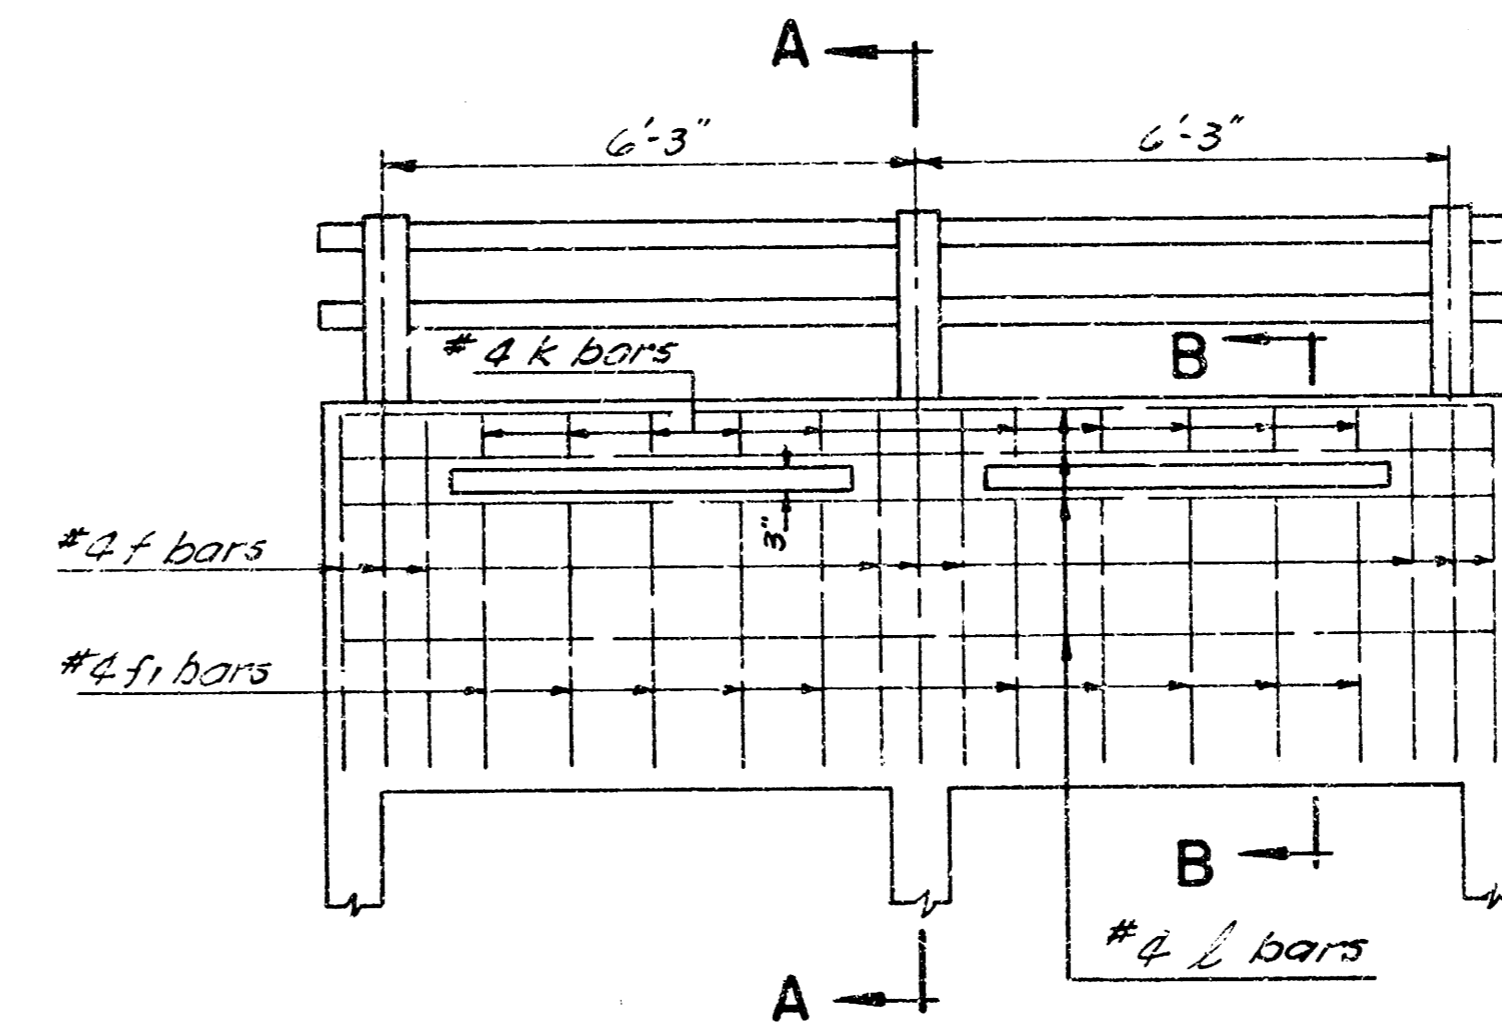

SECTION-RAILING
3/8"=1' 0"

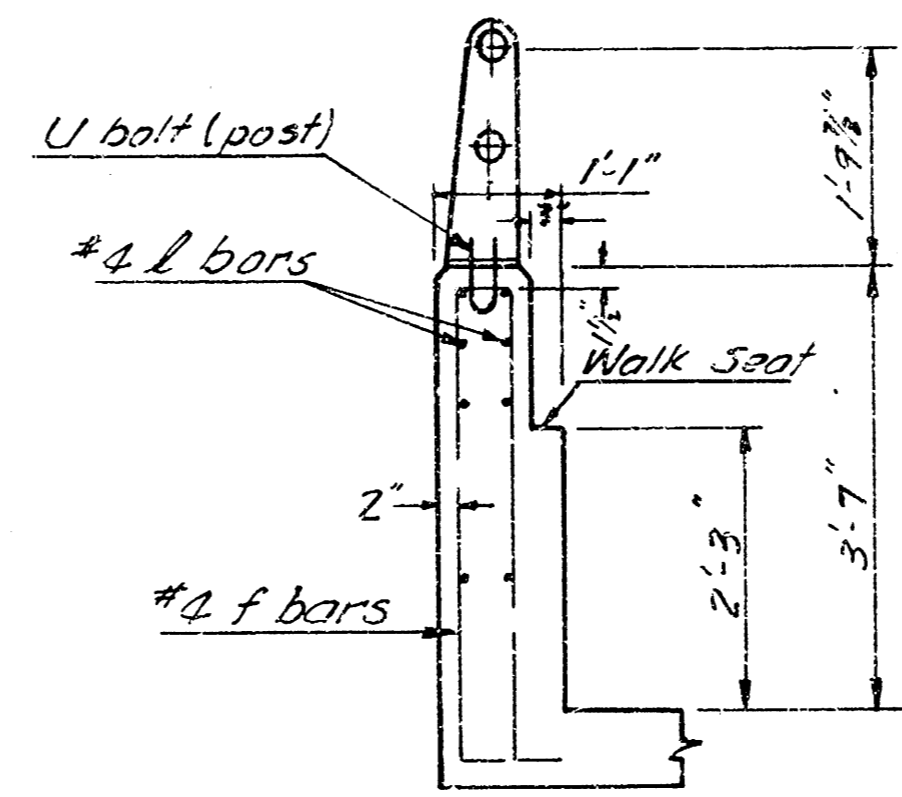

SECTION A-A
1/2"=1' 0"

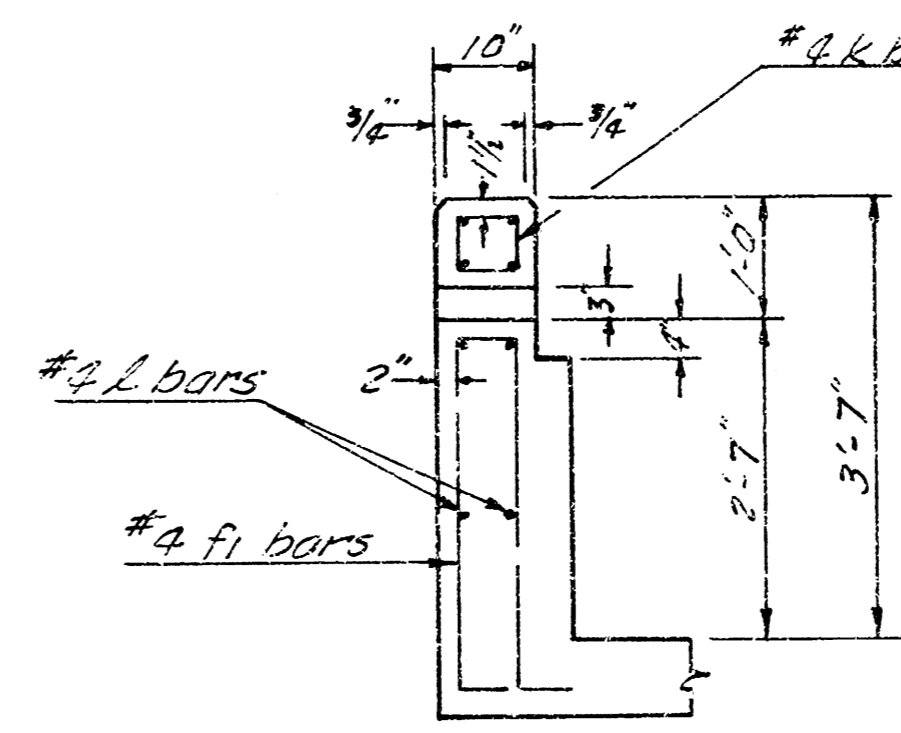

SECTION B-B
1/2"=1' 0"

BAR SCHEDULE					
BAR	SIZE	LENGTH	NO.	SHAPE	WEIGHT
L	#5	13'-9"	124	—	2065.14
M	#5	18'-7"	124	—	2114.70
N	#5	7'-5"	124	—	1051.34
O	#4	3'-0"	88	—	1822.87
P	#4	16'-0"	5	—	42.75
Q	#4	22'-0"	12	—	233.16
R	#4	7'-0"	22	—	102.87
S	#5	7'-5"	80	—	517.72
T	#4	12'-8"	4	—	33.65
U	#4	19'-1"	5	—	120.92
V	#4	9'-2"	19	—	102.22
W	#4	7'-2"	20	—	75.77
X	#4	7'-5"	8	—	124.71

Revised No. & Wt. 7-26-79

GENERAL NOTES


- CLASS A-AE - CONCRETE SHALL BE USED THROUGHOUT ON THE STRUCTURE. ALL REINFORCING STEEL SHALL CONFORM TO A.S.T.M. SPECIFICATIONS.
- EARTHWORK - ALL EARTHWORK SHALL BE CONSIDERED AS "COMMON EXCAVATION" EXCEPT FOR THE SIDEWALL. ALL EXCAVATION SHALL BE INCLUDED IN "LUMP SUM BID".
- BACKFILL - ALL BACKFILL AND EXCAVATION TO EXTEND TO (2') BEYOND SIDES OF BOX AND WING-WALLS.
- BEVEL - ALL EXPOSED EDGES OF CONCRETE WITH 3/4" TRIANGULAR MOUNDING.
- WEEPHOLES - COURSE AGGREGATE SHALL BE DEPOSITED BEHIND EACH WEEPHOLE TO OCCUPY A SPACE EXTENDING (15") IN ALL DIRECTIONS ABOVE WEEPHOLE LINE. THIS WORK SHALL NOT BE PAID FOR DIRECTLY, BUT SHALL BE CONSIDERED A PART OF THE EXCAVATION WORK.
- SEAL COURSE - A SEAL COURSE CONSISTING OF 3" CLASS "A" CONCRETE SHALL BE CONSTRUCTED ONLY WHERE SPECIFIED ON THE PLANS OR BY THE ENGINEER. NO REINFORCING SHALL BE PLACED UNTIL THE SEAL COURSE HAS GAINED SUFFICIENT STRENGTH TO PERMIT WORKING UPON IT WITHOUT DAMAGE.
- BUILDING OF CULVERT - THE CULVERT SHALL BE BID AS A "LUMP SUM BID".
- THE QUANTITIES SHOWN IN THE "BILL OF MATERIALS OR ITEMS" WHICH ARE INCLUDED IN THE "LUMP SUM BID" OF THE CULVERT ARE FOR "INFORMATION PURPOSES ONLY". THE CONTRACTOR MUST SATISFY HIMSELF AS TO THE "QUANTITIES" AND THE ENGINEER ASSUMES NO RESPONSIBILITIES FOR THEIR ACCURACY. THE CONTRACTOR WILL HAVE THE FULL RESPONSIBILITY FOR PROVIDING ALL MATERIALS ON THE DETAILED PLANS NECESSARY TO COMPLETE THE PROJECT.

BILL OF MATERIALS		
ITEMS	QUANTITY	UNIT
Class A-AE Concrete	92.3	C.Y.
Reinforcing Steel	10,879.7	LB.S
Hand Excavation	14.3	C.Y.
Aluminum Handrail	23.0	L.F.
Class A Concrete - Seal Course	7.8	C.Y.
Excavation	472.5	C.Y.
Compacted Fill	35.1	C.Y.


Revised quantity 7-26-79

STORM WATER SEWER NO. 146
PART II
2-6' x 4.5' R.C.B.C.
WESTLINK LAKES ESTATE
HARVEST LANE AT MAIZE RD.
CITY OF WICHITA, KANSAS
R.W. LINN CITY ENGINEER
DATE
PROJ. NO. 4" 8 76 245 80649 000 000 001

12/13

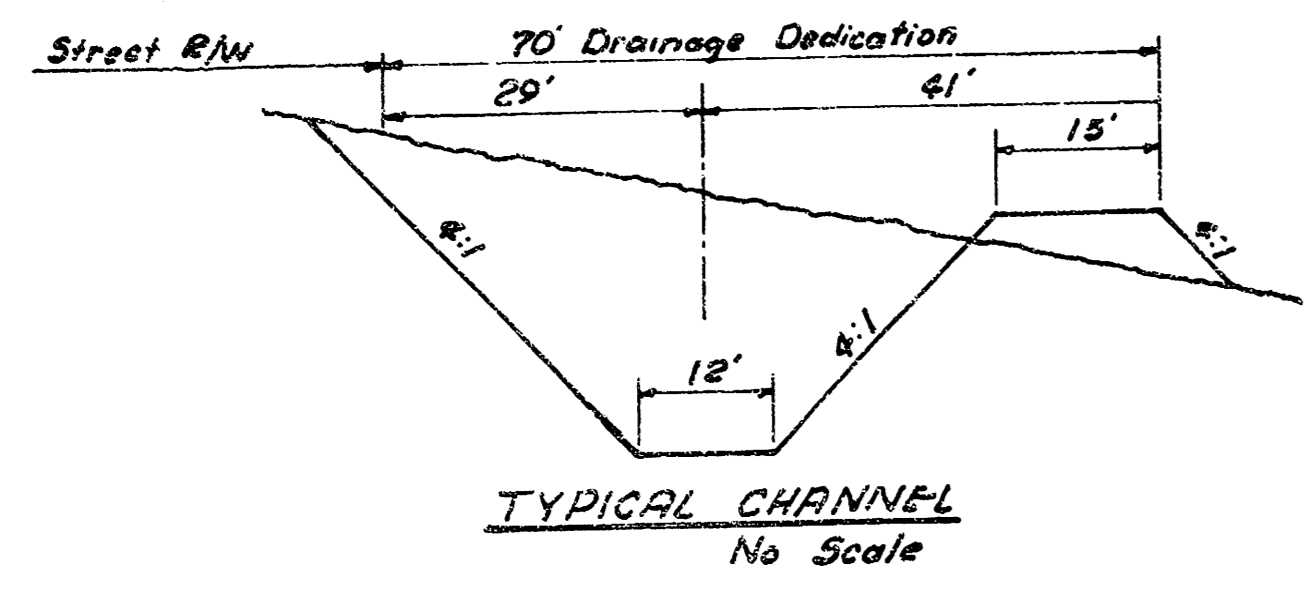


THE RIP-RAP ON THIS PROJECT SHALL BE TYPE 4. THE TYPE 4 RIP-RAP SHALL BE 18" RIP-RAP ON 6" SAND AND GRAVEL BEDDING. THE ROCK FOR RIP-RAP AND GRAVEL PROTECTION SHALL BE HARD, DENSE, DURABLE AND SHALL BE REASONABLY WELL GRADED. THE SIZE RANGE OF ROCK USED SHALL HAVE A MAXIMUM SIZE OF 1/3 CUBIC YARD AND A MINIMUM SIZE OF 1/10 CUBIC FOOT. THE 6 INCH SAND AND GRAVEL BEDDING FOR RIP-RAP SHALL BE A CONTINUOUS LAYER OF SAND AND GRAVEL OR SAND AND CRUSHED ROCK, REASONABLY WELL GRADED TO A MAXIMUM OF 1 1/2 INCHES IN SIZE.

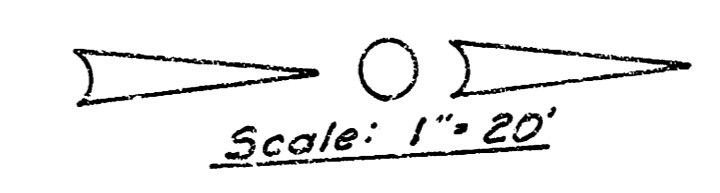


B.M. 154.20 "d" in center of east Adwl. RCB 553' N. of 1/4 corner of Sec. 7-27-11W.

PLAN JEG:el, Flood Control Plan WSK

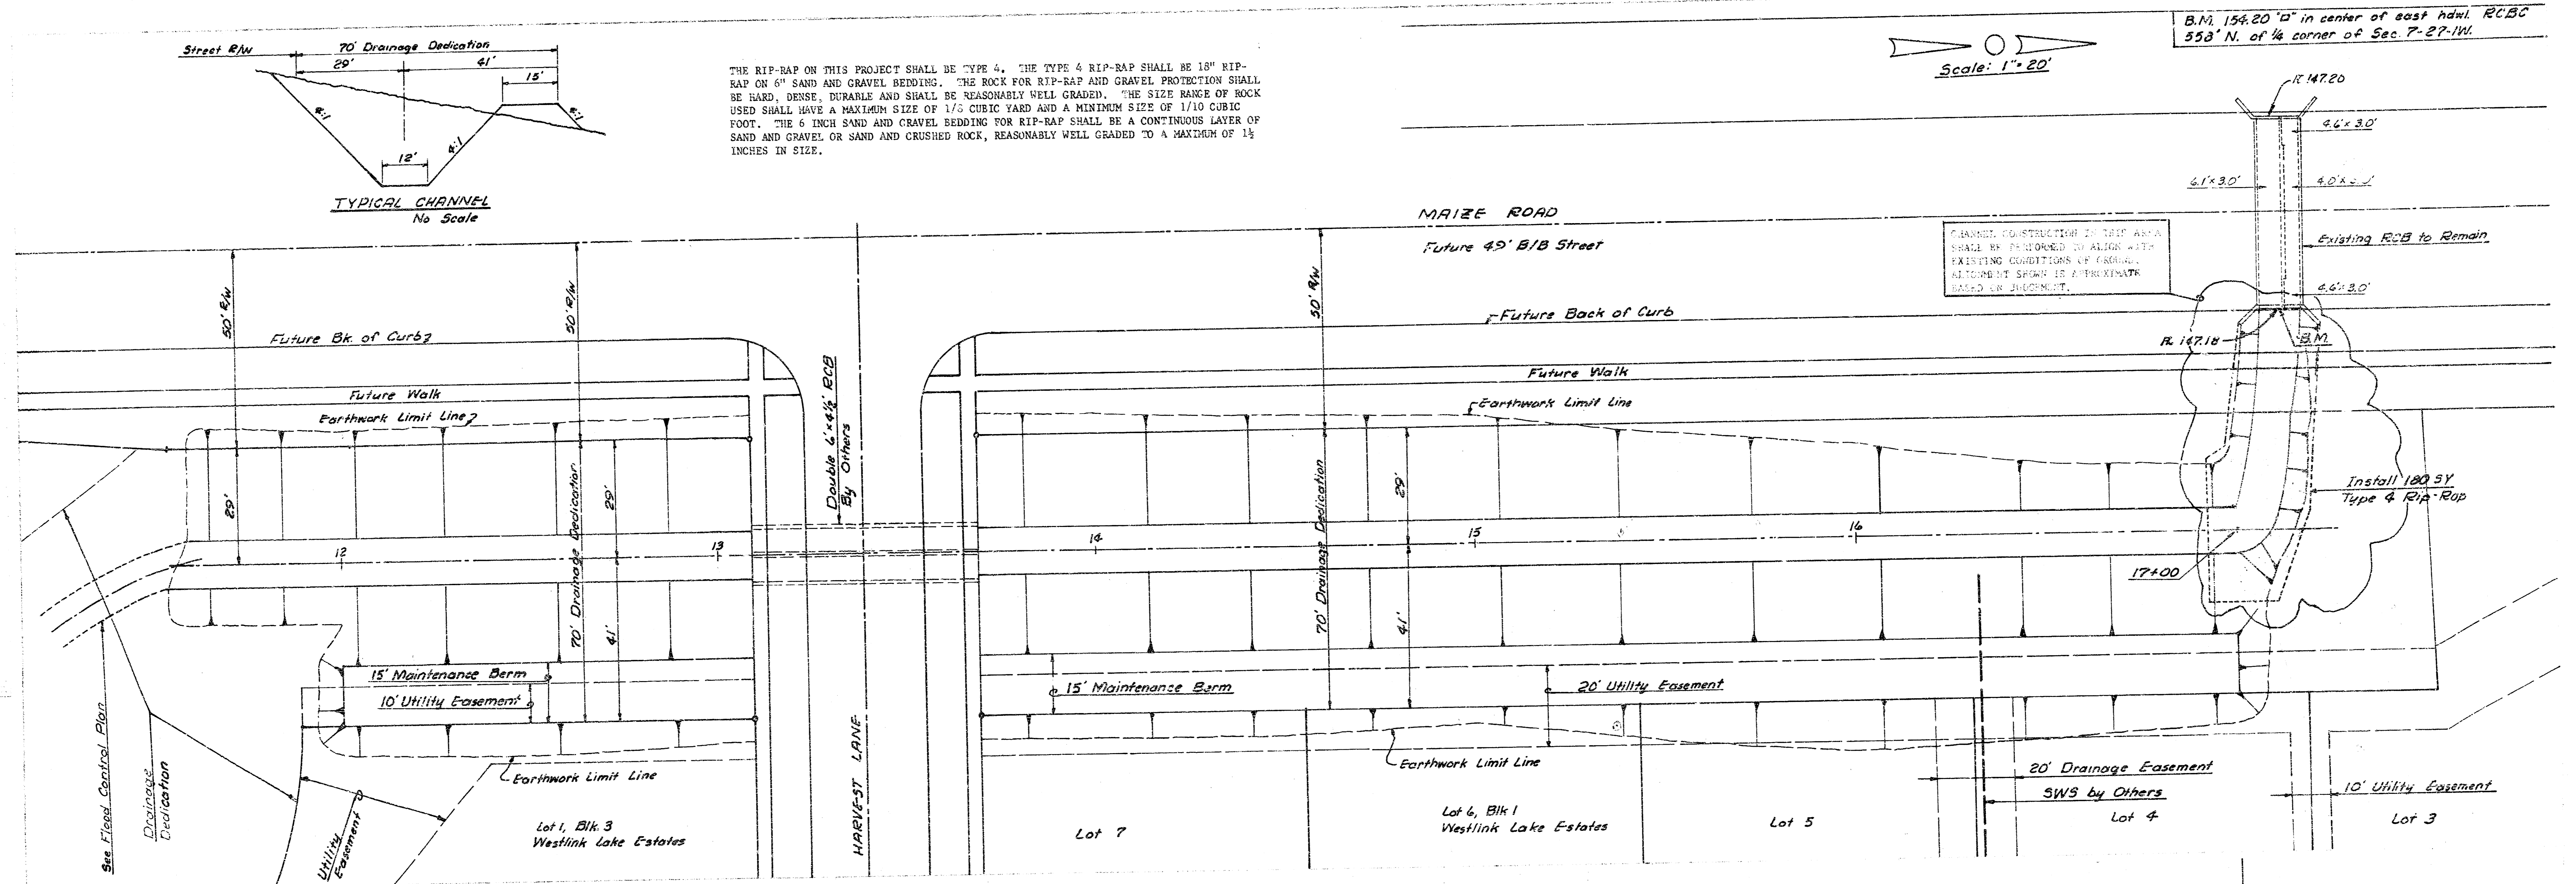

CHANNEL CONSTRUCTION IN THIS AREA SHALL BE FINISHED TO ALIGN WITH EXISTING CONDITIONS OF CHANNEL. SLOPMENT SHOWN IS APPROXIMATE BASED ON JUDGMENT.

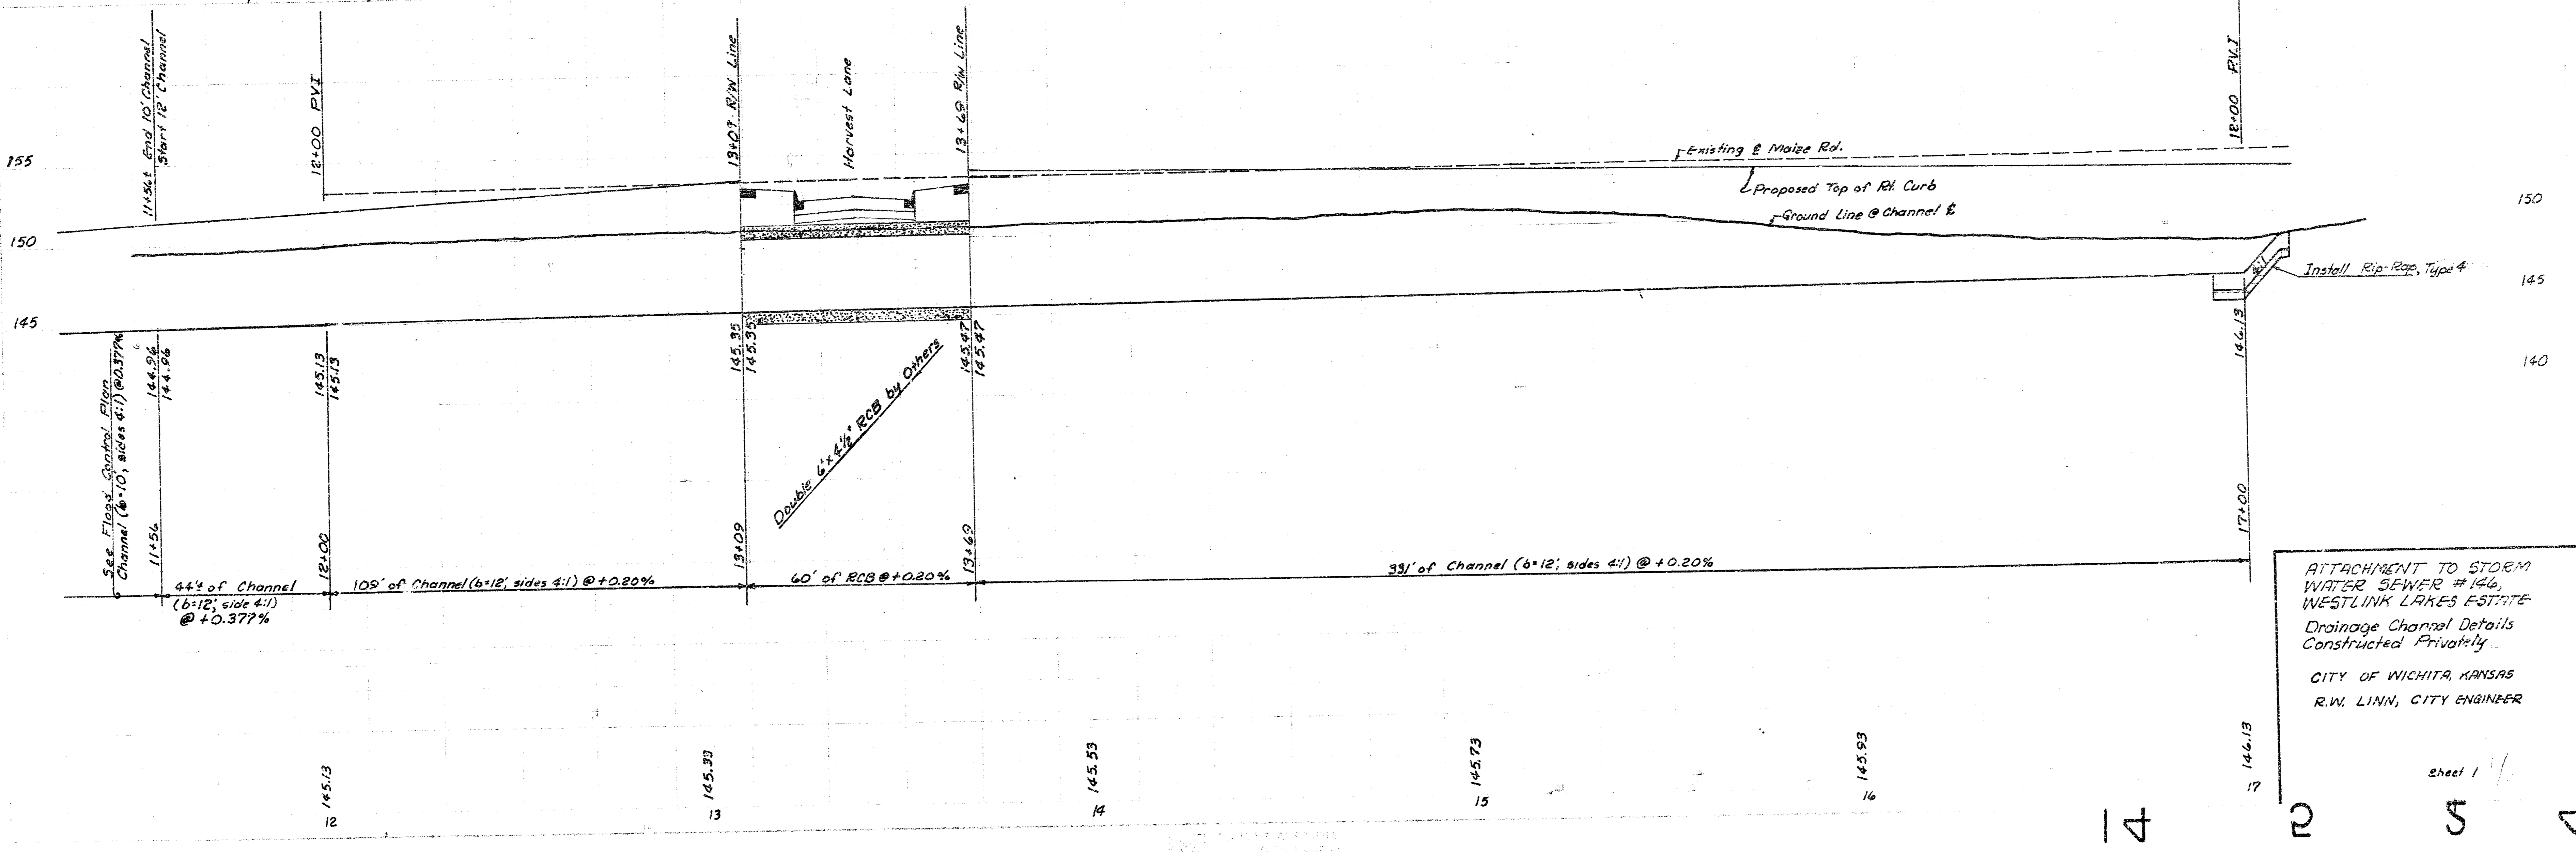

ATTACHMENT TO STORM WATER SEWER #146, WESTLINK LAKES ESTATE Drainage Channel Details Constructed Privately. CITY OF WICHITA, KANSAS R.W. LINN, CITY ENGINEER

Sheet 1