NOTE:
Field Engineer to determine the portion of each driveway that needs to be removed and replaced.


NOTE:
Existing backfill over the 8" San. sewer pipe is to be compacted by means of mechanical equipment approved by the Engineer, such that any unstable existing backfill shall be completely compacted.

The top 12" of the subgrade shall be mixed with cement and compacted in 6" lifts.

Est. 30 Cu.Yds. Borrow Excavation. (X-Sections required)
All excavated material to remain on project site.

As Built Plans
LWL
7-11-73

TYPICAL SECTION
No Scale

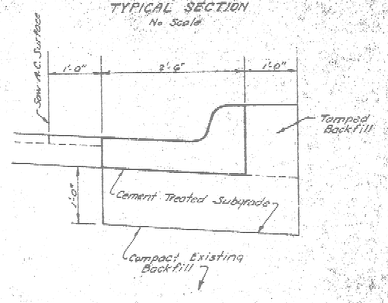


KINKAID STREET
Remove and reconstruct Conc. Curb & Gutter on North side Kinkaid from 149' W. of W.L. Terrace Dr. to W.L. Dellrose

R.W. LINN CITY ENGINEER
CITY OF WICHITA, KANSAS

Date: Sept. 1972

Project No. BHKS 501-074

H P S

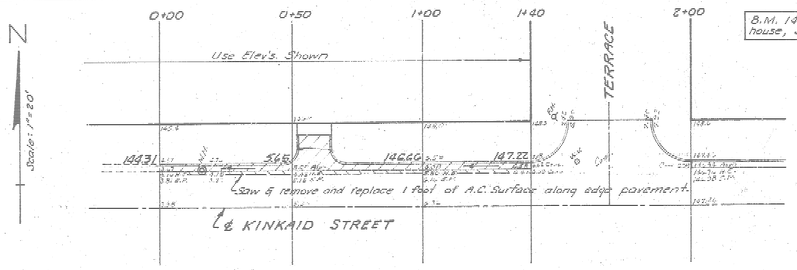

B.M. 149.35 N.W. corner conc. porch of house, S.E. corner Kinkaid & Terrace Dr.

NOTE:


Existing backfill over the 8" san. sewer pipe is to be compacted by the use of mechanical equipment approved by the Engineer, such that the unstable existing backfill shall be completely compacted.


The top 12" of the subgrade shall be mixed with cement and compacted in 6" lifts.

Est. 40 Cu. Yds. Borrow Excavation. (X-Sections Required)
All excavated material to remain on project site.

NOTE:

Field Engineer to determine the portion of each driveway that needs to be removed and replaced.

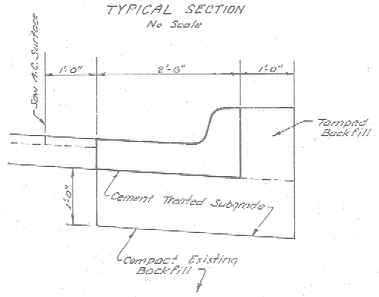

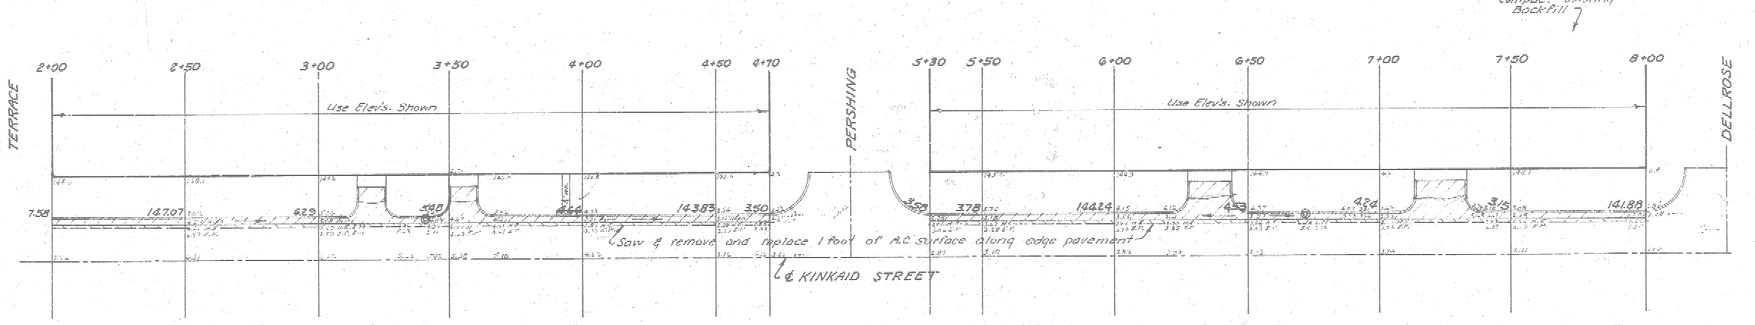

KINKAID STREET

Remove and reconstruct Comb. Curb & Gutter on North side Kinkaid from 140' W. of W.L. Terrace Dr. to W.L. Dellrose

R.W. LINN CITY ENGINEER
CITY OF WICHITA KANSAS

Date: Sept. 1972

PROJECT No. BHKS 501-074

JOHN L. ALLEN LICENSED 821 KANSAS PROFESSIONAL ENGINEER

R.W. LINN LICENSED KANSAS PROFESSIONAL ENGINEER

Surveyed D.C.D
Plan W.C.A.
By
Checked