Incidental Drainage by Others

N

KINKAID

AVENUE

MEAD

MOSLEY

20' ALLEY

3+86 4+01.37 4+50 5+00 5+36 5+56 6+00 6+50 7+06 7+36

4+01.37 5+42.2 5+62.2 7+01.7 7+41.8

EXCAVATION		COMP. FILL	
Prop.	Orig.	Prop.	Orig.
148.3	139	36.3	3.8
14.8	1.8	3.2	0.2
163.1	140.9	61.9	4.0

Use #4 bars, 3'-0" c/c on 2'-6" ctr.

DETAIL OF MASTIC JOINT

KINKAID


E.L. MEAD AVE. TO W.L. MOSLEY

30' CONC. & CB.


CITY OF WICHITA, KANSAS

B.E. SMITH CITY ENGINEER


DATE: AUG. 1962 PROJ. NO. C12-4

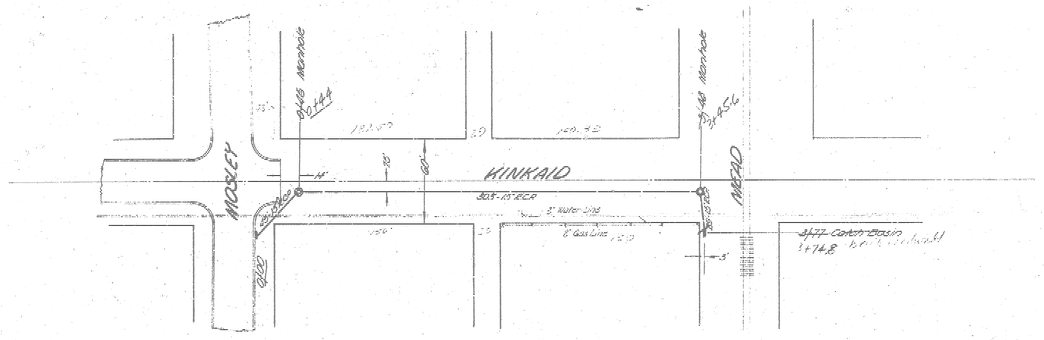

Incidental Drainage
KINKAID
E. L. Mead Ave. to W.L. Mosley
B.E. Smith City Engineer
Date: AUG. 1962, Proj. NO CIE-4

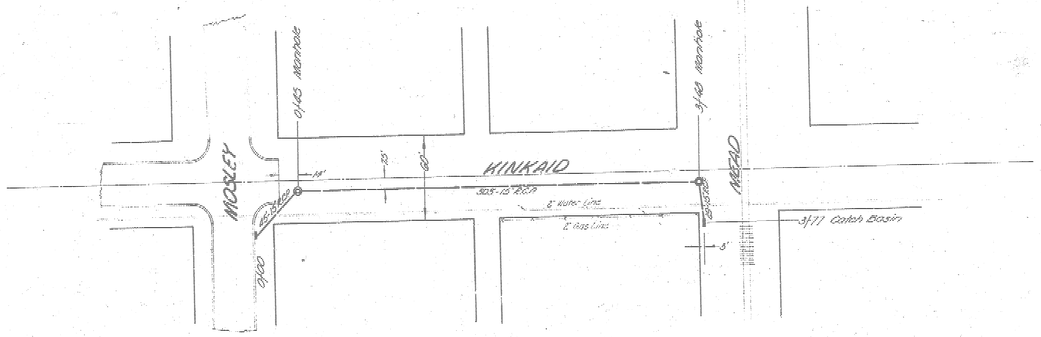

Contractor shall const. std. 2'x3' catch basin over existing 18" R.C.P. at N.E. cor. of Kinkaid and Santa Fe intersection

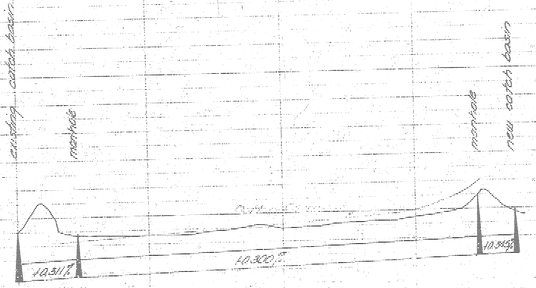

NOTE:
Sand hill ditch entire length of project

Incidental Drainage
KINKAID
L.L. Mead Ave to W.L. Mosley
B.E. Smith City Engineer
Date: Aug. 48, Proj. No. CU2-4