


BK 23

B.M. 101.05 "X" in Kensler, So. end N.W. side Water
NW Corner Kinkaid & Water

1+70 to 1+50
Grod. Wk. from
0.4' to 1.0'

1+30 to 2+50
Wk. 1.0'

2+50 to 3+70
Grod. Wk. from
1.0' to 0.4'

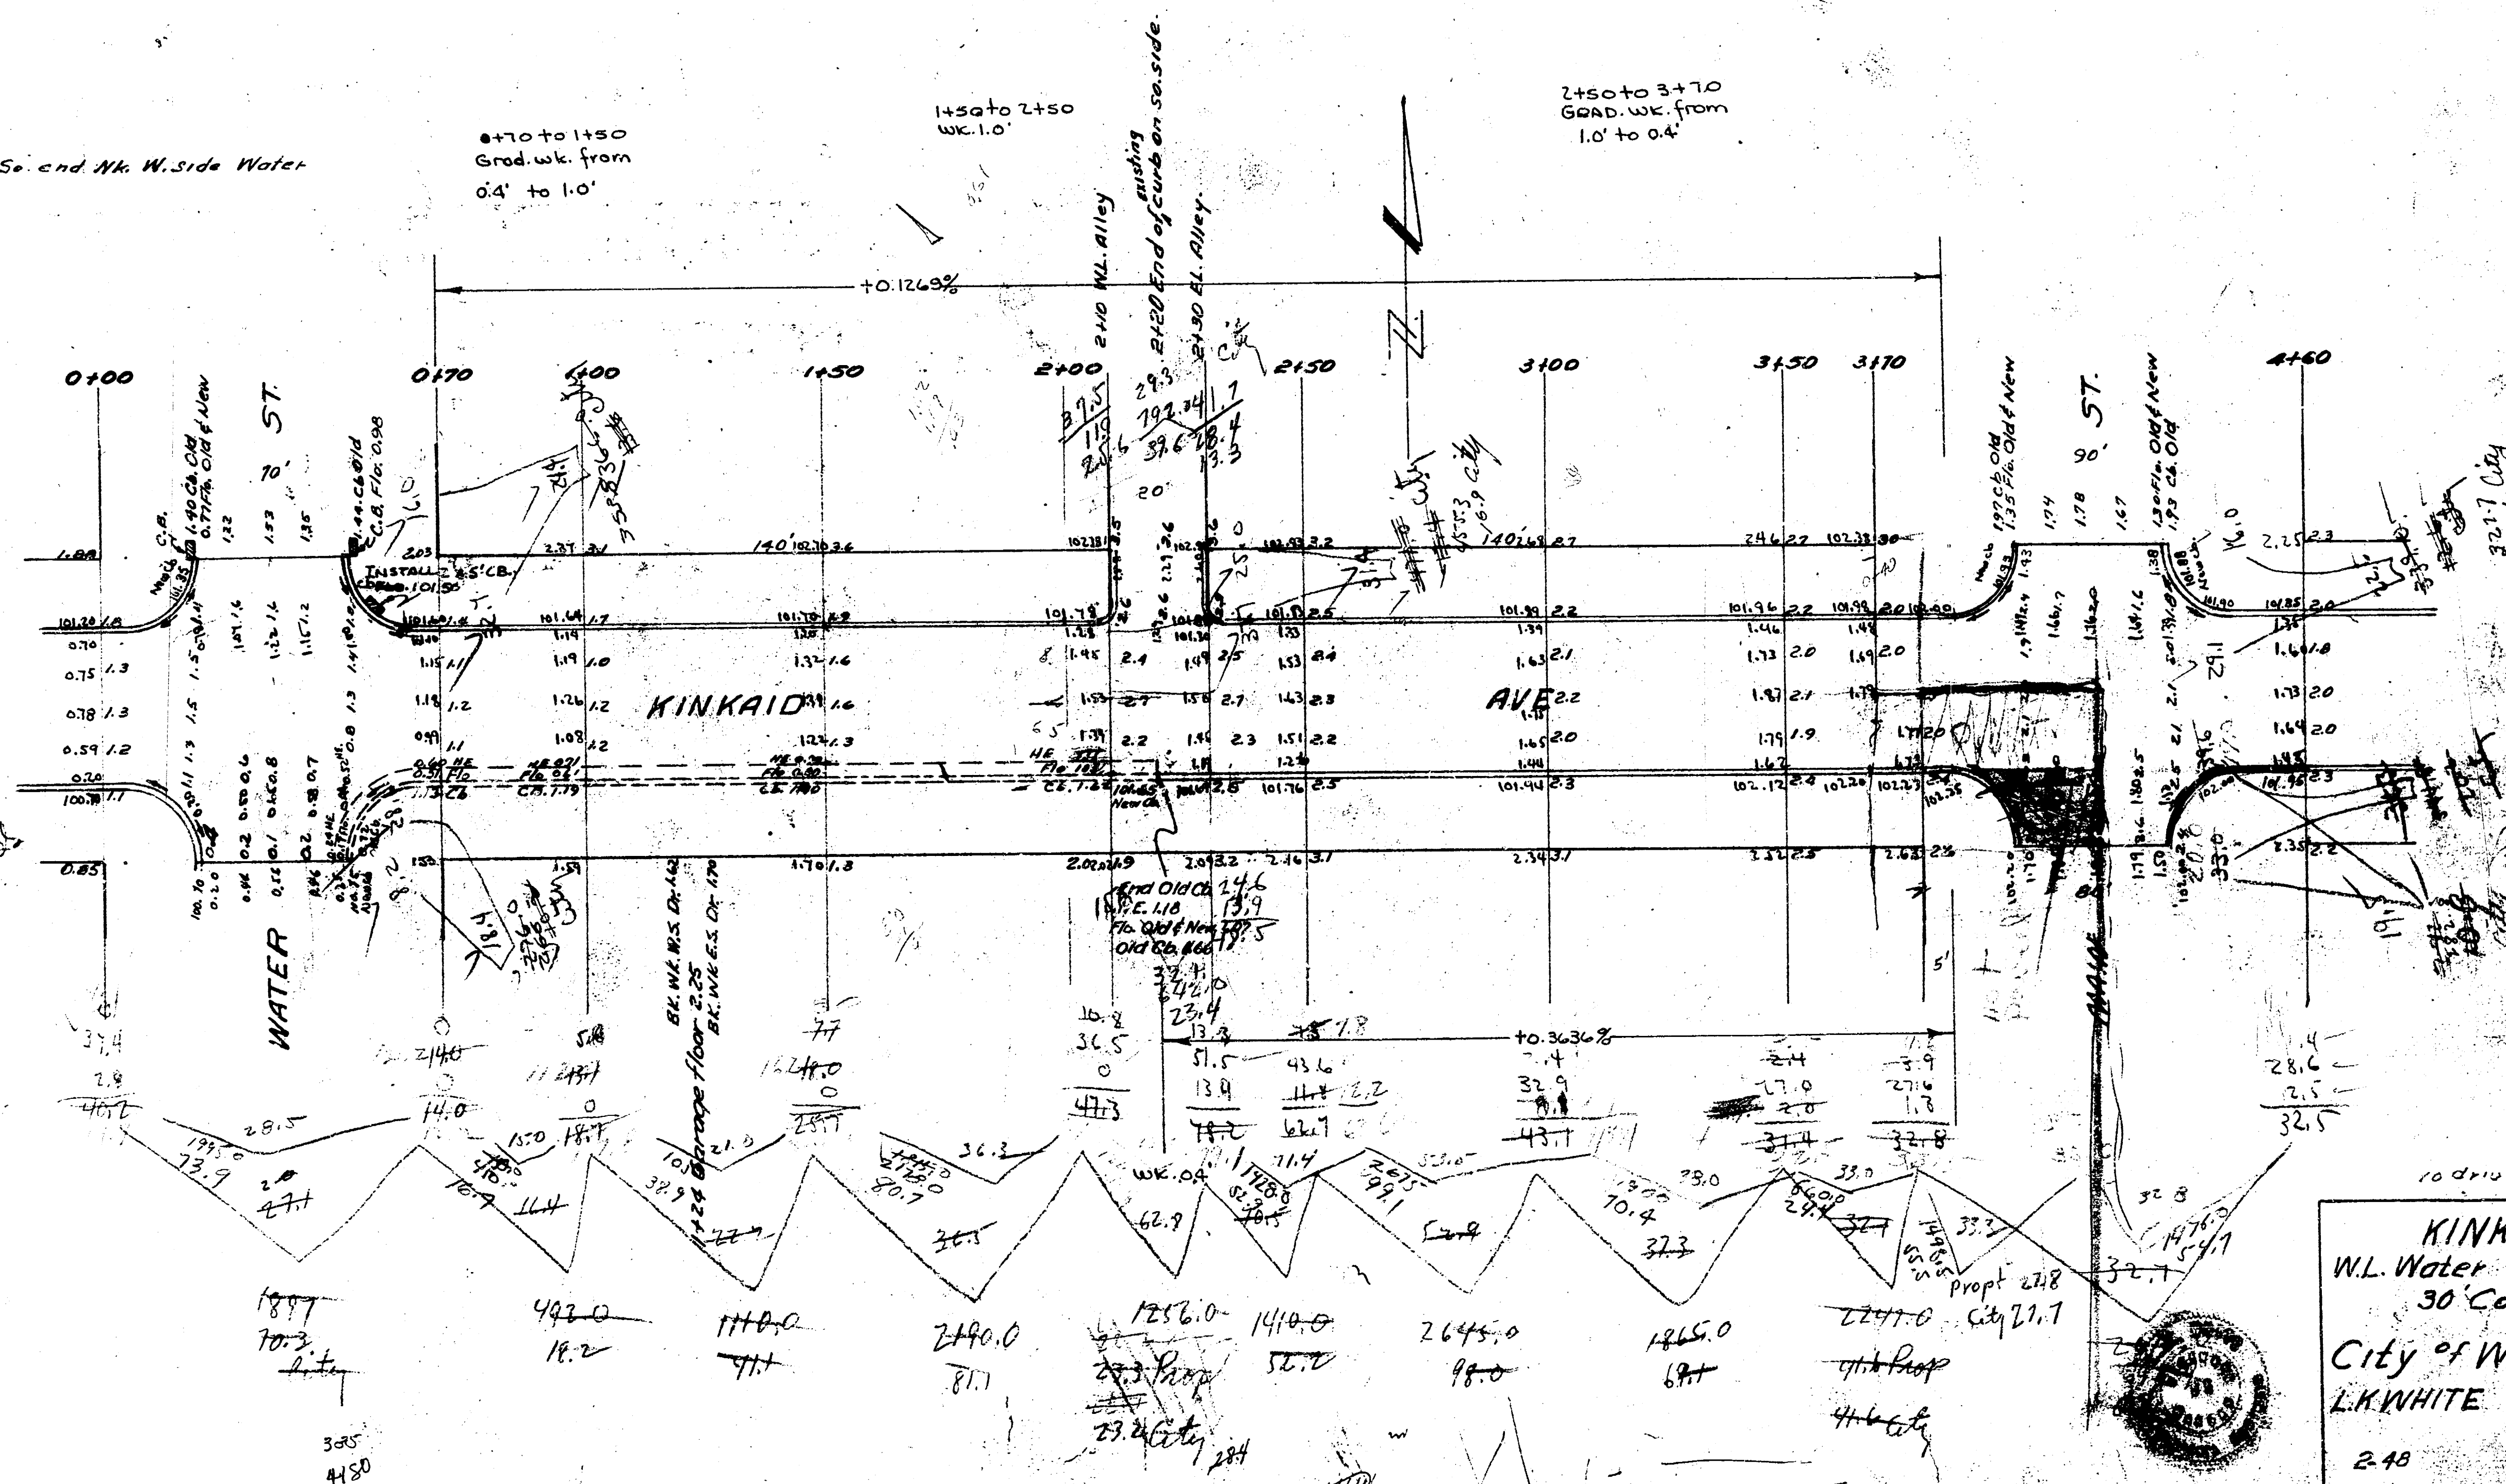


KINKAID AVE
W.L. Water — E.L. Main
30' Conc. & Curb
City of Wichita, Kans.
L.K. WHITE City Engineer
2-40 Proj. C-18-11

BK 23

B.M. 10185 "X" in Mensler So. end W. side Water
NW Corner Kinkaid & Water

Prop.
18.2
41.1
23.3
52.2
98.0
69.1
41.6
424.6
+10% 42.4
Total 467.0 w/46

ct
70.3
10.2
17.4
12.6
20.2
22.7
110% 171.0
Total 194.7 w/46

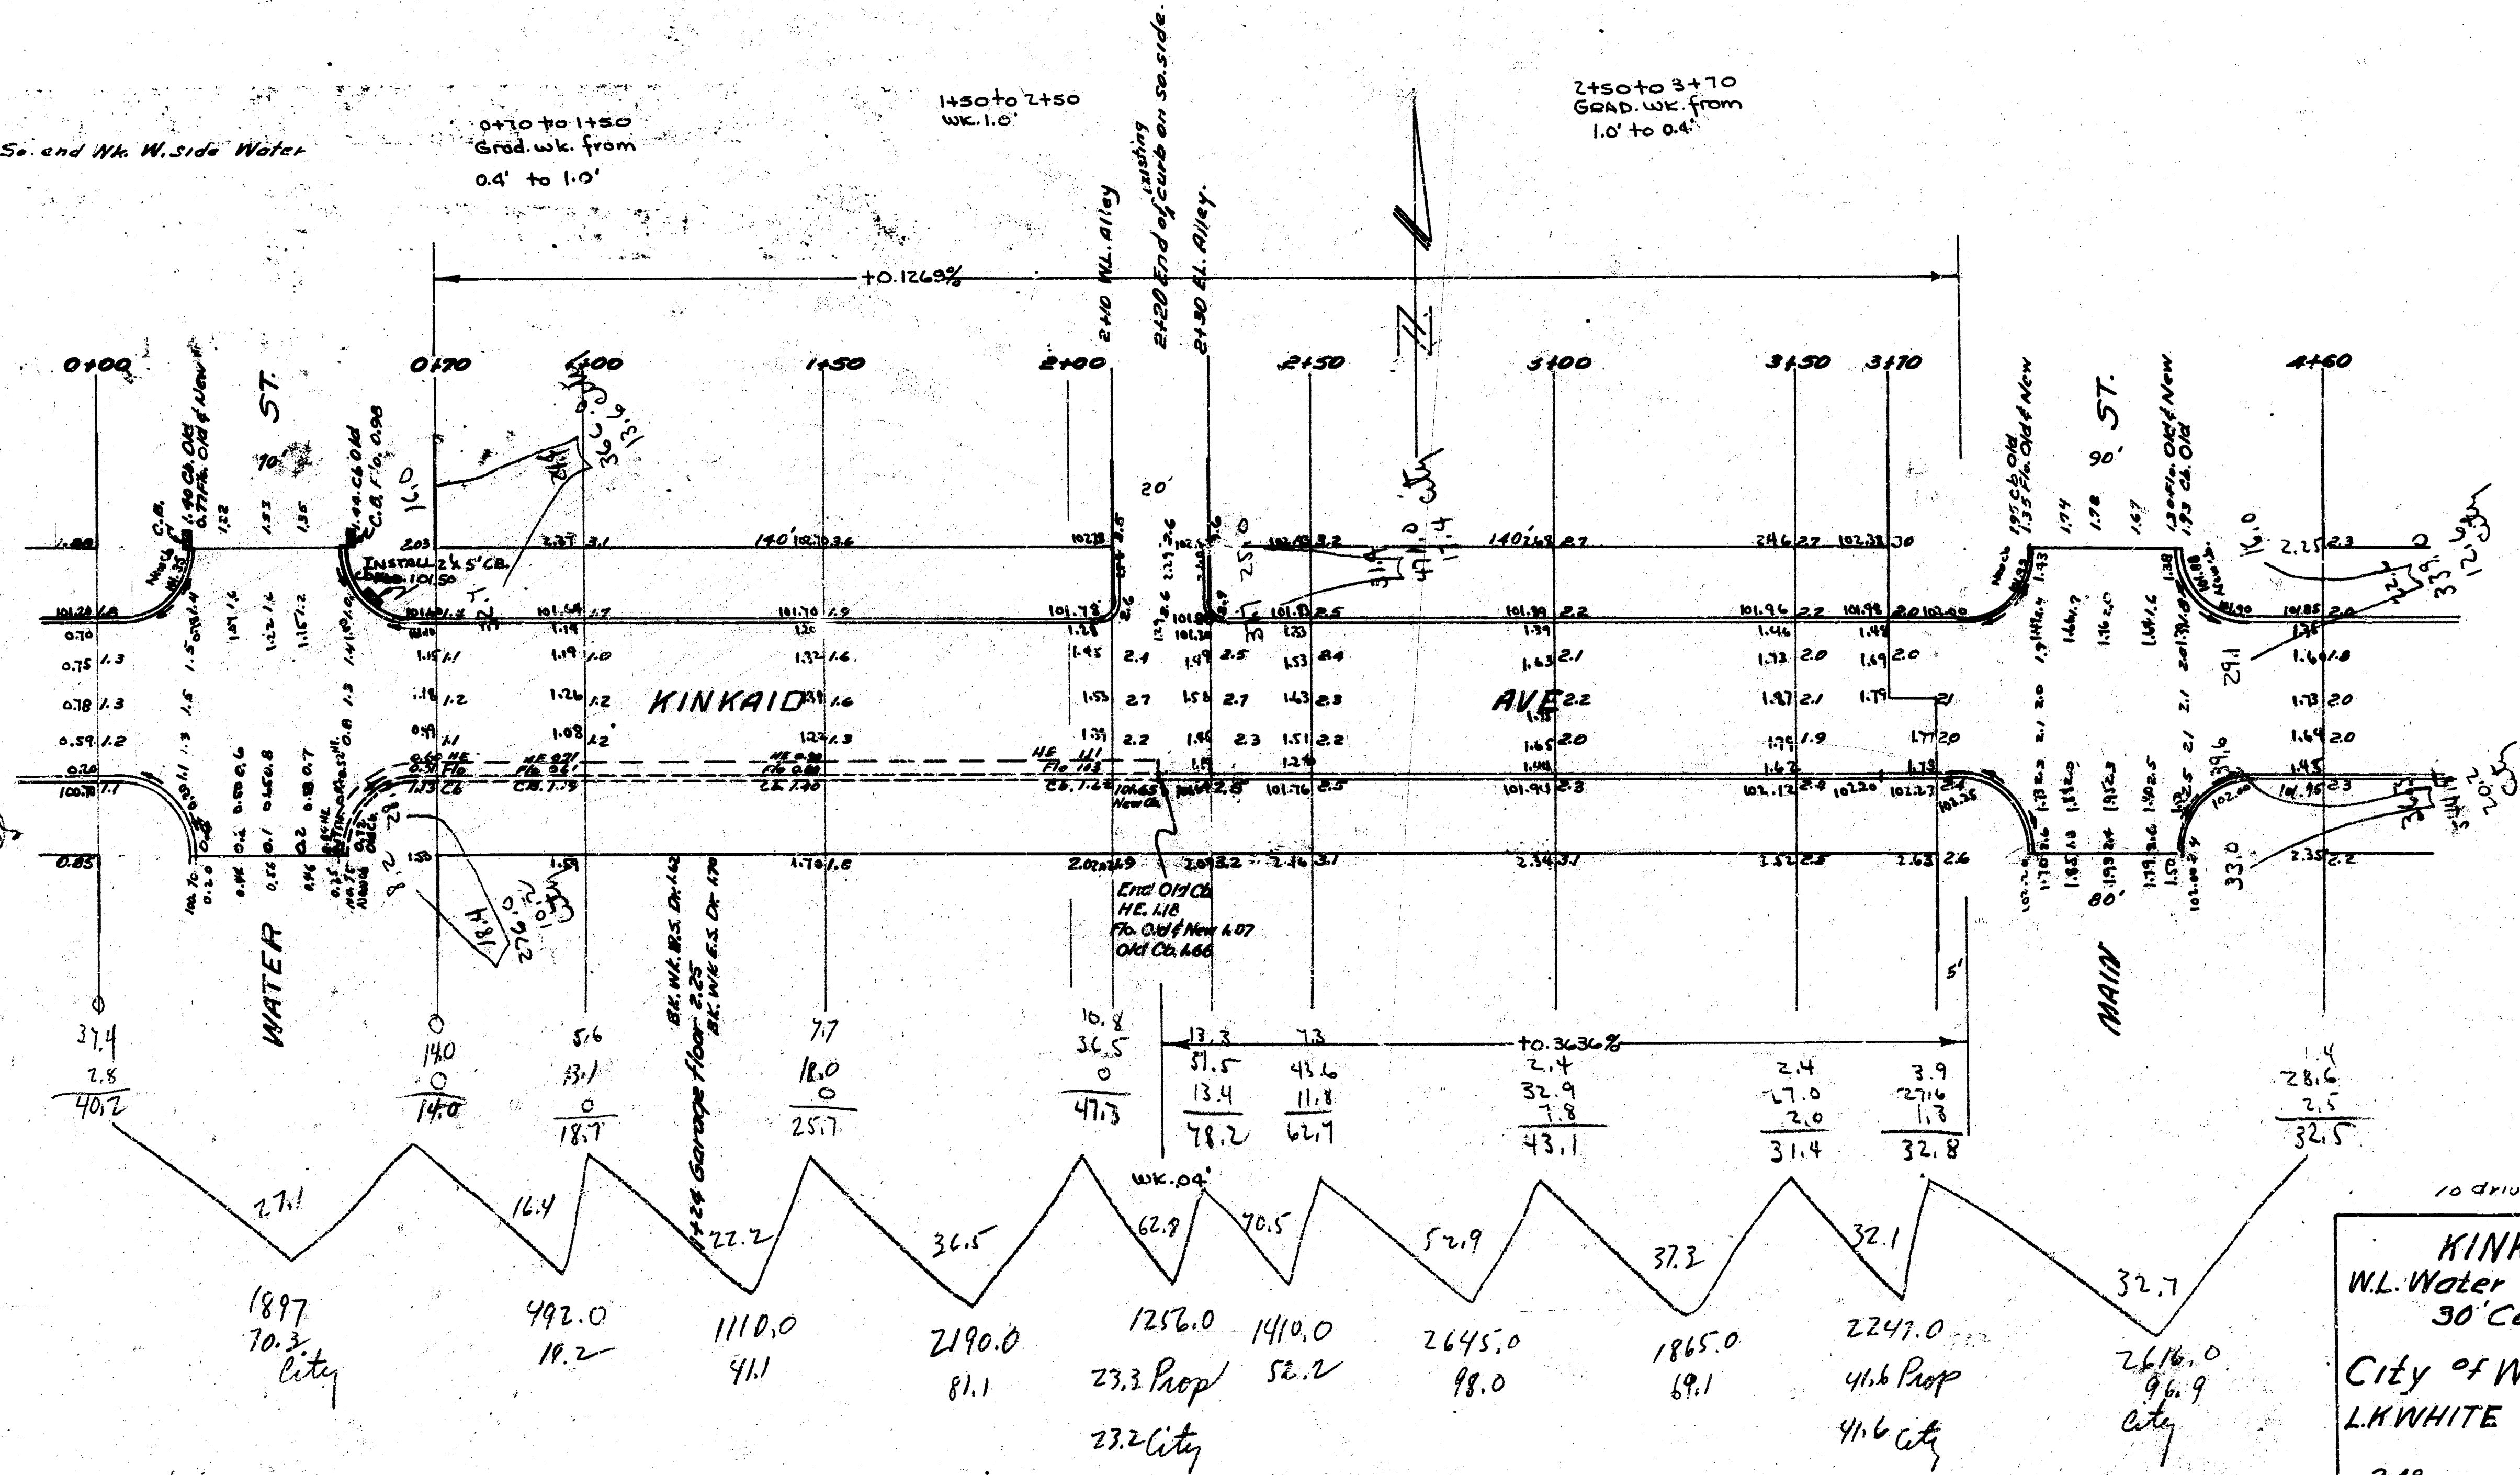

4135