BM 127.74 N.E.Cor. Conc. Step No.# 1631 N Kessler.

N

Scale 1"=20'

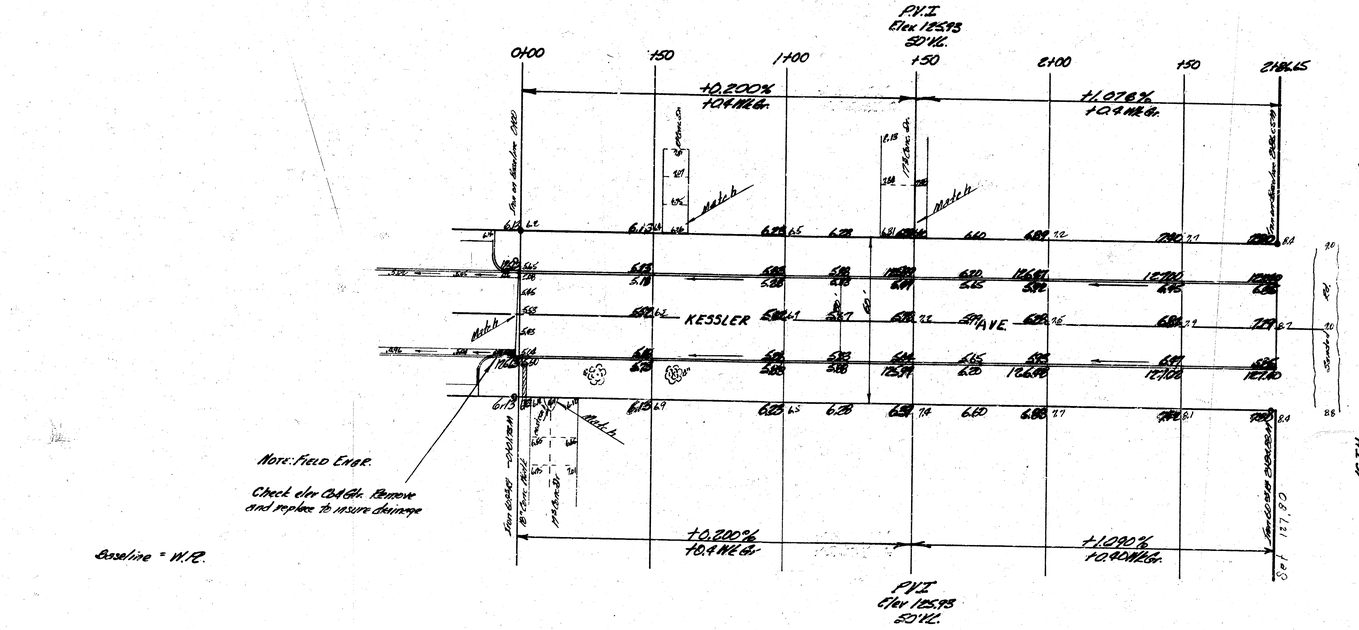

Note: Field Engr.

Check elev CB & Gr. Remove and replace to insure drainage

Baseline = W.R.

Excavation Prop.

699.8 C.Y.
70.0 +10%
769.8 C.Y. Total

KESSLER AVE.
N.L. J.H. JARRETT ADDN. TO
S.L. 16TH. ST.
30' CONC. & C.B.
CITY OF WICHITA, KANSAS
R.E. SMITH CITY ENGINEER
DATE MAY 1966 PROJ. C16-4