



B.M. 19179 N.E. Cor. Conc. Drive by Ho. "1082 Armour"  
 B.M. 17716 "B" in Ritevic Bros. N. of Lawrence Ct. & E. Lawrence Lane.  
 Baseline & Stationing as North Property Line.

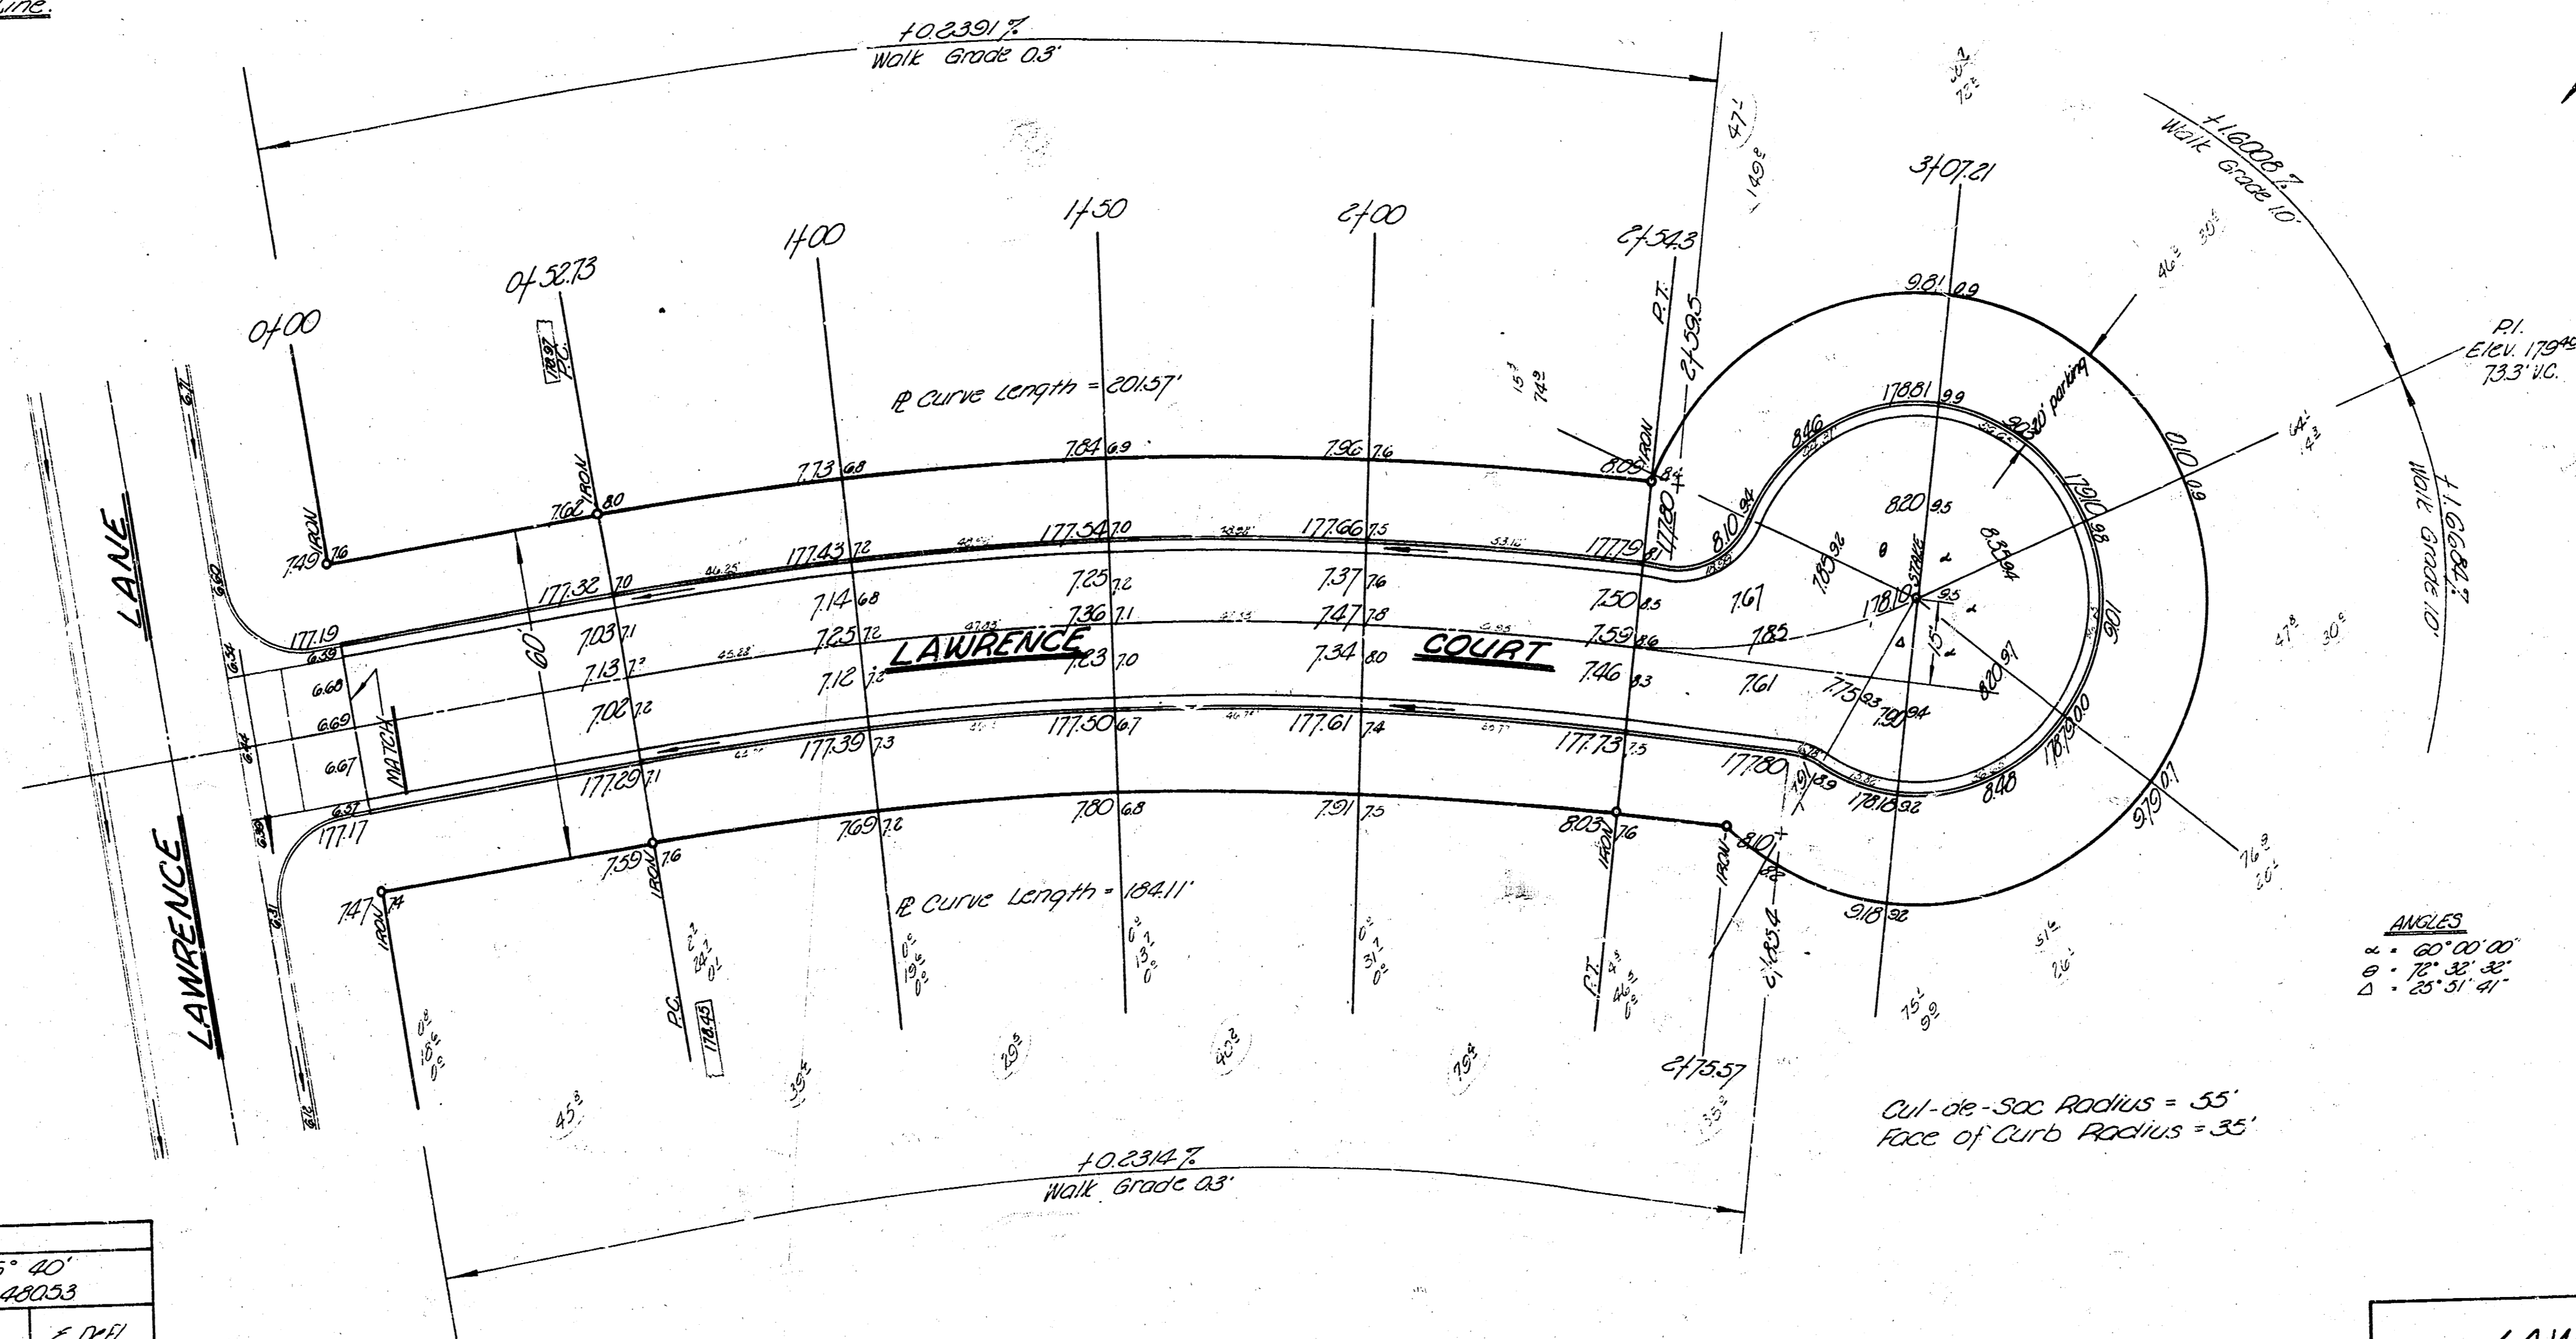

Survey, CIVIL No. 143  
 J. L. HARRIS, S.E.  
 JULY 1932

CURVE DATA					
Radius @ N.P. = 692.83 Δ = 16° 40'					
Length of Curve = 201.57 Min. = 2.42053					
Sta.	Arc	Chords		Defl.	E. Off.
		N.P.	S.P.		
0+32.7	47.27	47.26	46.70	1° 57' 15.3"	1° 57' 15"
1+00	30.00	29.97	29.47	2° 04' 21.6"	2° 01' 17"
1+30	30.00	29.97	29.47	2° 04' 21.6"	2° 01' 17"
2+00	30.00	29.97	29.47	2° 04' 21.6"	2° 01' 17"
2+30	30.00	29.97	29.47	2° 04' 21.6"	2° 01' 17"



EXCAVATION  
 798.2  
 798.2  
 3/16.2 CUL-DE-SAC

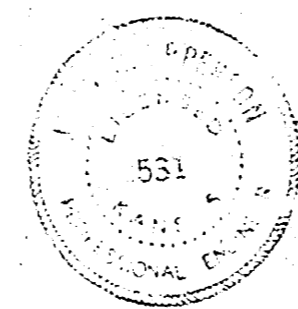

**LAWRENCE COURT**  
 E.L. Lawrence Ln to & incl. Cul-de-Sac  
 36' - 2' - 30' A.C.  
 City of Wichita, Kansas  
 B.E. Smith City Engineer  
 Date: JULY 1932, Proj. No. C19-143

FILE


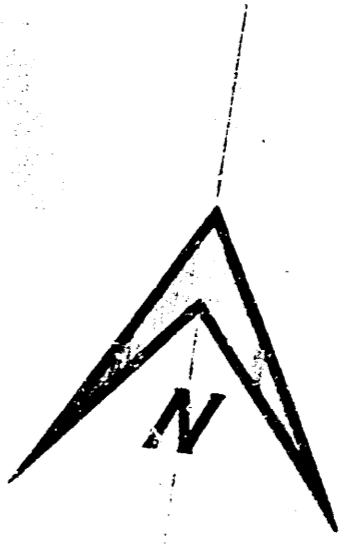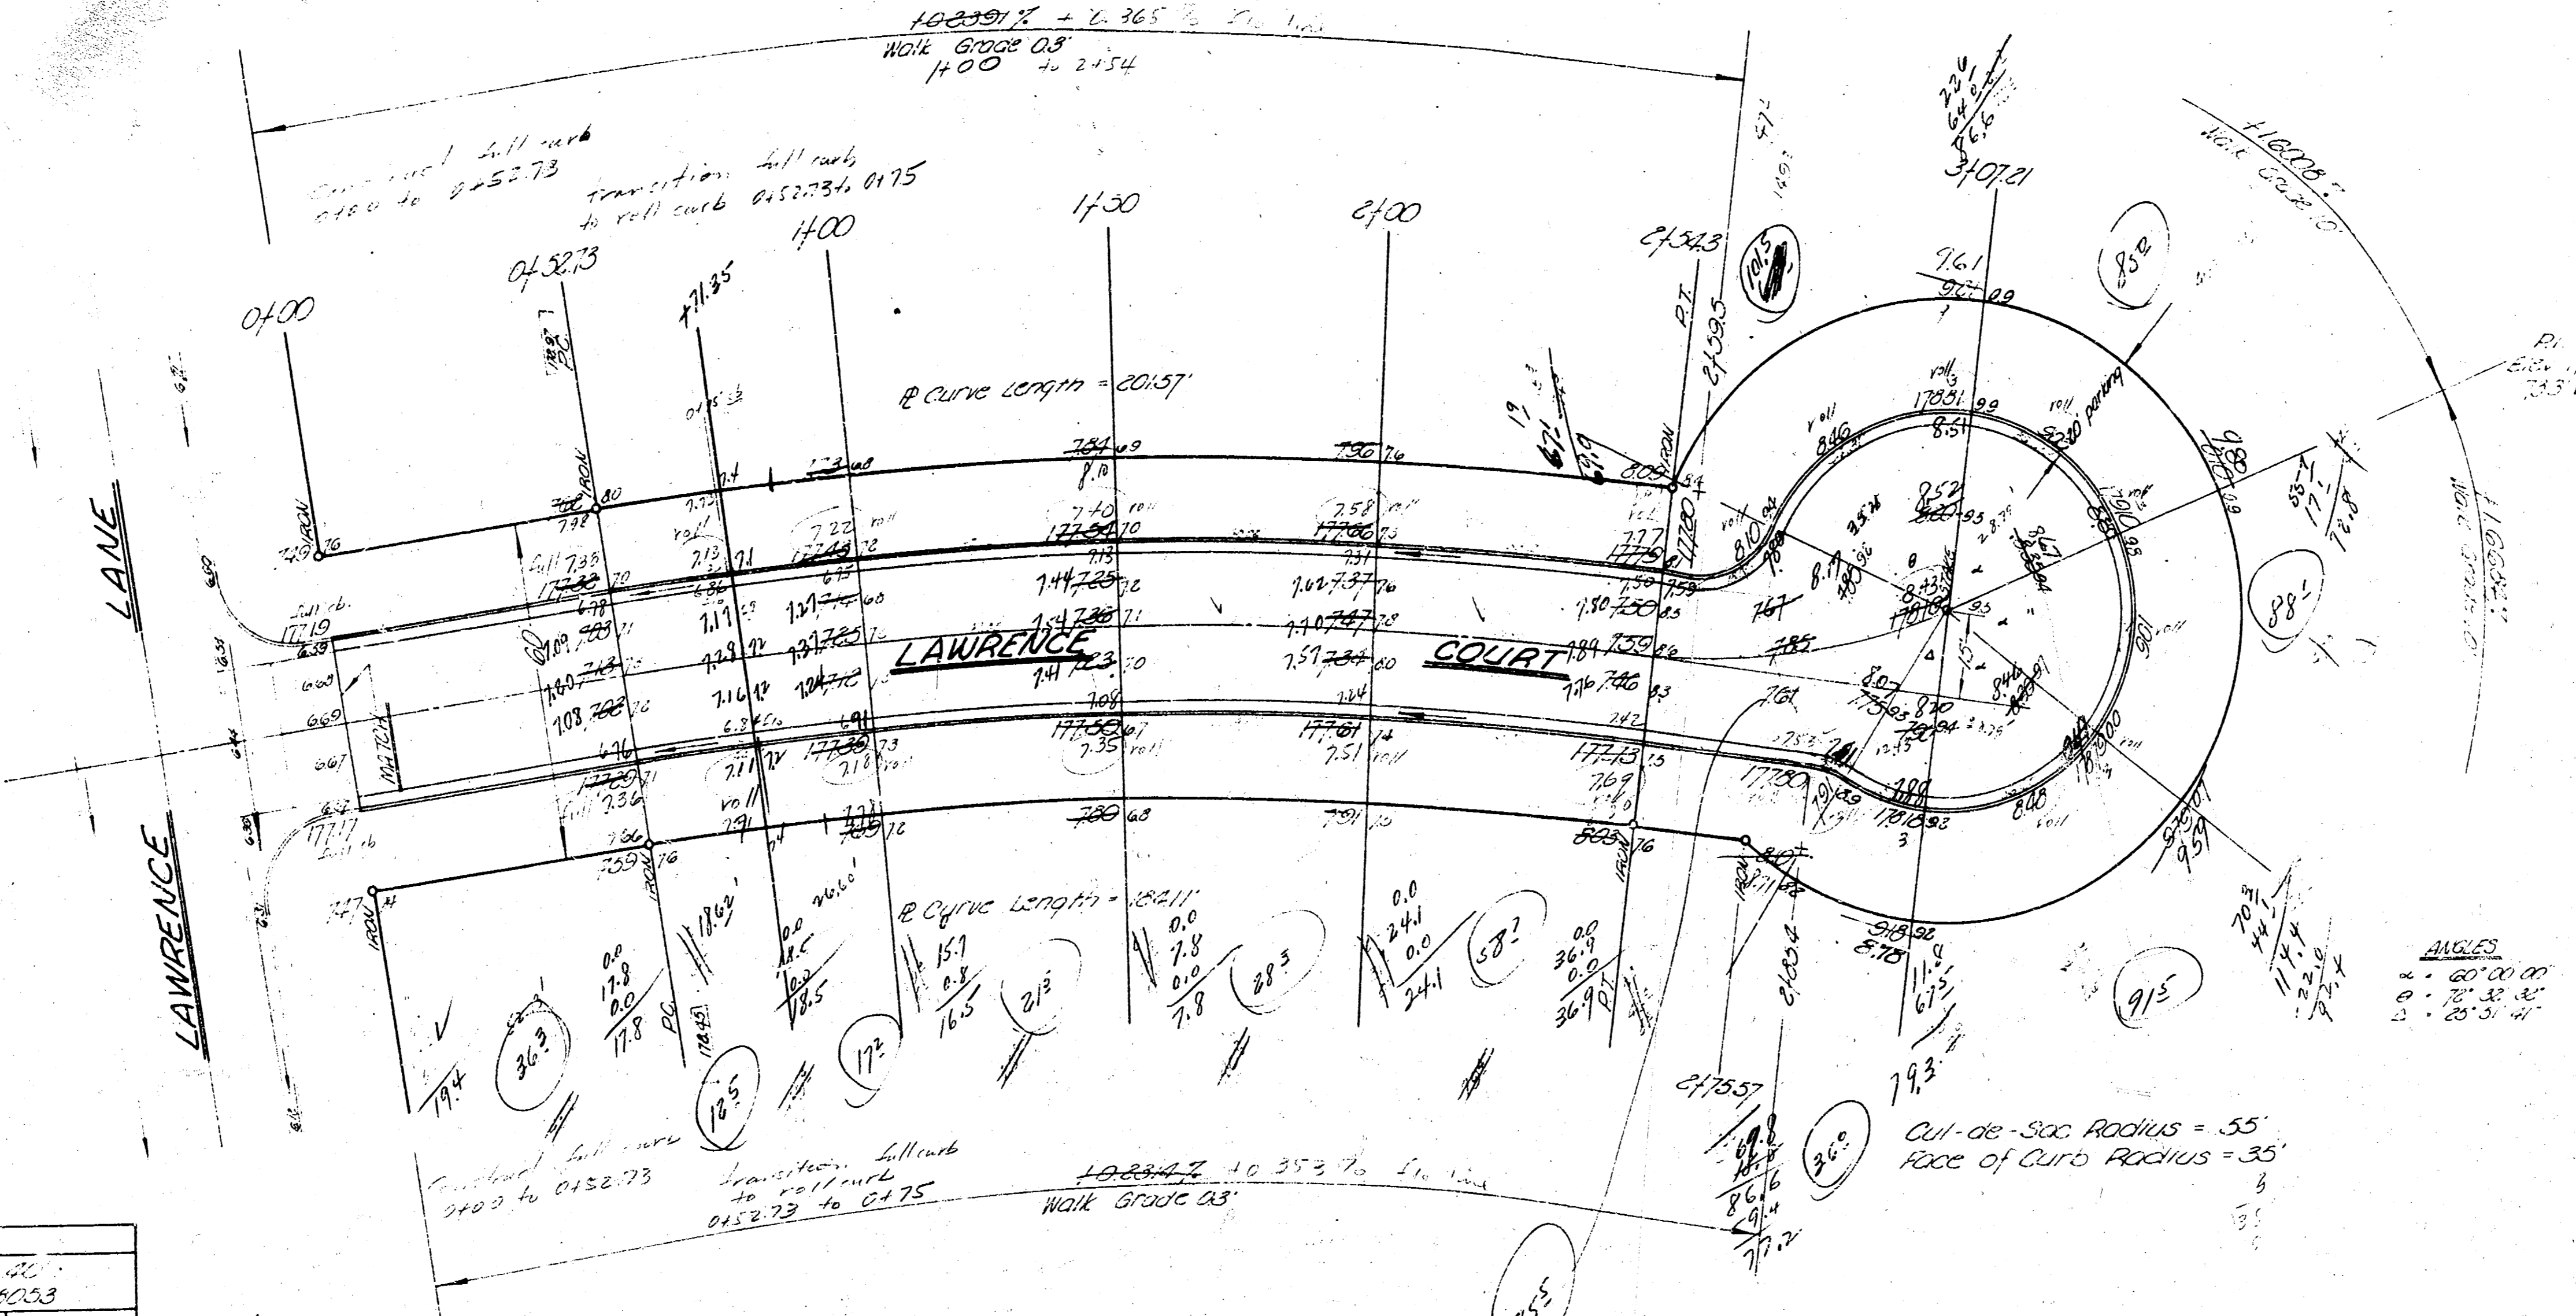

CURB 11.00

CURVE DATA




EXCAVATION  
 7.50'  
 8.70' @ 10'



LAWRENCE COURT  
 26' - 2' - 30' AC.  
 City of Wichita, Kansas  
 B.E. Smith, Engineer  


ANGLES  
 1. 60° 00' 00"  

Out-of-Soc. Radius = 55'  
 Race of Curve Radius = 35'

11/17/12  
 11/17/12