B.M. 181.74 N.E. Cor. Conc. Drive bk. Ho. #1082 Armour.
B.M. 177.18 "B" in Ritchie Bros., N. Cb. Lawrence Ct. & E.L. Lawrence Lane.
Baseline & Stationing on North Property Line.

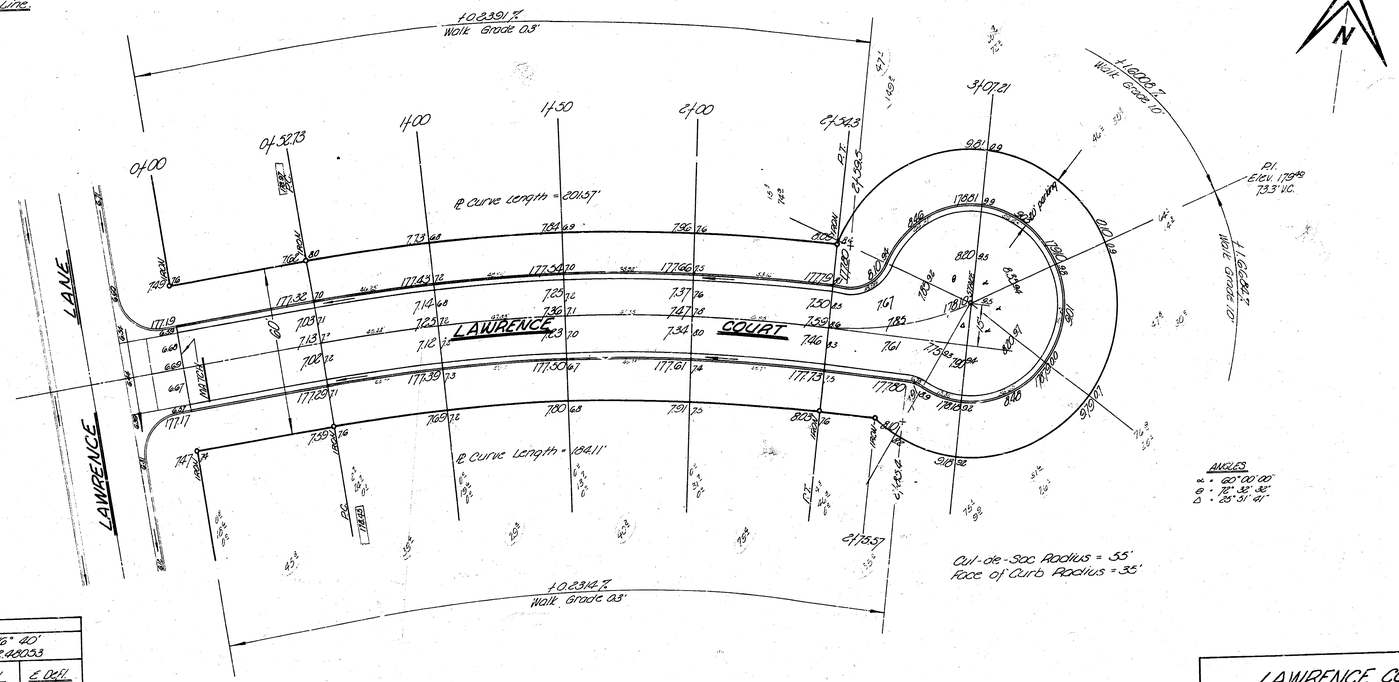

CURVE DATA						
Radius @ N. ℄ = 692.83				Δ = 16° 40'		
Length of Curve = 201.57				Min. = 2.48053		
Sta.	Arc.	Chord N. ℄	Chord 8" off N. cb.	Chord 8" off S. cb.	Defl.	E. Defl.
0+52.7						
1+00	47.27	47.26	46.70	43.64	1° 57' 15.3"	1° 57' 15"
1+50	50.00	49.97	49.47	46.15	2° 04' 01.6"	4° 01' 17"
2+00	50.00	49.97	49.47	46.15	2° 04' 01.6"	6° 05' 18"
2+54.3	54.30	54.28	53.73	50.13	2° 14' 41.6"	8° 20' 00"

LAWRENCE COURT

E.L. Lawrence Ln. to & incl. Cul-de-Sac

26' - 2' - 30' A.C.

City of Wichita, Kansas

B.E. Smith City Engineer

Date: July 1982, Proj. No. C19-143

File

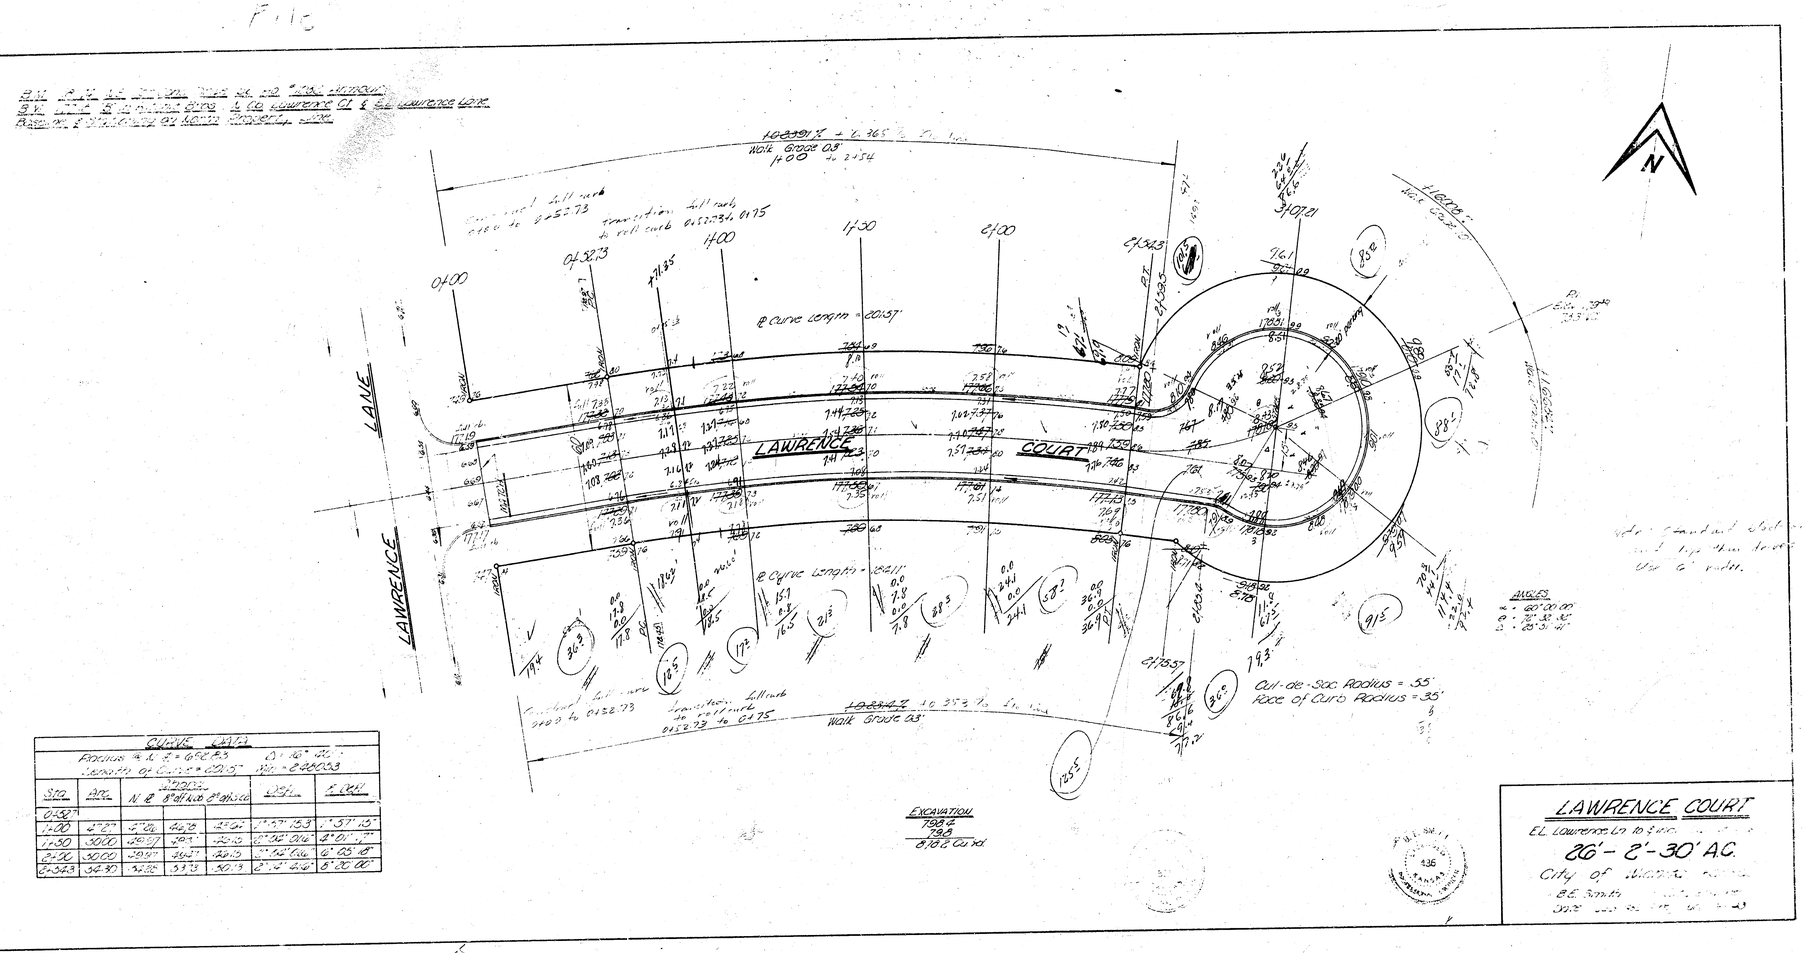

CURVE DATA						
Radius @ N ℄ = 692.83 Δ = 16° 40'						
Length of Curve = 201.57 Min = 248.053						
Sta.	Arc	Chord N ℄	Chord 8" off N.Cb	Chord 8" off S.Cb	Deft.	E. Deft.
0+52.7						
1+00	47.27	47.26	46.78	43.64	1°57' 15.3"	1°57' 15"
1+50	50.00	49.97	49.3	46.15	2°54' 01.6"	4°01' 17"
2+00	50.00	49.97	49.47	46.15	2°54' 01.6"	6°05' 18"
2+54.3	54.30	54.28	53.73	50.13	2°14' 41.6"	8°20' 00"