


BM 135* = Top E-End Conc Culvert W. Side Drainage Ditch, W Side
Lawrence Cr. approx. 1000' N. of 134th N.
BM 204* = Top E. Ch. Gouverneur on E. Aberdeen.

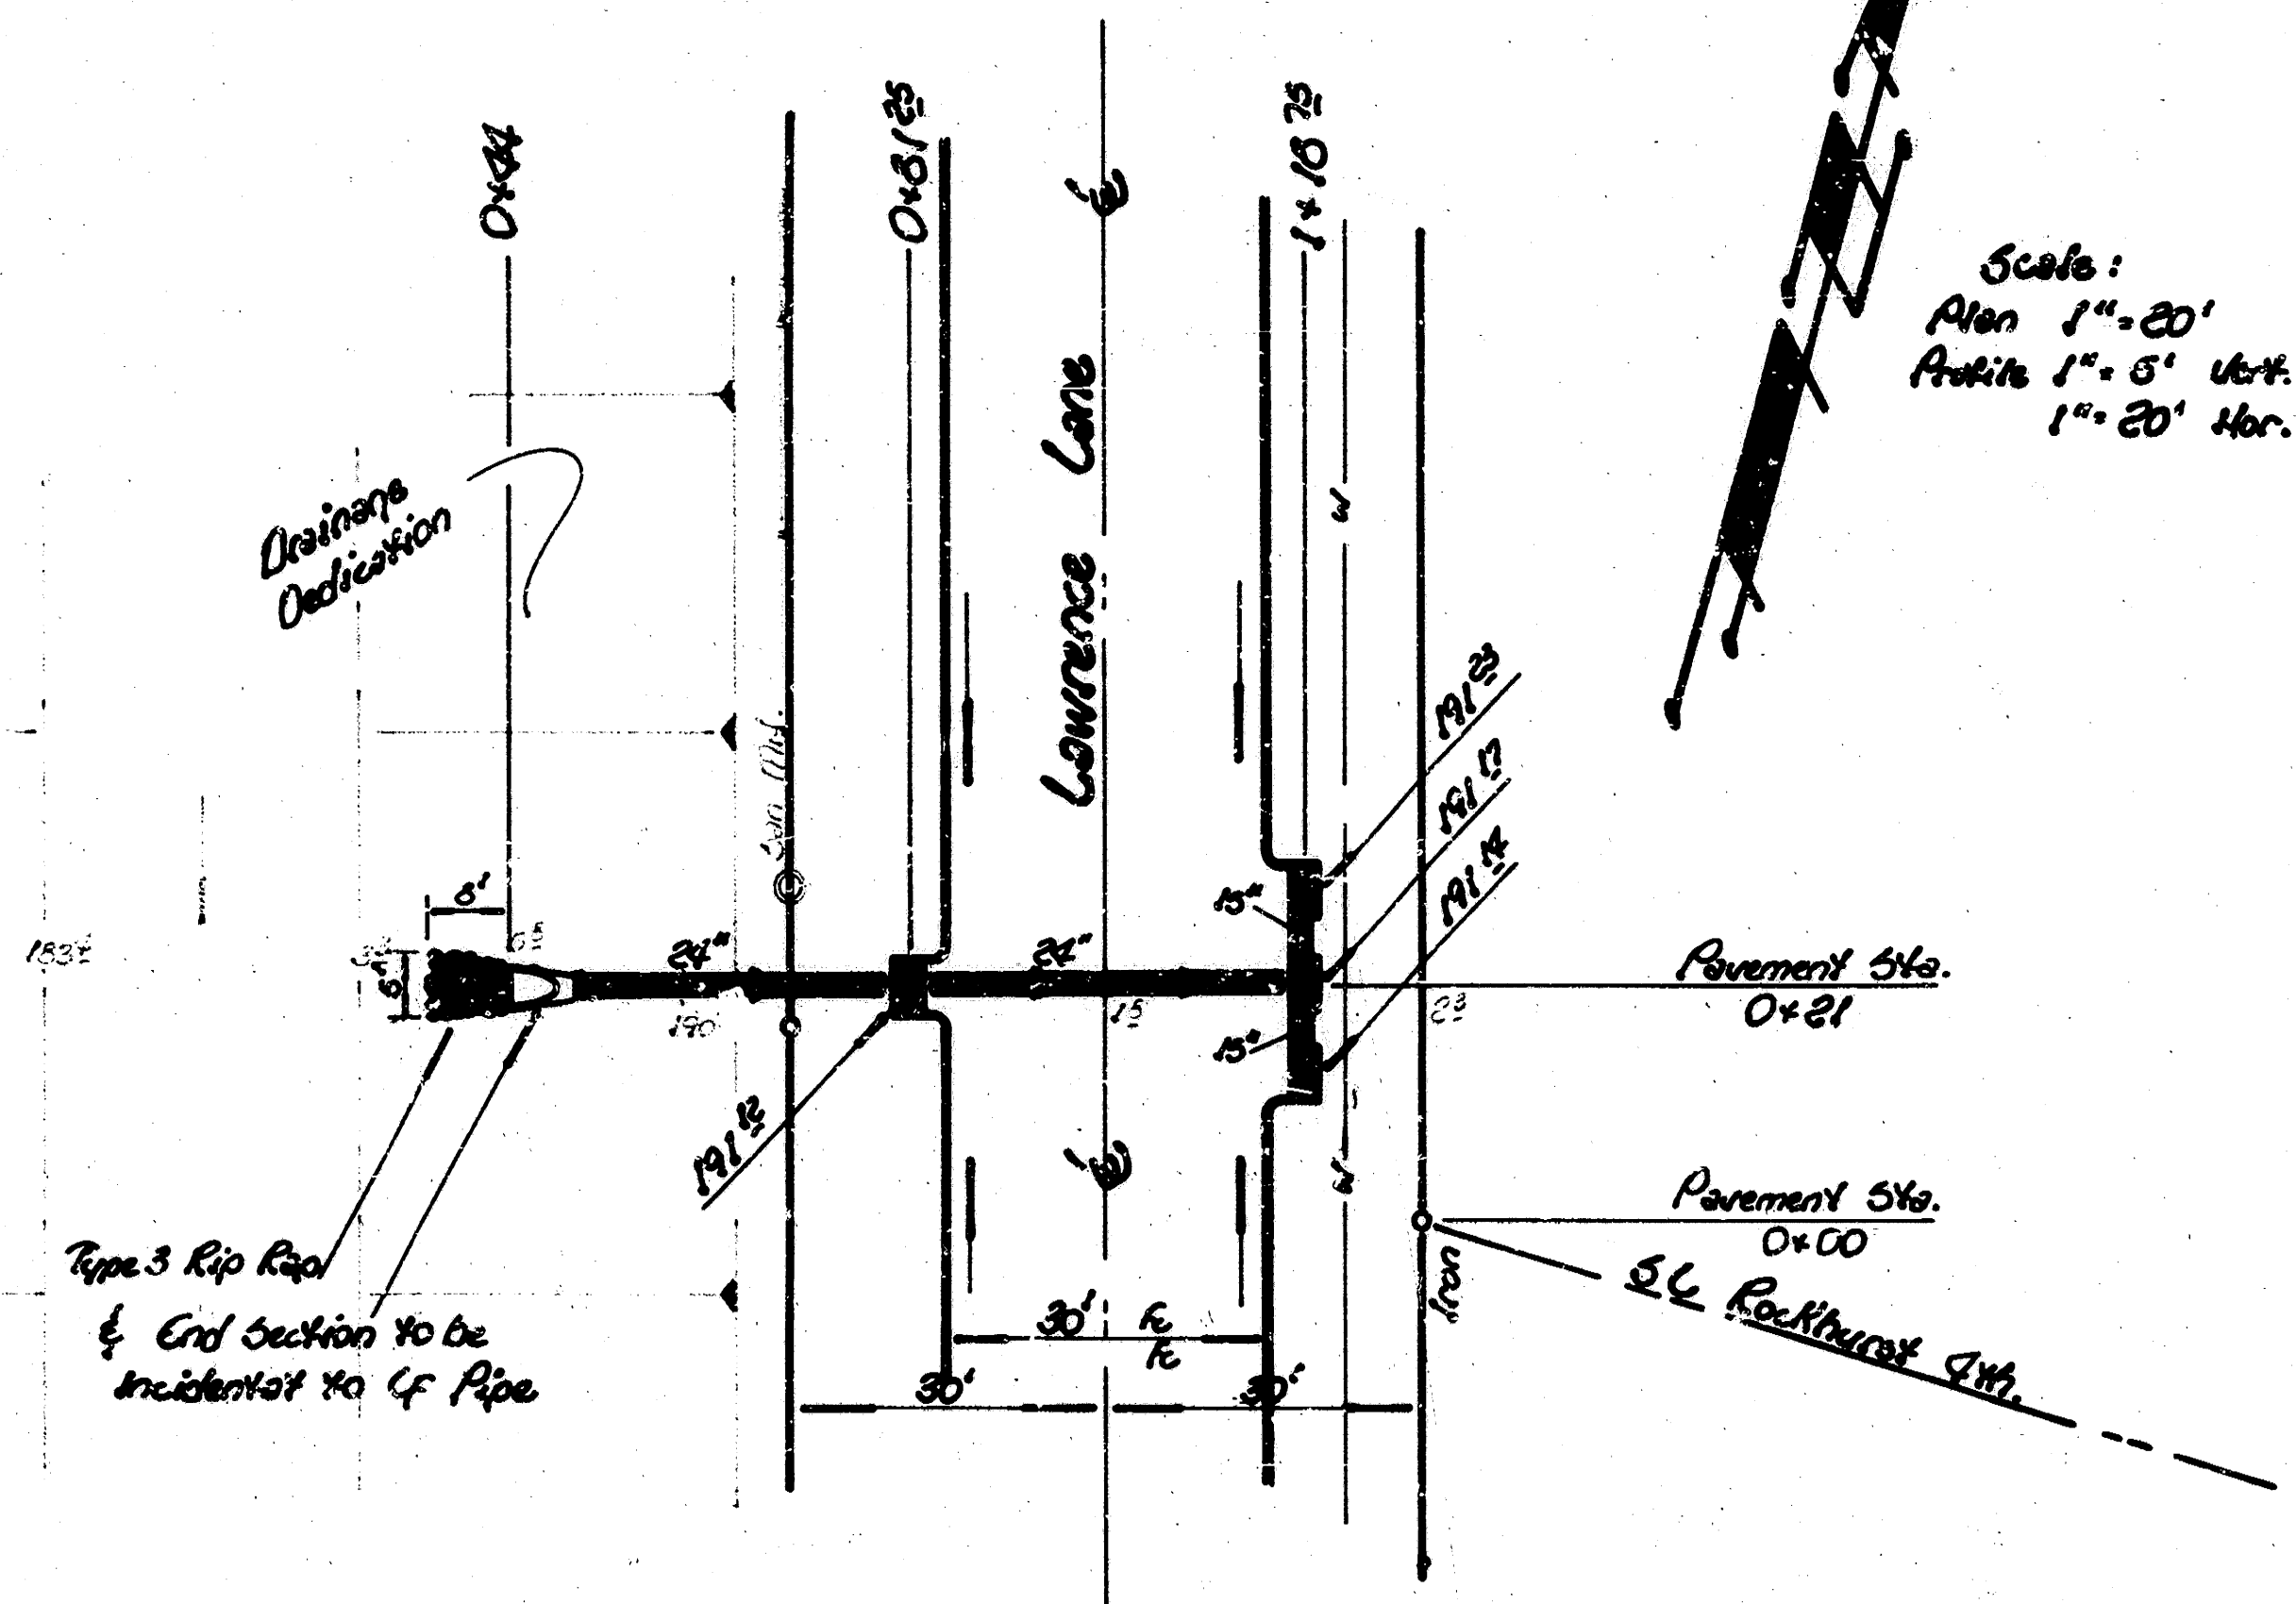


Note -

Type 1-A Inlets (14 x 3' 10") to be constructed.
Storm Sewer Contractor to co-ordinate construction w.
pavement contractor.
Rip Rap & End Section shall be considered as incidental
to C.F. pipe.

TYPE 3 RIP-RAP SHALL BE 12" RIP-RAP ON 6" SAND AND GRAVEL BEDDING. THE ROCK FOR RIP-RAP AND GRAVEL SHALL BE HARD, DENSE, DURABLE, AND SHOULD BE REASONABLY WELL GRADED. THE SIZE RANGE OF ROCK USED FOR 12 INCH RIP-RAP SHALL HAVE A MAXIMUM SIZE OF 1 CUBIC FT. AND A MINIMUM SIZE OF 1 1/4 INCHES. THE 6" SAND AND GRAVEL BEDDING FOR RIP-RAP SHOULD BE A CONTINUOUS LAYER OF SAND OR GRAVEL AND CRUSHED ROCK, REASONABLY WELL GRADED TO A MAXIMUM OF 1 1/4 INCHES IN SIZE.


Plan - Kubota
Survey - Group
Bk. - Oct 217

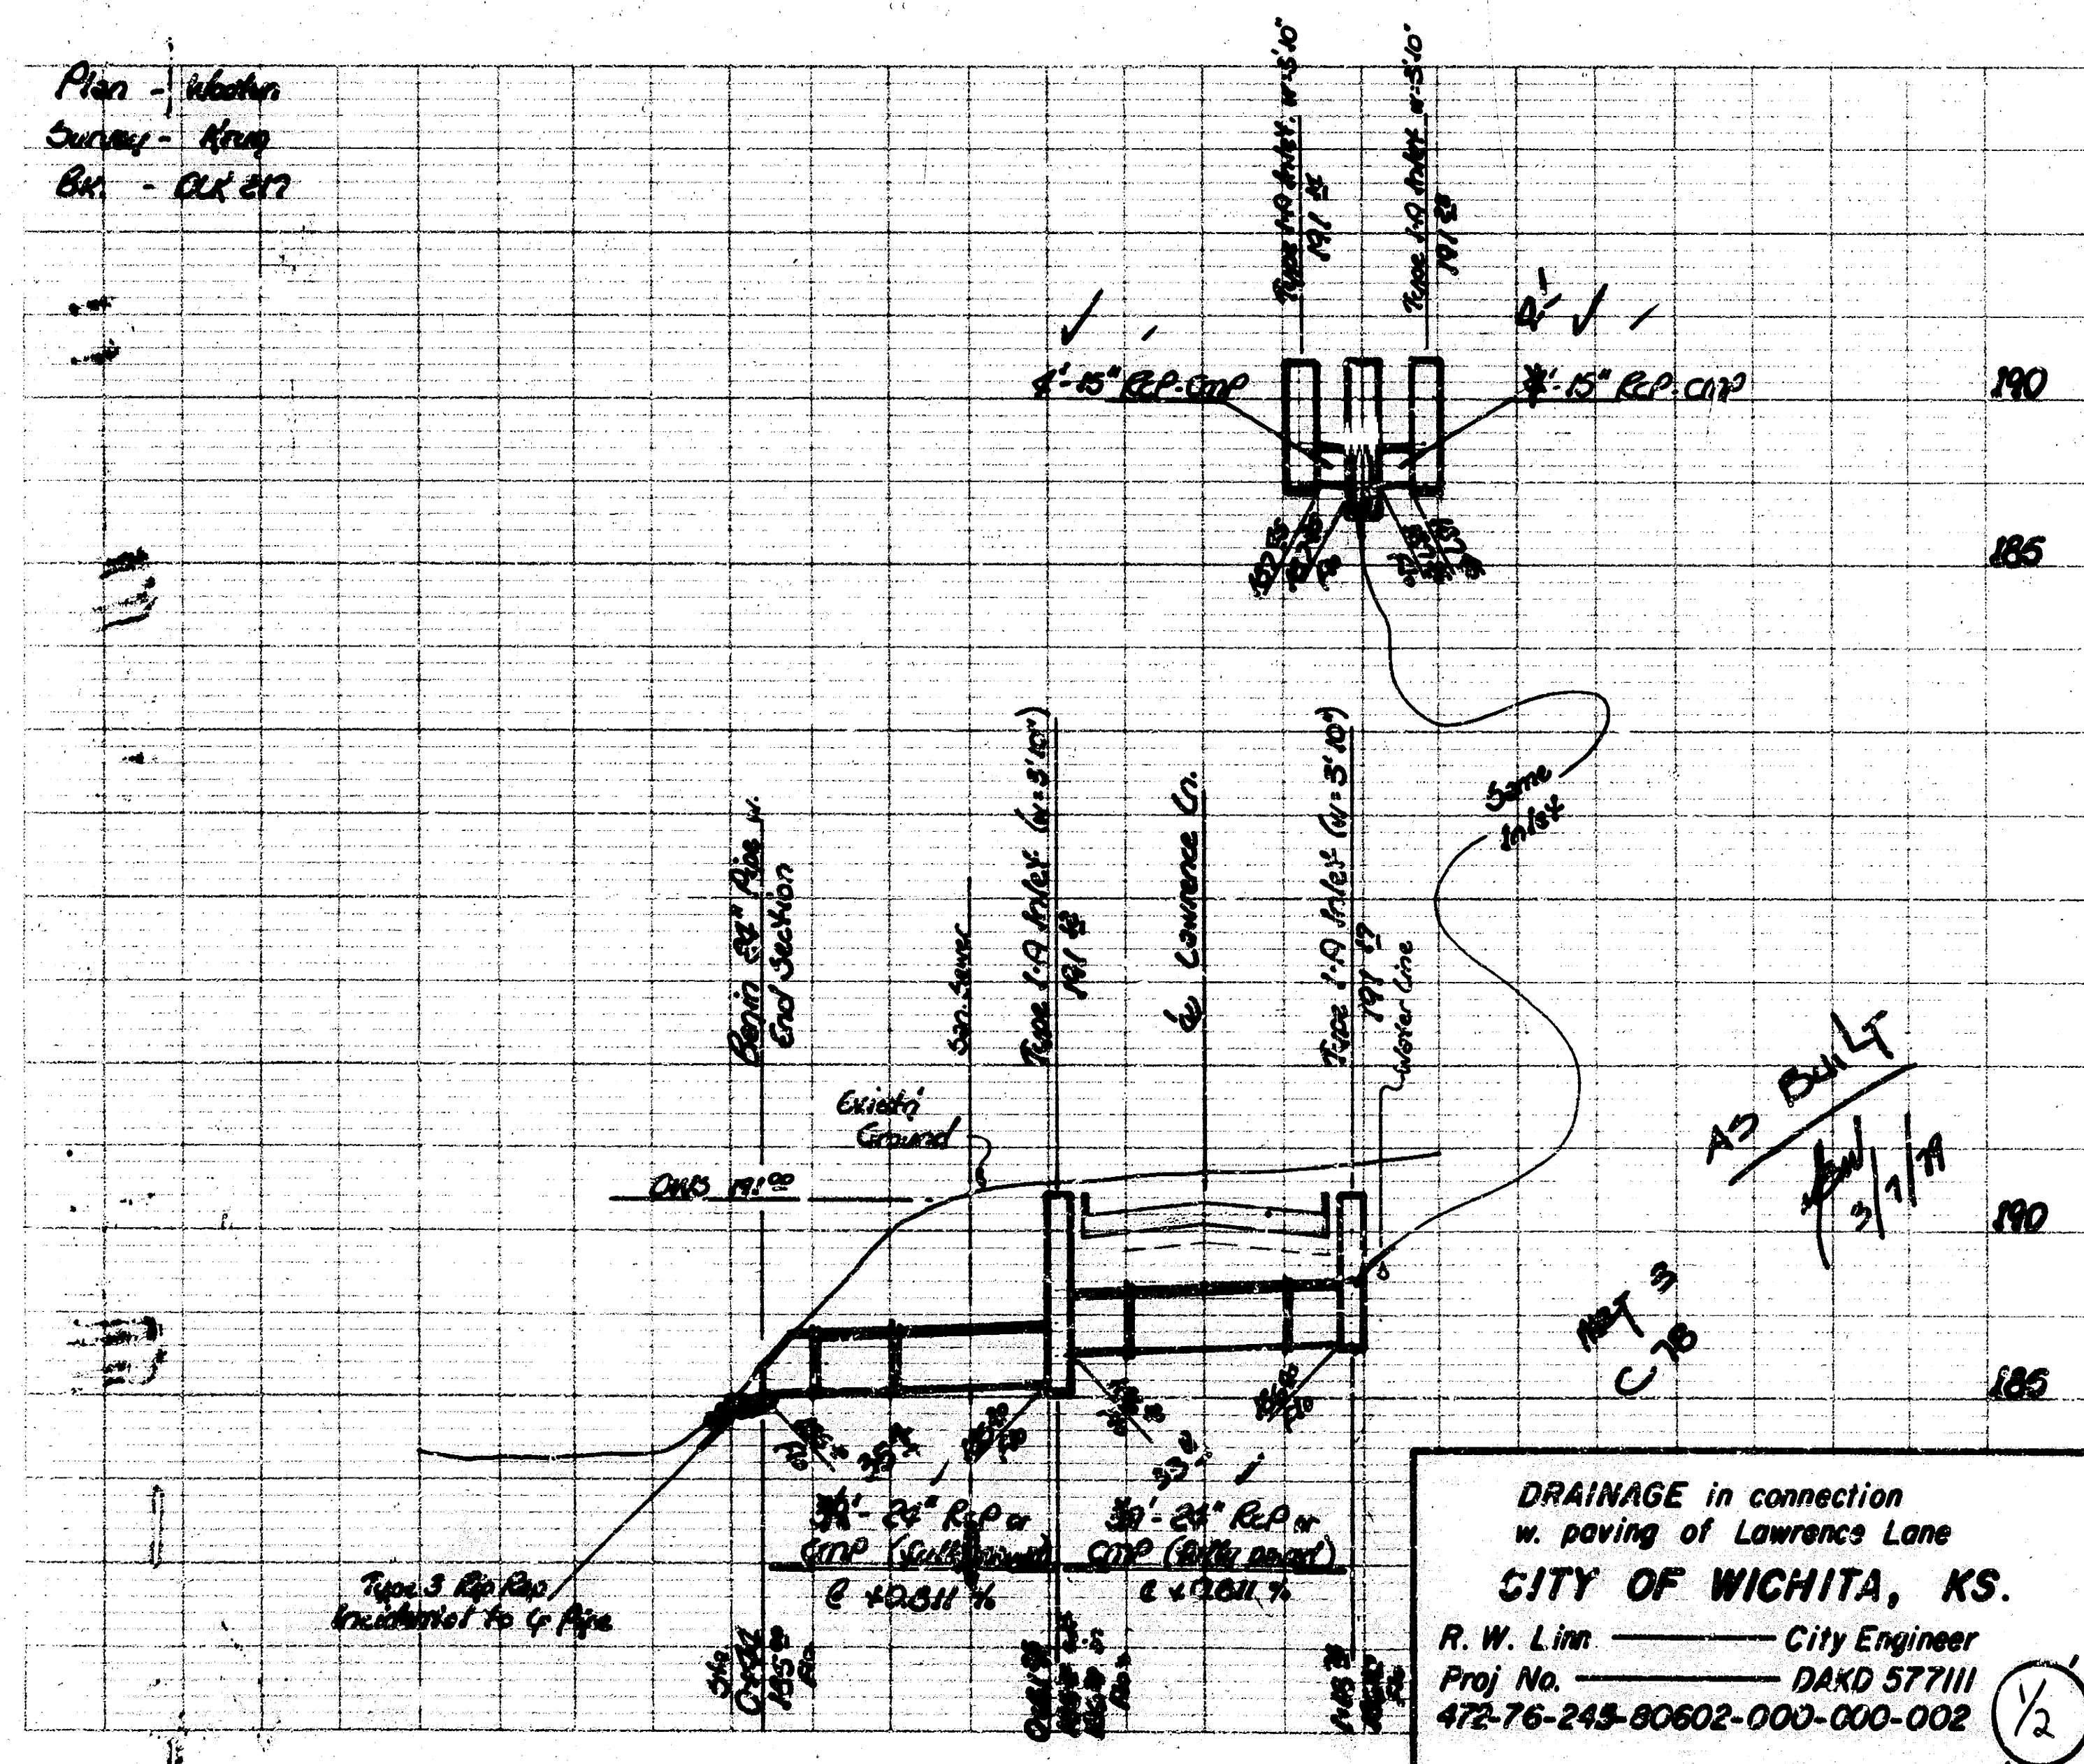

DRAINAGE in connection
w. paving of Lawrence Lane
CITY OF WICHITA, KS
R. W. Linn. _____ City Engineer
Proj No. _____ DAKD 577III
472-76-245-80602-000-000-002



* NOTE: 3 BARS TO BE PLACED APPROX. 2" BELOW TOP OF INLET COVER.

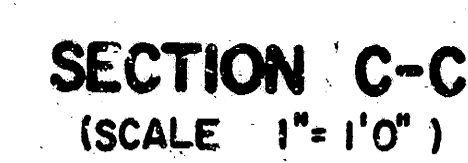


Technical drawing showing a cross-section of a curb and gutter assembly. The drawing includes the following dimensions and labels:

- Top Dimensions:**
 - W-8" (Total width)
 - 1' 8" (Distance from curb face to gutter edge)
 - 1' 7" MIN. (Minimum curb width)
 - VARIES (Variable curb width)
 - $\left(\frac{W-8"}{2}\right)$ (Curb width from centerline)
- Vertical Dimensions:**
 - 7 1/2" (Curb height)
 - 6" (Gutter depth)
 - 6" (Concrete base thickness)
 - EL. (Elevation line)
- Materials and Components:**
 - 2 1/2" R (Radius of curb top)
 - STD. CURB (Standard curb)
 - OPTIONAL JOINT (Line indicating optional joint location)
 - 6 SACK CONCRETE (Material for curb and gutter base)
 - BACK OF STD. CURB (Line indicating back of curb)
 - CB. & GTR. BY PAVING CONTRACTOR (UNLESS OTHERWISE NOTED) (Label for the gutter and curb area)
- Bottom Dimensions:**
 - 8" (Distance from curb face to gutter edge)
 - W-1' 4" (Total width of concrete base)
 - 8" (Distance from curb face to gutter edge)
 - W (Total width of concrete base)


SECTION A-A
(SCALE 1" = 1' 0")

GROSS VOLUME

NOTE: CONCRETE TOPS TO BE INSTALLED ON THIN MORTAR CUSHION TO INSURE FULL SUPPORT ALONG BRICK WALLS. CONCRETE TOPS MAY BE CAST IN PLACE OR PRECAST. CONCRETE FOR INLET TOPS AND FLOORS SHALL BE 6-SACK PAVING MIX.

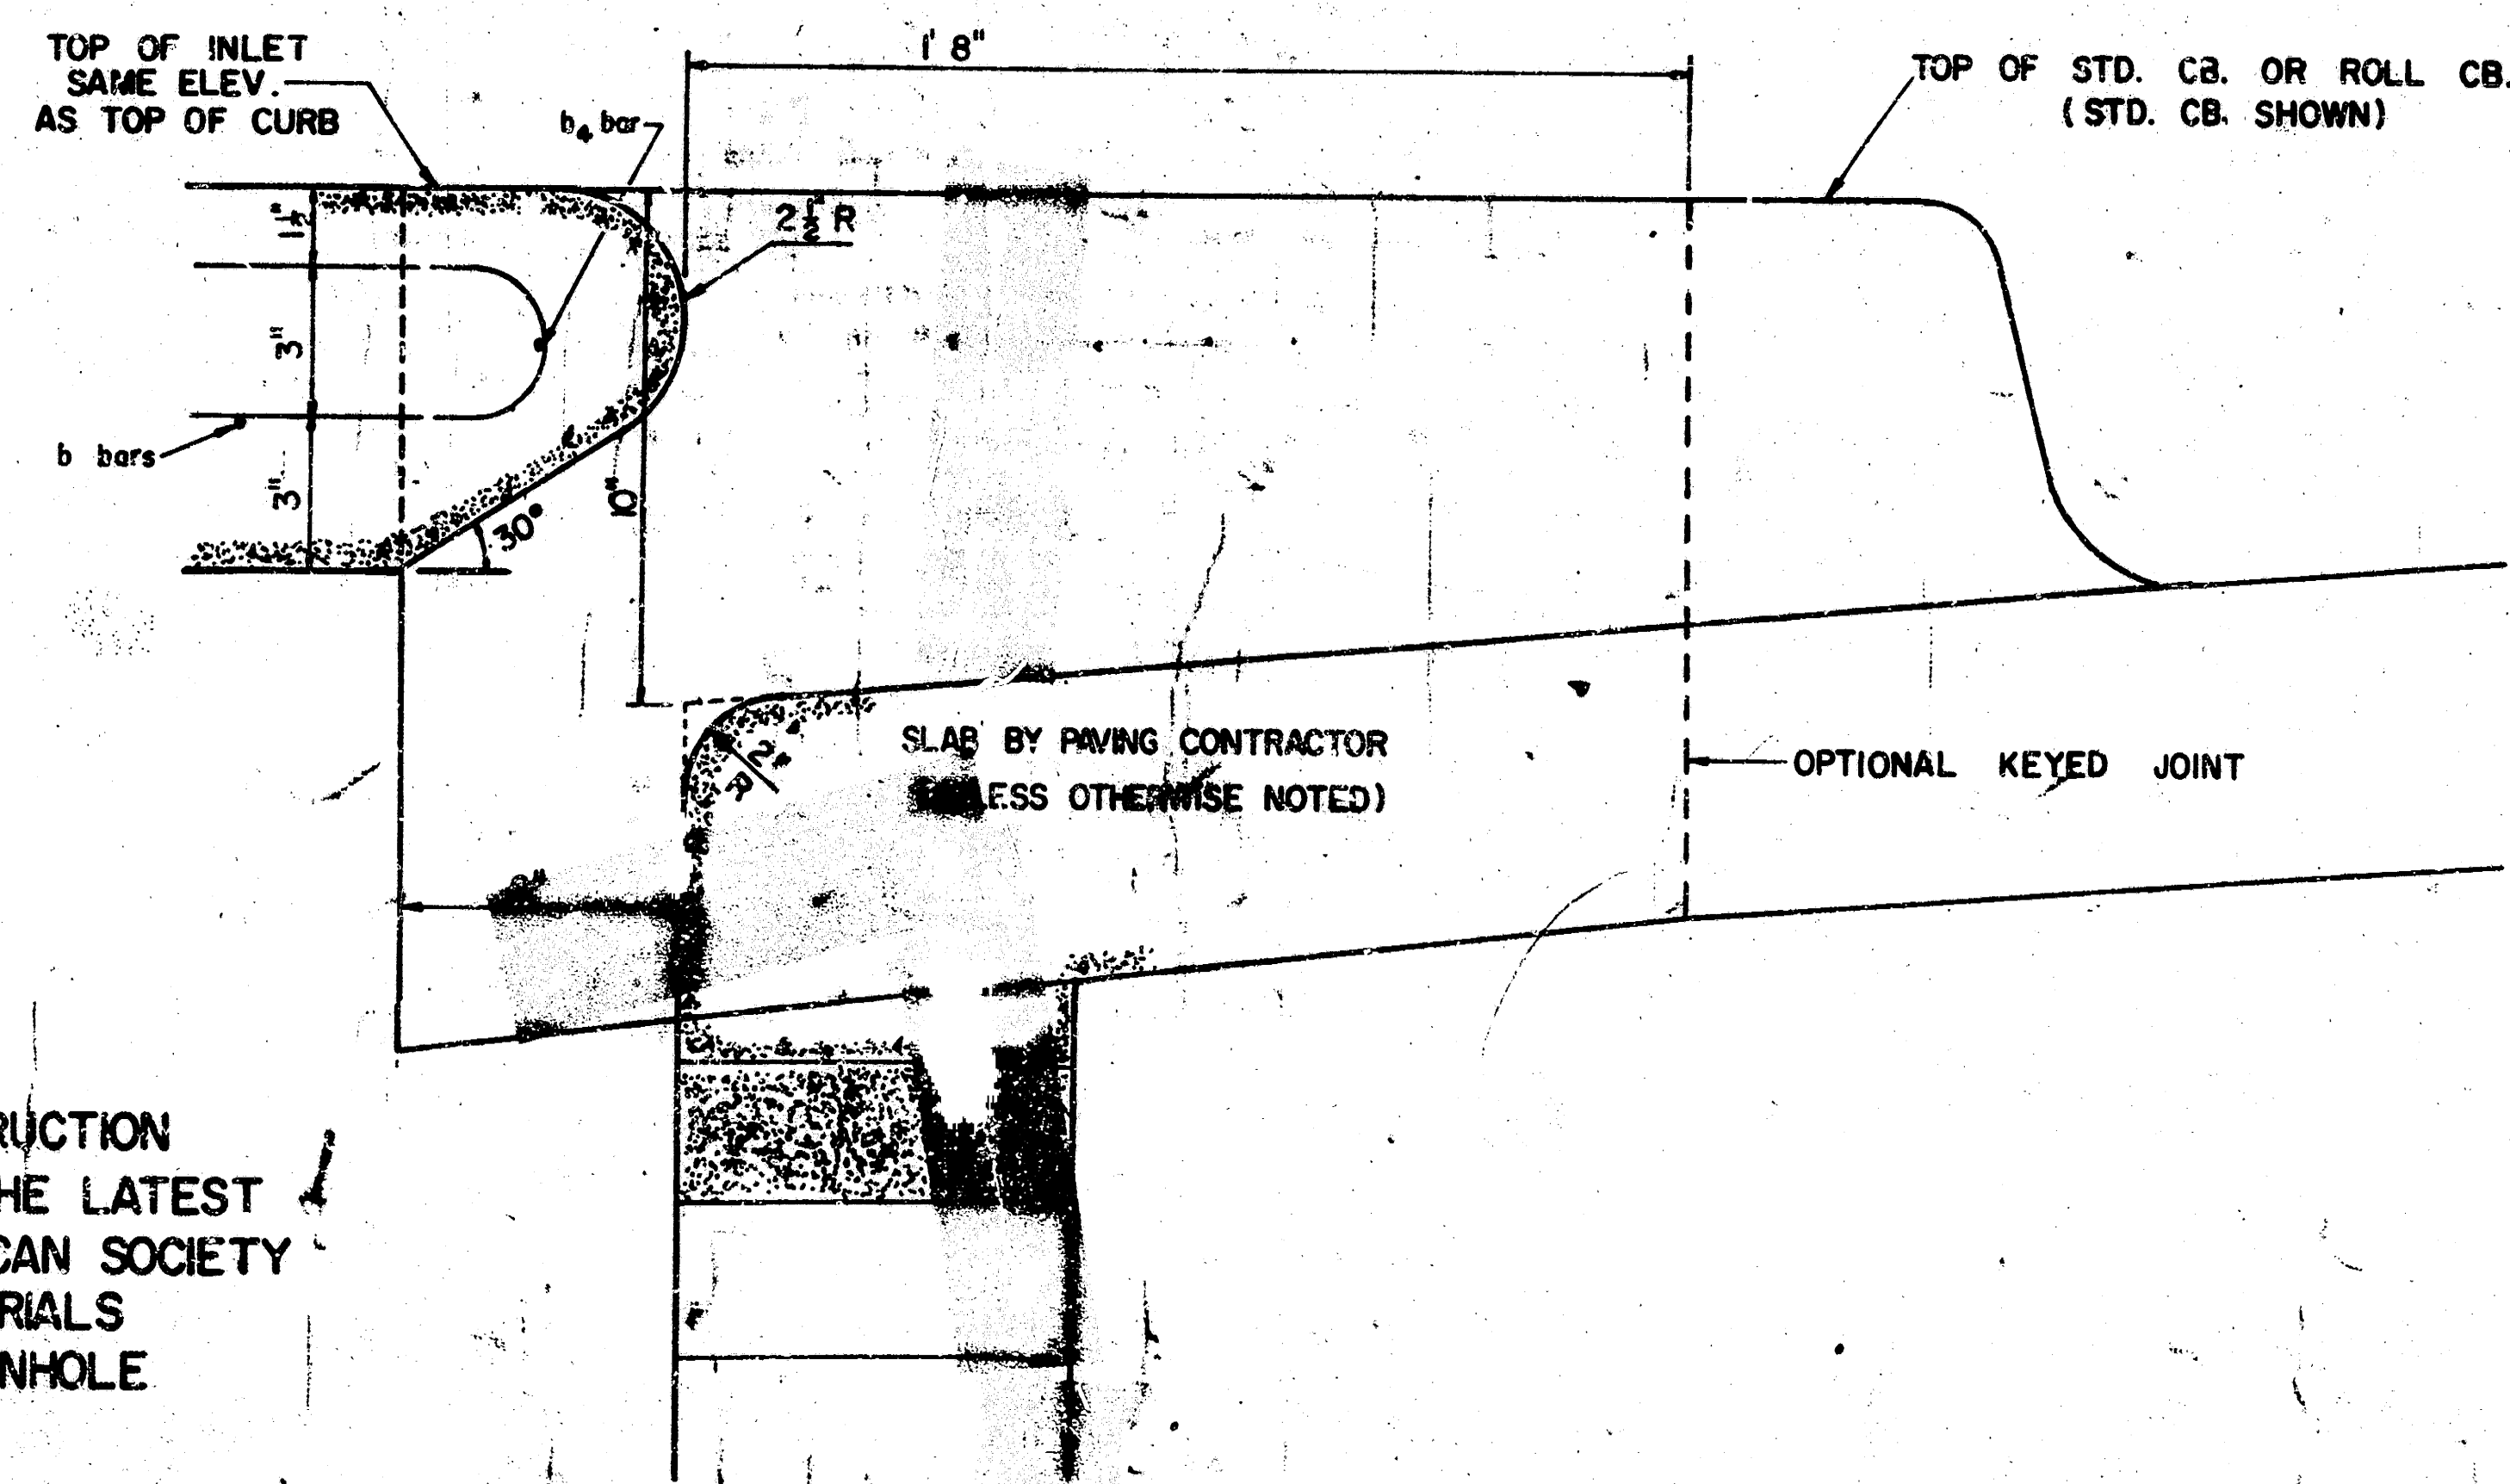


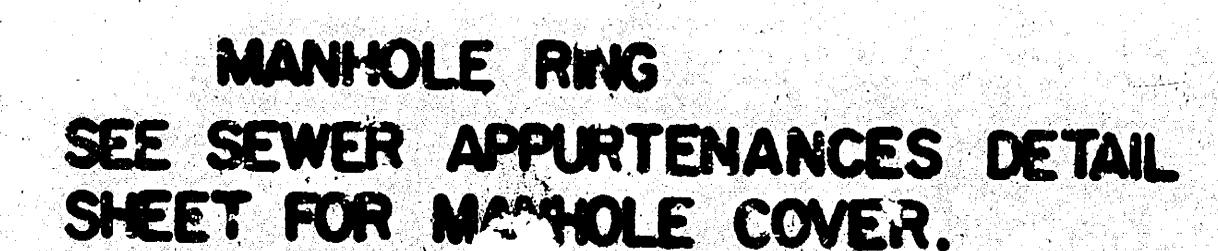

THIS TYPE INLET TO BE USED WHEN PAVEMENT IS ASPHALT PAVEMENT WITH ASPHALT BASE COURSE AND/OR WHEN PAVEMENTS HAVE ROLL CURB.

CITY OF WICHITA, KANSAS
R. W. LINN—CITY ENGINEER
FEBRUARY 1975

2/2