
B.M. 155.50 S.E. Cor. Porch Mos.# 5838 Castle Dr.
NOTE:
Stationing on 9.0' offset N. of S.P.L.

EXC. PROP.	CITY
2689.9	
+10%	
2958.9 cu. YDS.	

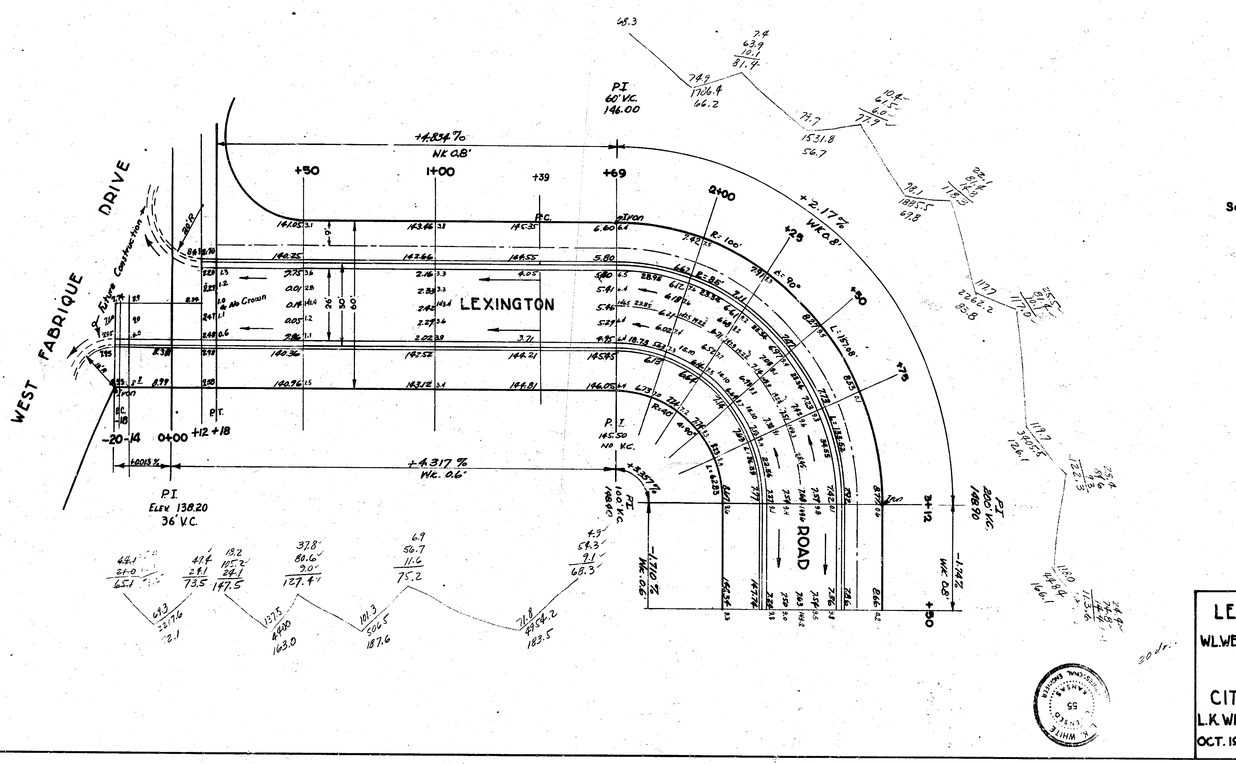

1/2

REVISED 1-25-52

LEXINGTON ROAD


WL. WEST FABRIQUE TO SL. CASTLE DR.

26-2-30 A.C.

CITY OF WICHITA, KANSAS

L.K. WHITE — CITY ENGINEER

OCT. 1951 — PROJ. NO. C 11-168

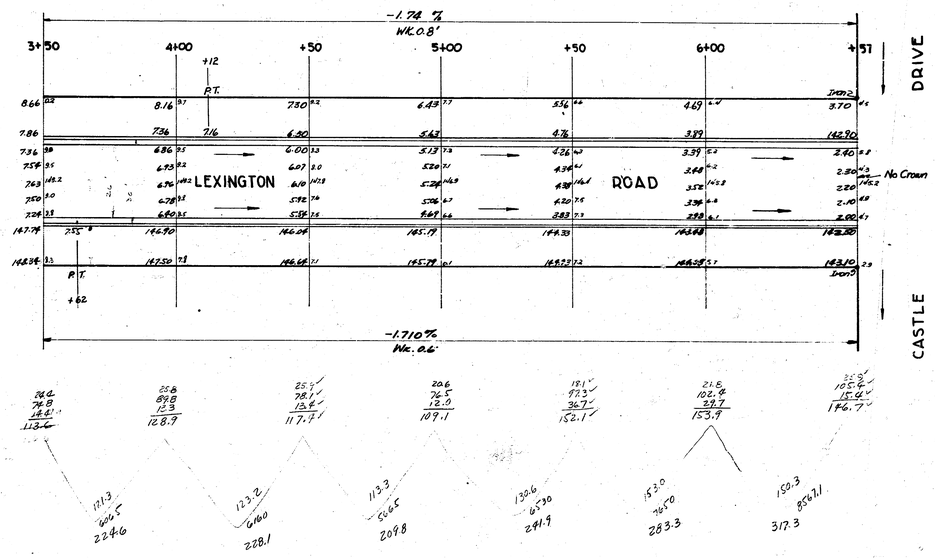

2/2

LEXINGTON ROAD

K. WHITE LICENSED 55 KANSAS