
Book H-3

NOTE: STAKES TO BE SET BY THESE BM'S ONLY.

BM 163.38 "M" in Mueller N.W. Cor. Gilbert & Lightner Dr.
BM 163.17 "M" in Mueller N.W. Cor. Mar. & Lightner Dr.
BM 161.20 "M" in Mueller N.W. Cor. Lincoln & Lightner Dr.

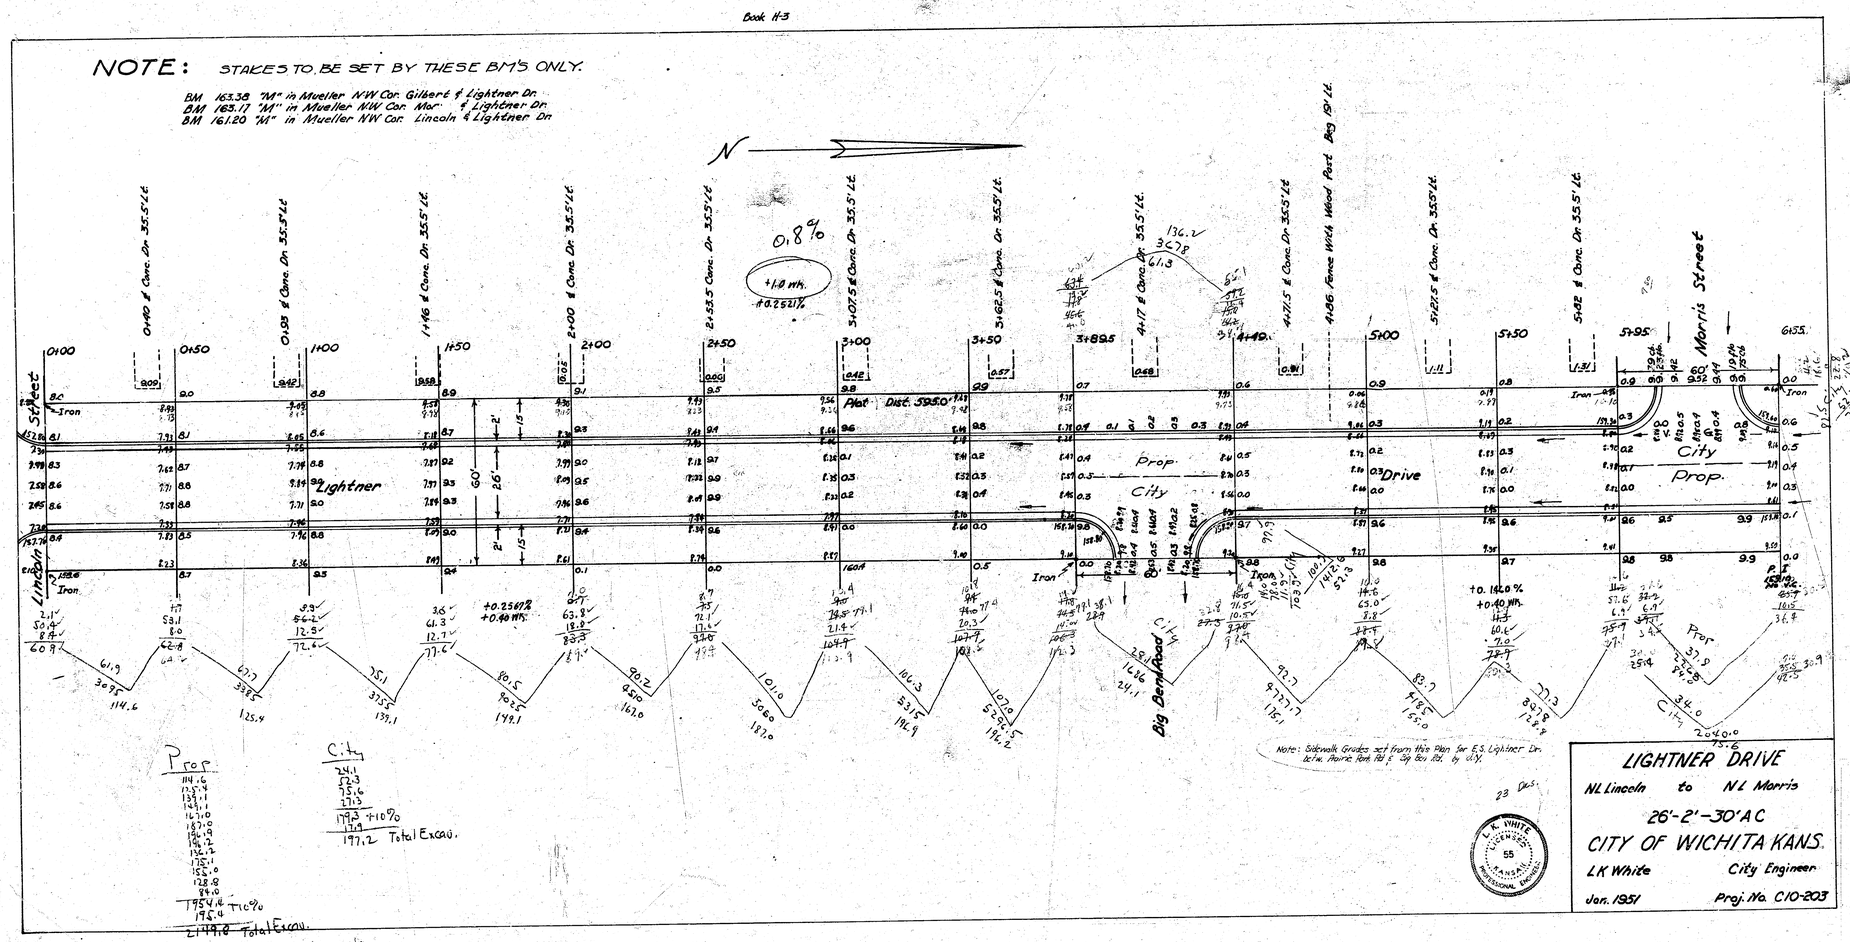

LIGHTNER DRIVE

NL Lincoln to NL Morris

26'-2'-30' AC

CITY OF WICHITA KANS.

LK White City Engineer

Jan. 1951 Proj. No. C10-203

S HB

NOTE: STAKES TO BE SET BY THESE ELEVATIONS ONLY !

BM 163.17 "M" in Mueller NW Cor. Morris & Lightner
BM 163.38 "M" in Mueller NW Cor. Gilbert & Lightner

STREET

0-60

MORRIS

LIGHTNER

DRIVE

PRAIRIE PARK ROAD

0+00 | 0+50 | 1+00 | 1+50 | 2+00 | 2+50 | 2+99.2 | 3+58.7 | 4+00 | 4+50 | 5+00 | 5+50 | 6+00

P.I. No. N.C. 159.10

P.C.

P.I. 100' V.C. 160.00

+0.251 %

+0.117 % No. 0.8'

+0.166 % No. 0.8'

NOTE: Match Existing Drives

Note: Sidewalk Grades set from this Plan for Lightner Dr. between Big Bee Rd. & Prairie Pk. Rd.

0140 ft Conc. Dr. 36'-0"
0150 ft Conc. Dr. 36'-0"
1148 ft Conc. Dr. 36'-0"
2409 ft Conc. Dr. 36'-0"
2158 ft Conc. Dr. 36'-0"
3111 ft Conc. Dr. 36'-0"
3170 ft Conc. Dr. 36'-0"
4128 ft Conc. Dr. 36'-0"
4177 ft Conc. Dr. 36'-0"
5138 ft Conc. Dr. 36'-0"
5190 ft Conc. Dr. 36'-0"

Excavation

Property	City
141.3	50.2
136.1	61.8
138.2	39.2
130.2	25.2
114.6	1.774
101.2	142
65.8	1621 cu yds
7.8	
63.4	
50.8	
55.2	
96.1	
43.3	
64.6	
73.3	
81.1	
65.2	
27.2	
83.0	
1.776	
139.1	
139.2	
177.2	
111.8	
1128.	
2430.8	
243.1	
2673.9 cu yds	

LIGHTNER DRIVE
SL MORRIS to NL ORME
26'-2-30' AC.
City of Wichita Kansas
LK White City Engineer
April, 1951 Proj No. C11-30

L. K. WHITE LICENSED KANSAS PROFESSIONAL ENGINEER 55

Seal #8

GILBERT STREET

SL CRIME STREET

LIGHTNER

DRIVE

+0.753%
Vc. 0.7'

+0.716%
Vc. 0.8'
7+00 to 12+66

P.I.
102 V.C.
160.00

P.T.

Vc. GRAD. FROM 0.8' TO 0.4'
6+00 to 7+00

Interaction @ DRIVE on Proj. C10-112

2
2