


1941
LINCOLN ST N½ - EL. GEO. WASHINGTON TO W.L. HILLSIDE
20' CONC-INT. CURB

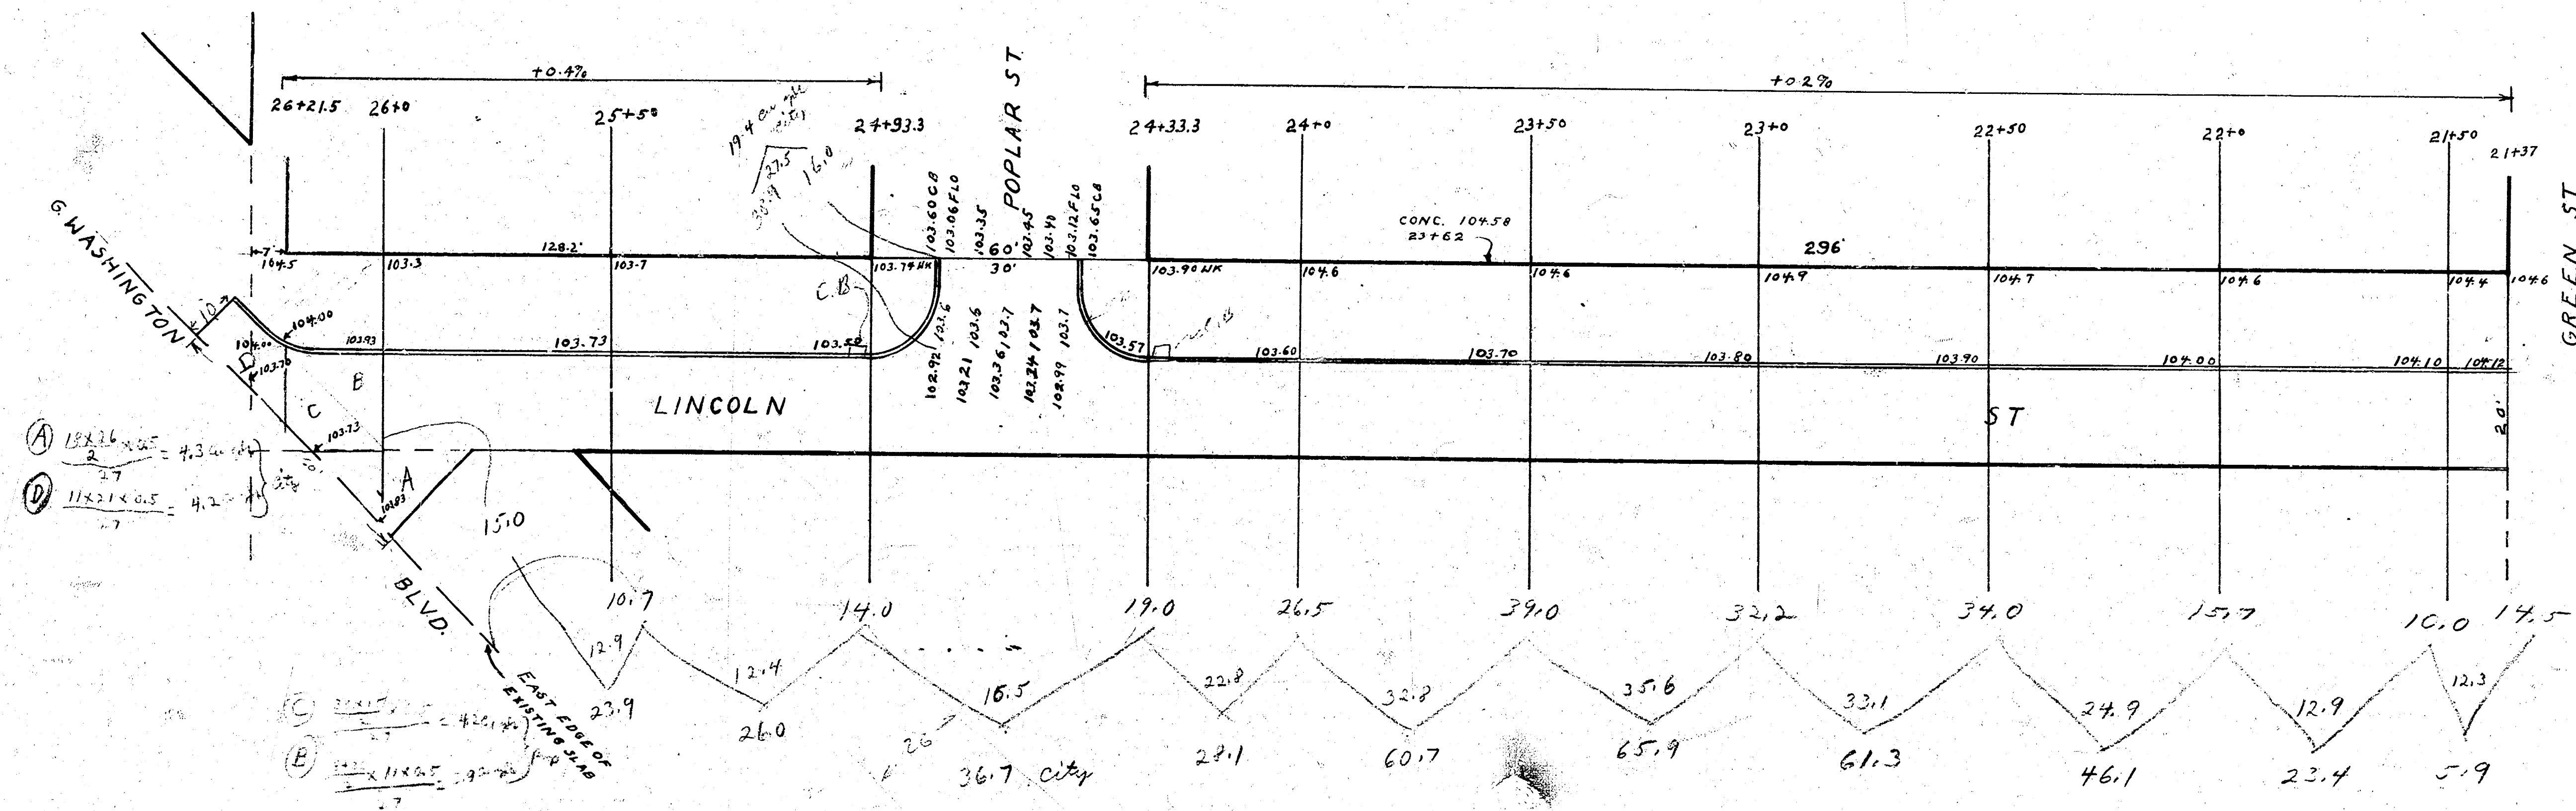

Prop	City
4.2	4.2
3.9	4.2
23.9	4.2
26.0	36.7
32.1	19.4
60.7	64.6
65.9	100.0
61.3	6.5
46.1	71.1
23.4	
5.9	
34.9	
34.9	
34.3	


Total for job


Prop	City
34.3	71.1
163.0	54.6
260.0	1.2
574.6	1.4
519.9	1.2
54.6	1.2
361.7	1.2
2820.1	171.6

Grand Total → 3761.7


1941

6" Crown
7" Carb

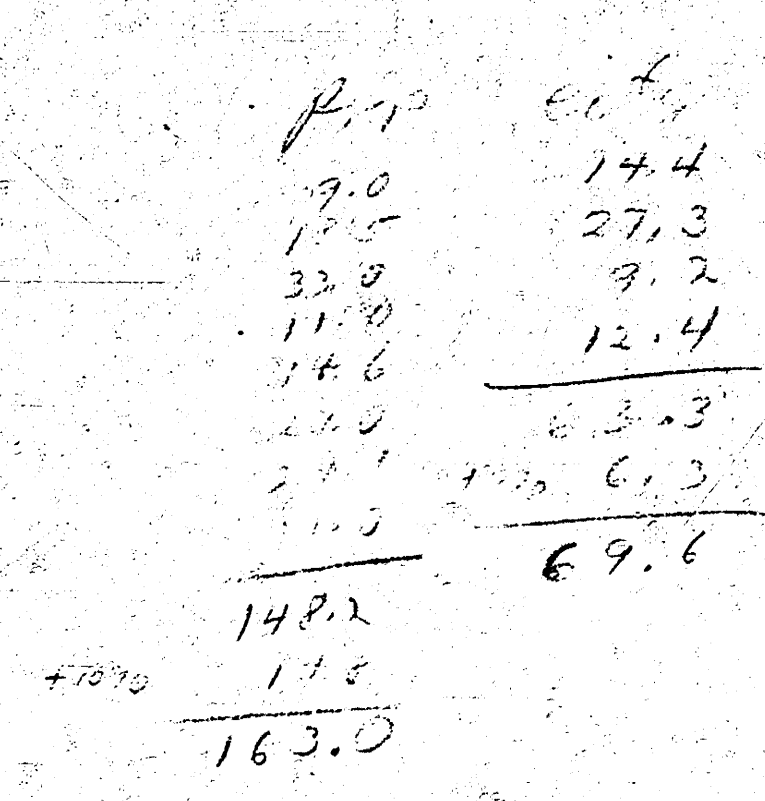


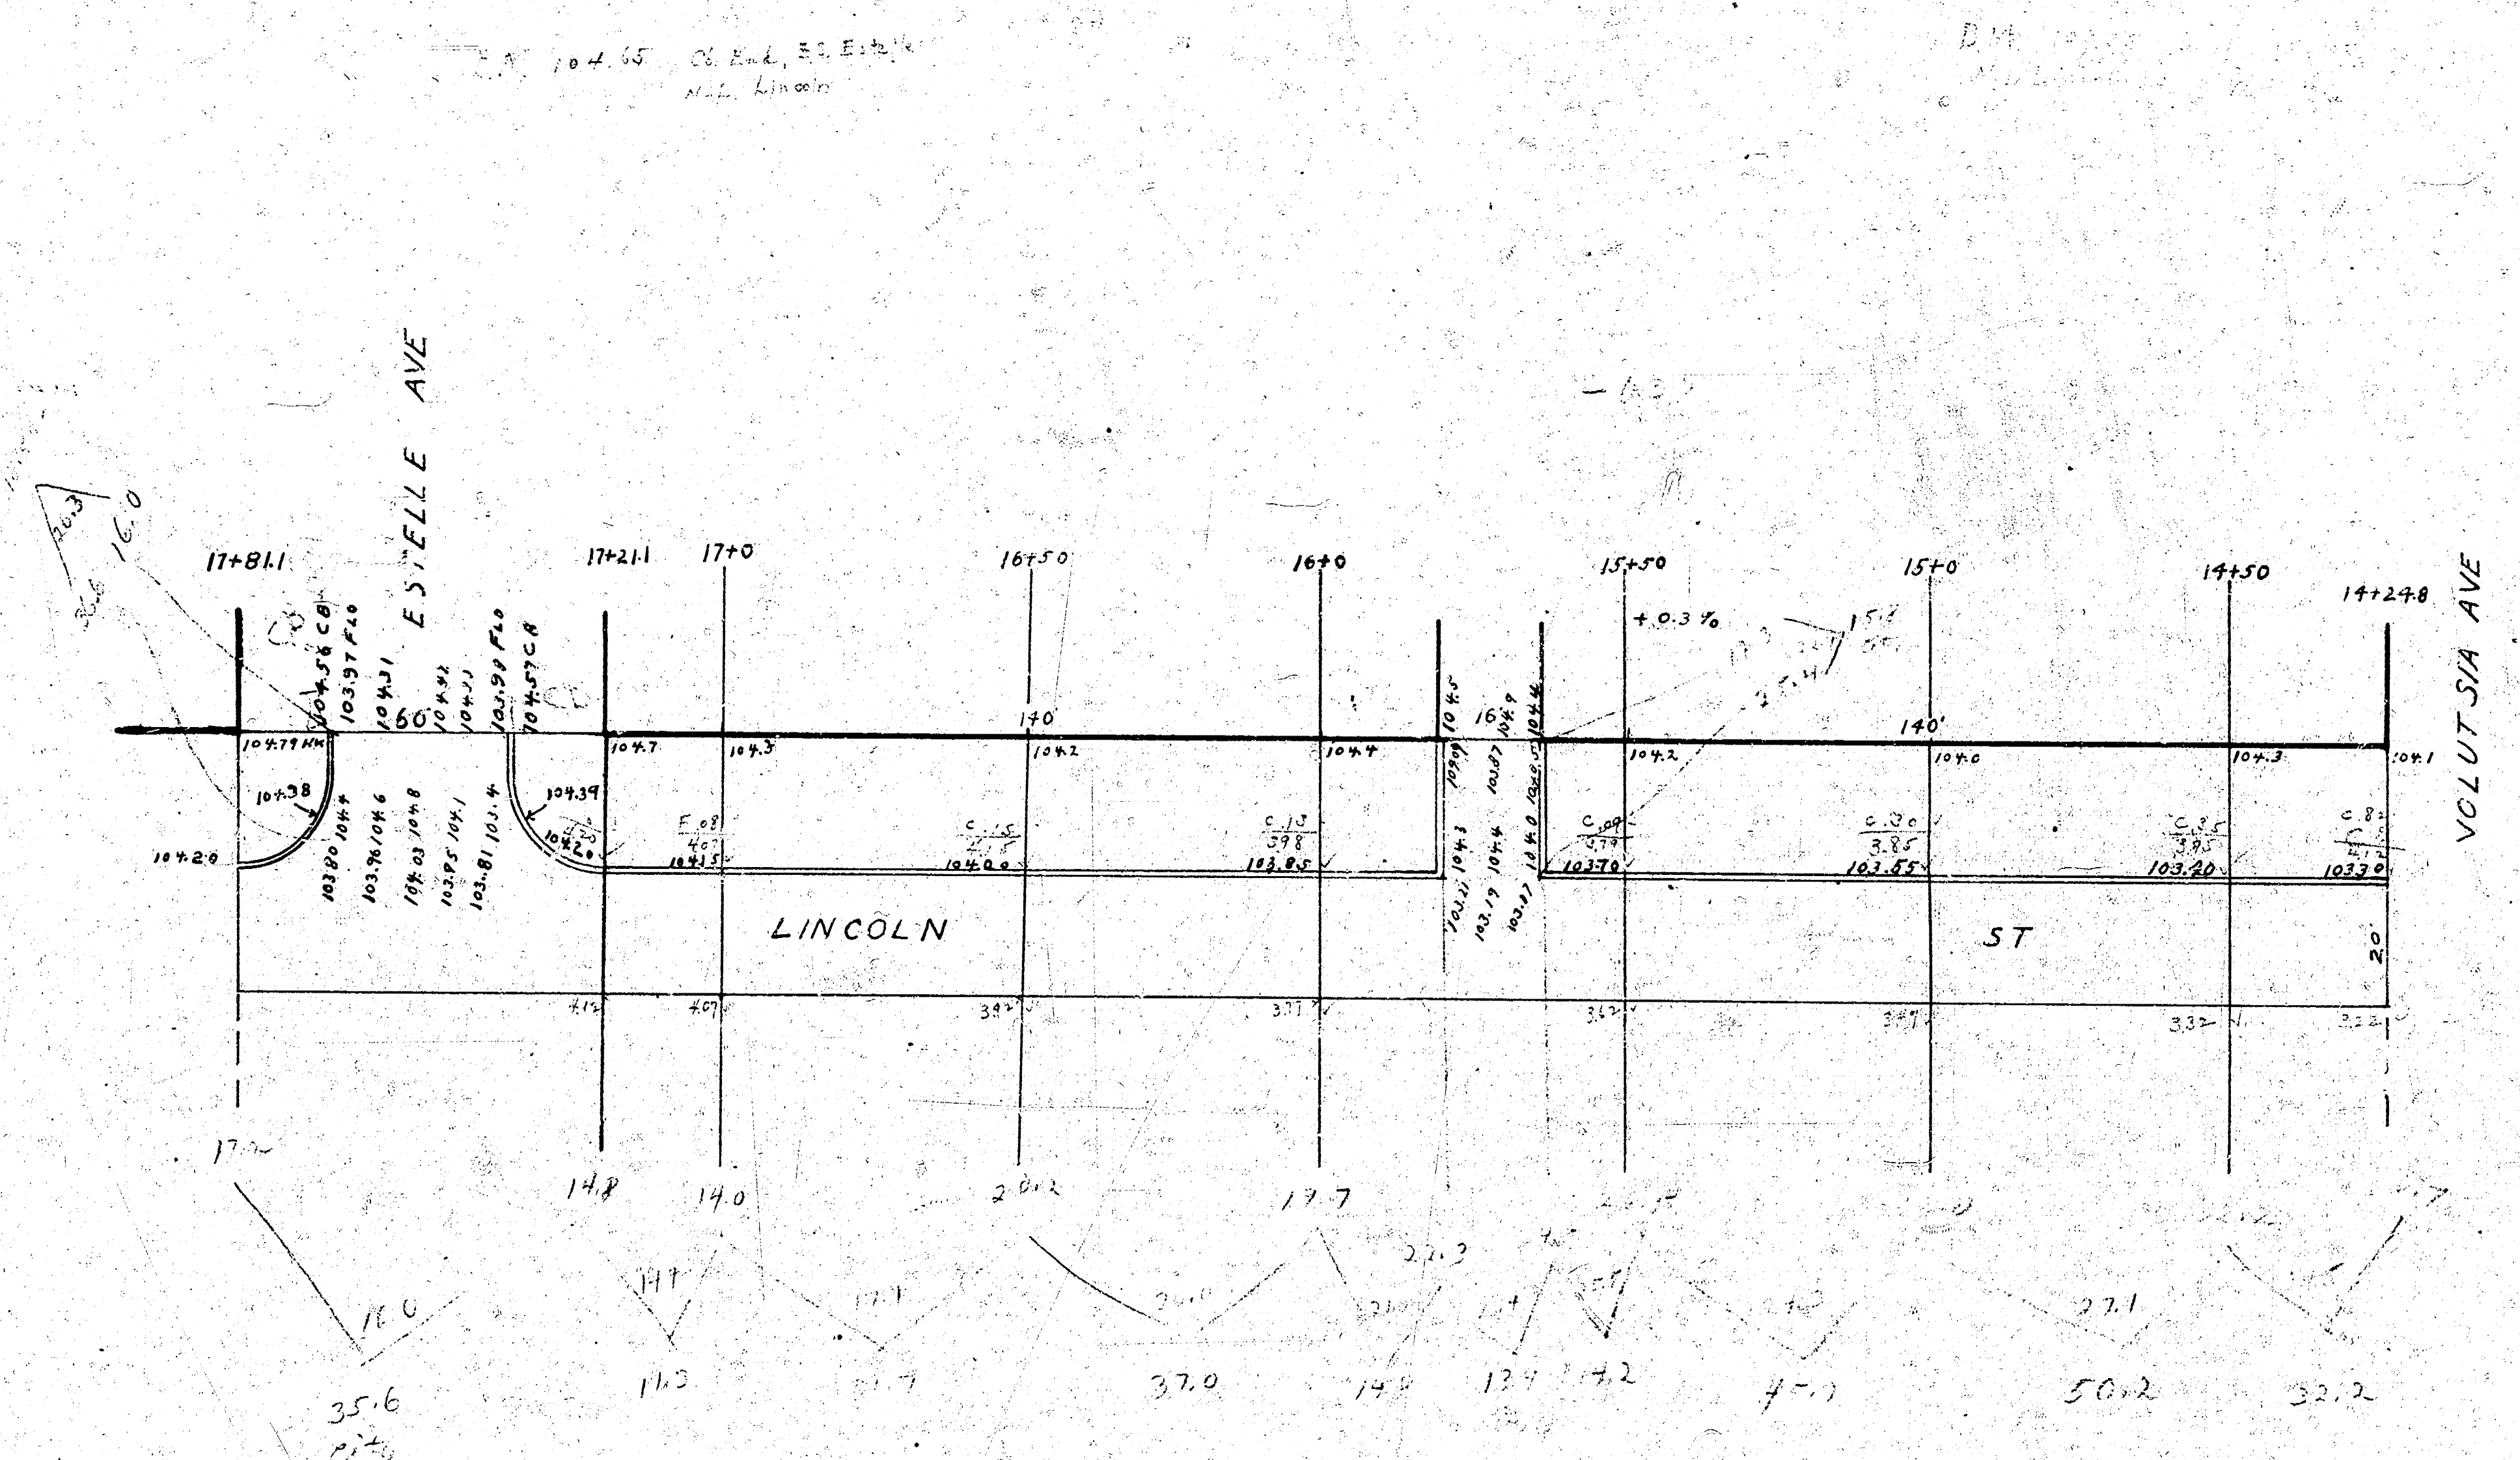

11.3	18.5
31.7	35.6
37.0	17.5
24.6	13.9
14.2	8.8
45.0	20.4
50.2	92.2
36.4	
80.6	
60.0	

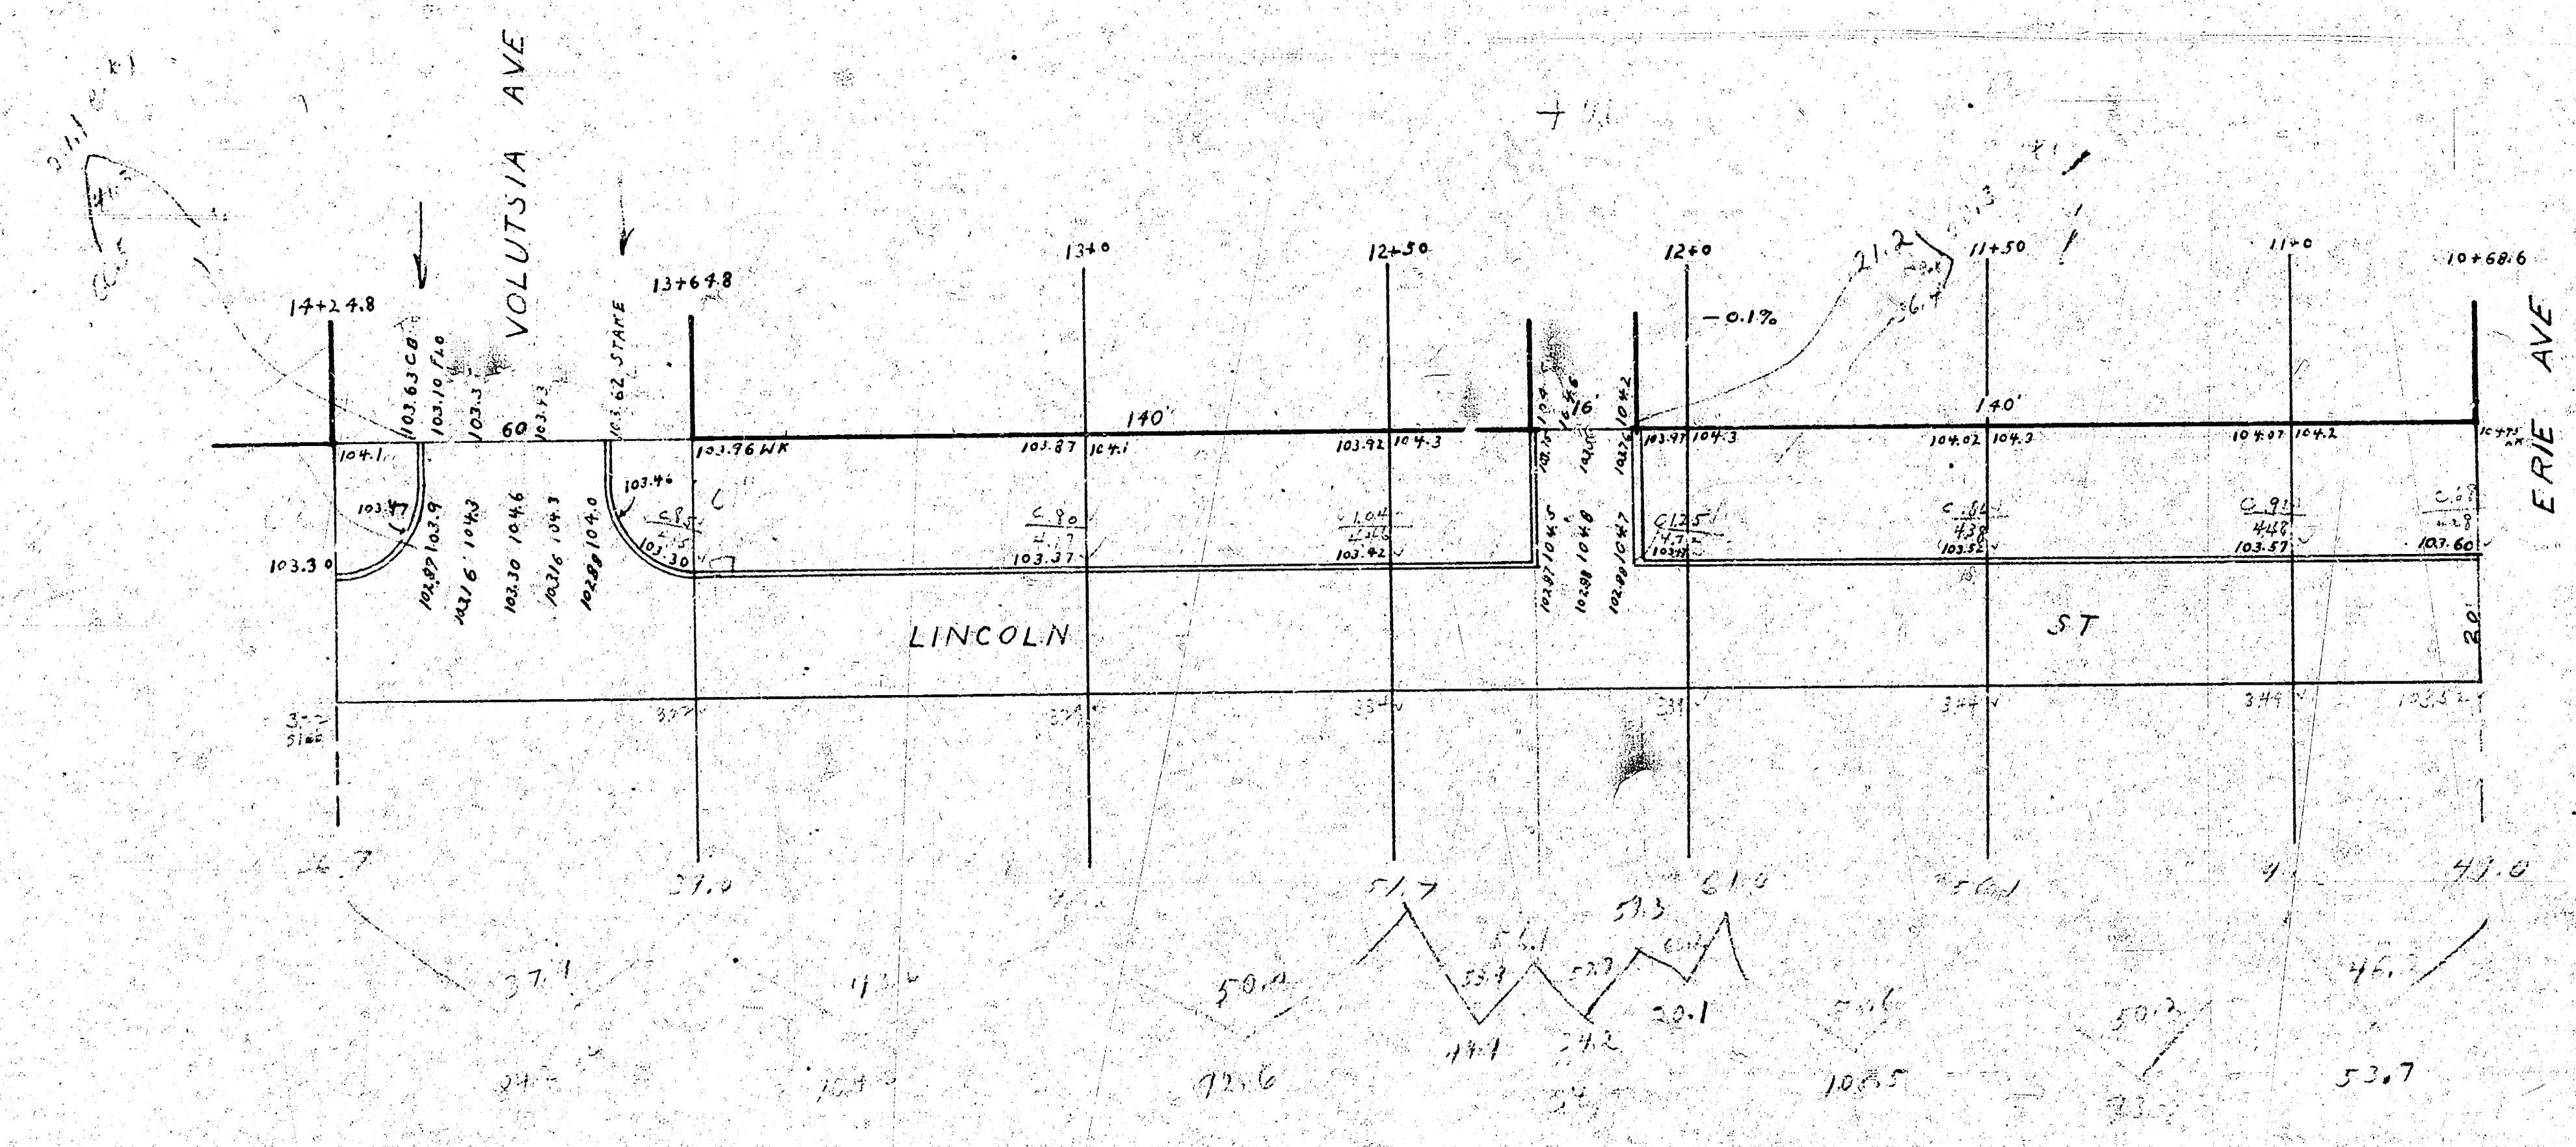

154.6	1
41.7	2
1	3
167.2	
522.4	57.3

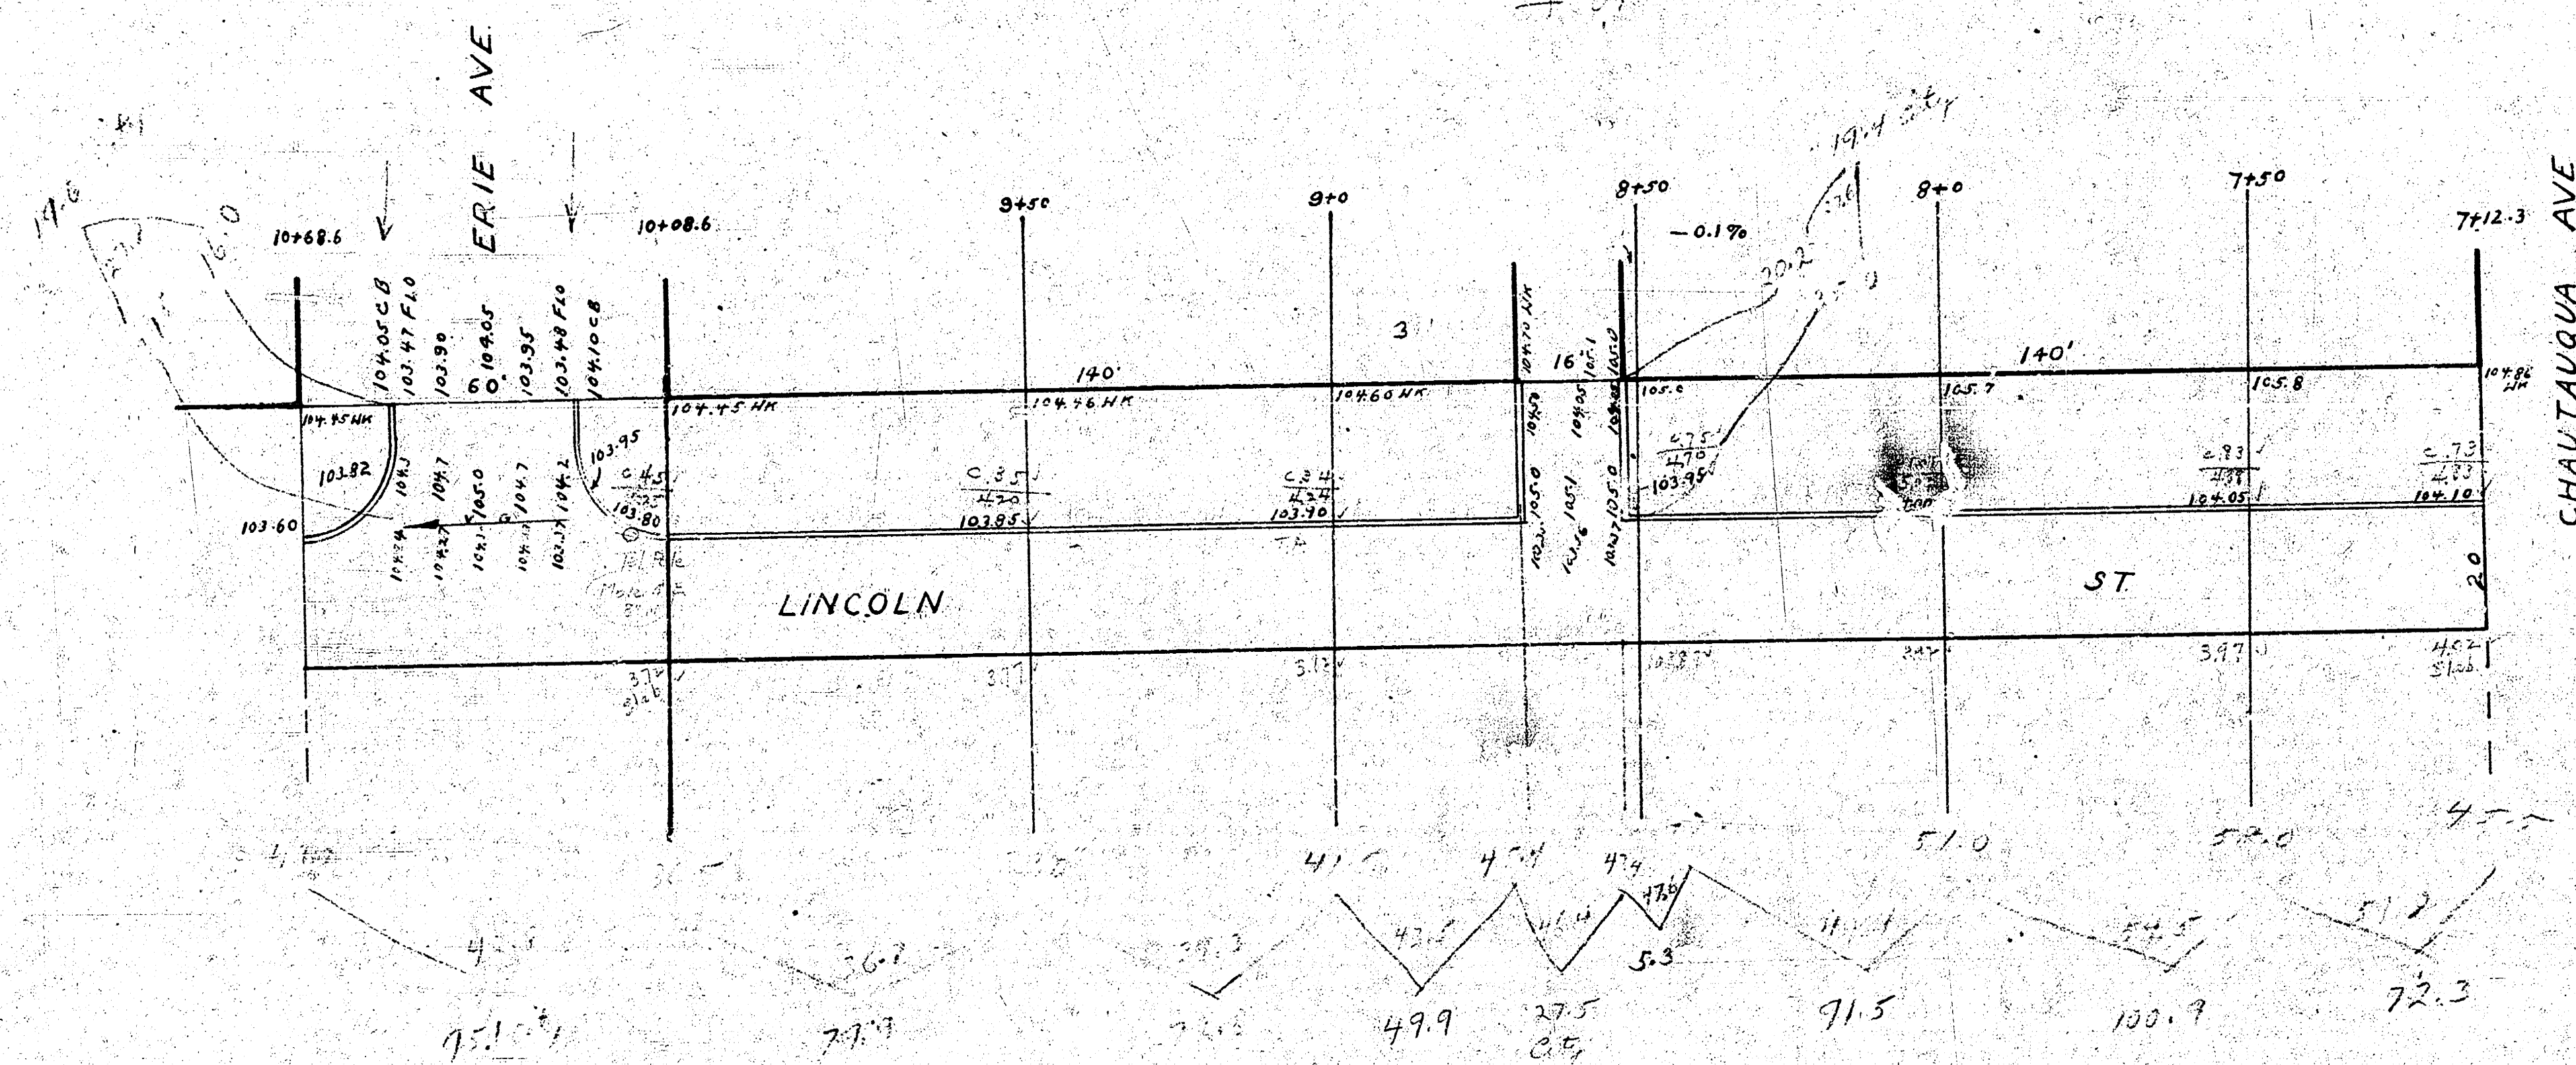

Prop City

73.9	19.6
72.8	95.1
19.7	19.4
5.3	27.5
91.5	161.6
100.9	+0.2 16.2
72.3	177.8
472.6	
47.3	
519.9	

