


$\frac{1}{2}$	$\frac{1}{2}$
4.2	
3.7	4.3
2.2.7	4.2
26.0	26.7
22.1	19.44
60.7	64.6
65.9	+10.20 6.5
61.3	
76.1	71.1
25.4	
5.9	
347.4	
+10.20 34.9	
382.3	

Totals for Job	
Prop	City
374.3	71.1
183.0	296
260.0	1.2
574.6	146
579.9	133.3
574.6	
264.7	
2010.1	771.6

Grand Total → 3761.7

1941


6" Crown
7" Carb

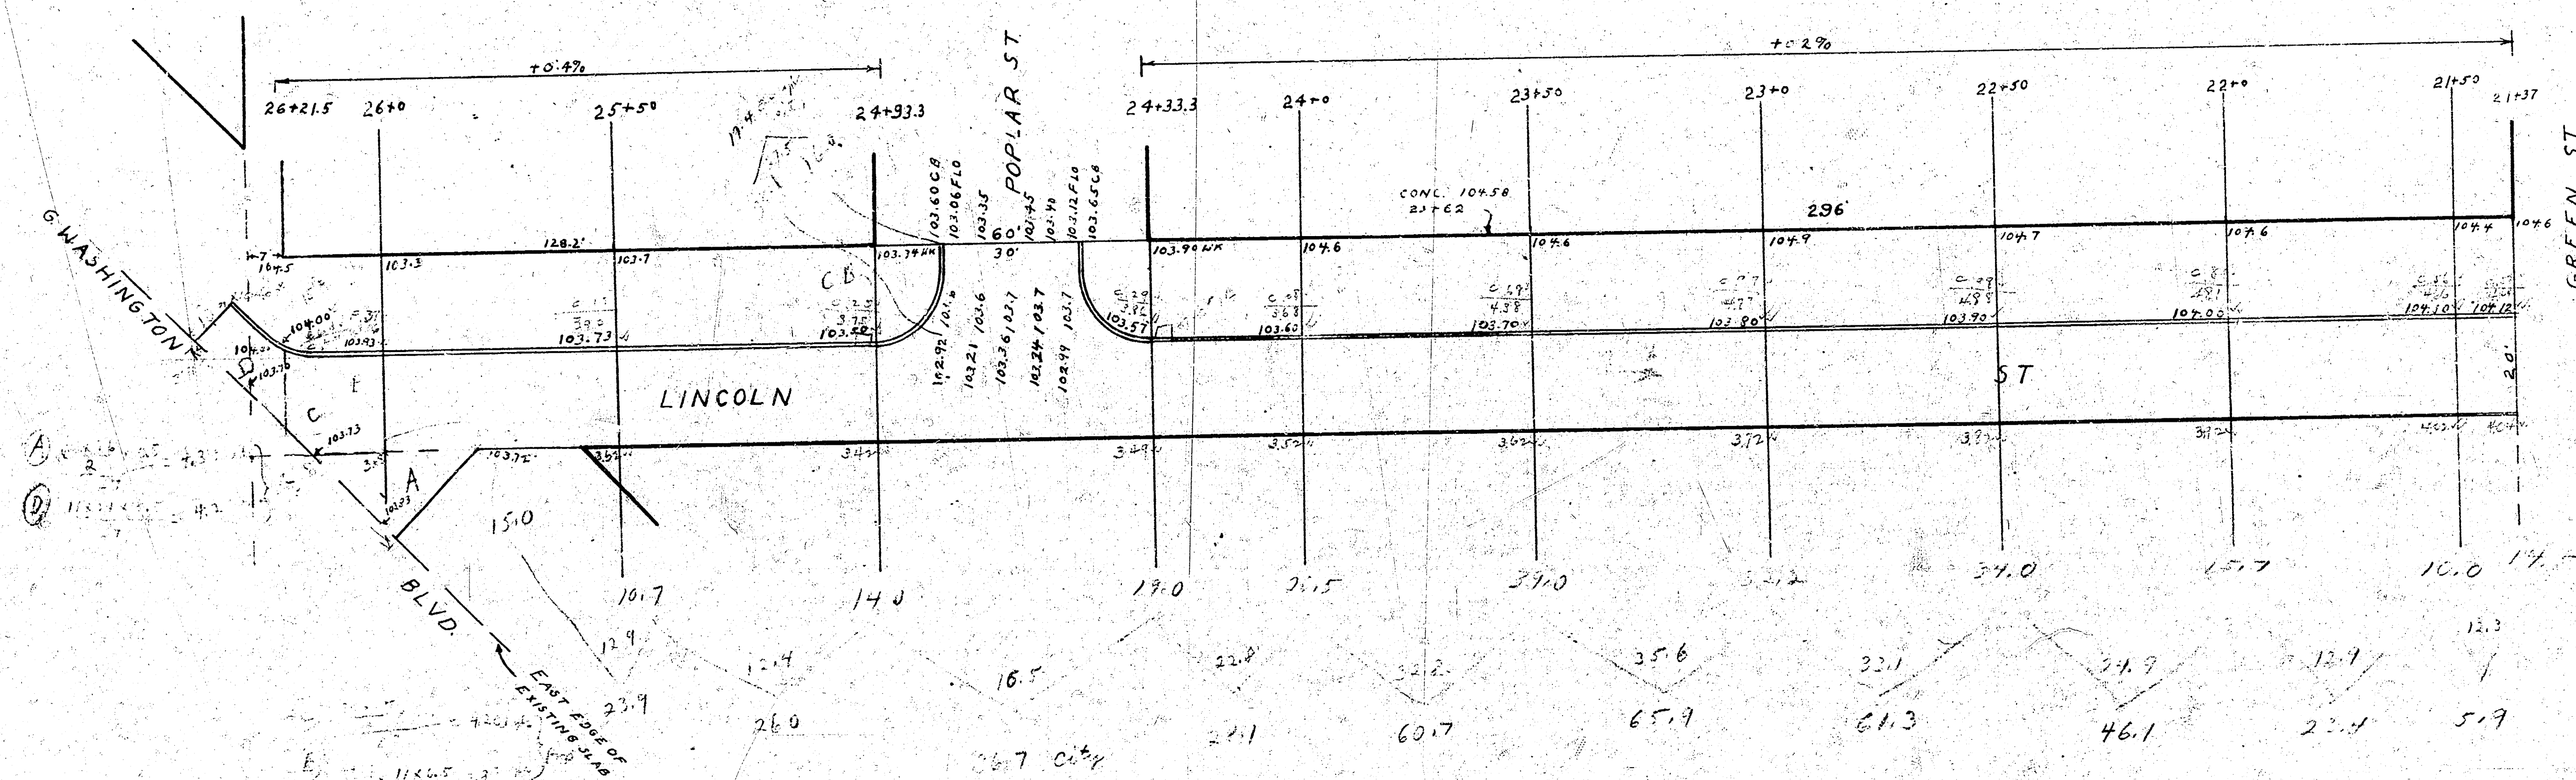


$$\begin{array}{r} 42 \\ 37 \\ \hline 79 \end{array}$$


$$\begin{array}{r} 1 \\ 21 \\ 28 \\ 61 \\ 613 \\ 751 \\ 724 \\ 54 \\ \hline 5474 \end{array}$$

$$\begin{array}{r} 5474 \\ 42 \\ \hline 5516 \end{array}$$

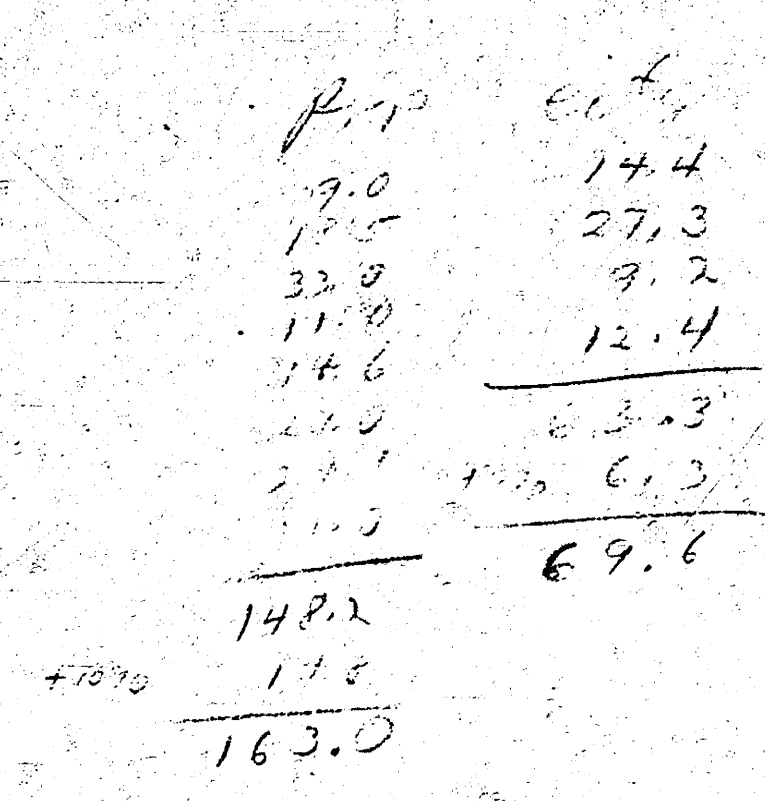

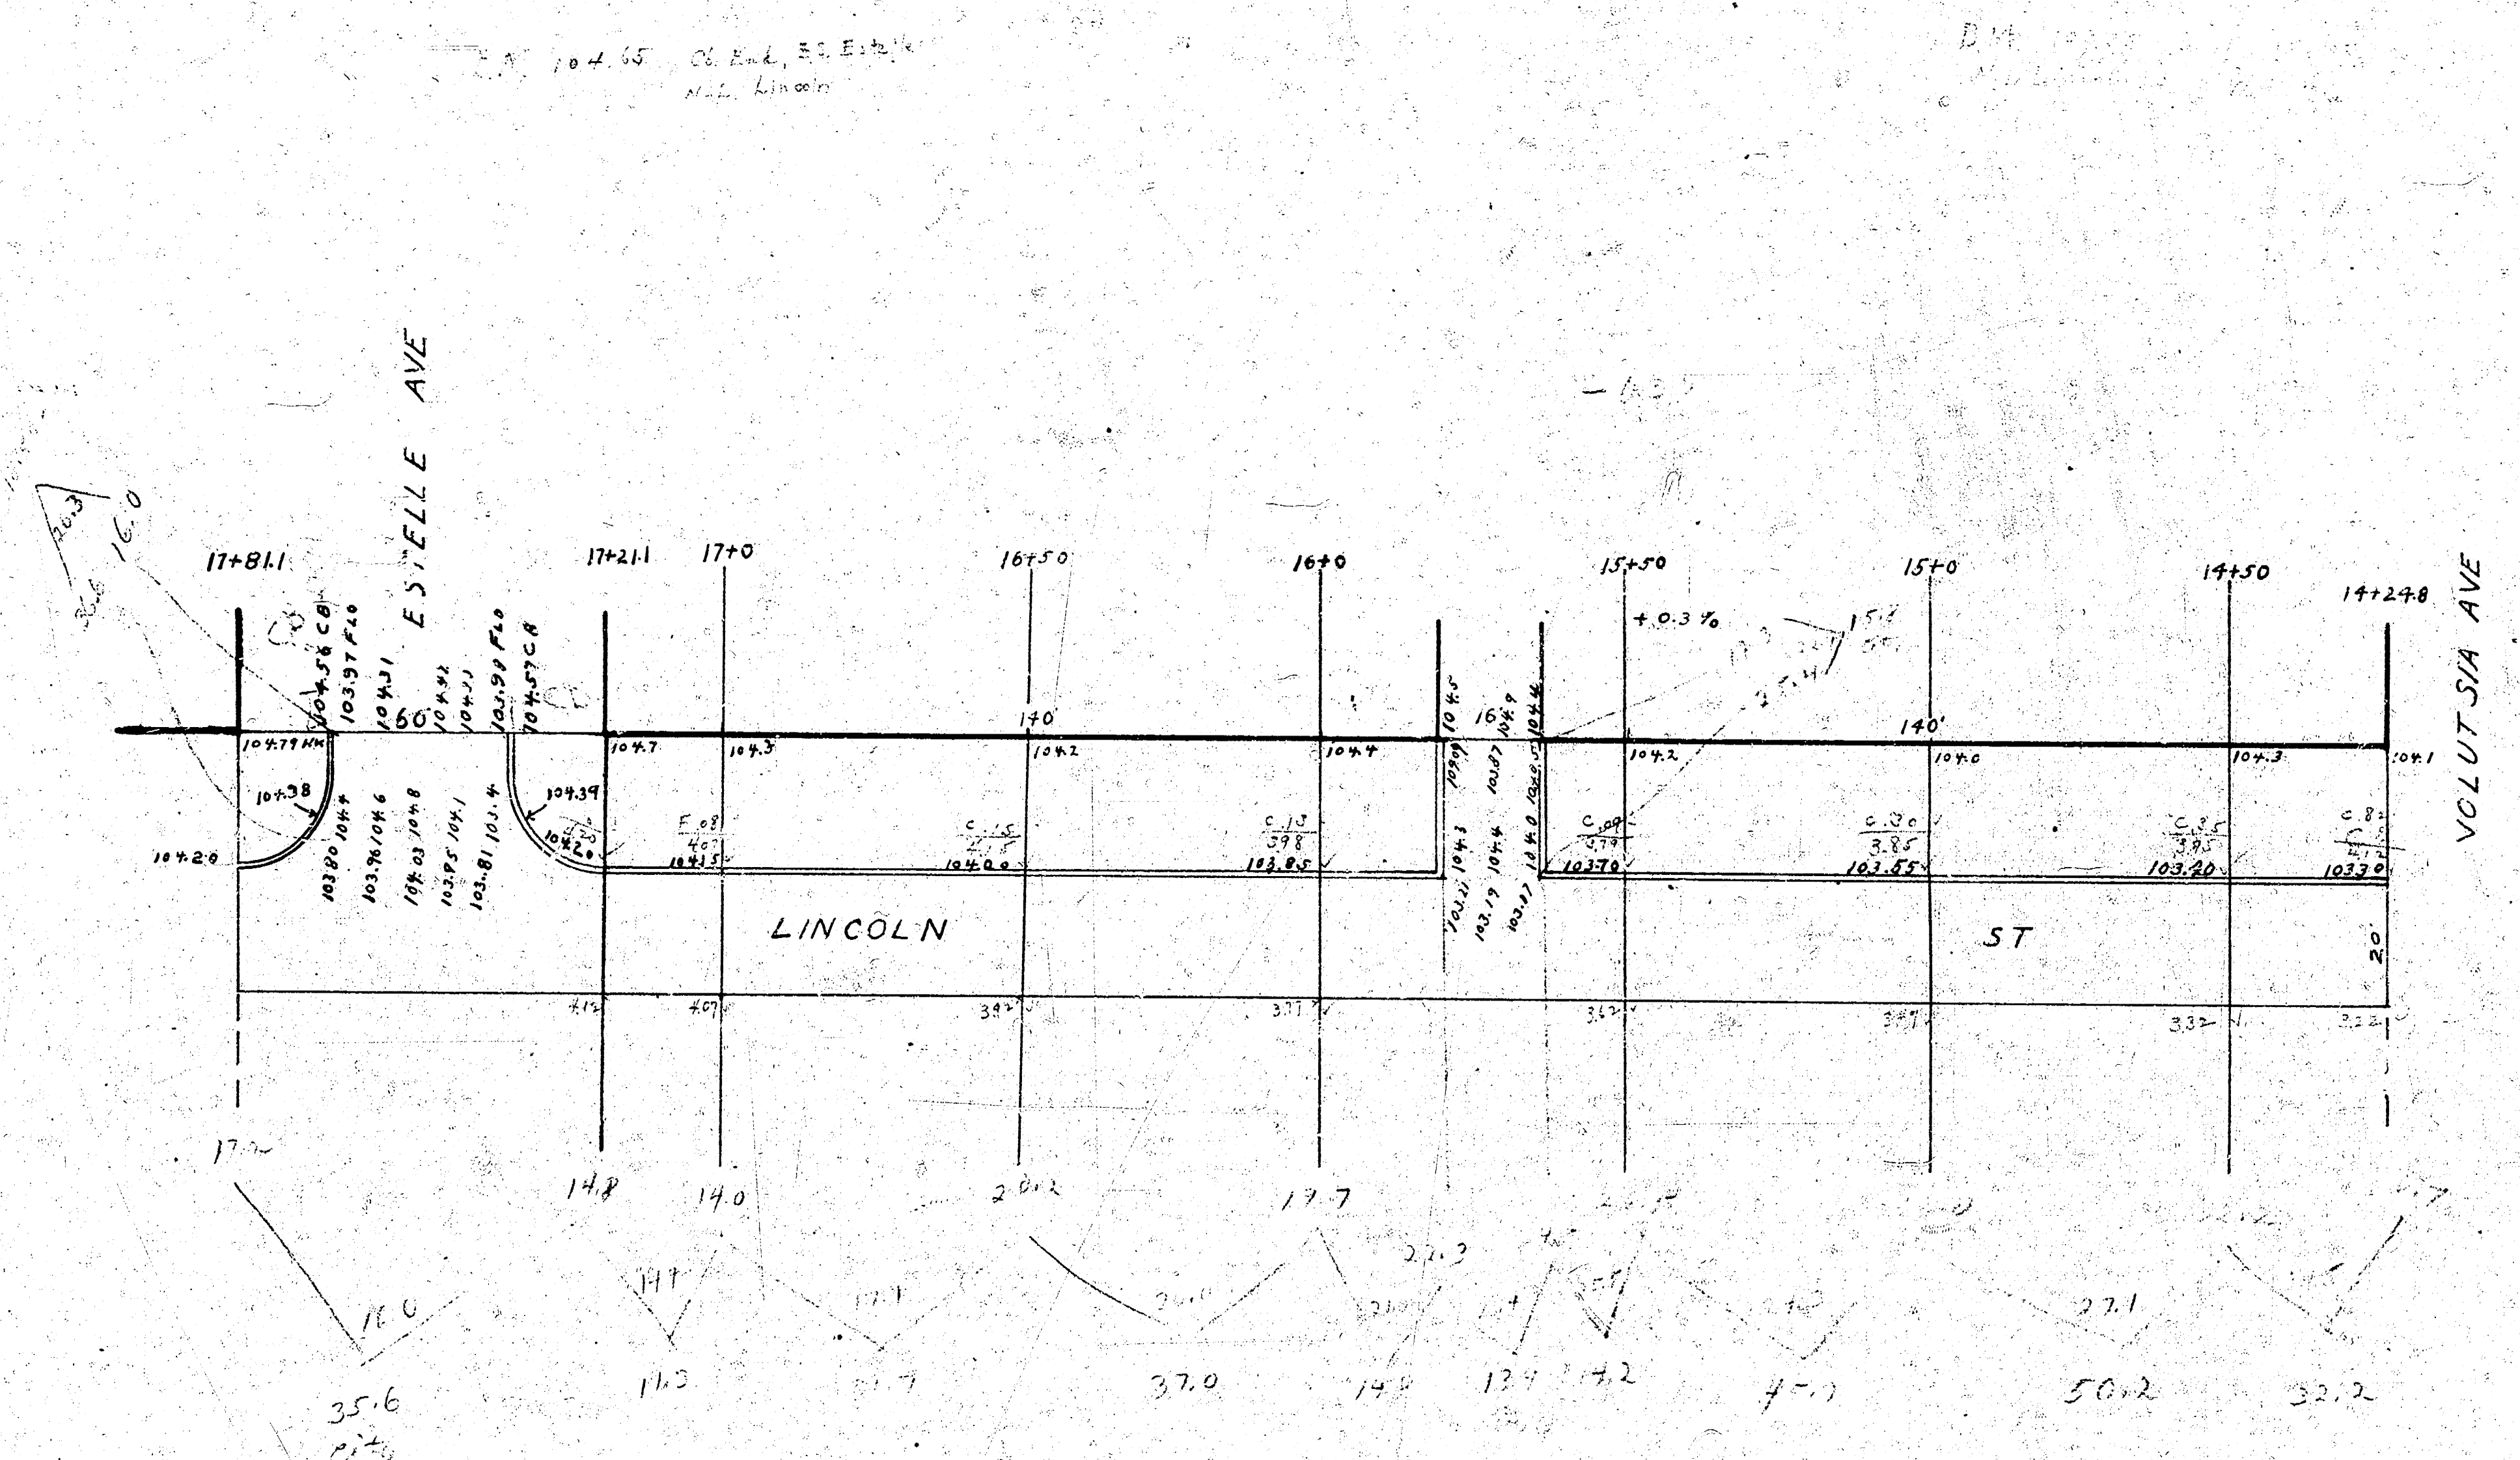


11.3	18.5
35.6	35.6
37.0	15.5
24.0	13.9
14.2	8.8
45.0	20.1
50.2	30.6
30.2	92.2
30.4	
30.6	
30.0	

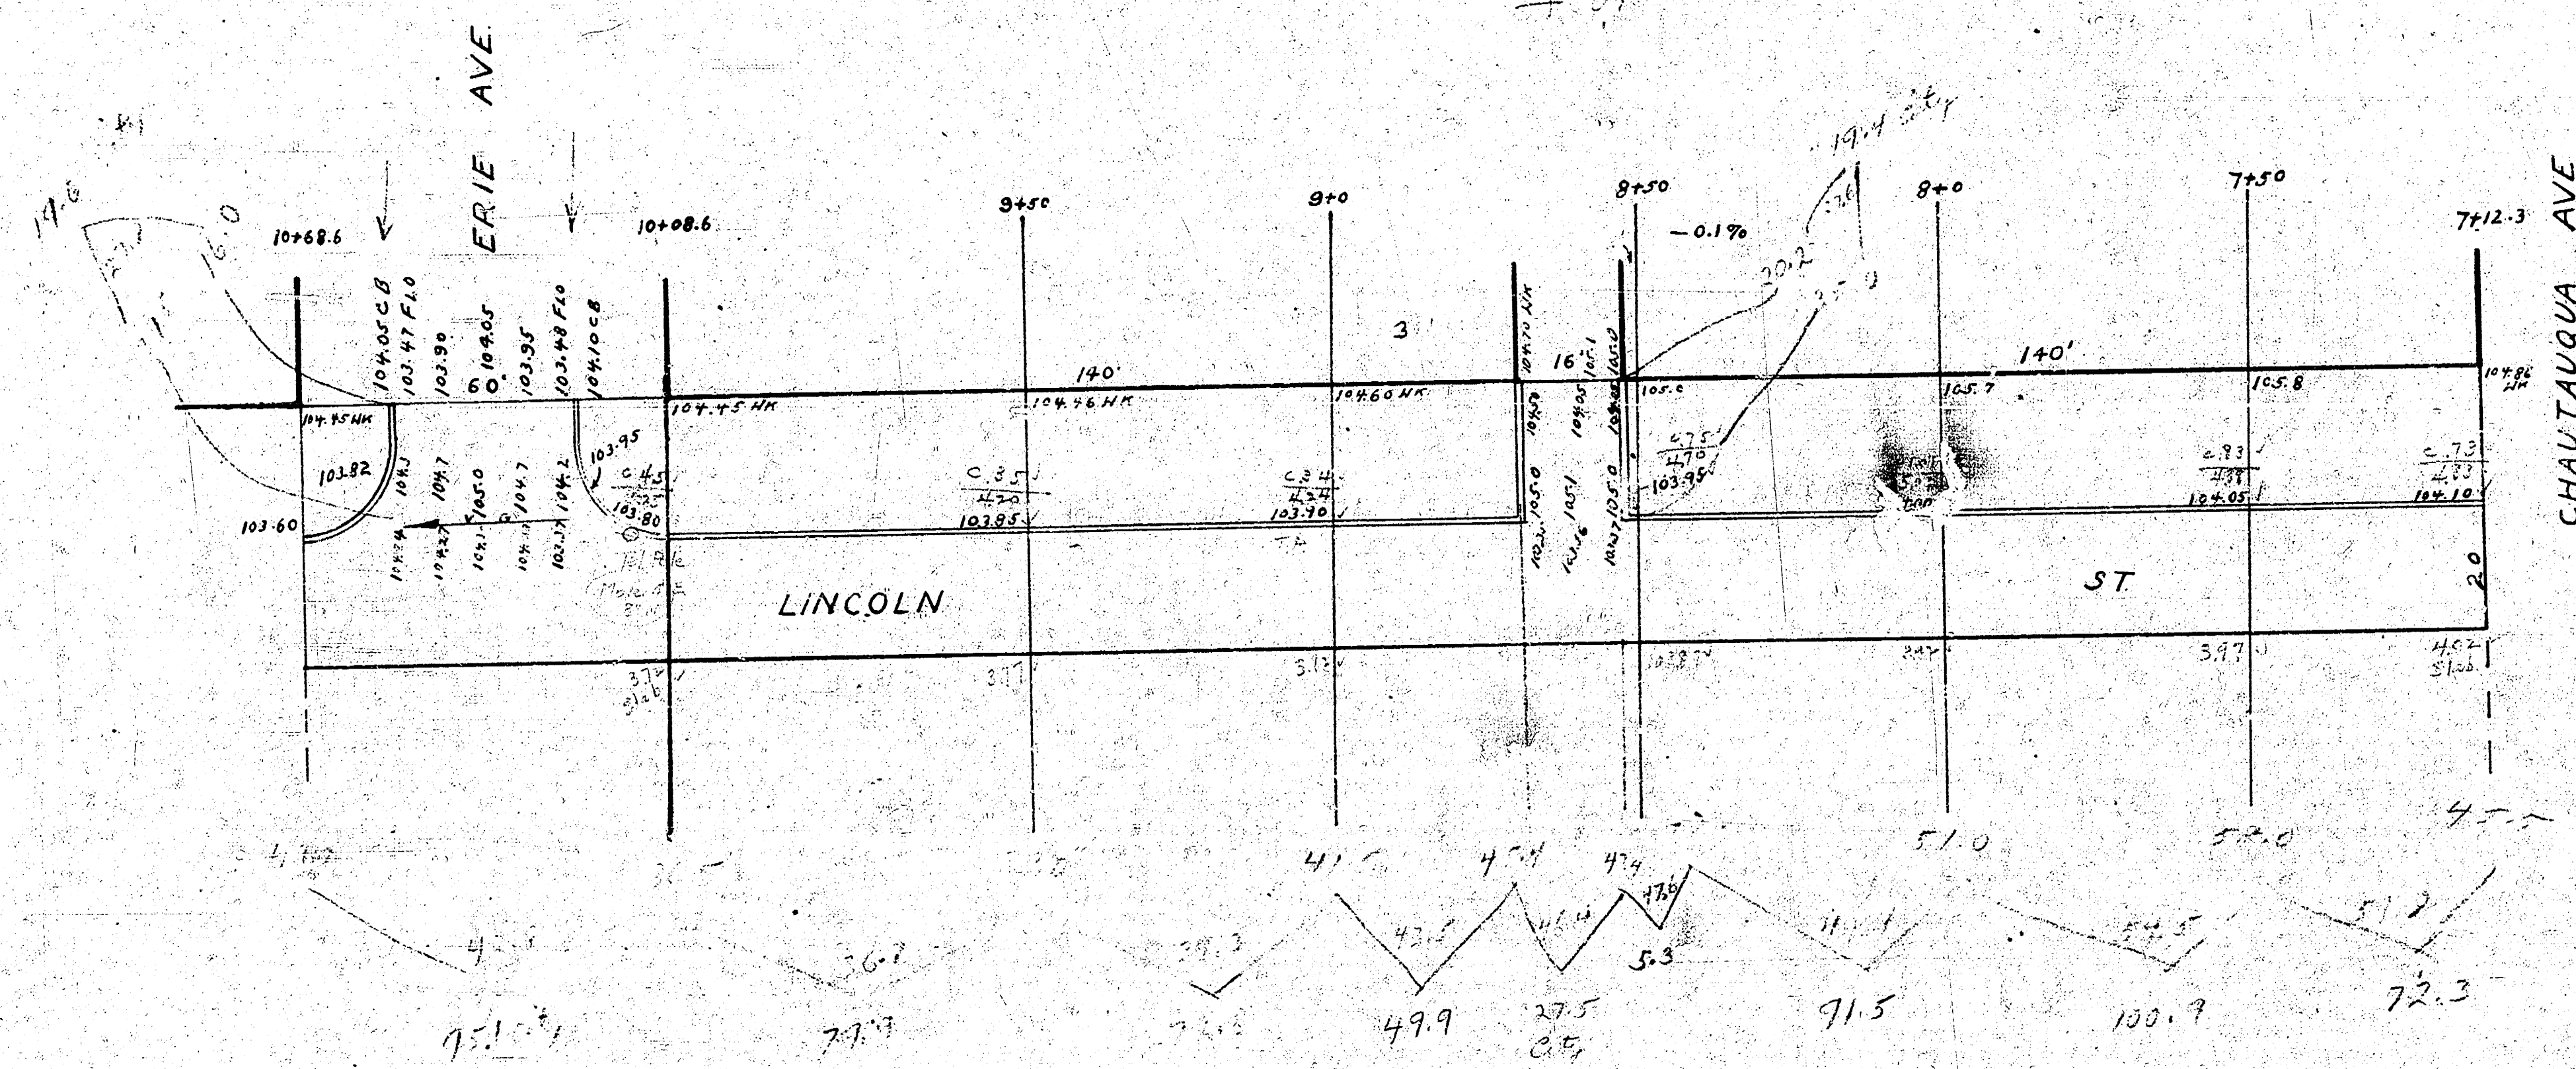


Prop City

73.9	19.6
72.8	95.1
177.7	19.4
51.3	27.5
91.5	161.6
100.7	+0.2 16.2
721.3	177.8
472.6	
47.3	
519.9	

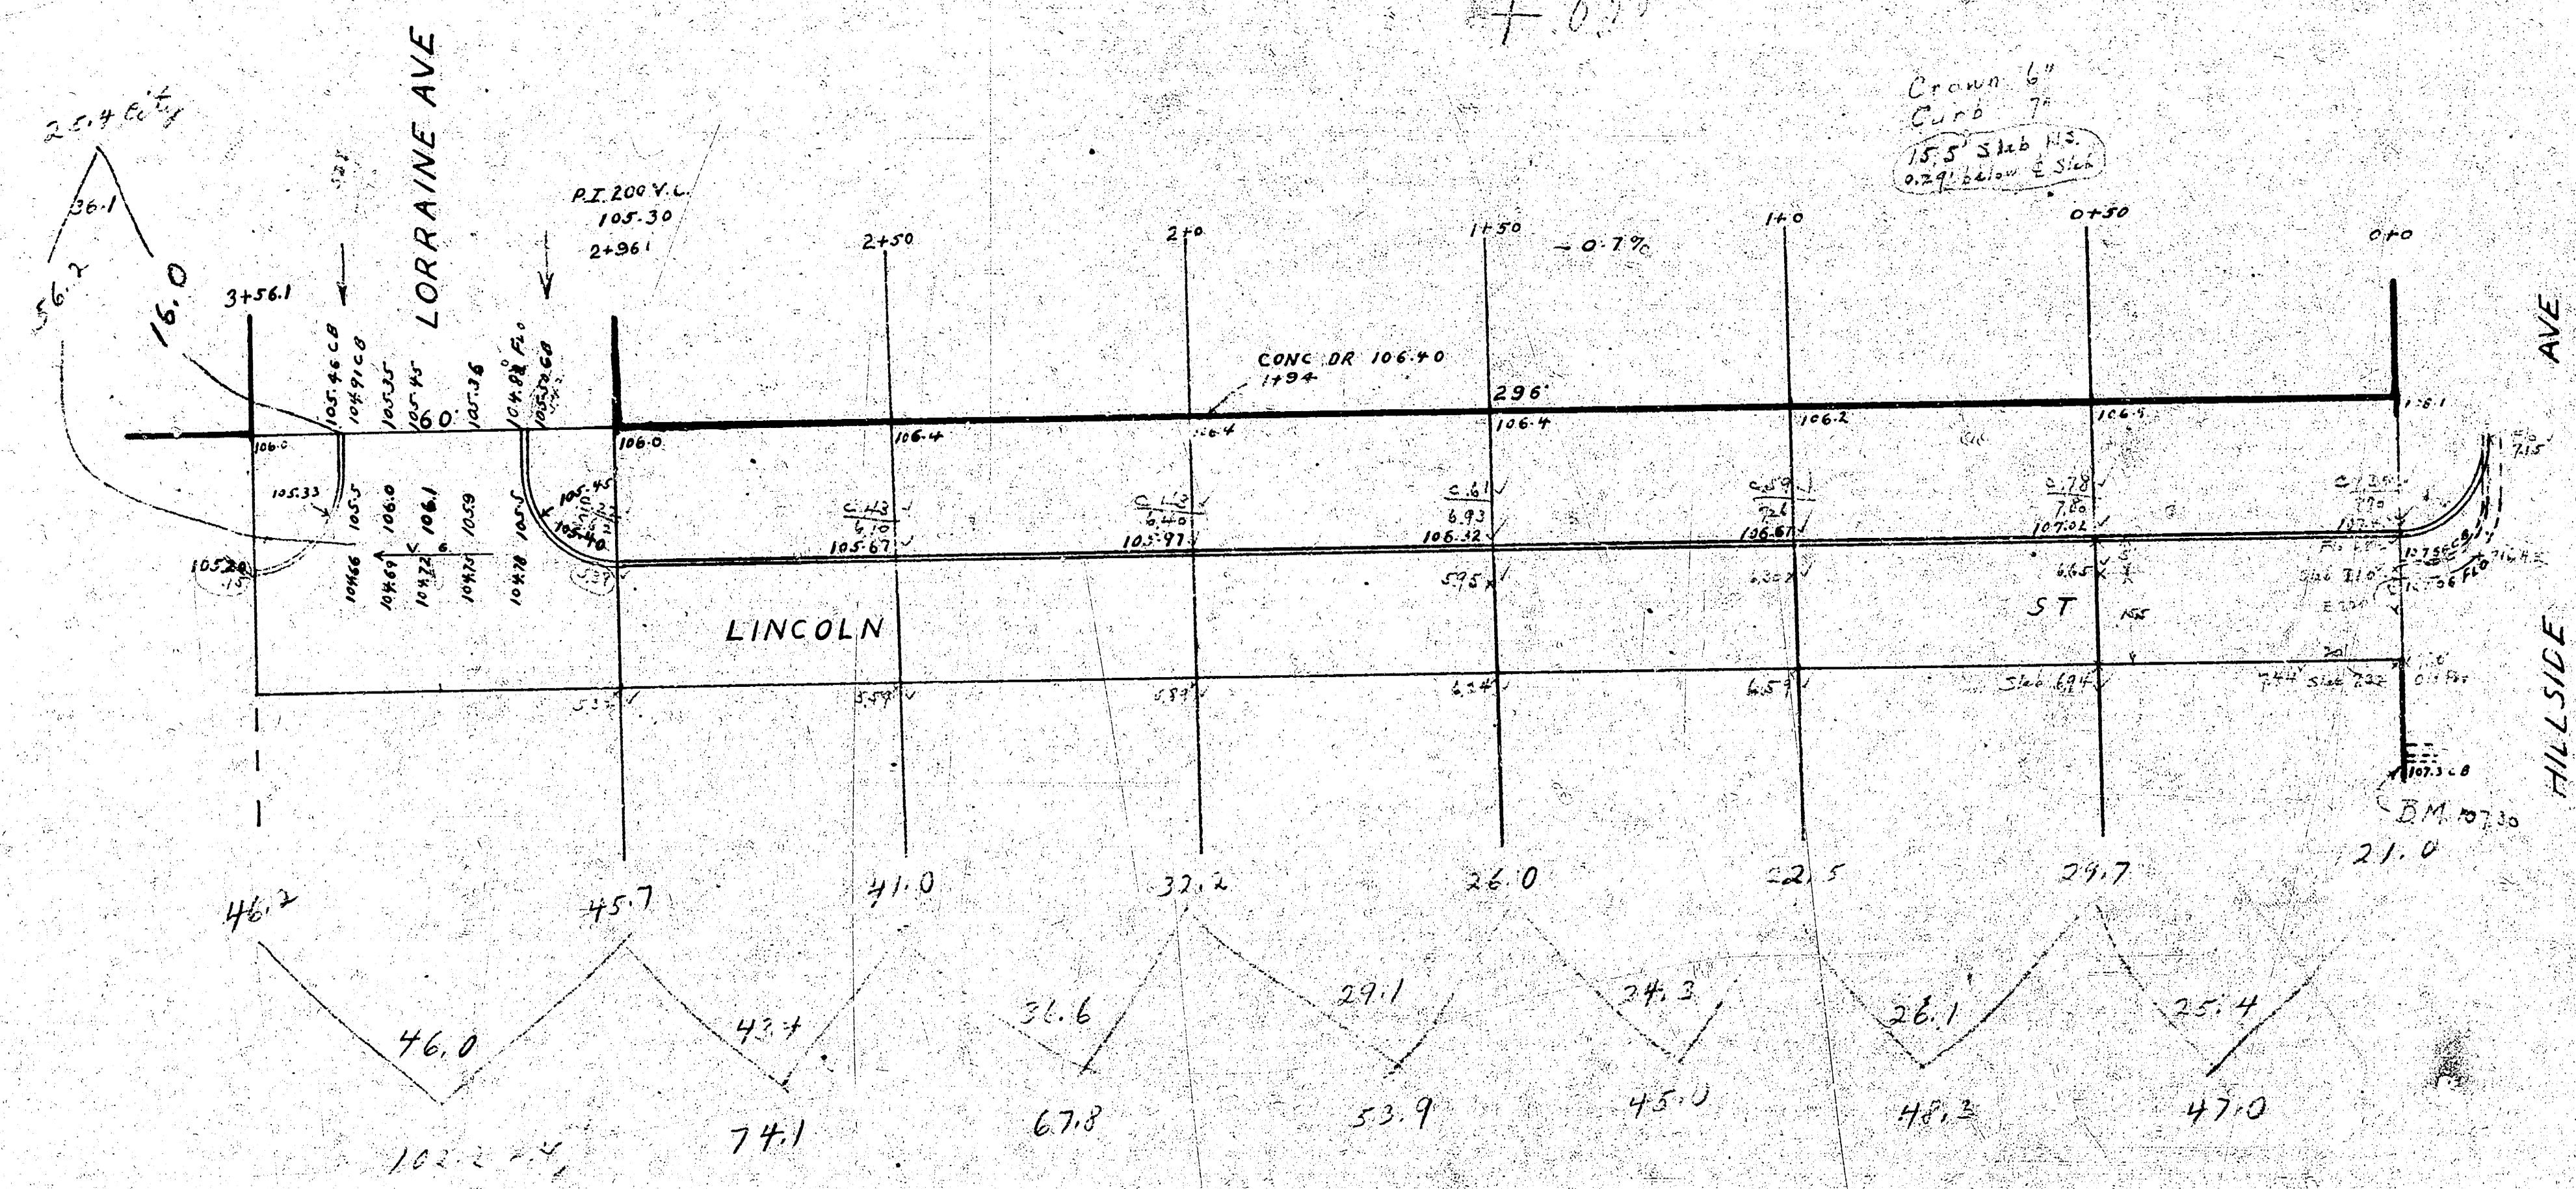

47.0	13.0
48.3	13.0
45.0	13.0
53.9	13.0
67.8	13.0
74.1	13.0
336.1	142.7
11.7	6
36.7	

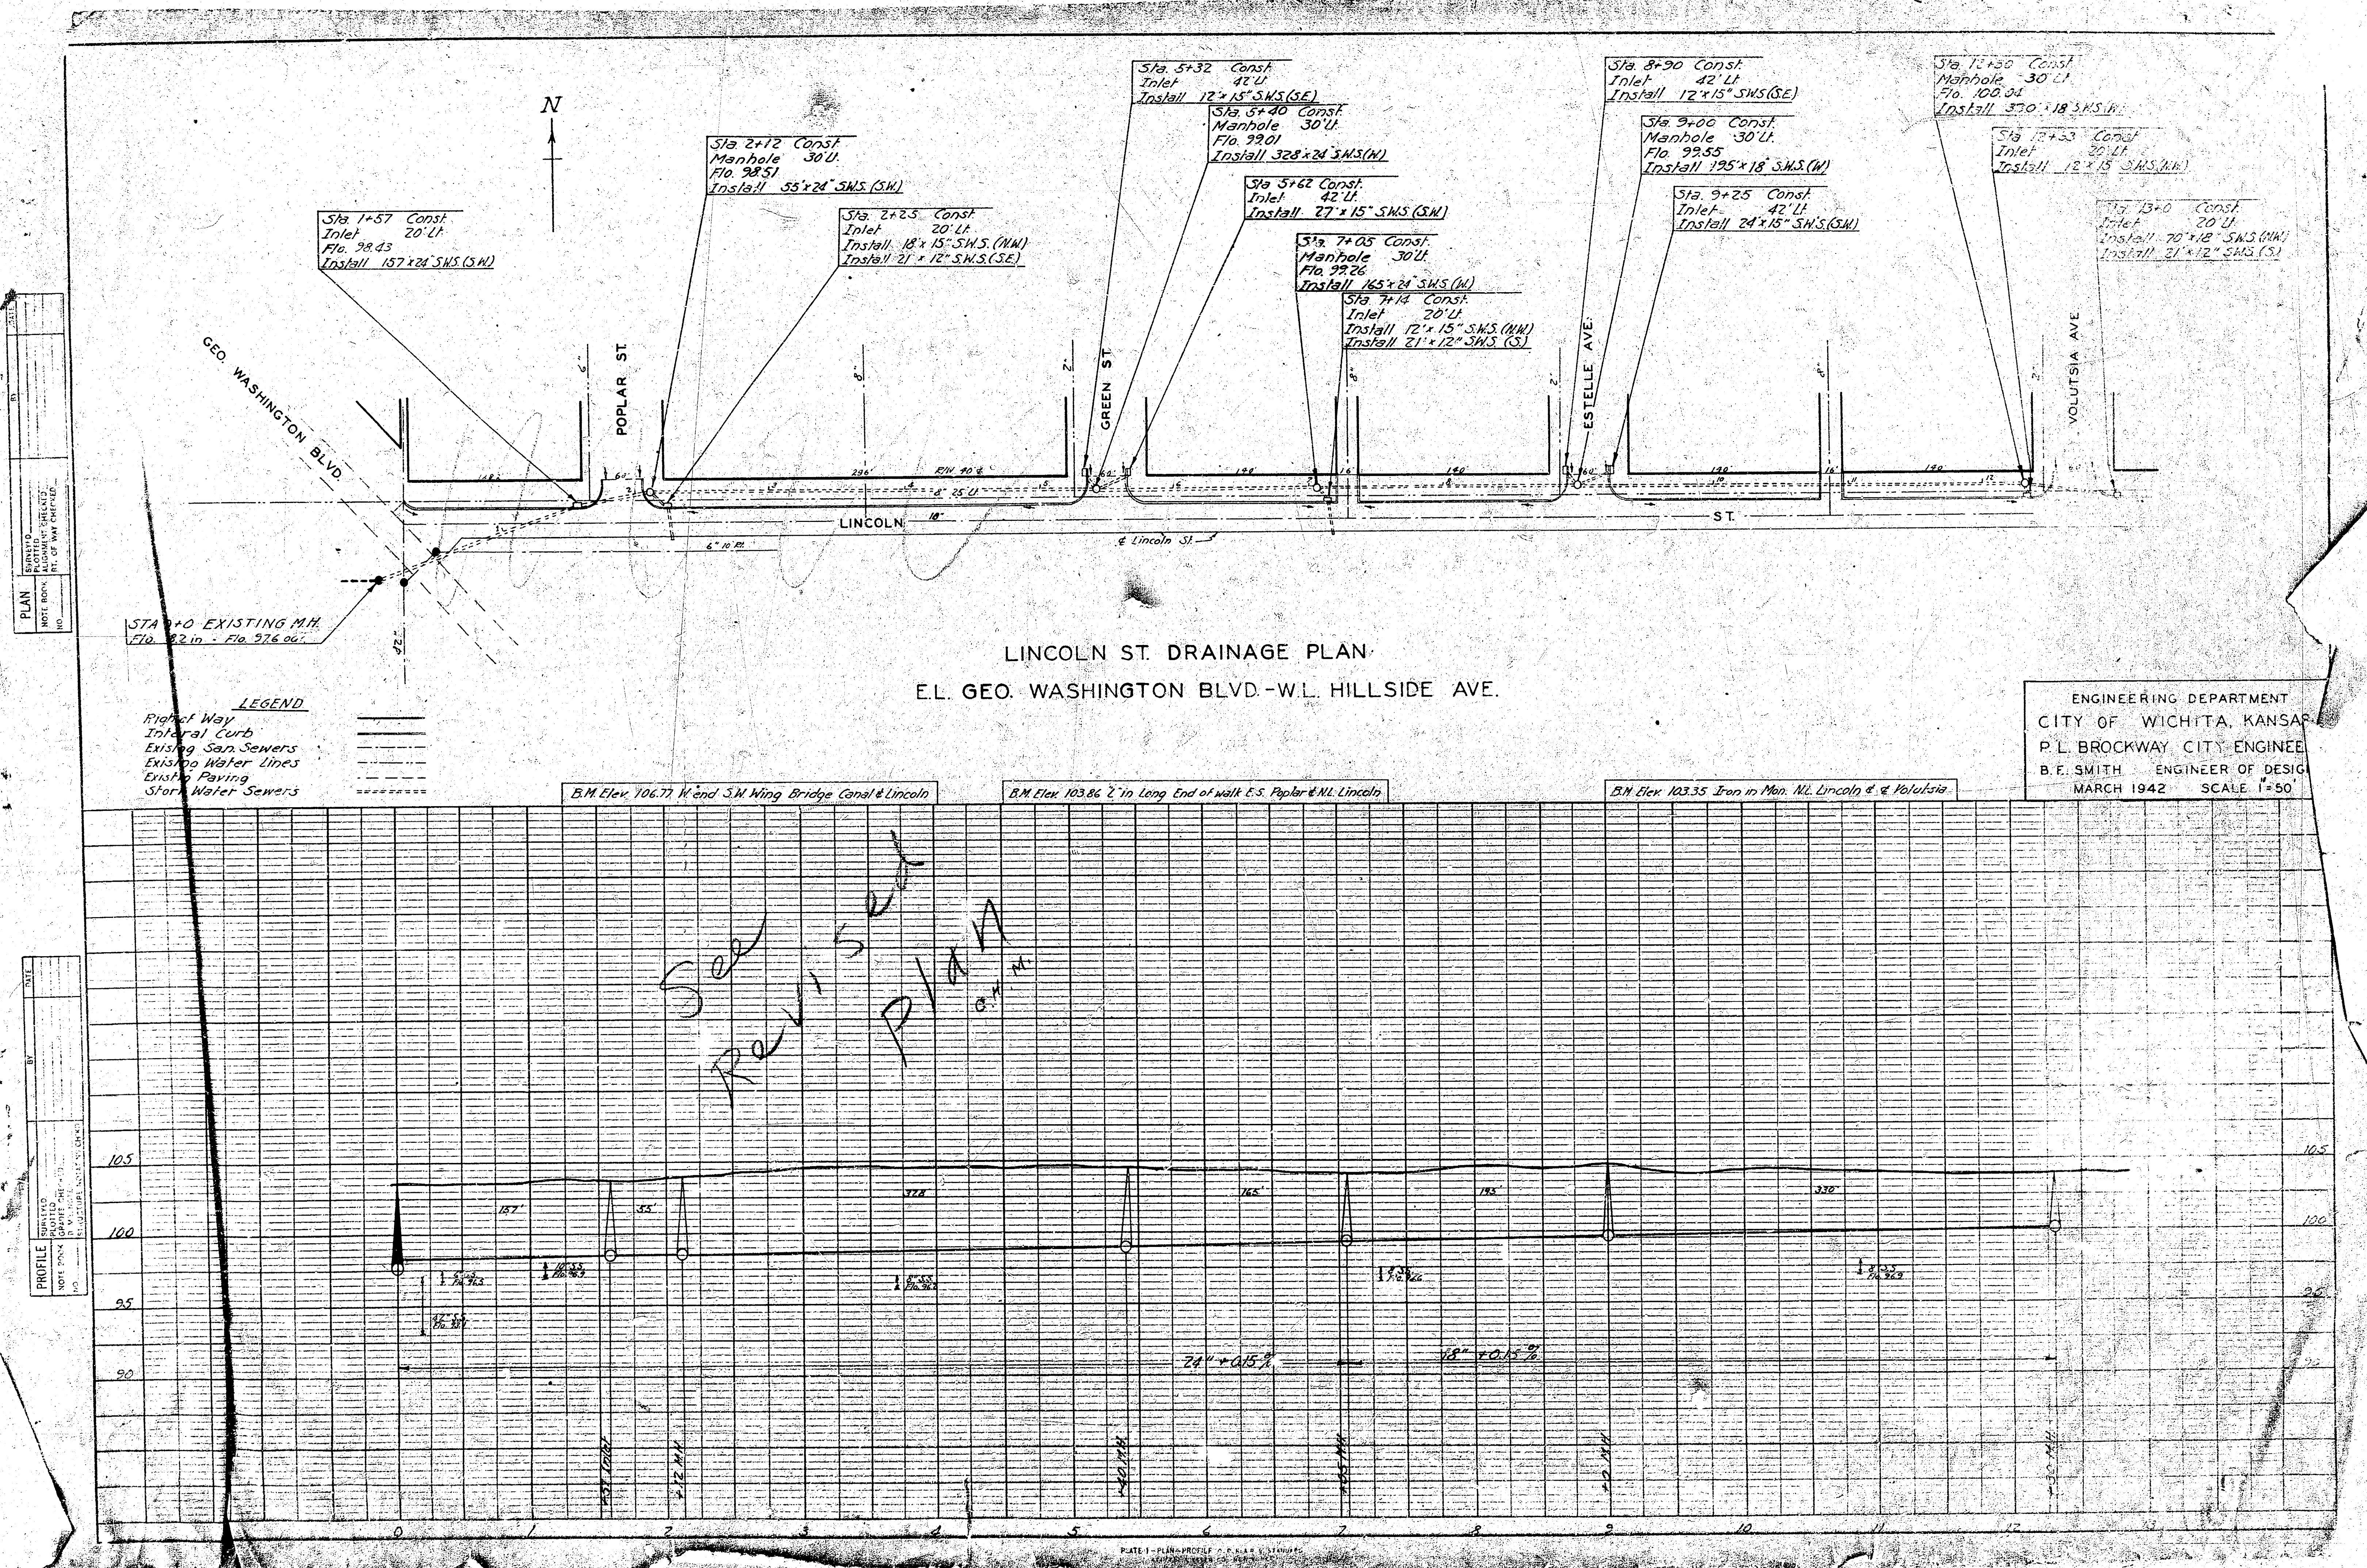

See Revised Plan