




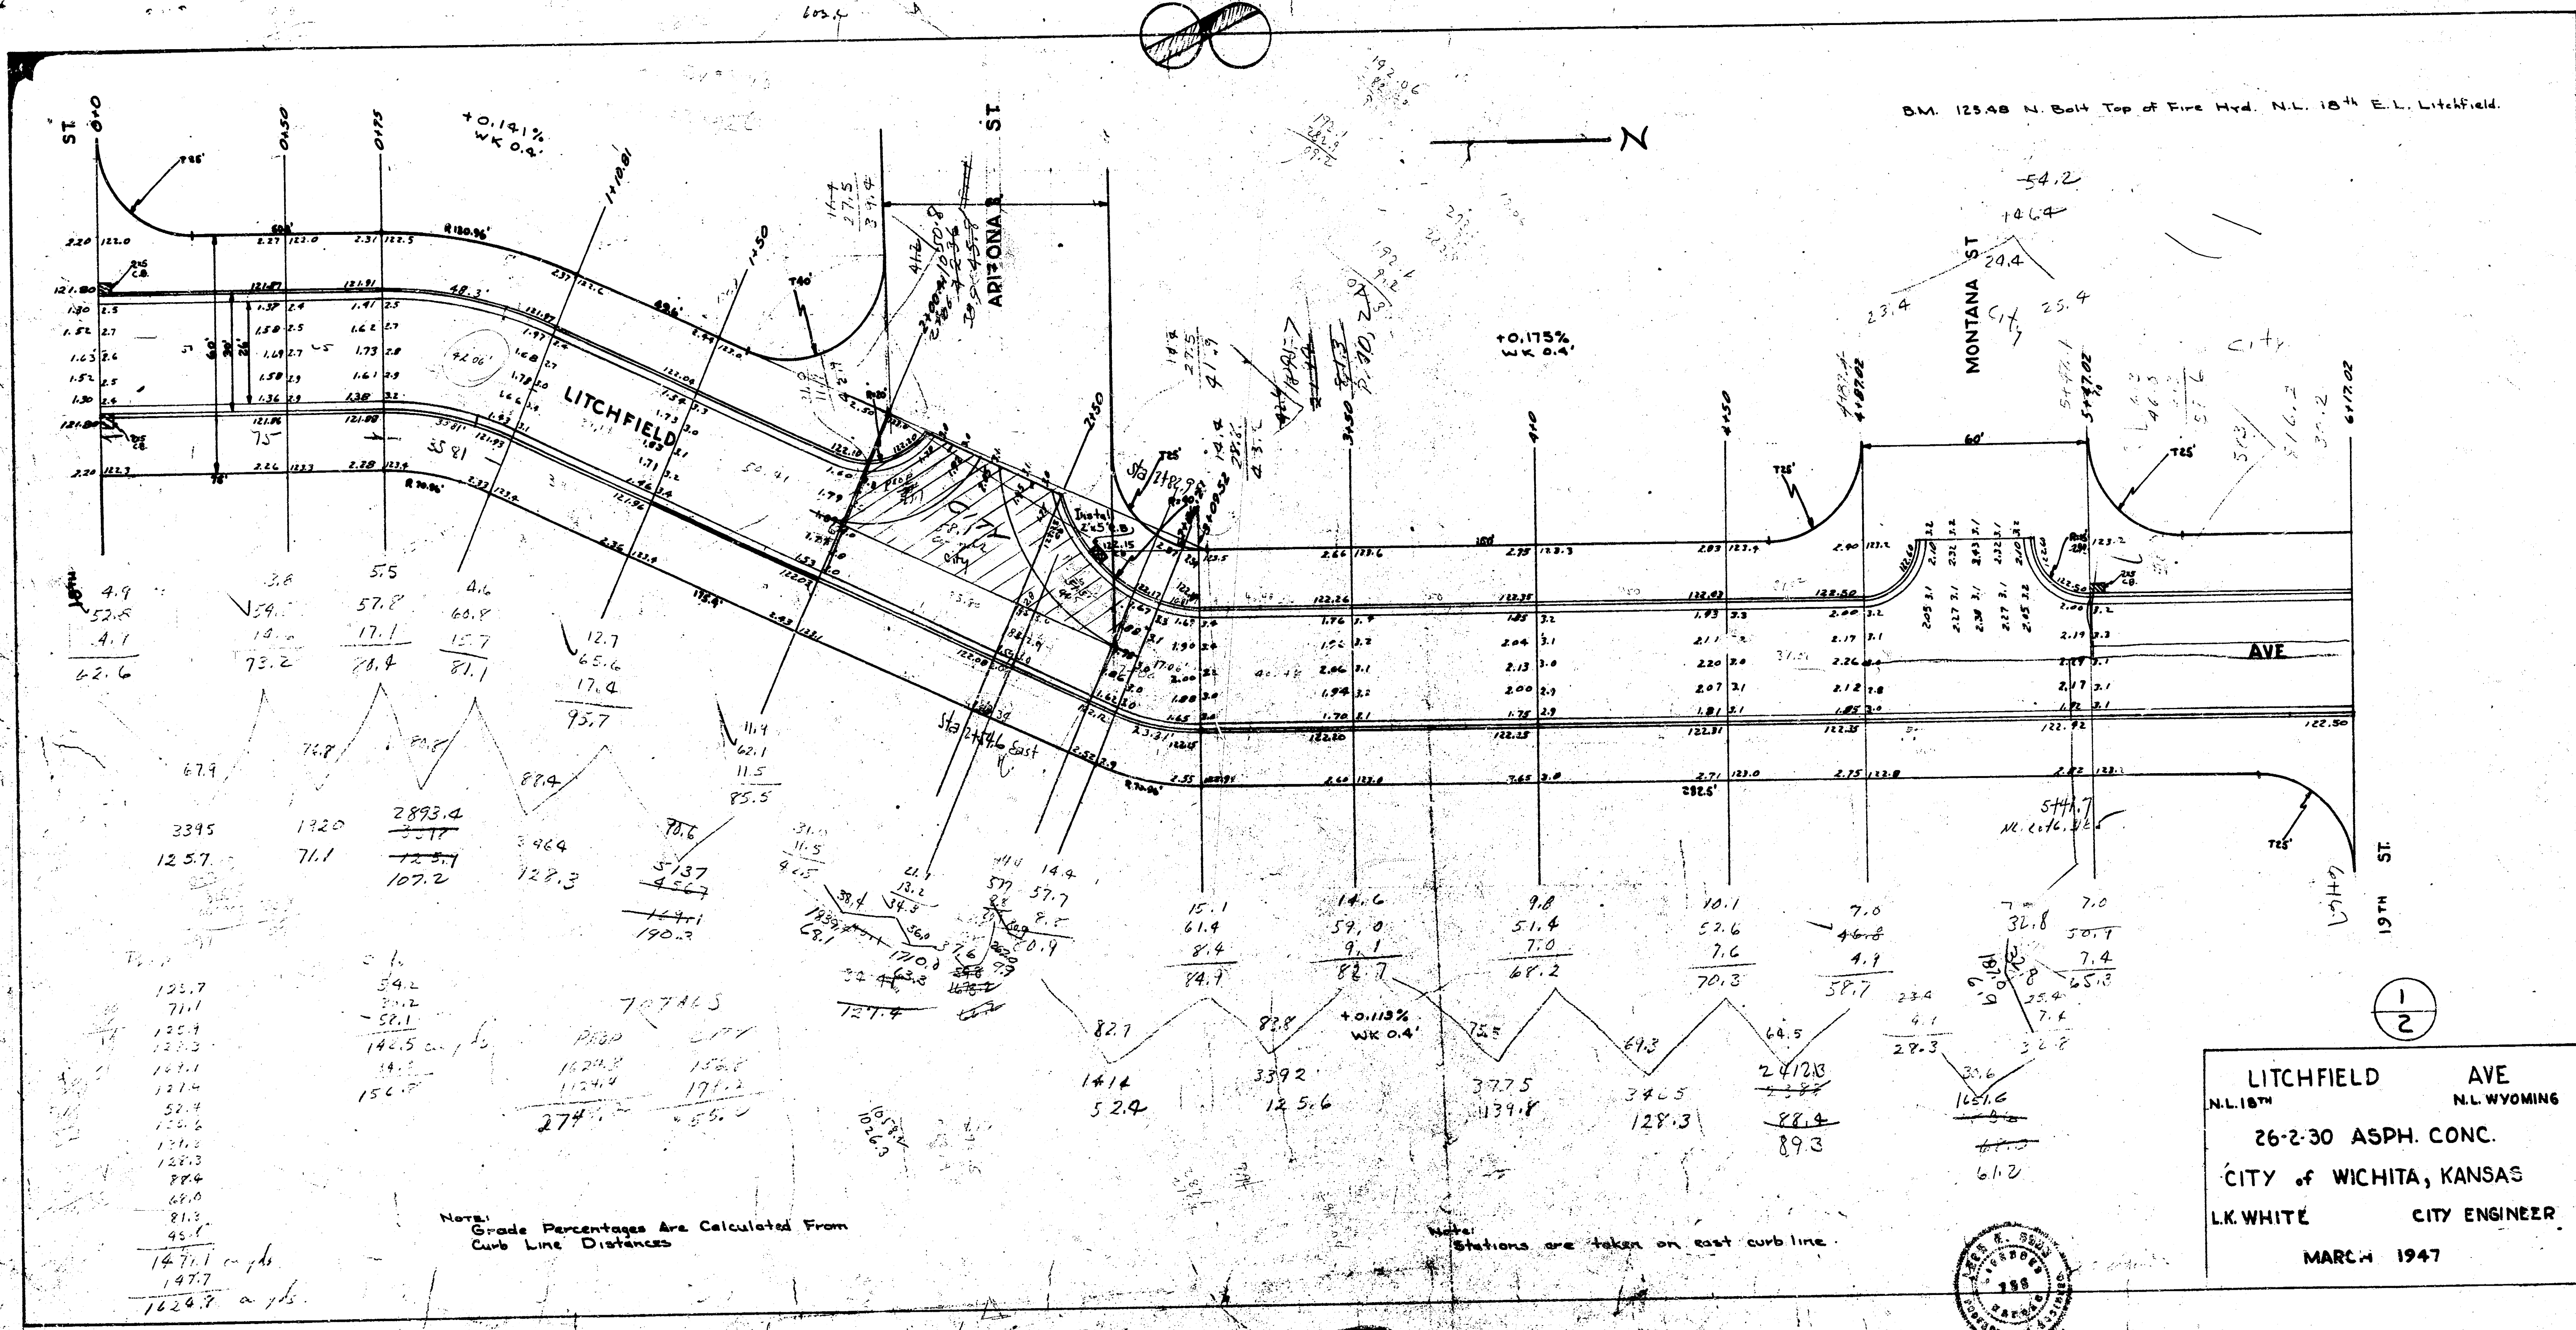


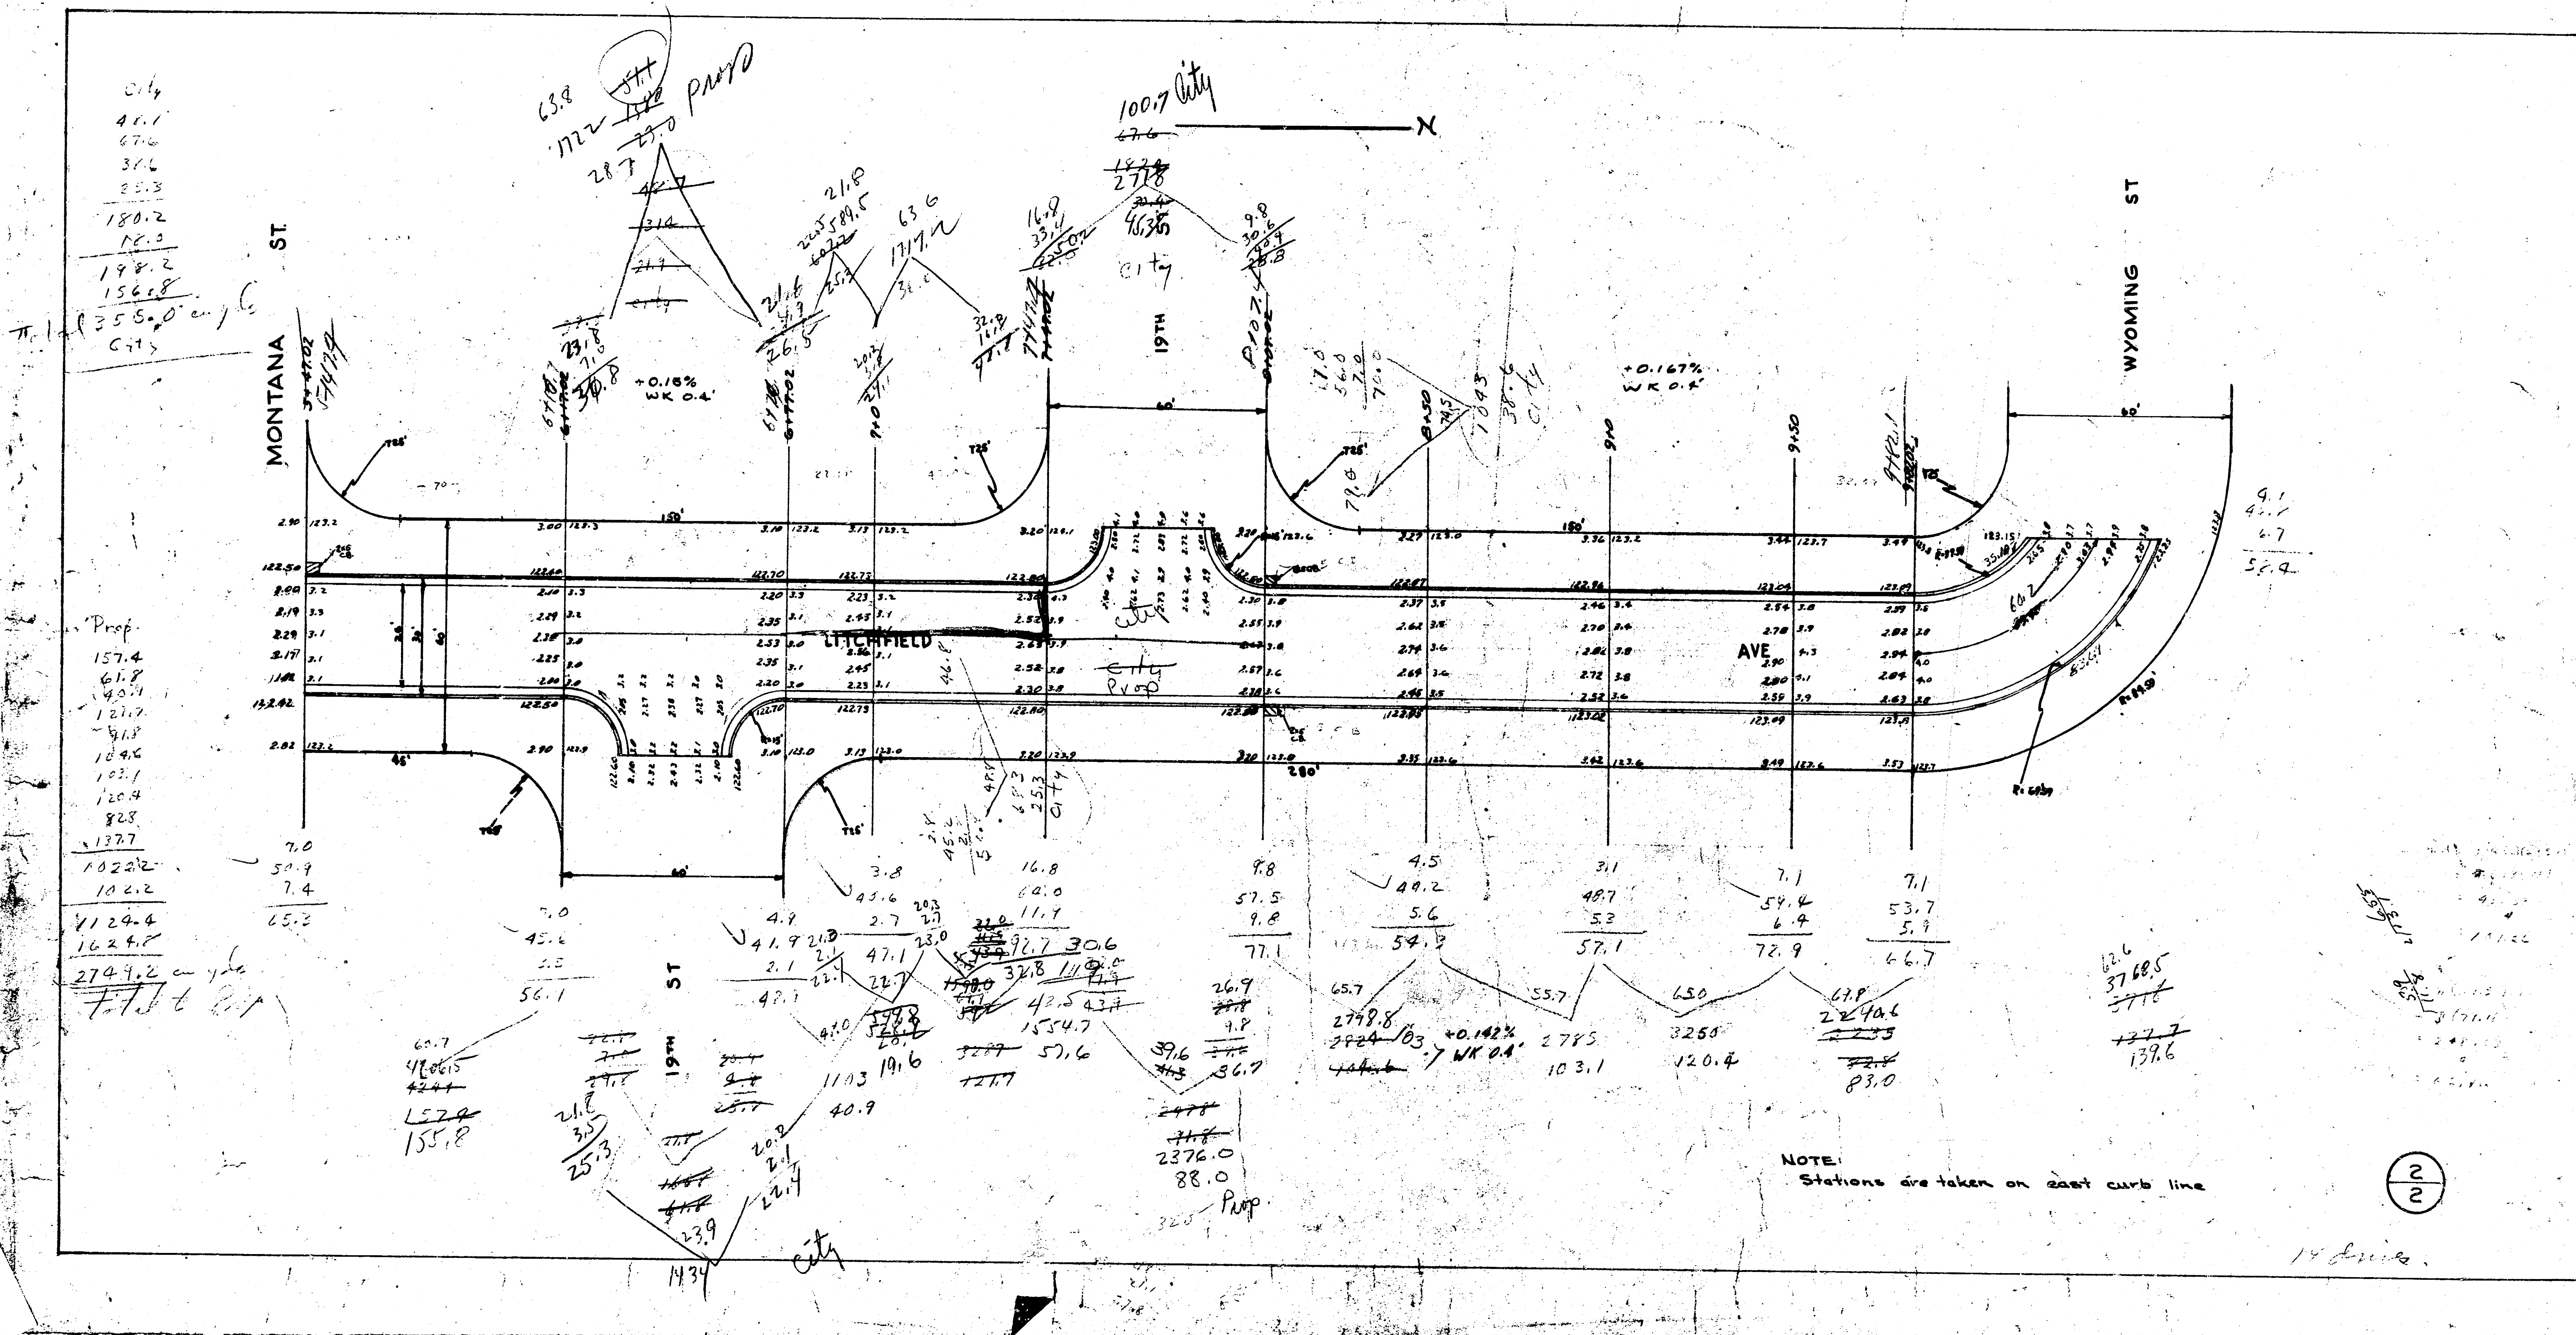

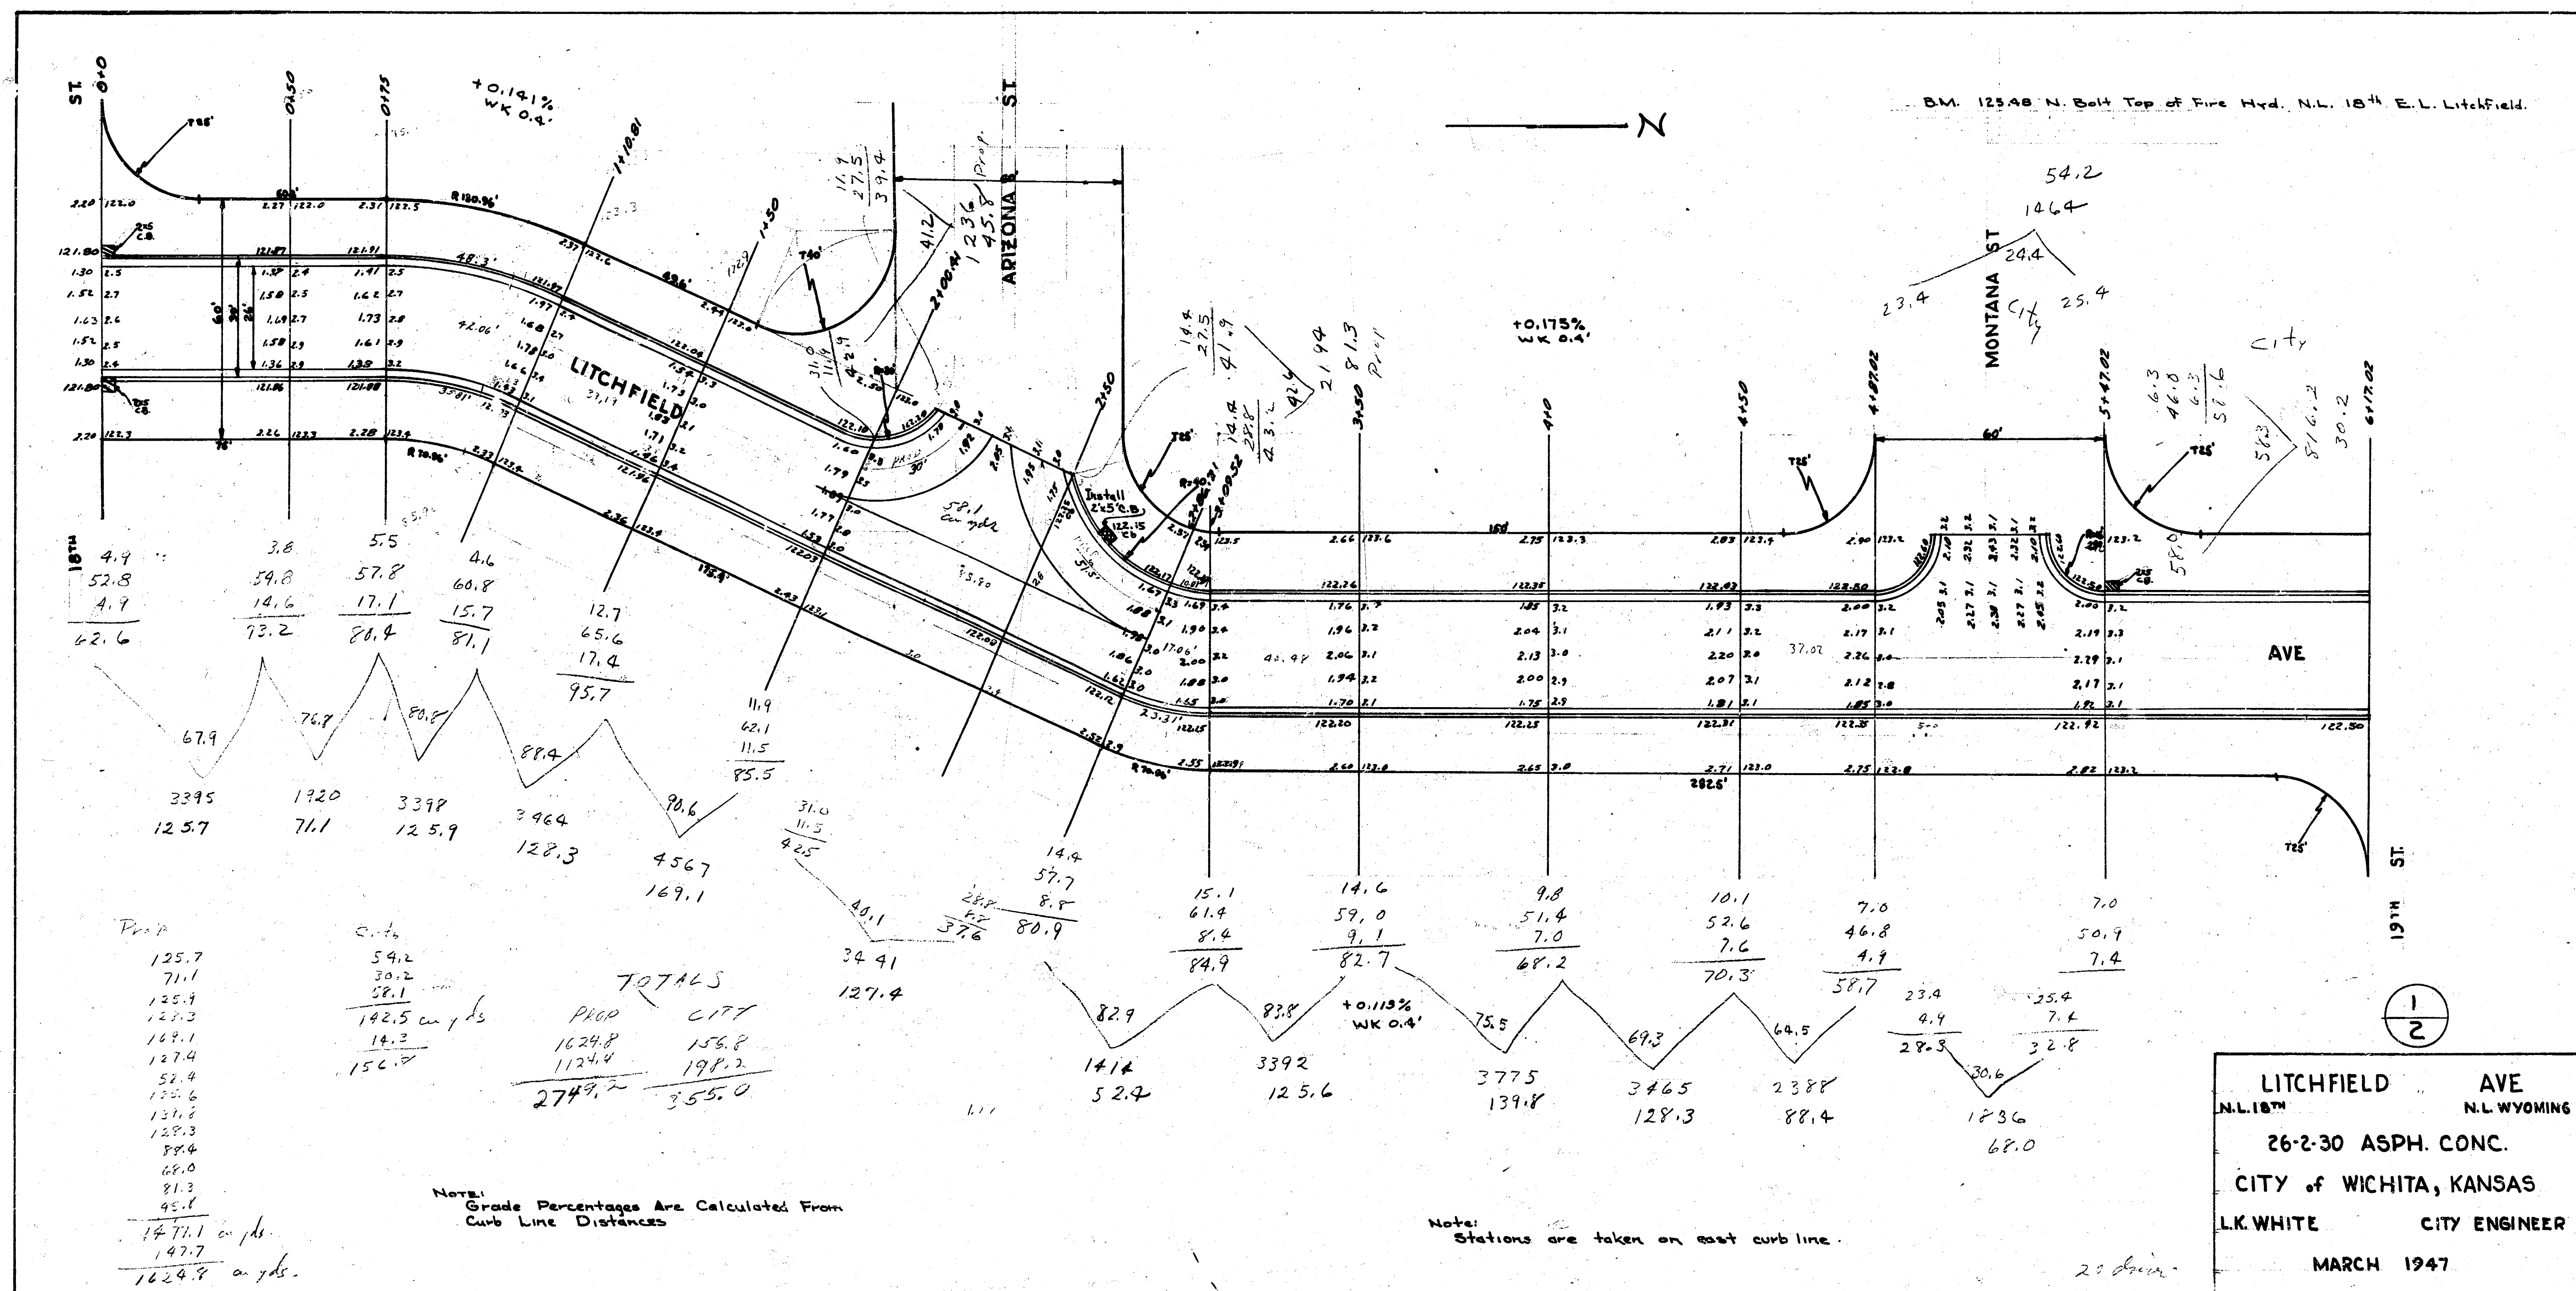

City
 48.7
 67.6
 37.6
 25.3
 180.2
 18.0
 198.2
 156.8
 Total 355.0 encls
 City

Prop.
 157.4
 61.8
 40.9
 121.7
 91.8
 104.6
 103.1
 120.4
 82.8
 137.7
 102.2
 102.2
 112.4
 162.8
 274.2 encls
 Total to Prop

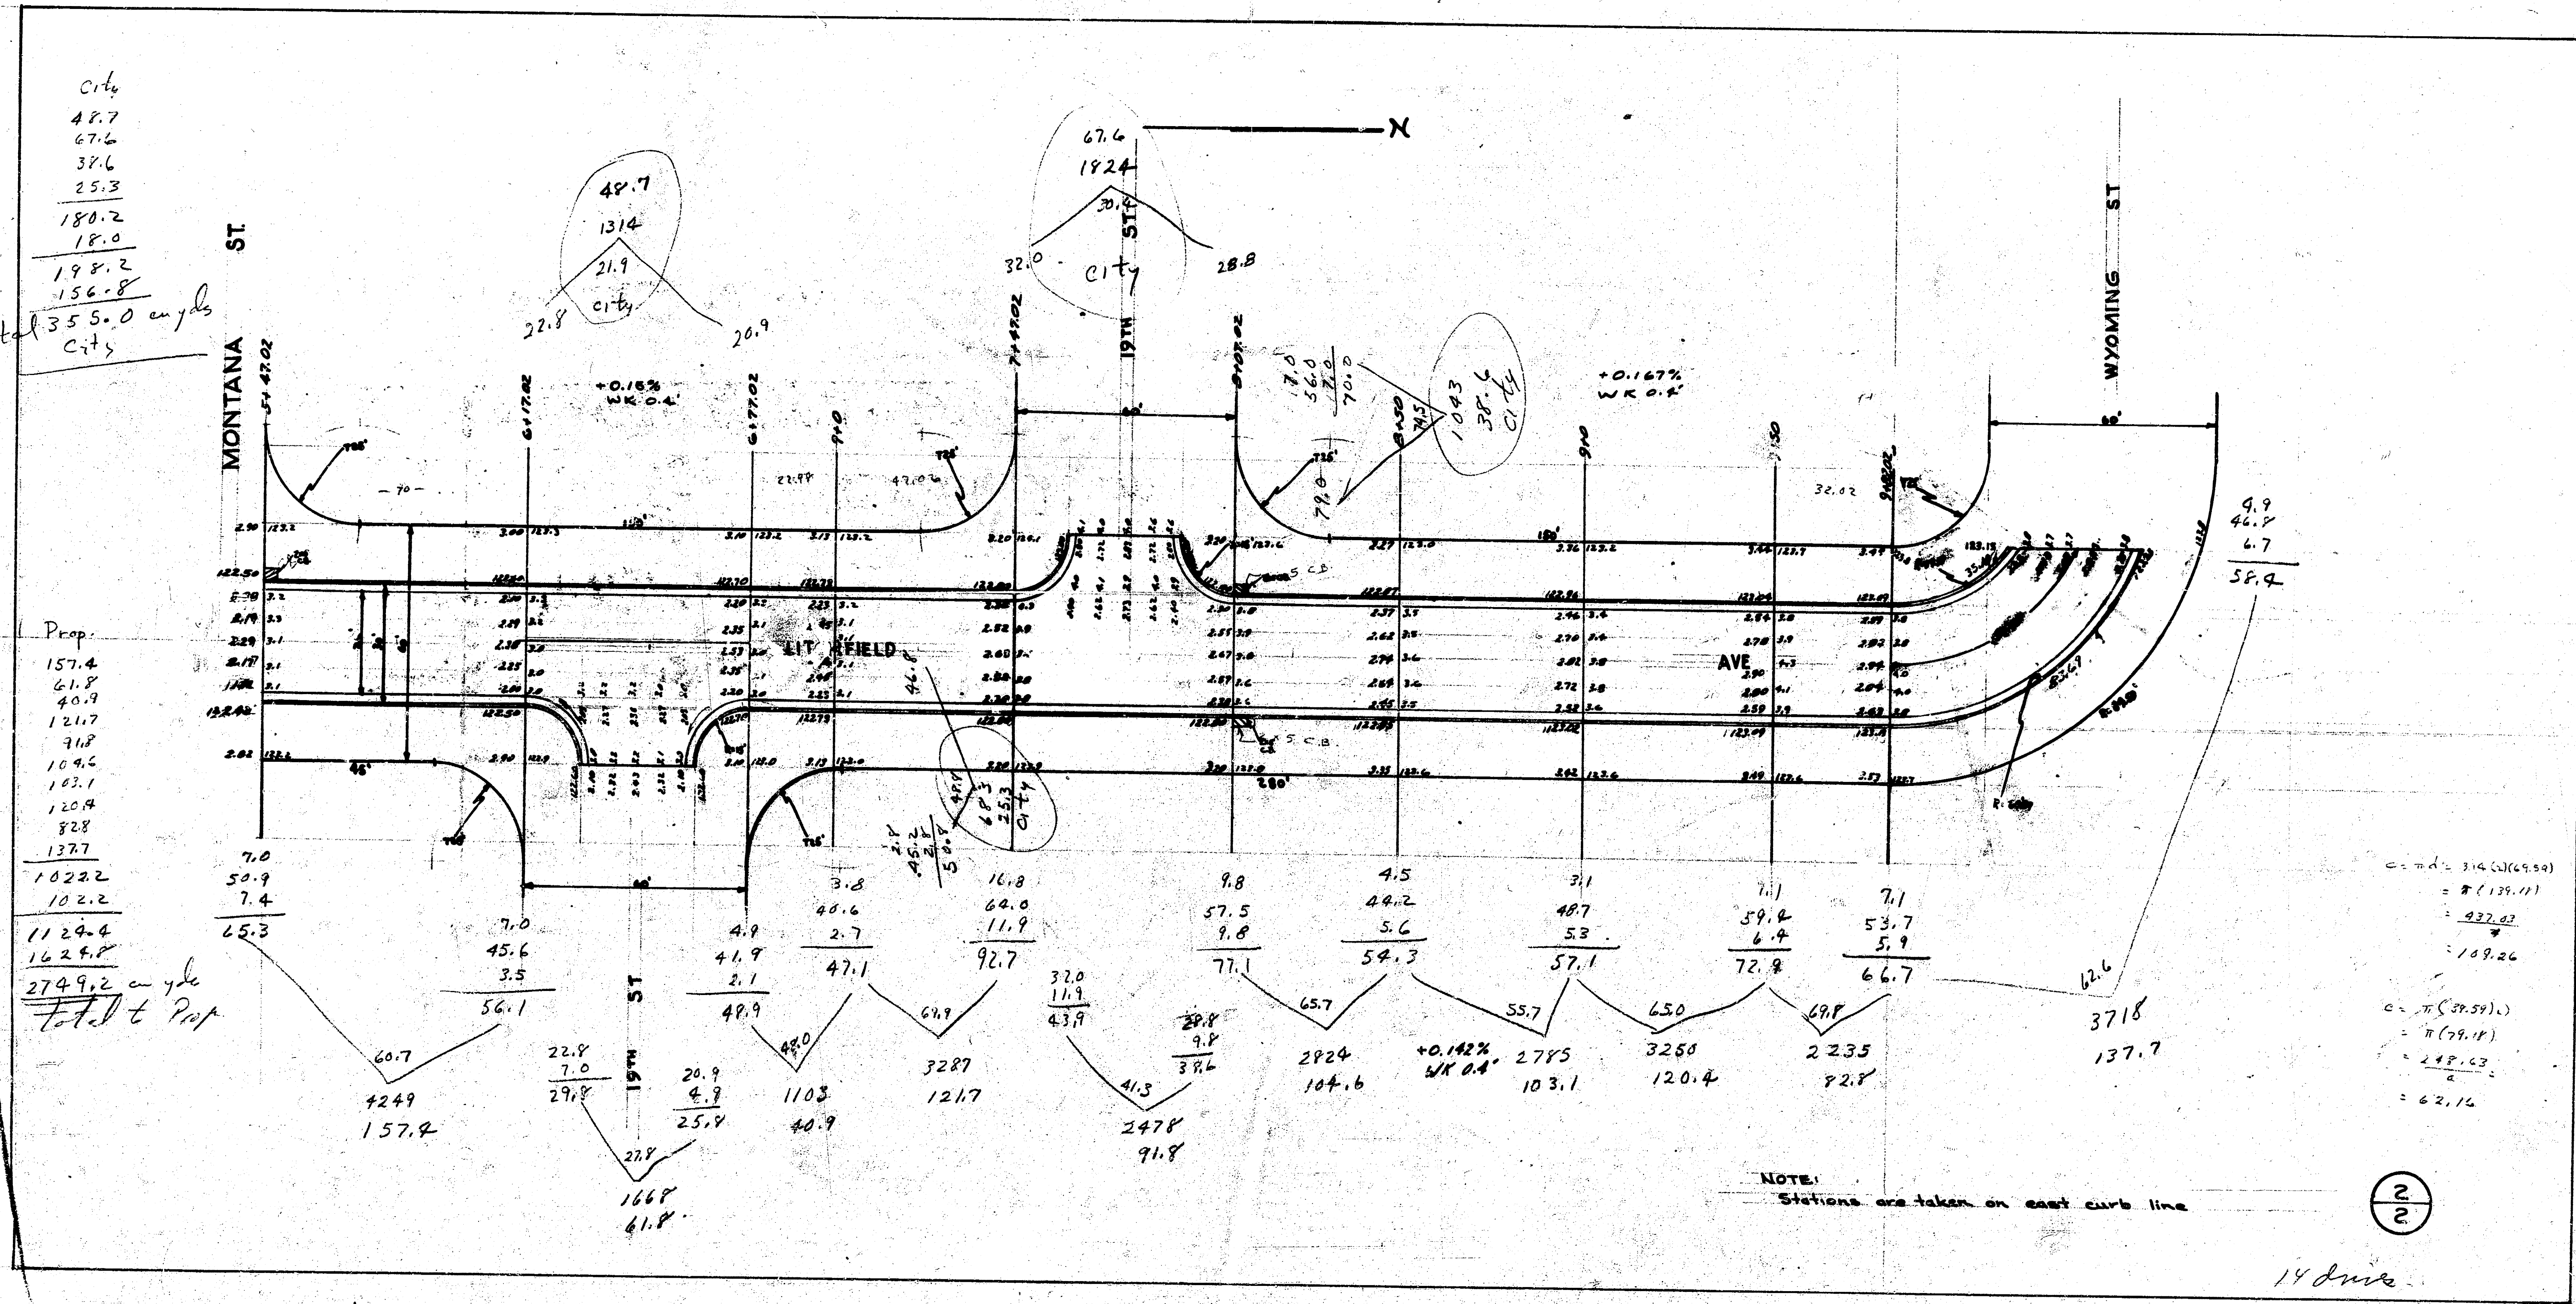

$C = \pi \cdot d = 3.14 \cdot (49.59)$
 $= 155.71$
 $C = \pi \cdot (29.59)$
 $= 93.71$

NOTE:
 Stations are taken on east curb line

2
2

18 drive