
BM 103.92 "X" on top of Rnd. 2' SE of SW cb cor. Indianapolis & Ellis

Iron W.side old 16' Alley SL Lot 1
35.19' NW to SE Cor Green Cinder Brick Duplex
54.95' SE to SW Cor. Wood Garage
46.26' NE to Ctr. nail of 3 nails East side Osage tree

Iron E.Side Luel SL Lot 1
37.49' NE to Ctr Nail of 3 Nails E. side of Osage tree
40.00' SE to SW Cor of Wood Garage
50.82' NW to SE Cor. Green Cinder Brick Duplex

Exc.
20.2
26.5
39.1
56.9
36.6
179.3 cu. YDS

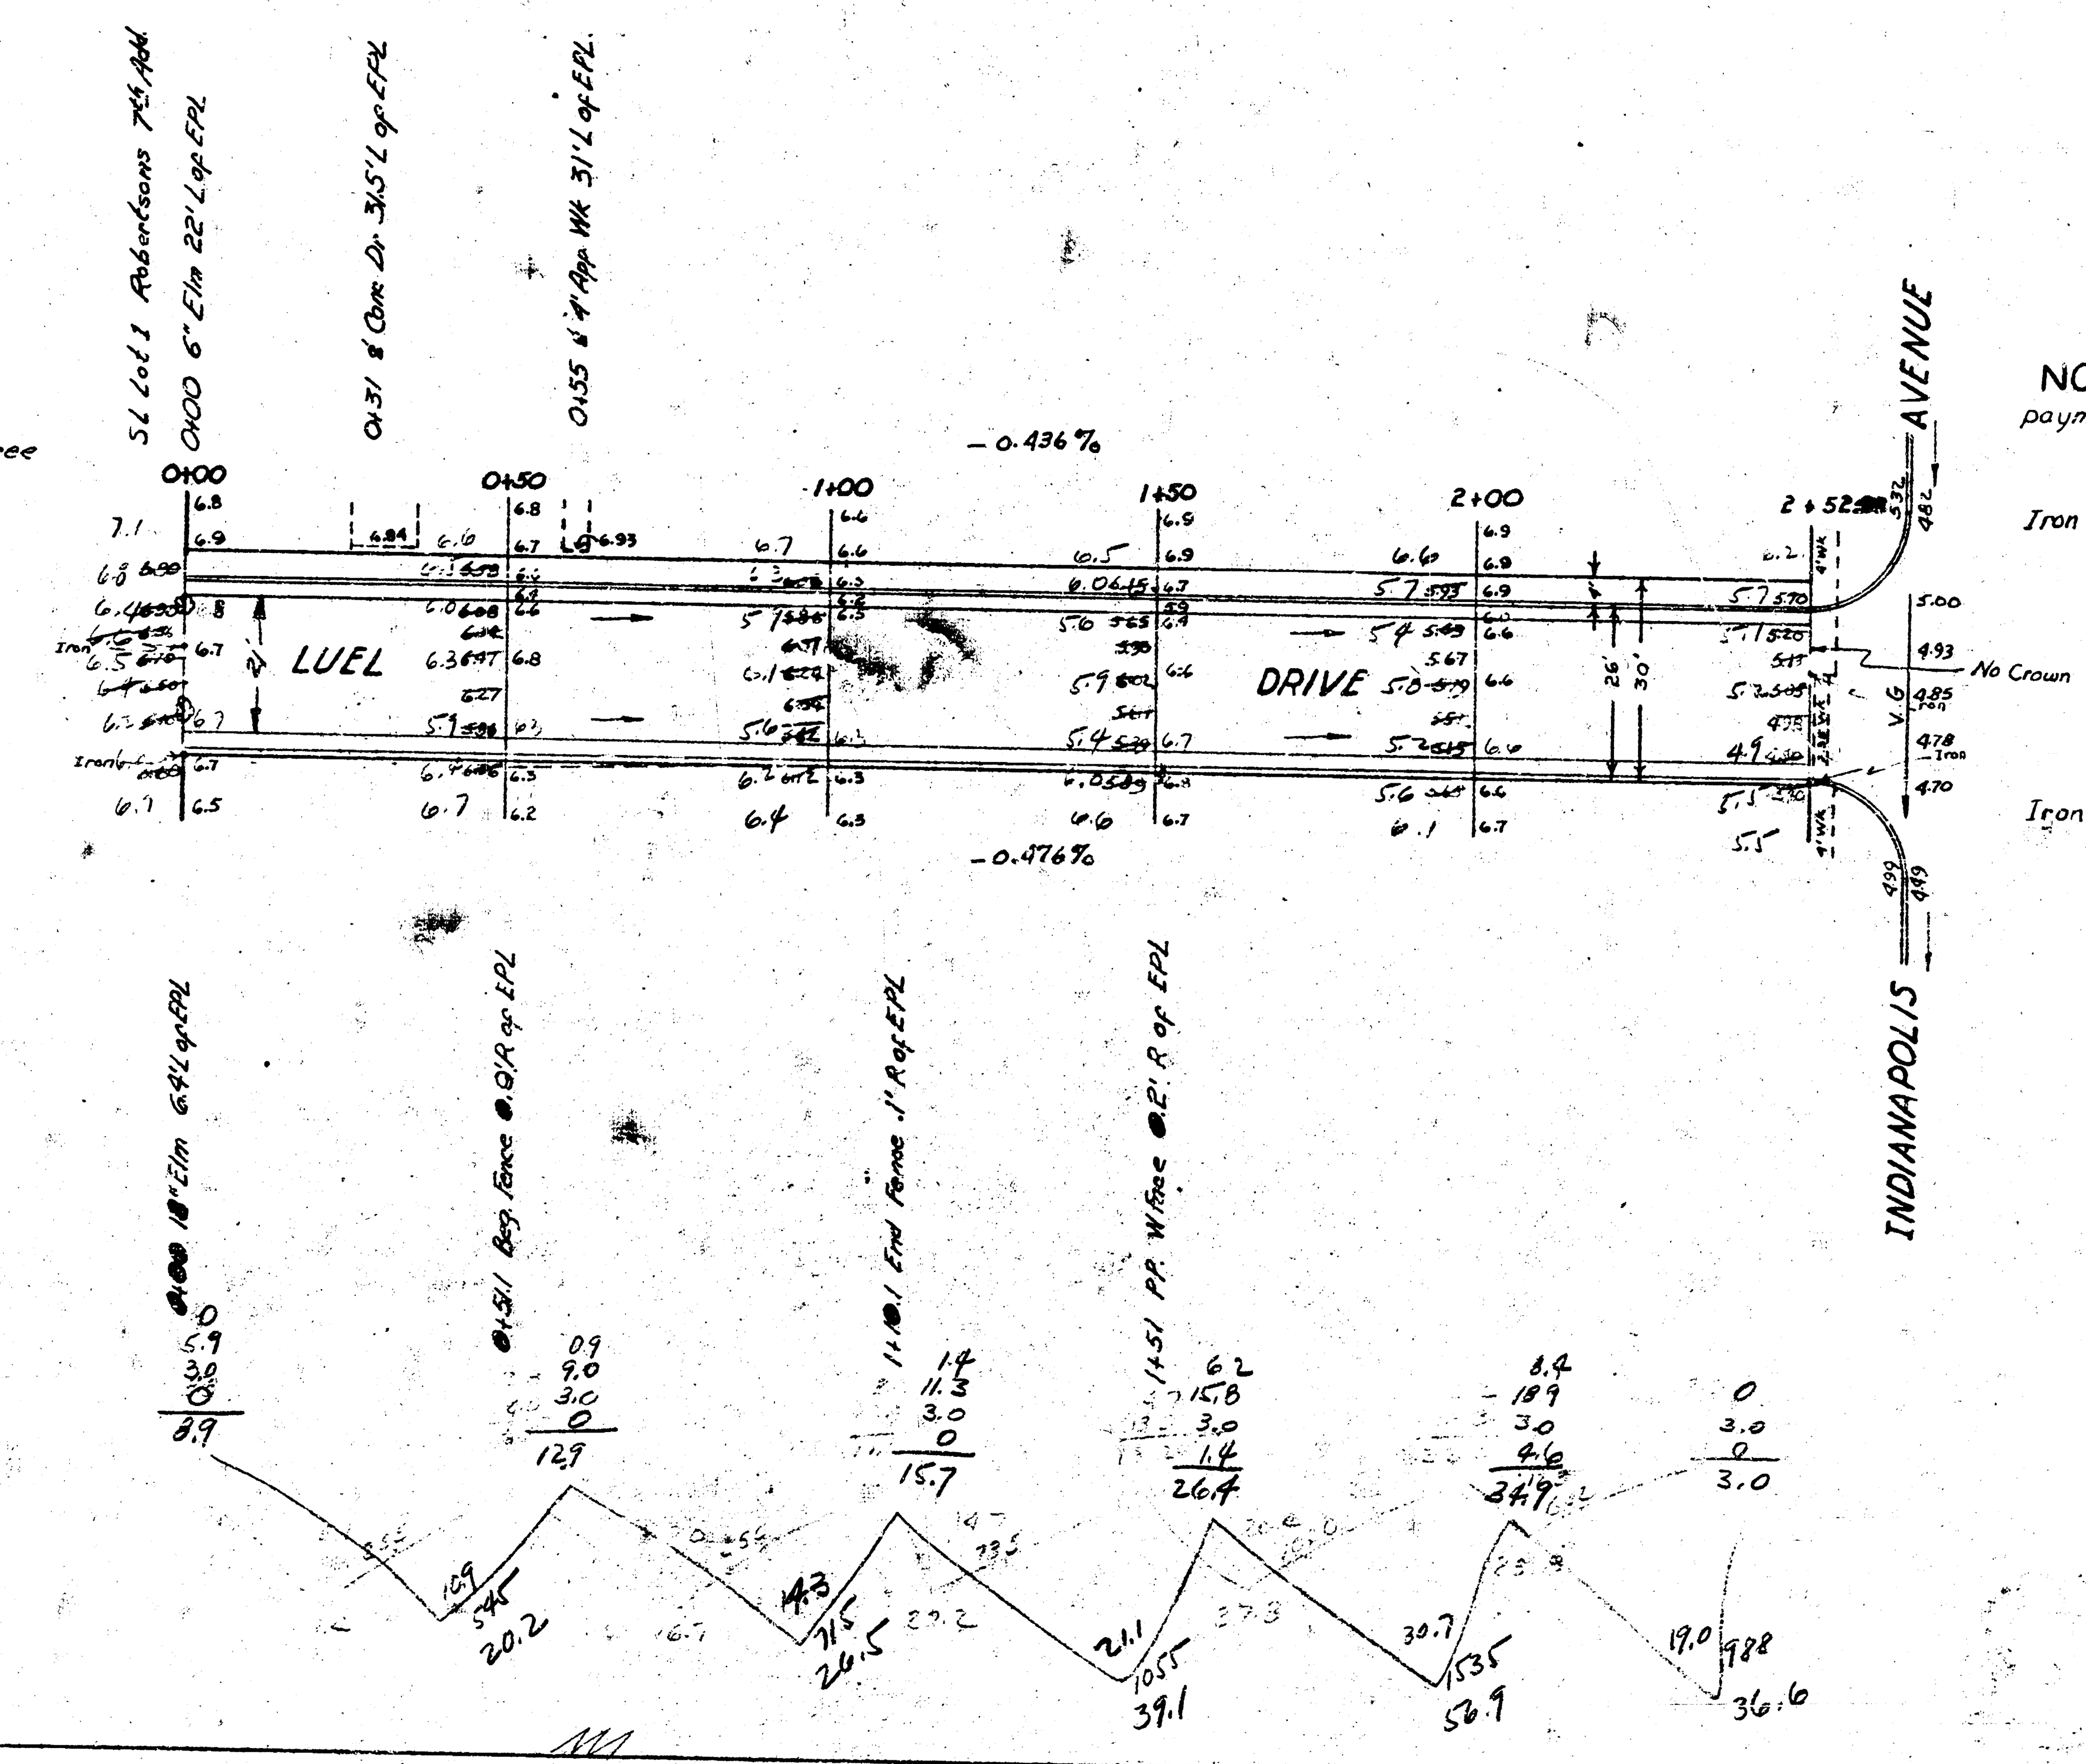

NOTE Intersection to be constructed and payment made on Proj. No. C 10-71.

Iron W side old 16' Alley & SL Indianapolis
44' W to NE cor 1st step App. Wk. #1421 Indianapolis
31.87' SE to SW cor. conc. porch
25.43 E to "X" ctr. wk. S.S. Indianapolis

Iron E side Luel, SL Indianapolis
21.87' SE to SW cor. conc. Back por. of Duplex
9.50' to "X" Ctr of Wk.
60.05' W to NE Cor. 1st Step App. Wk #1421 Indianapolis

LUEL DRIVE

SL Lot 1 Robertsons 7th - SL Indianapolis

Comb. Cb and G.

City of Wichita Kansas

LK White City Engineer

Feb, 1951 Proj. No. C10-218

B.M. 103.92 "X" on top of Rod. 2' SE of SW ob cor. Indianapolis & Ellis

Excavation —
Property - 92
167
272
378
282
1149
+10% 115
1264 cu yds

Iron W.side old 16' Alley SL Lot 1
35.19' NW to SE Cor Green Cinder Brick Duplex
39.95' SE to SW Cor. Wood Garage
46.26' NE to Ctr nail of 3 nails East side Osage tree


Iron E.Side Luel SL Lot 1
37.79' NE to Ctr. Nail of 3 Nails E. side of Osage tree
40.00' SE to SW Cor of Wood Garage
30.92' NW to SE Cor. Green Cinder Brick Duplex

N

NOTE: Intersection to be constructed and payment made on Proj. No. C10-71.

Iron W side old 16' Alley & SL Indianapolis
44' W to NE cor 1st Step App. Wk. "1421 Indianapolis
31.87' SE to SW cor. conc. porch
25.43' E to "X" ctr. wk. SS. Indianapolis

Iron E side Luel. SL Indianapolis
21.87' SE to SW cor. conc. Back por. of Duplex
9.50' to "X" Ctr of Wk.
60.05' W to NE Cor. 1st Step App. Wk "1421 Indianapolis

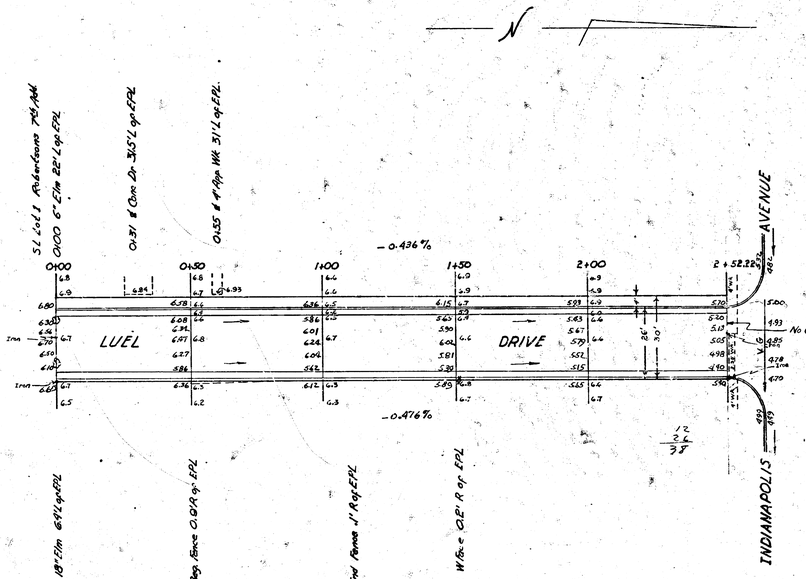

L. K. WHITE LICENSED 55 KANSAS PROFESSIONAL ENGINEER

8 dr

LUEL DRIVE
SL Lot 1 Robertsons 7th-SL Indianapolis
Comb. Cb. and G.
City of Wichita Kansas
LK White City Engineer
Feb, 1951 Proj. No. C10-218

18 8