


B.M. 154.44 NE Cor. Stone Slab on Brick Rail N.S. 16" 8802 Levitt
B.M. 151.68 SW Cor. Conc. Patch N.S. Levitt 15' W of E.L. Blackwell

FIELD ENGR. & CONTRACTOR NOTE
Spec. Drain Location

154.44 NE Cor. Stone Slab on Brick Rail N.S. 16" 8802 Levitt
151.68 SW Cor. Conc. Patch N.S. Levitt 15' W of E.L. Blackwell
154.44 NE Cor. Stone Slab on Brick Rail N.S. 16" 8802 Levitt
151.68 SW Cor. Conc. Patch N.S. Levitt 15' W of E.L. Blackwell

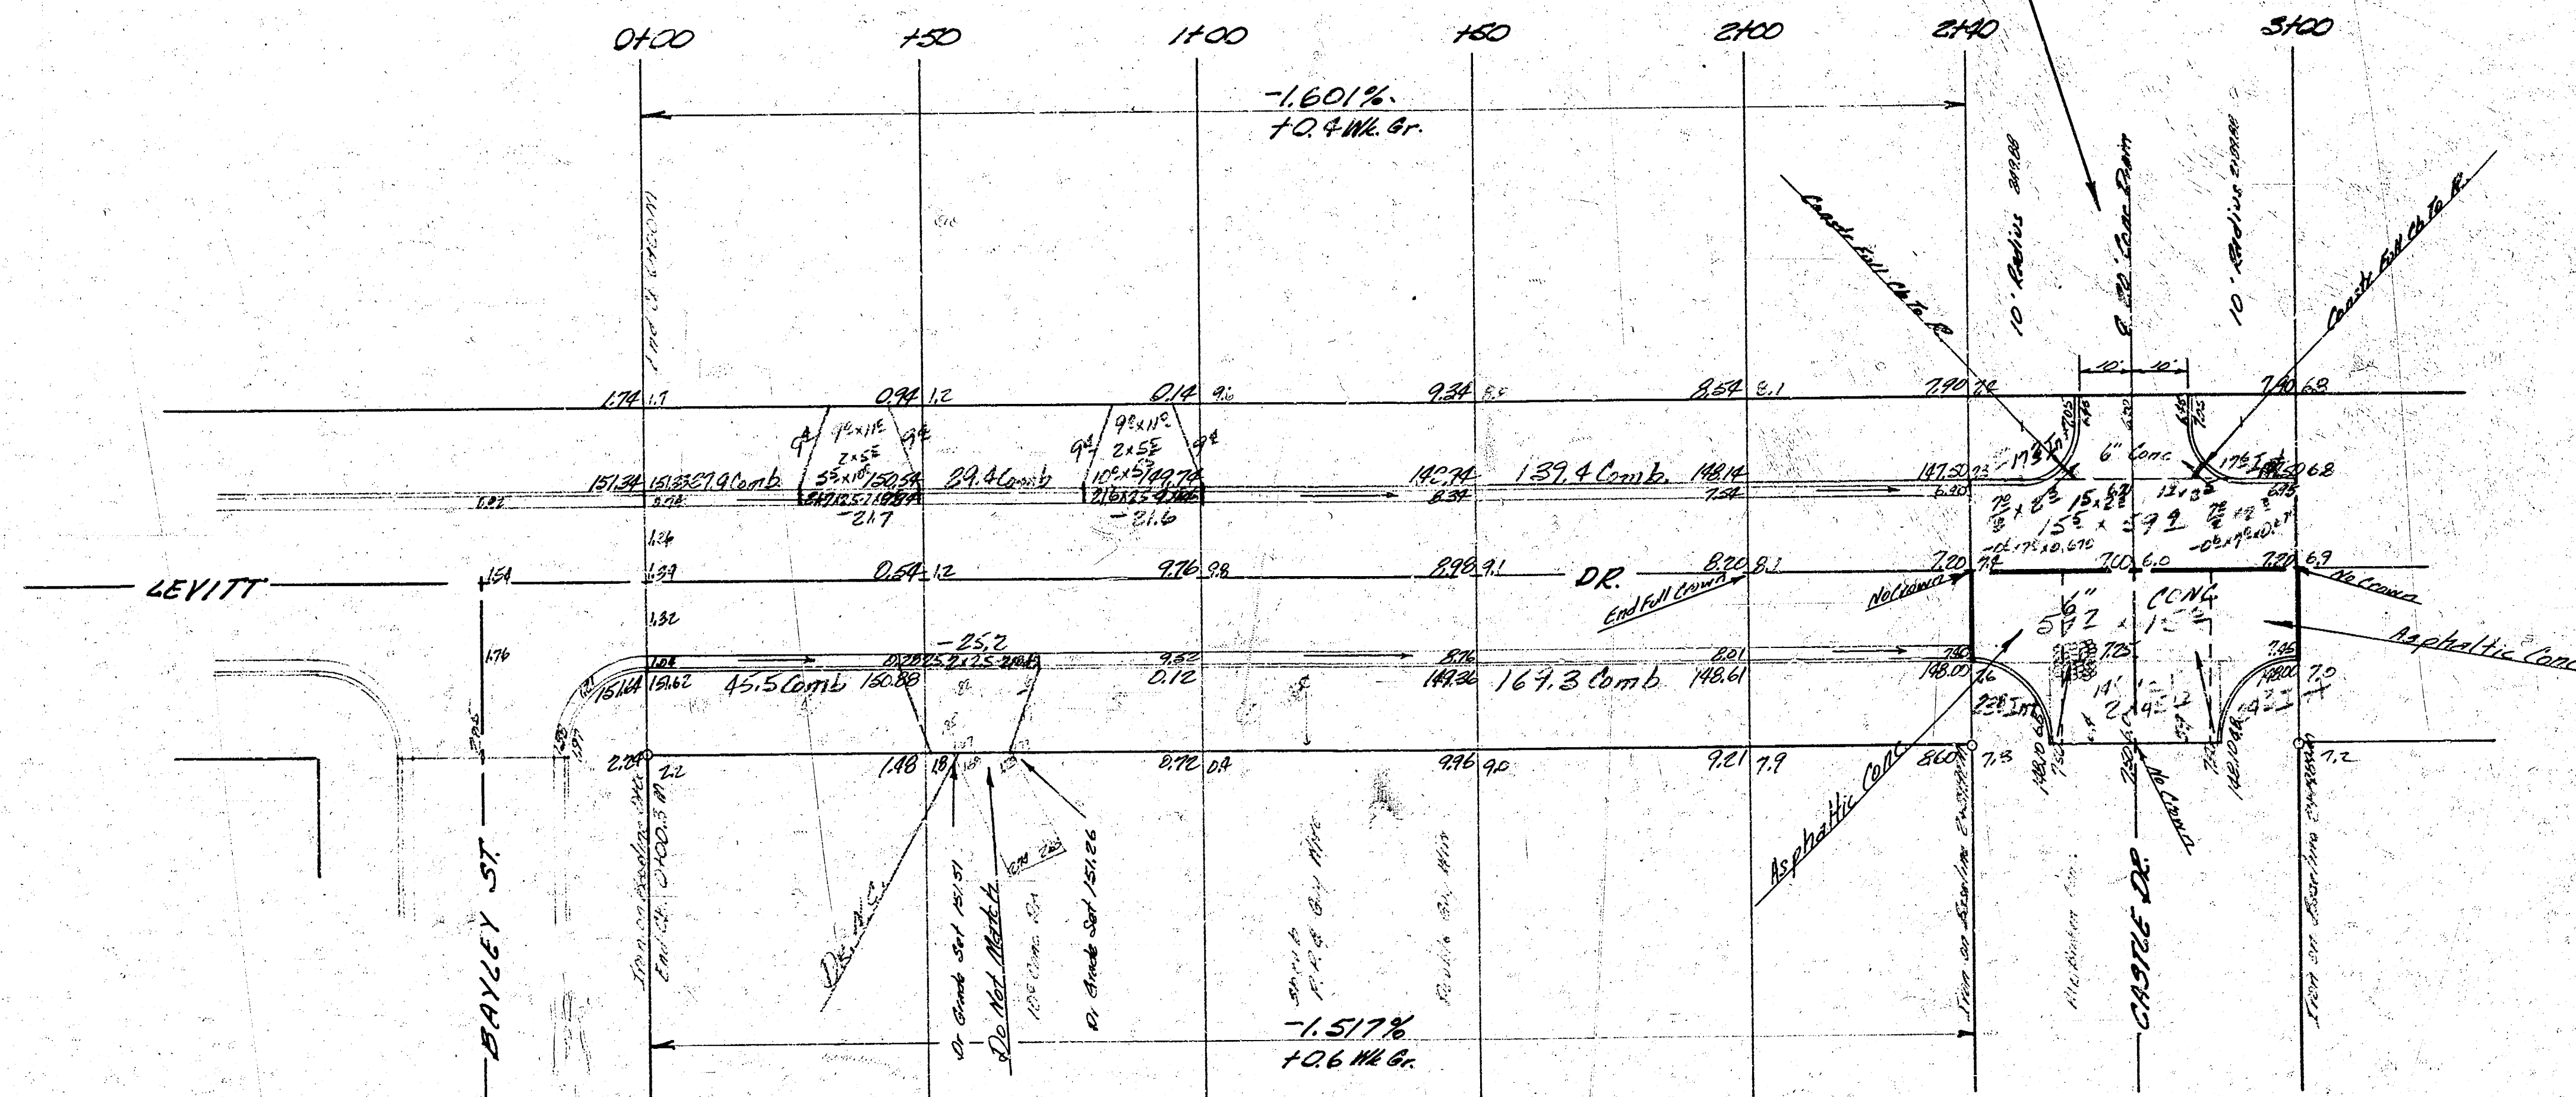

PRIVATE CONTRACTOR QUANTITIES			FINAL
695	SY	Pav't	695.2
142	SY	6" Conc. Patch	142.0
370	LF	Comb. Ch. & Bn.	411.5
81	LF	Reinf. 2nd Ch.	84.8
100	SF	5th Ch.	87.6
875	SF	5th Bn.	146.5
885	SF	6" Drive	220.0
2570	Lbs	Reinf. Steel	222.5
190.2	CY	Excavation	211.8
60.1	CY	Comp. Fill	22.0
30	LF	Mastic H.	22.0
1	ea	3m. Tree Rem.	1
1	CY	Concrete	1
1	CY	Spec. Excav.	1

PROJ. C15-89

Excav.
City
3.8 CY
0.4% 10%
4.2 CY Total

Comp. Fill
City
45.4 CY
0.4% 10%
50.5 CY Total

LEVITT DRIVE
E.L. BAYLEY ST TO E.L. CASTLE DR

26'-2" - 30' A.C.

CITY OF WICHITA, KANSAS
B.E. SMITH CITY ENGINEER
DATE PRIVATE CONTRACT

INTERSECTIONS
CASTLE DR & LEVITT DR
CASTLE DR & CAPRI ST

ASPHALTIC CONCRETE

CITY OF WICHITA, KANSAS
B.E. SMITH CITY ENGINEER
DATE PROJ. NO. C15-89