



S.M. 169.22 'R' in Ritchie Top N. Ch. Rutland @ E.L. Lawrence Ln.

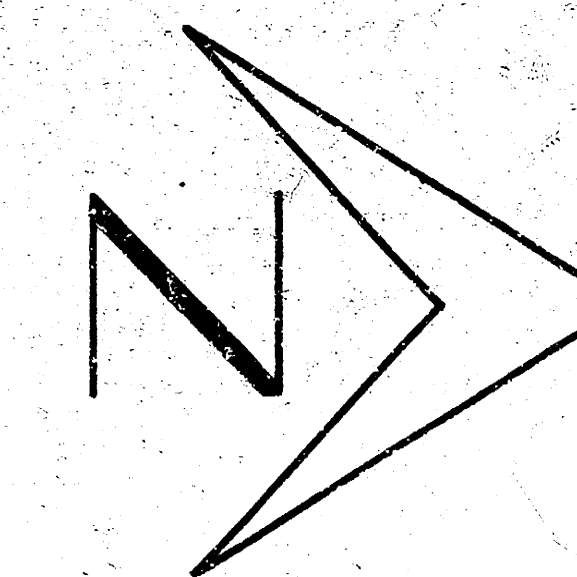


SCALE 1" = 20'

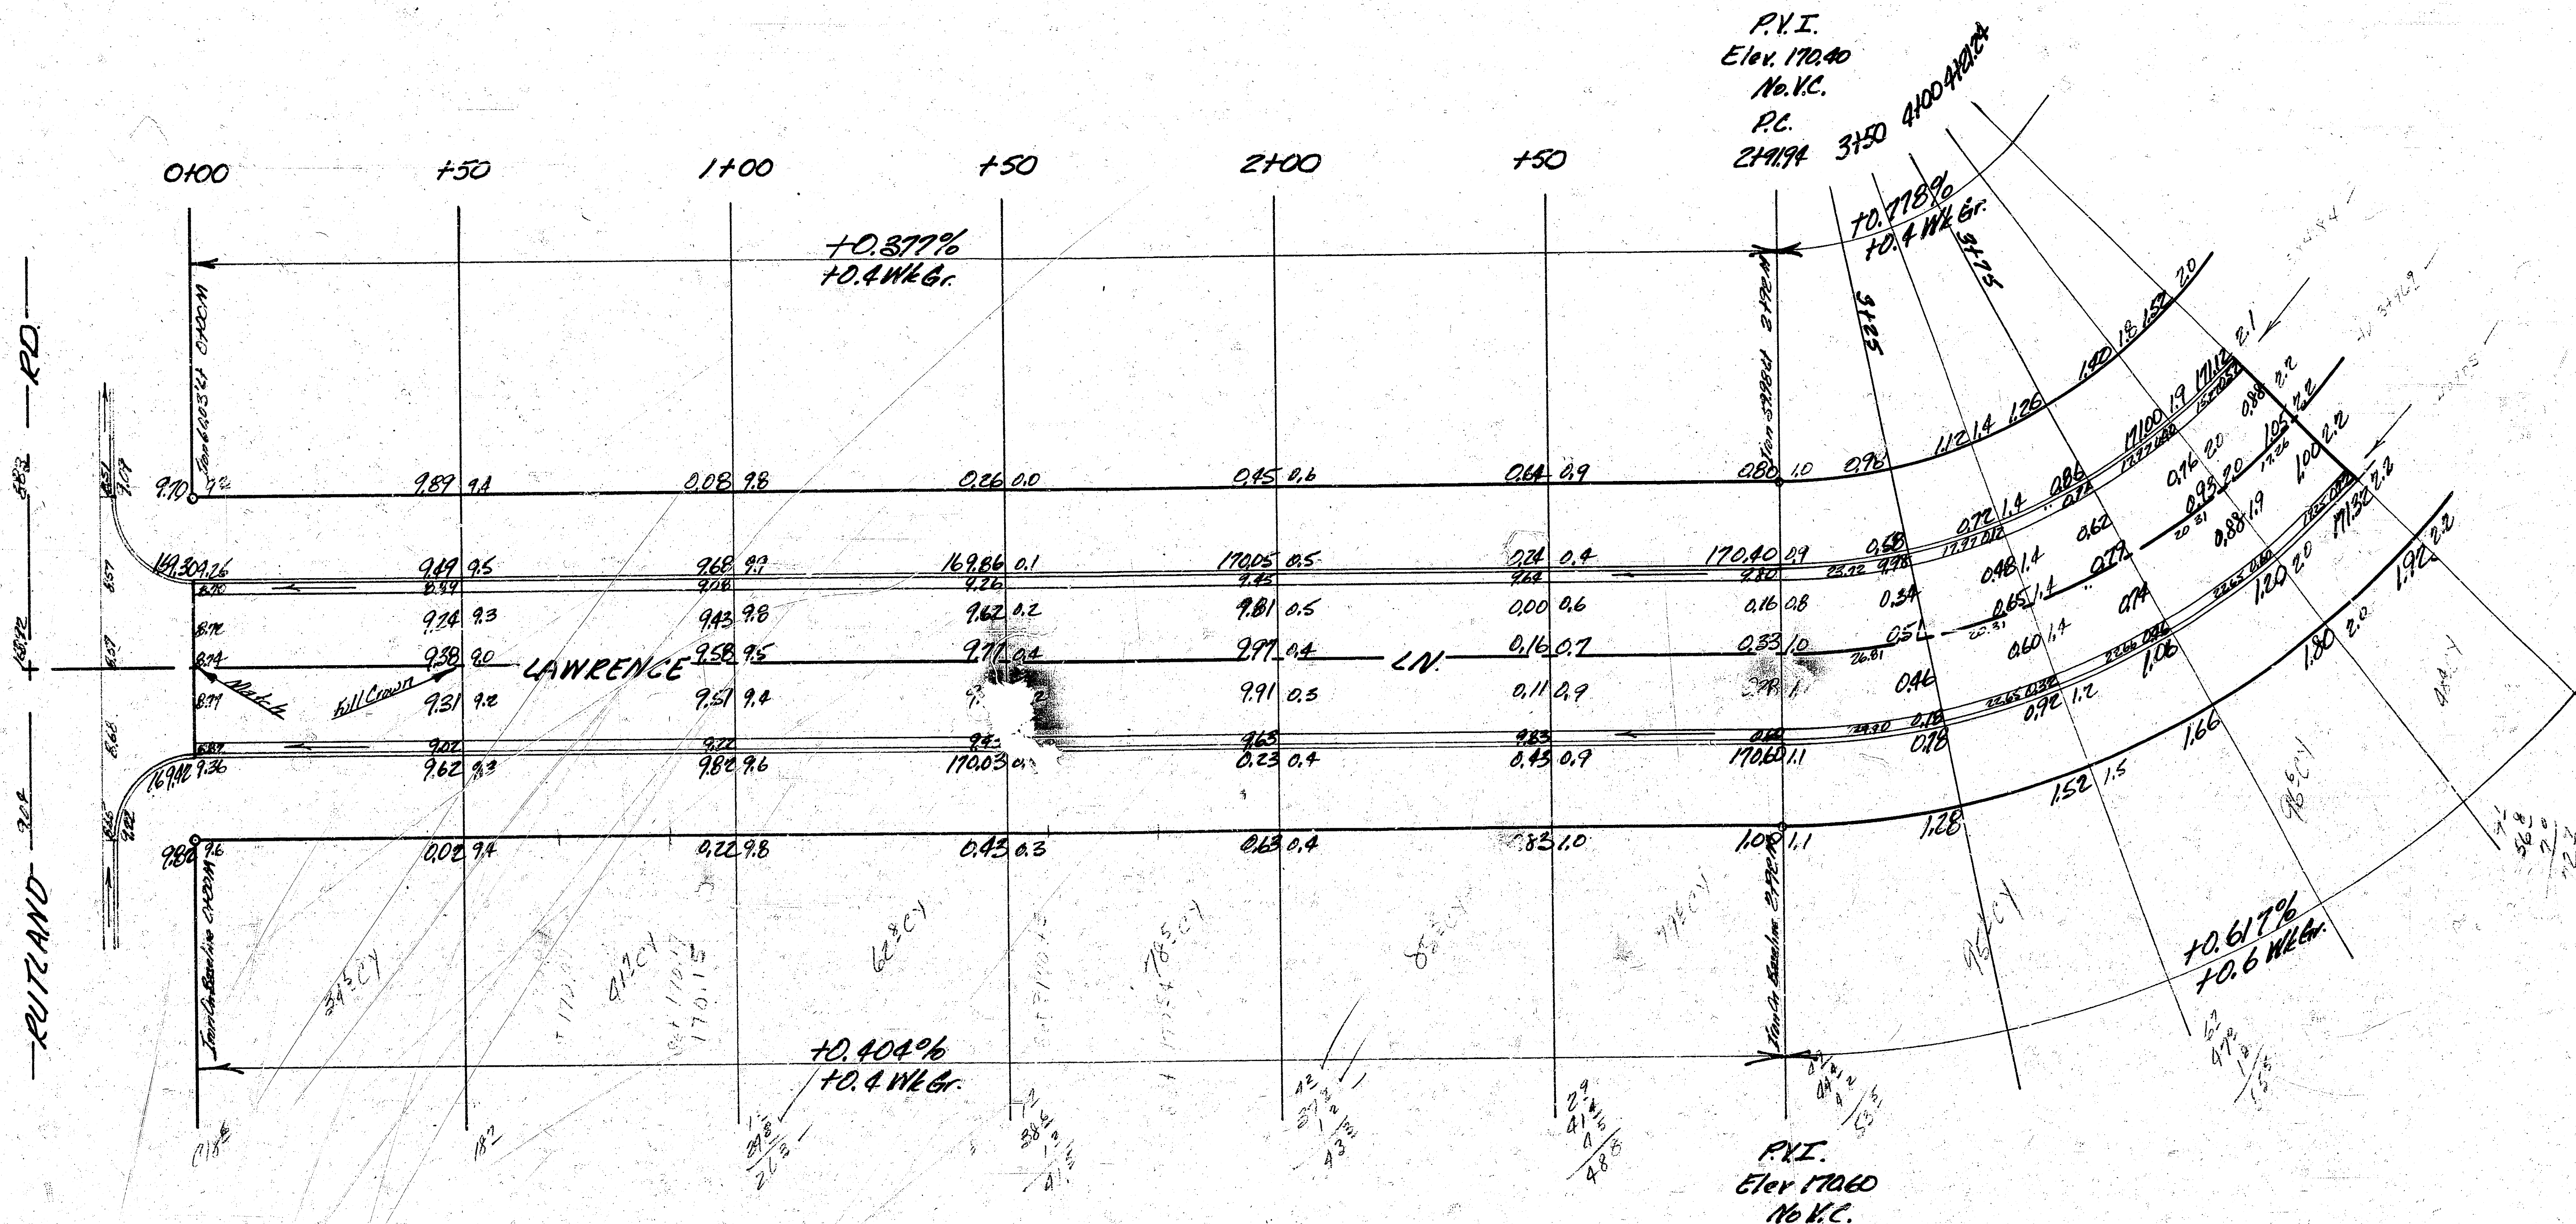

CURVE DATA BASED O.E.P. R = 160' Δ 89°34'30"					
Sta	Alt.	Chd B' @ E Ch.	Chd B' @ W Ch.	Deflection	Total Defl's
P.C. 2+49.94				0° 00' 00"	
3+25	33°	31.50'	22.03'	5° 54' 31"	6° 54' 31"
+50	25°	23.88'	16.70'	4° 28' 35"	10° 23' 06"
+75	"	"	"	"	14° 51' 41"
4+00	25°	23.88'	16.70'	4° 28' 35"	19° 20' 16"
+21.24	21.24	20.30'	14.19'	5° 48' 11"	23° 08' 27"
P.T. 3+40.42	120.99	112.96'	79.00'	21° 39' 48"	44° 48' 15"

10.7450 Min./Hr

Excavation
Prop.
622.5 CY.
62.3 HD%
684.8 C.Y. Total

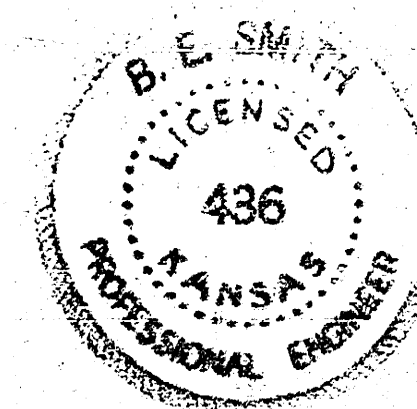

LAWRENCE LANE
N.L. RUTLAND RD TO EL. LOT 6.
D 3RD ADDN TO WOODLAWN BLVD

26' 2" - 30' A.C.

CITY OF WICHITA KANSAS
B.E. SMITH CITY ENGINEER
DATE MAR. 1966 FROM C-13-9