


Madison Ave. - S.L. Messman to N.L. Remond Rd.

26-2-30 A.S.

1941 Oct 11531 "B" Road looking
W. H. N. on Right + 98


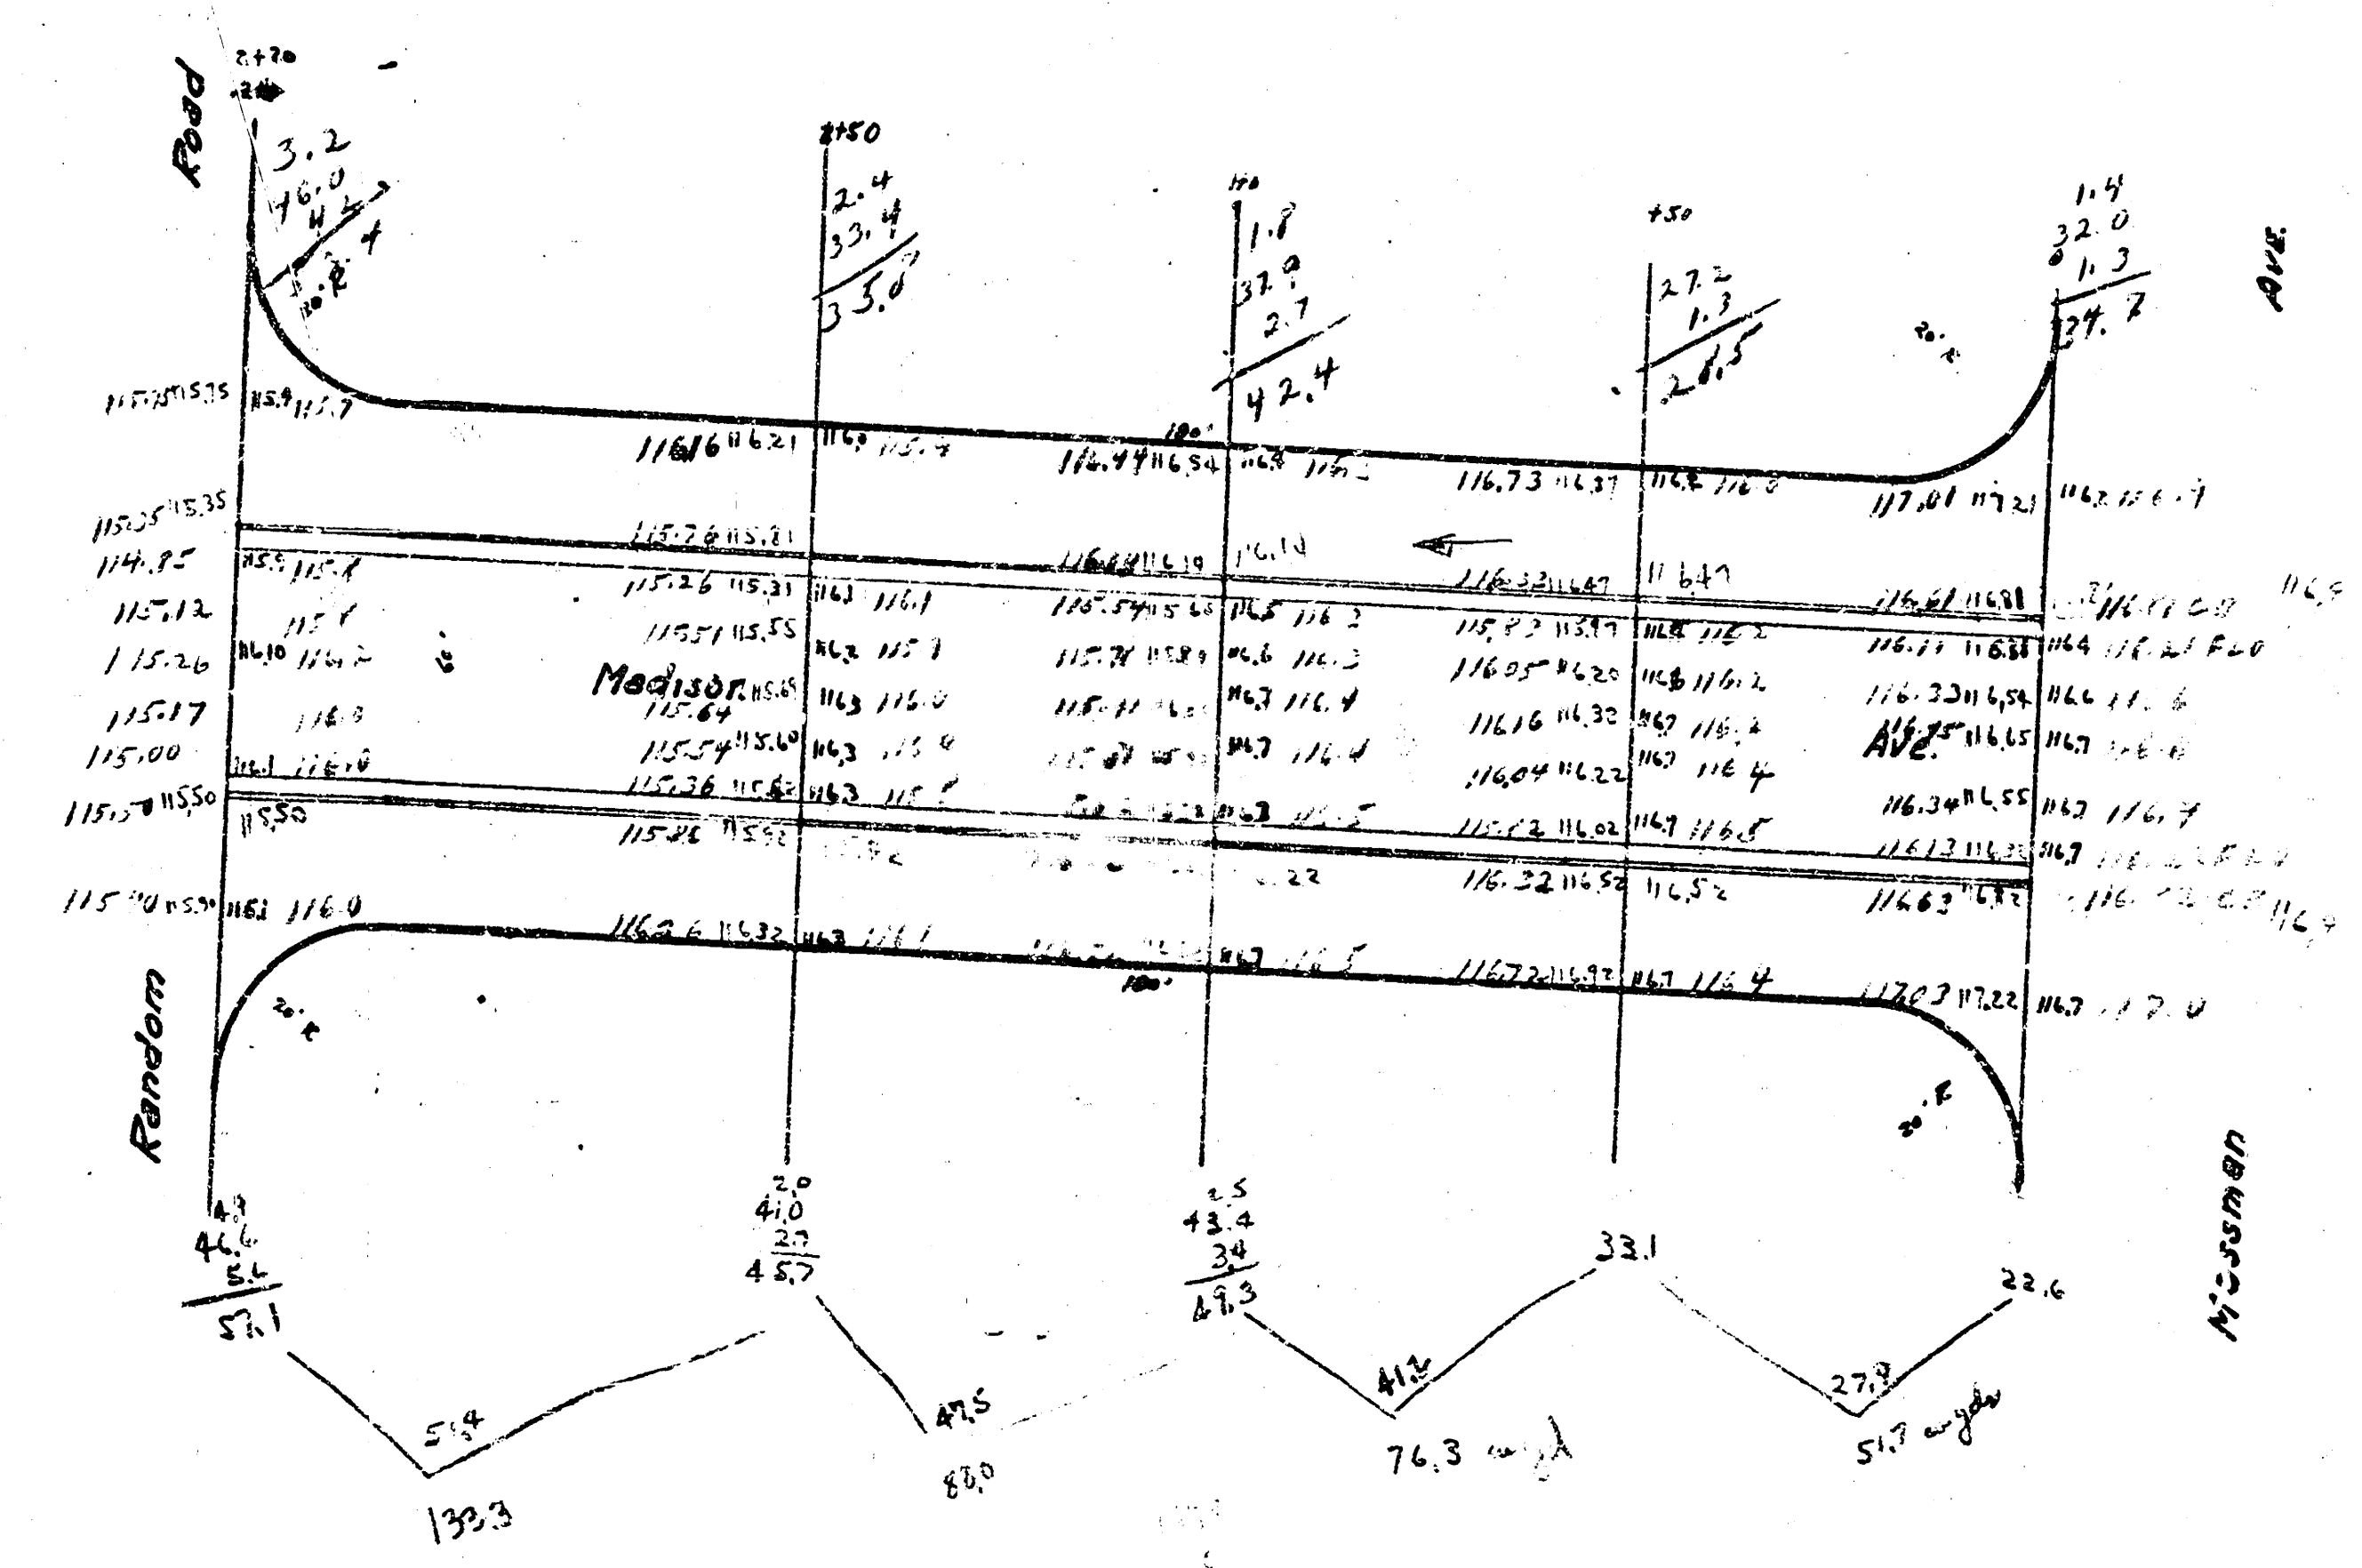

Property 349.3
Total 324.2