


Madison Ave - S.L. 9th St. to N.L. Mossman

26-2-30 A.C.

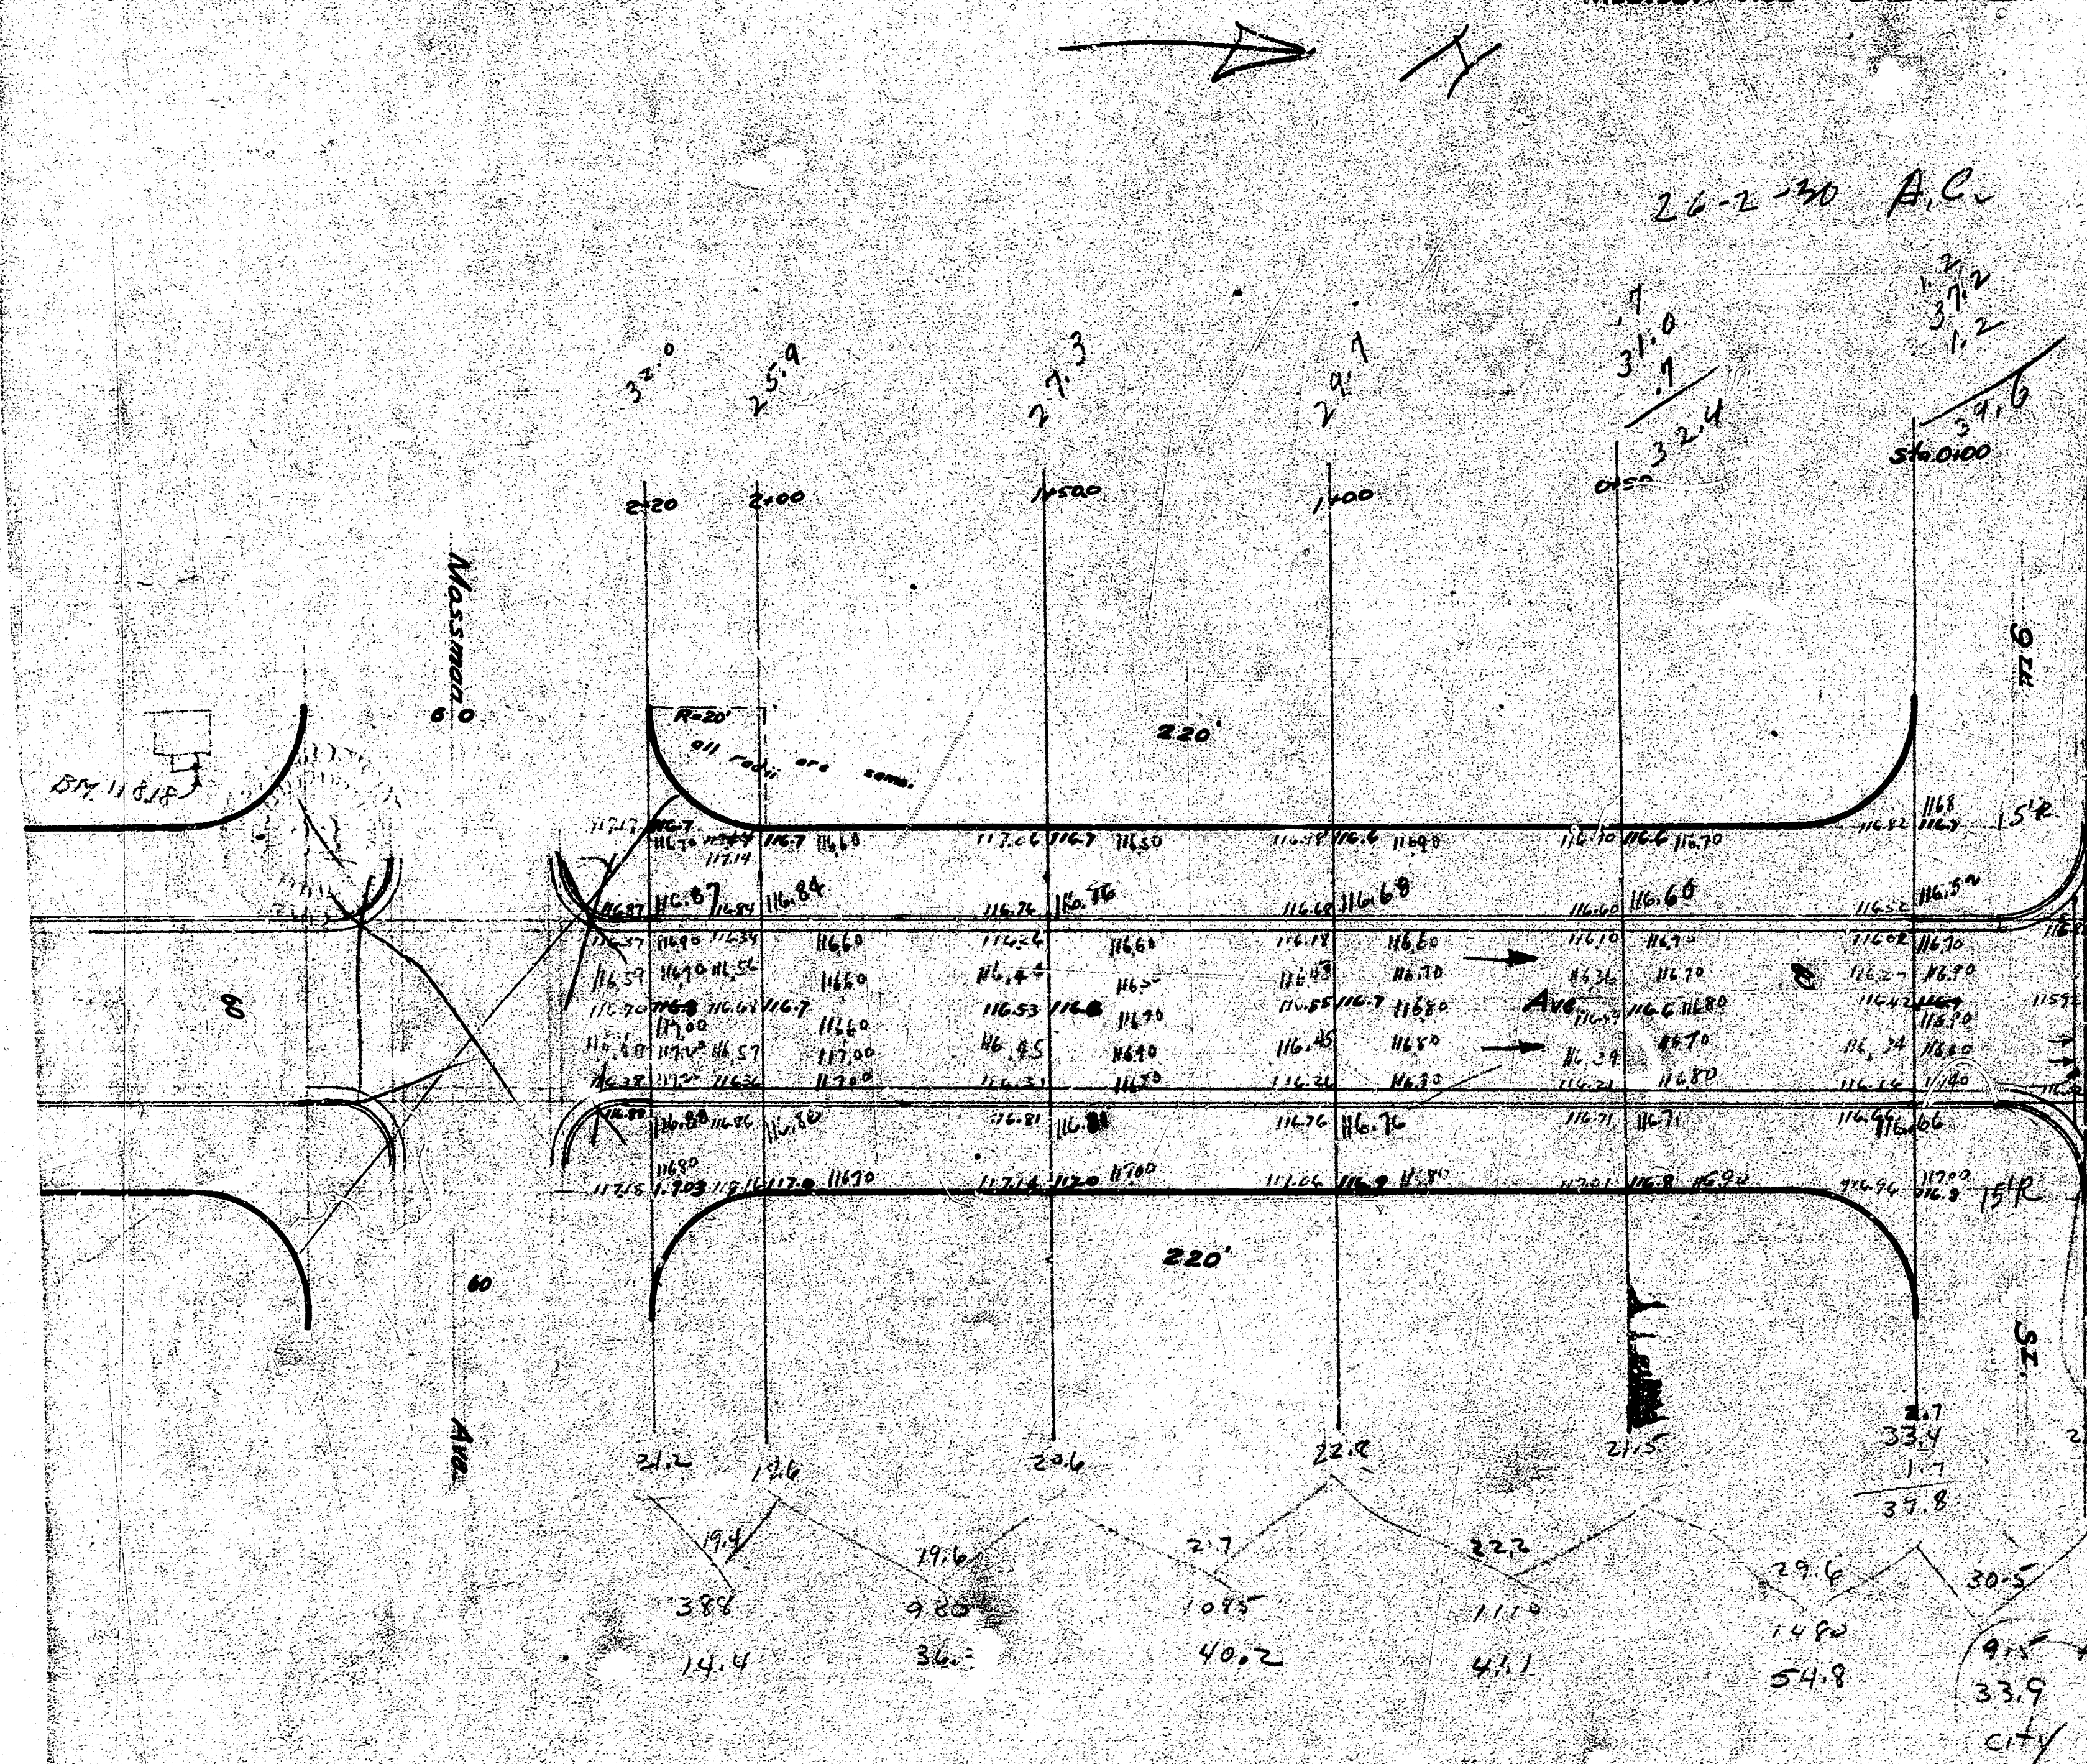

MADISON AVE.

$$\begin{aligned} \text{Prop } 186.8 + 10.7 &= 205.5 \\ \text{City } 33.9 + 2.4 &= 37.3 \end{aligned}$$