
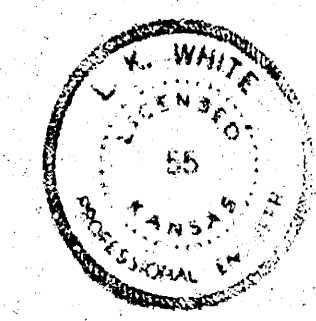
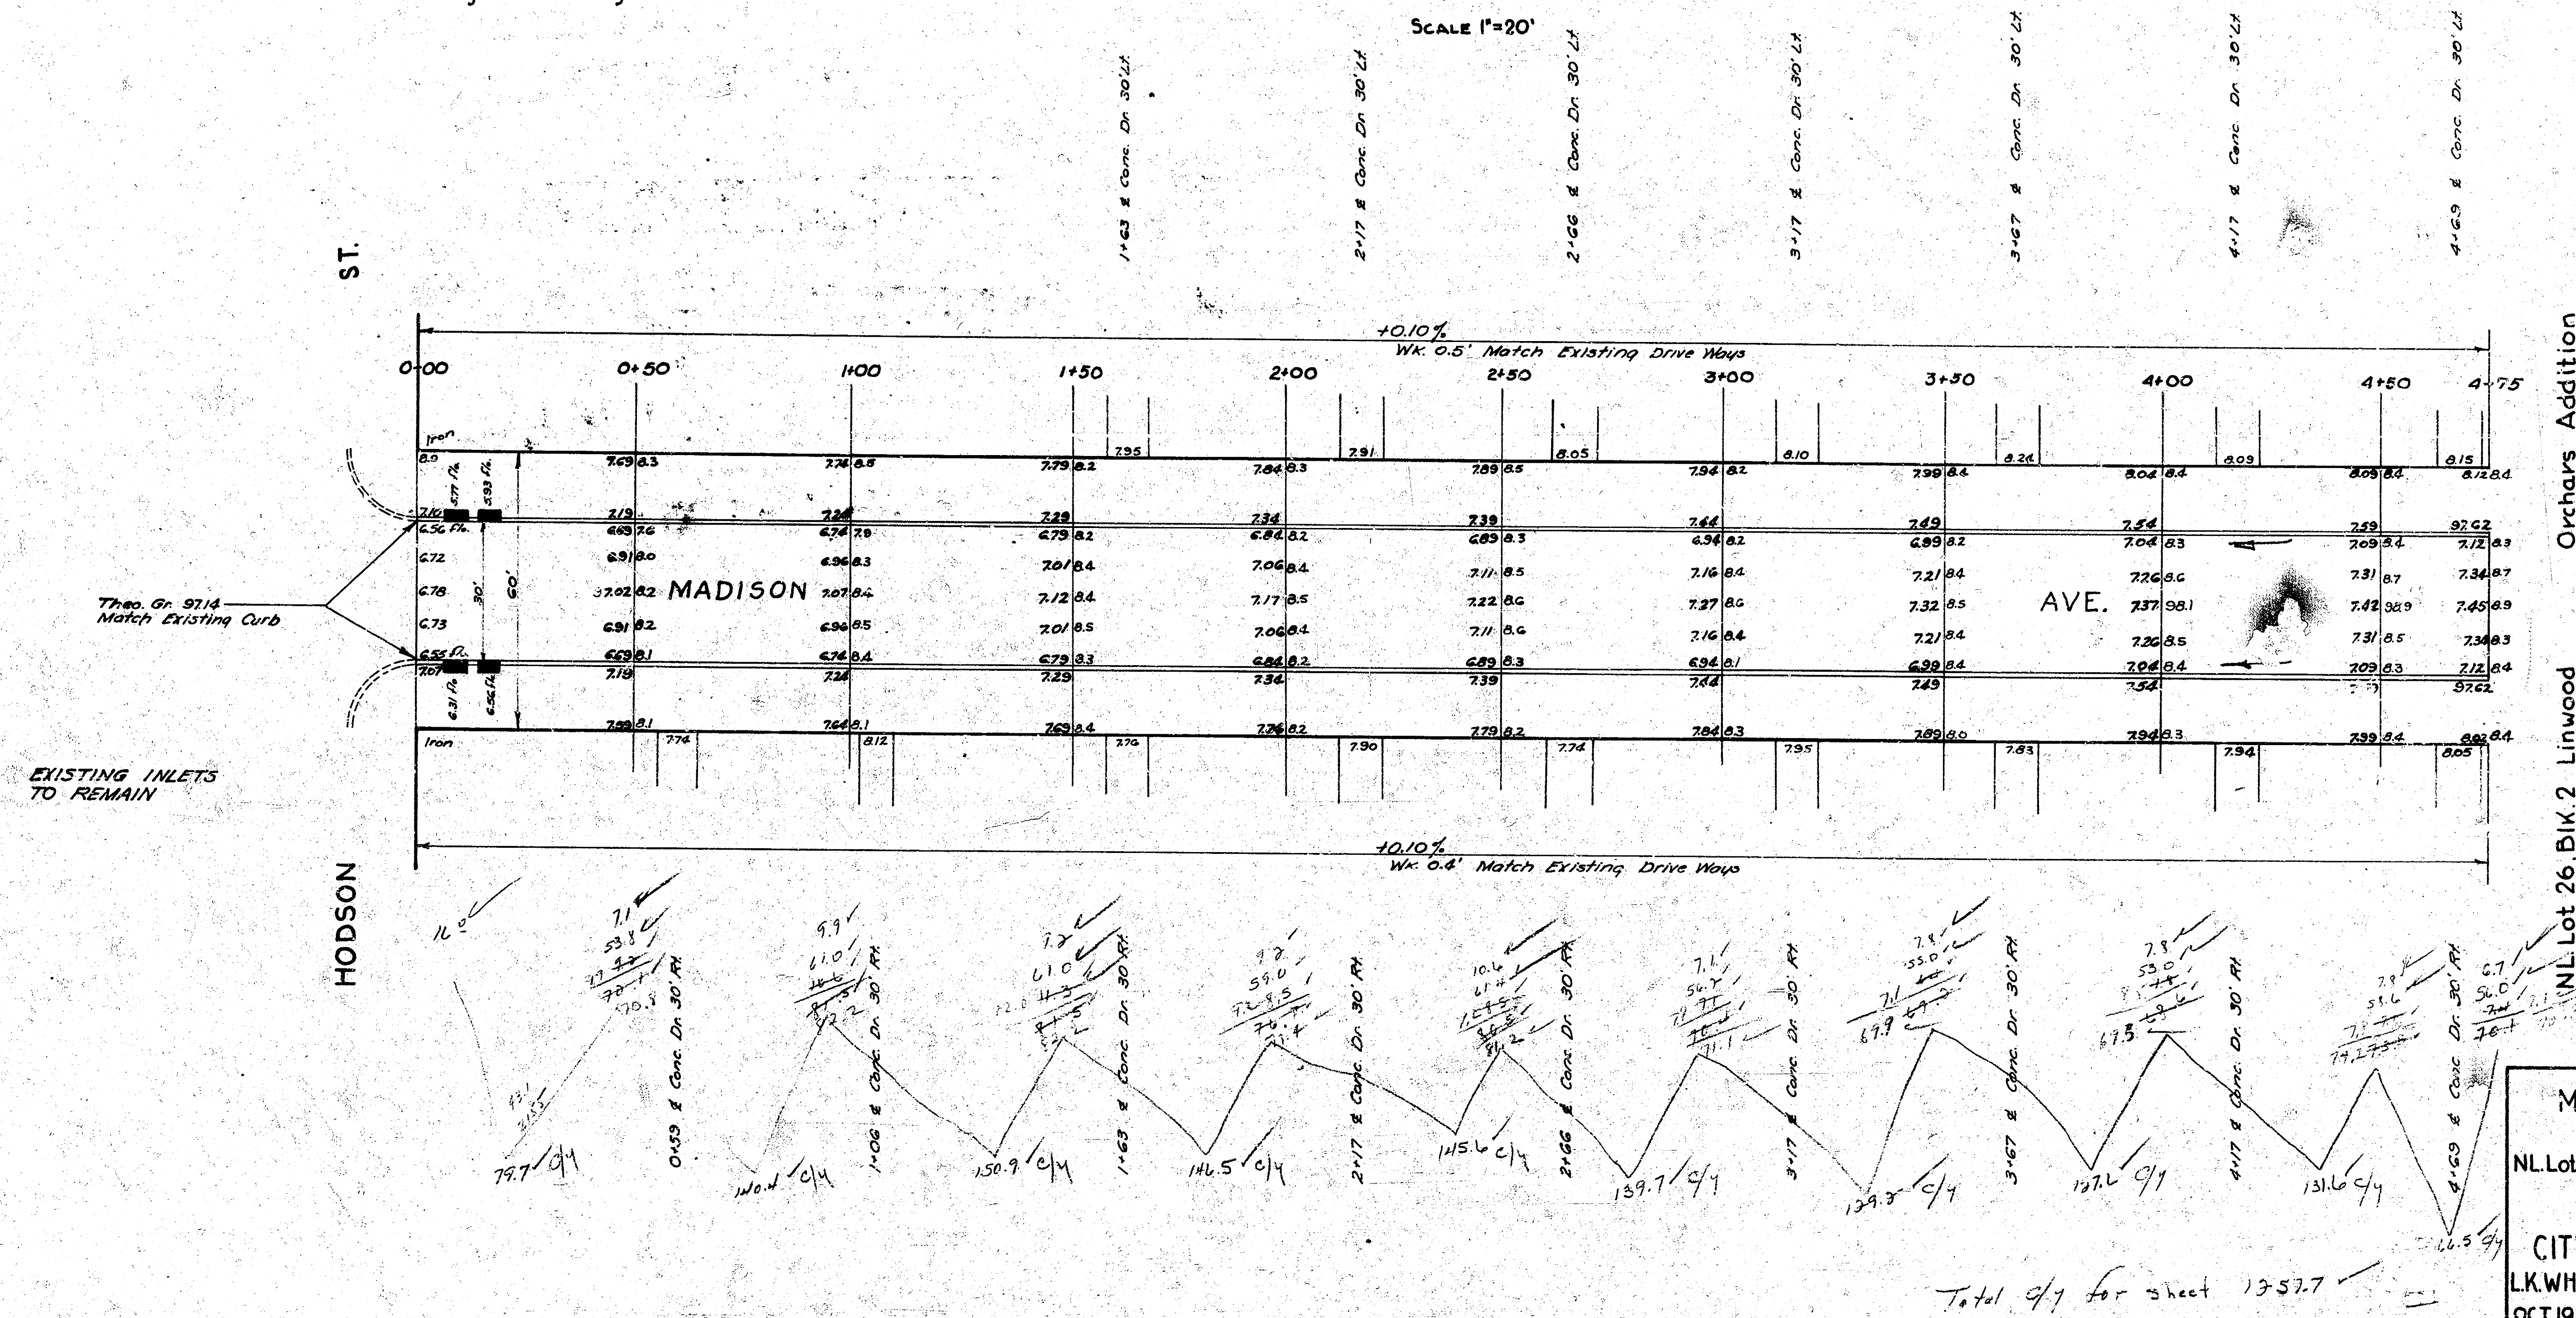


BM: 10021 "M" in Mueller Fire Hyd. NW cor. Levy & Madison.

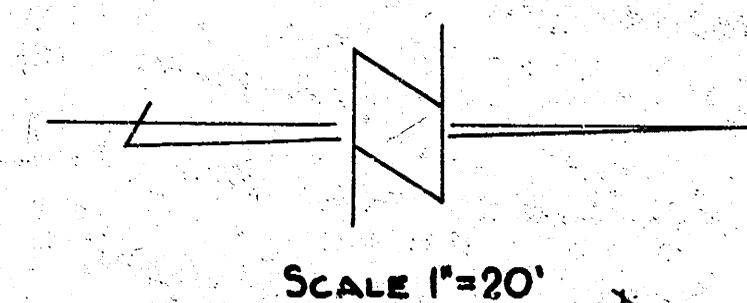

MADISON AVE.
NL HODSON ST. to
NL Lot 26, Bk. 2 Linwood Orchards Addn.
30' Conc. & Cb.
CITY OF WICHITA, KANSAS
L. K. WHITE CITY ENGINEER
OCT. 1951 PROJ. NO. C 11-148

S-4

Preliminary Survey - Bl. S-4 - 583 - 11/13/51
Made on Plat. 115 - 1-9-52
Grounds of City of Wichita, Kan.

