


SEWER SERVICE TABLE

NUMBER	TYPE	LOCATION			FOR INFORMATION ONLY	
		LOT NO.	BLOCK NO.	LINE NO.	STATION \ DIRECTION	APPROXIMATE LENGTH 4" PIPE
1	8" X 4" Tee Saddle	7	3	2	0+69/R	10' VERTICAL, 6' HORIZONTAL
2	8" X 4" Tee Saddle	73	5	2	2+57/R	10' VERTICAL, 5' HORIZONTAL
3	8" X 4" Tee Saddle	72	5	2	3+00/R	54' VERTICAL, 9' HORIZONTAL
4	8" X 4" Tee Saddle	71	5	2	4+00/R	28' VERTICAL, 9' HORIZONTAL
5	8" X 4" Tee Saddle	70	5	2	5+00/R	35' VERTICAL, 9' HORIZONTAL

NOTE: Vertical Riser Pipe shall be extended to 2' minimum above ground water elevation and 4' maximum below proposed ground elevation.

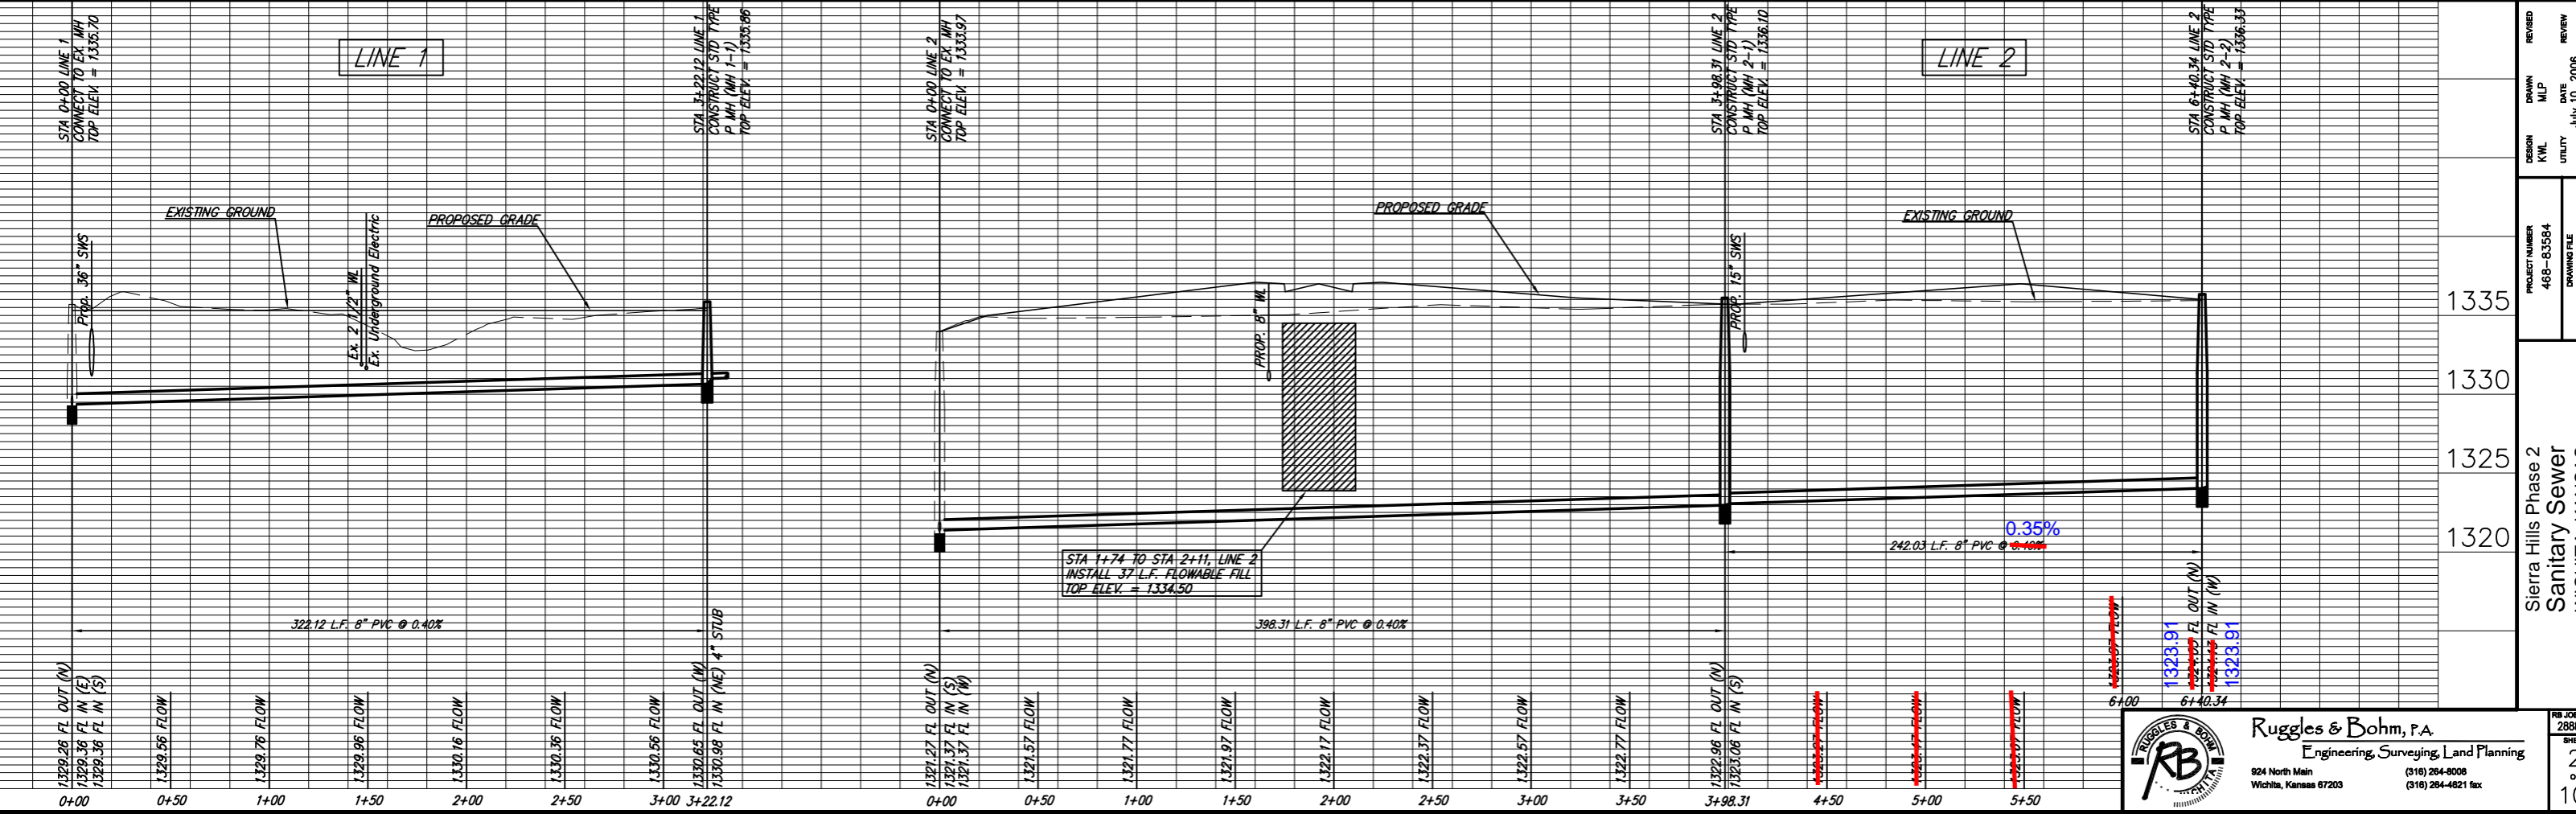

Ruggles & Bohm, P.A.
Engineering, Surveying, Land Planning
924 North Main
Wichita, Kansas 67203
(316) 264-8008
(316) 264-4821 fax

PROJECT NUMBER: 468-83564
DRAWING FILE: Sanitary Sewer (LINE 1&2)

DESIGN: KWL
DRAWN: MLP
REVIEW: July 10, 2006

JOB: 2888E
SHEET: 2
OF: 10