

SEWER SERVICE TABLE


NUMBER	TYPE	LOCATION				FOR INFORMATION ONLY		
		LOT NO.	BLOCK NO.	LINE NO.	STATION \ DIRECTION	APPROXIMATE LENGTH 4" PIPE	VERTICAL	HORIZONTAL
6	8" X 4" Tee Saddle	69	5	2	7+00/R	09	8'	5'
7	8" X 4" Tee Saddle	68	5	2	8+00/R	94	6'	5'
8	8" X 4" Tee Saddle	67	5	2	10+41/R	5'	5'	
9	8" X 4" Tee Saddle	66	5	2	11+37/R	5'	5'	
10	8" X 4" Tee Saddle	65	5	2	12+04/R	23	6'	5'

NOTE: Vertical Riser Pipe shall be extended to 2' minimum above ground water elevation and 4' maximum below proposed ground elevation.



NOTE: CONTRACTOR SHALL LIMIT WORK TO EASEMENTS ON GOLF COURSE PROPERTY.

SCALE 1" = 40' HORIZ.
1" = 5' VERT.
IRON = •

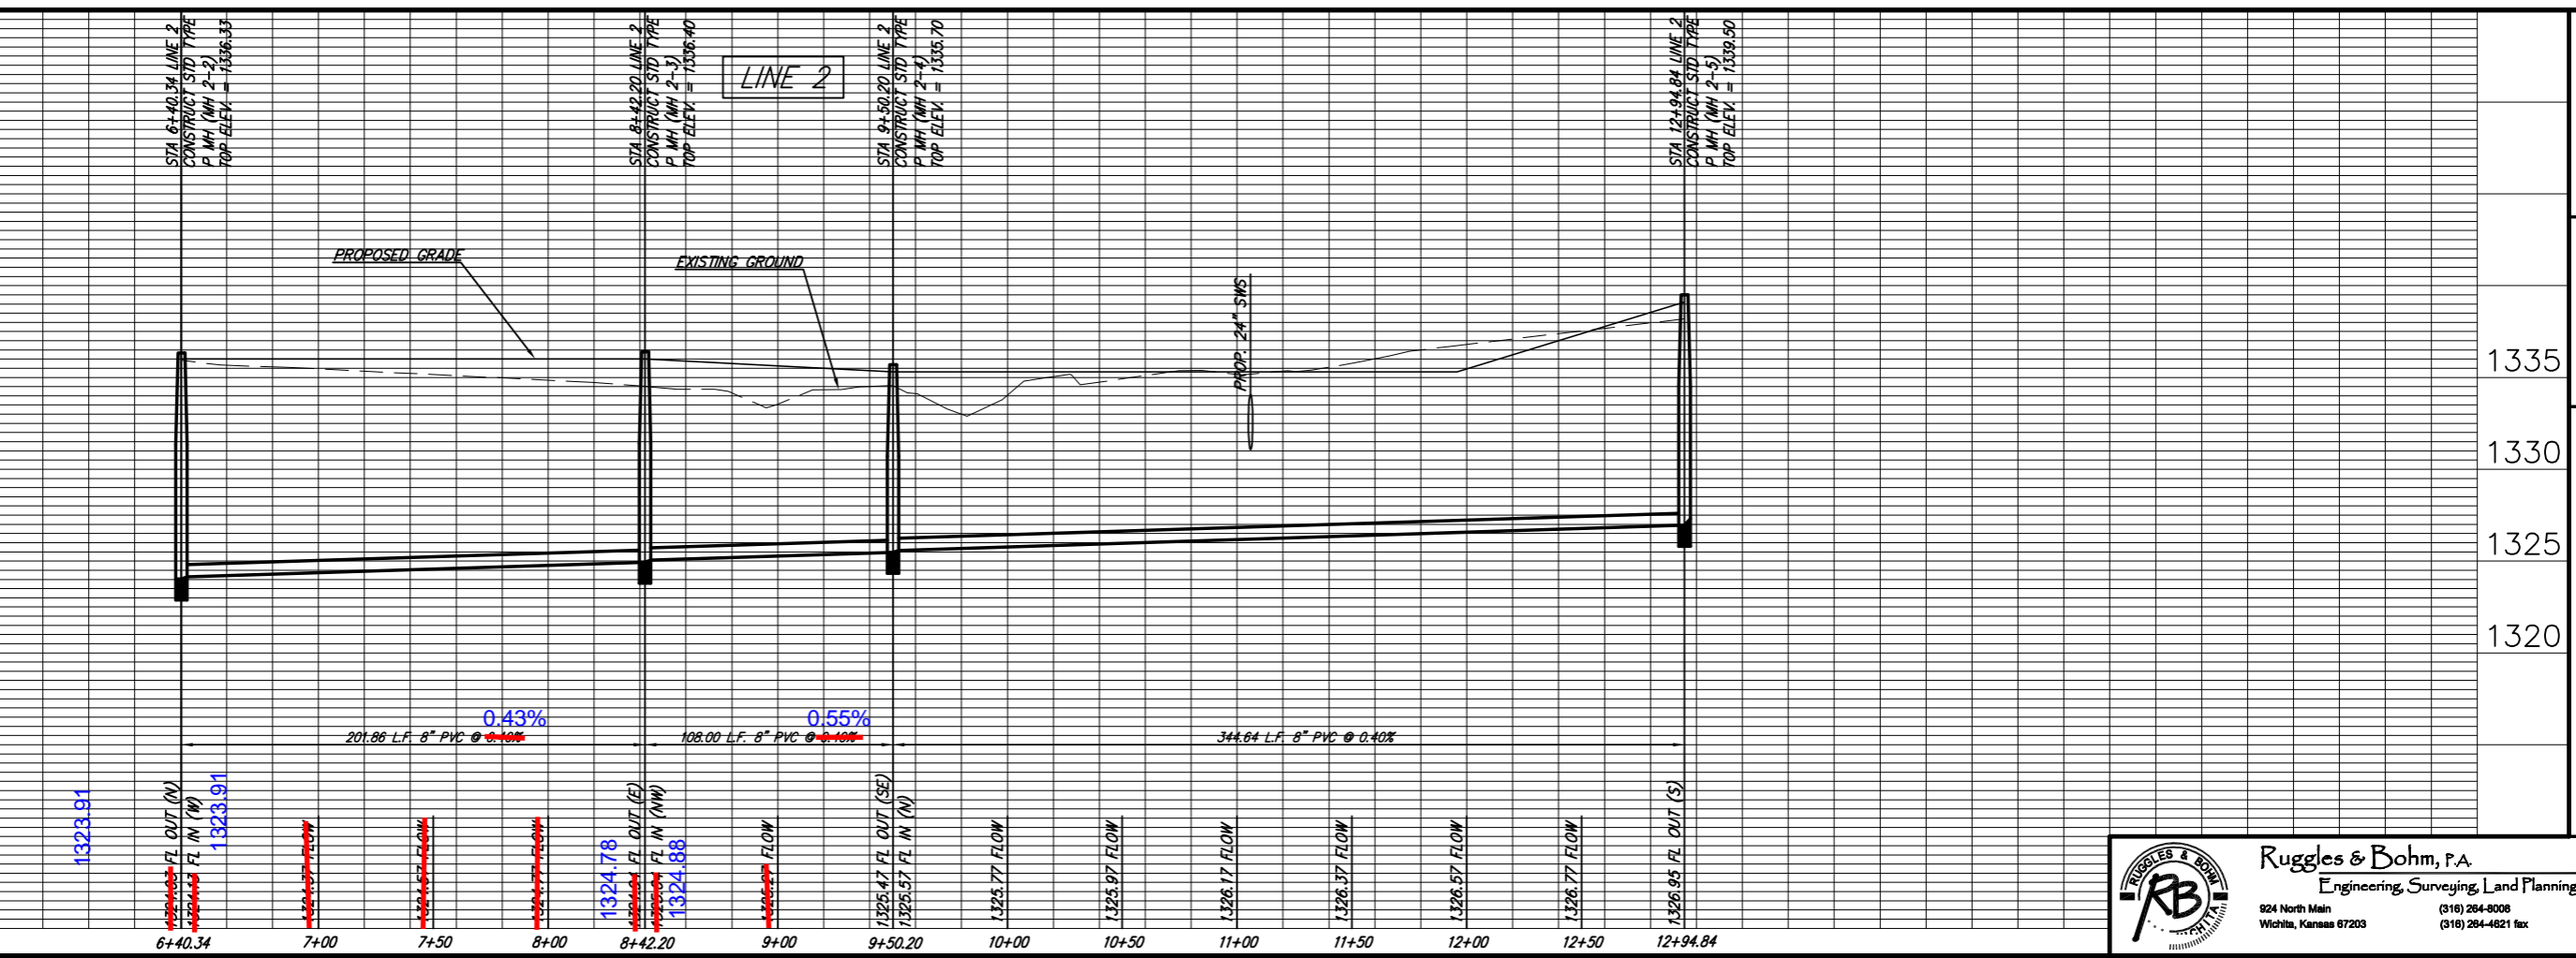

Ruggles & Bohm, P.A.
Engineering, Surveying, Land Planning
924 North Main
Wichita, Kansas 67203
(316) 264-8008
(316) 264-4821 fax

PROJECT NUMBER
468-83564

DESIGN KWL
DRAWING FILE
Sanitary Sewer {LINE 2-1}

REVISIONS
DRAWN MLP
DATE July 10, 2006
REVIEW

Sierra Hills Phase 2
Sanitary Sewer

RB JOB 2888E
SHEET 3
OF 10