


STATE	PROJECT NO.	YEAR	SHEET NO.	TOTAL SHEETS
KANSAS	87 N-0362-01	2007	9	48

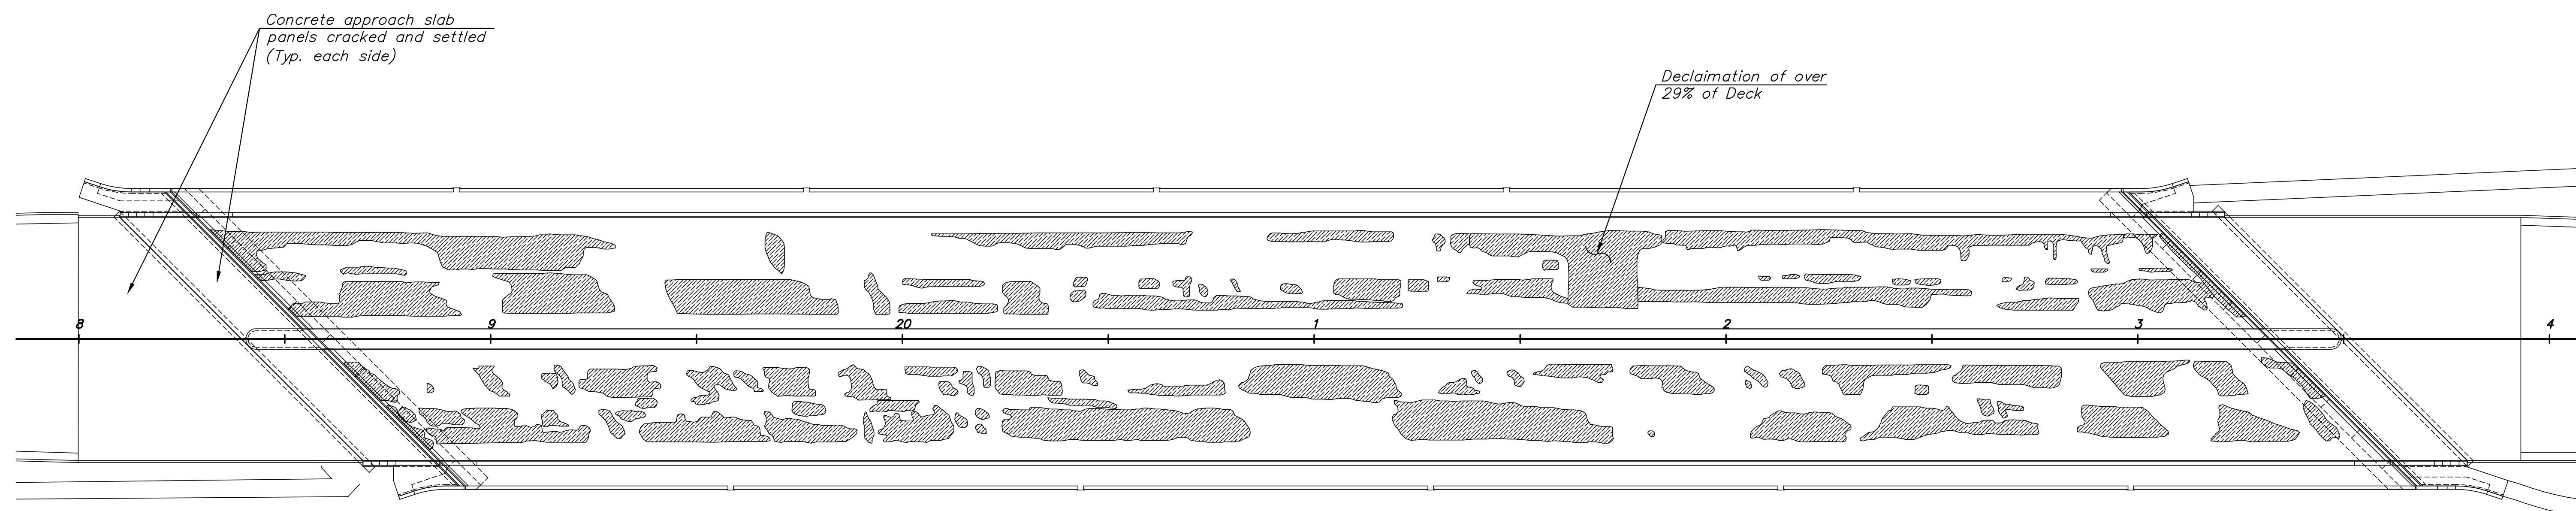

**BRIDGE DECK DELAMINATION DIAGRAM**

Estimated Area: 7,425 Sq. Ft.  
 Inspected: June 2004

J:\Civil\04223\dwg\BRIDGE\04223DEL.DWG 09/20/2007 02:07:07 PM CST

KANSAS DEPARTMENT OF TRANSPORTATION			
DECK DELAMINATION DIAGRAM			
PROJ. NO. 87 N-0362-01		SEDGWICK CO.	
MKEC ENGINEERING CONSULTANTS, INC. WICHITA, KANSAS			
DESIGNED BY:	JAG	CHECKED BY:	KJS
DRAWN BY:	DPG	DATE:	4/24/07 SHEET 9 OF 48