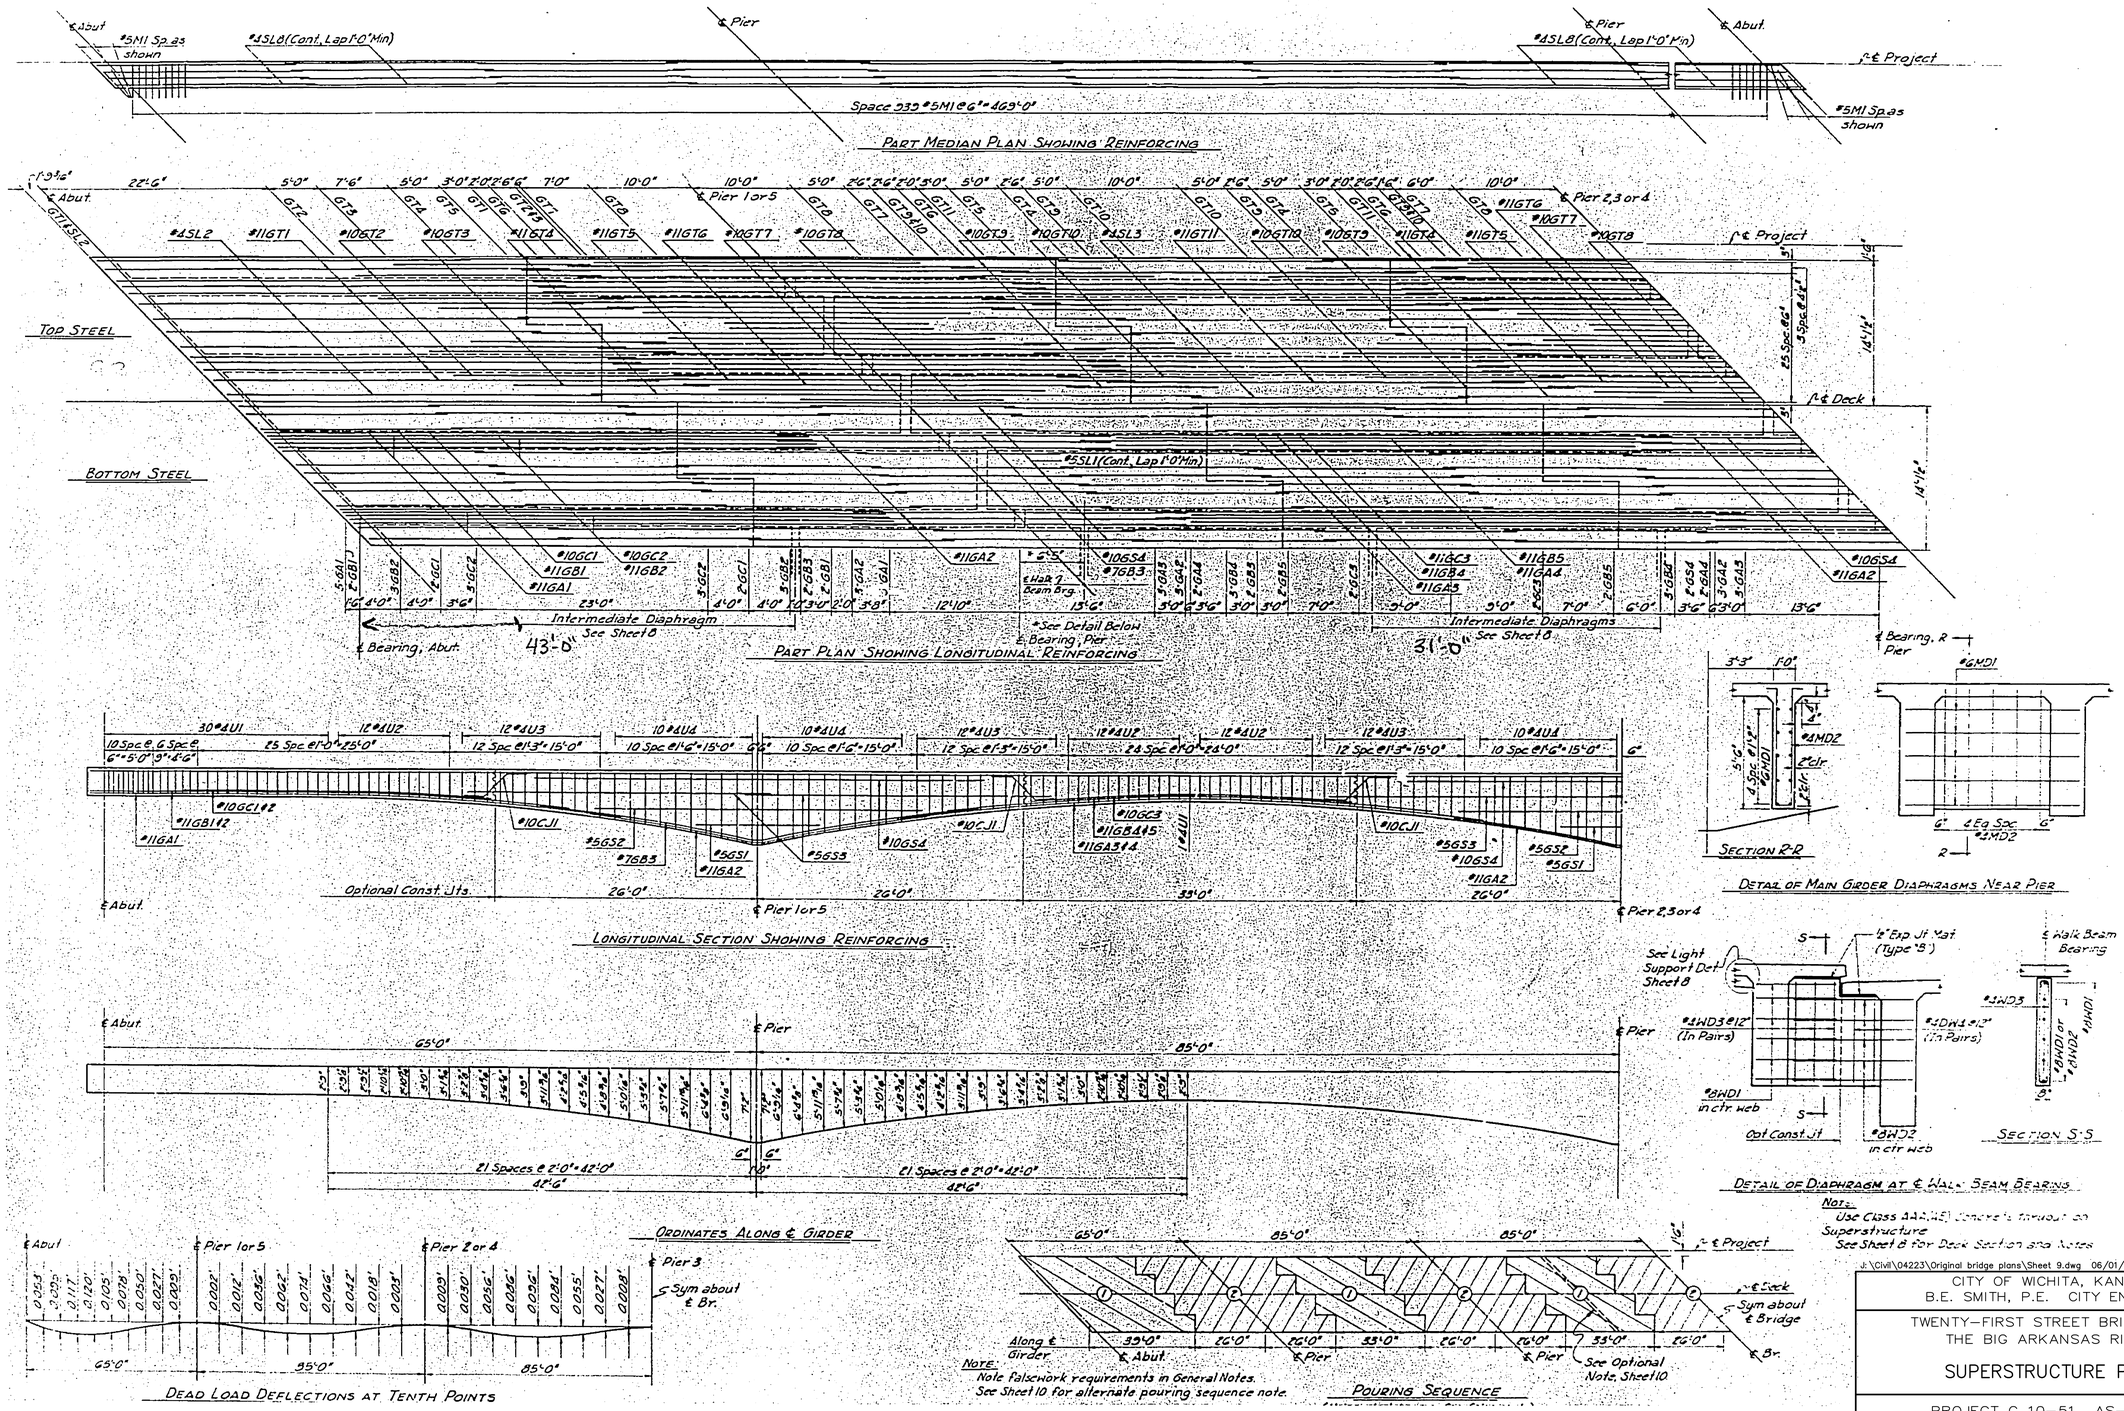

J:\Civil\04223\Original bridge plans\Sheet 9.dwg 06/01/2007 04:13:47 PM CST

CITY OF WICHITA, KANSAS
B.E. SMITH, P.E. CITY ENGINEER

TWENTY–FIRST STREET BRIDGE OVER
THE BIG ARKANSAS RIVER

SUPERSTRUCTURE PLAN

PROJECT C 10–51 AS–BUILT
NOVEMBER 1972