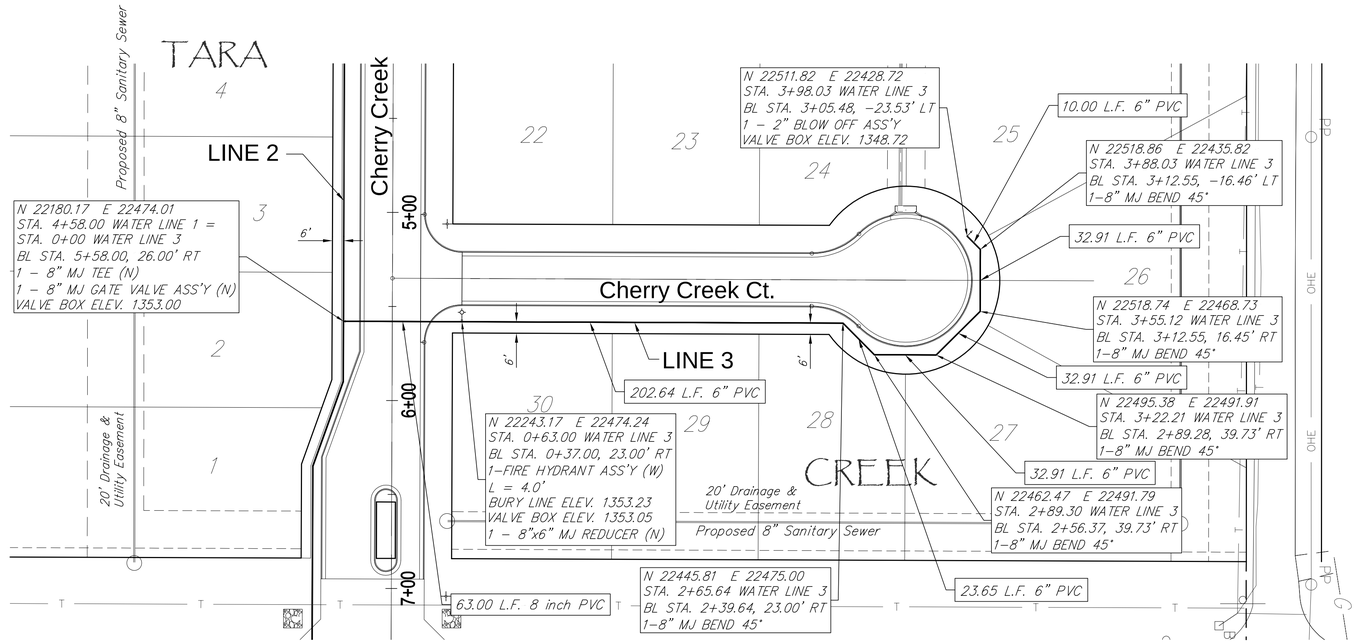

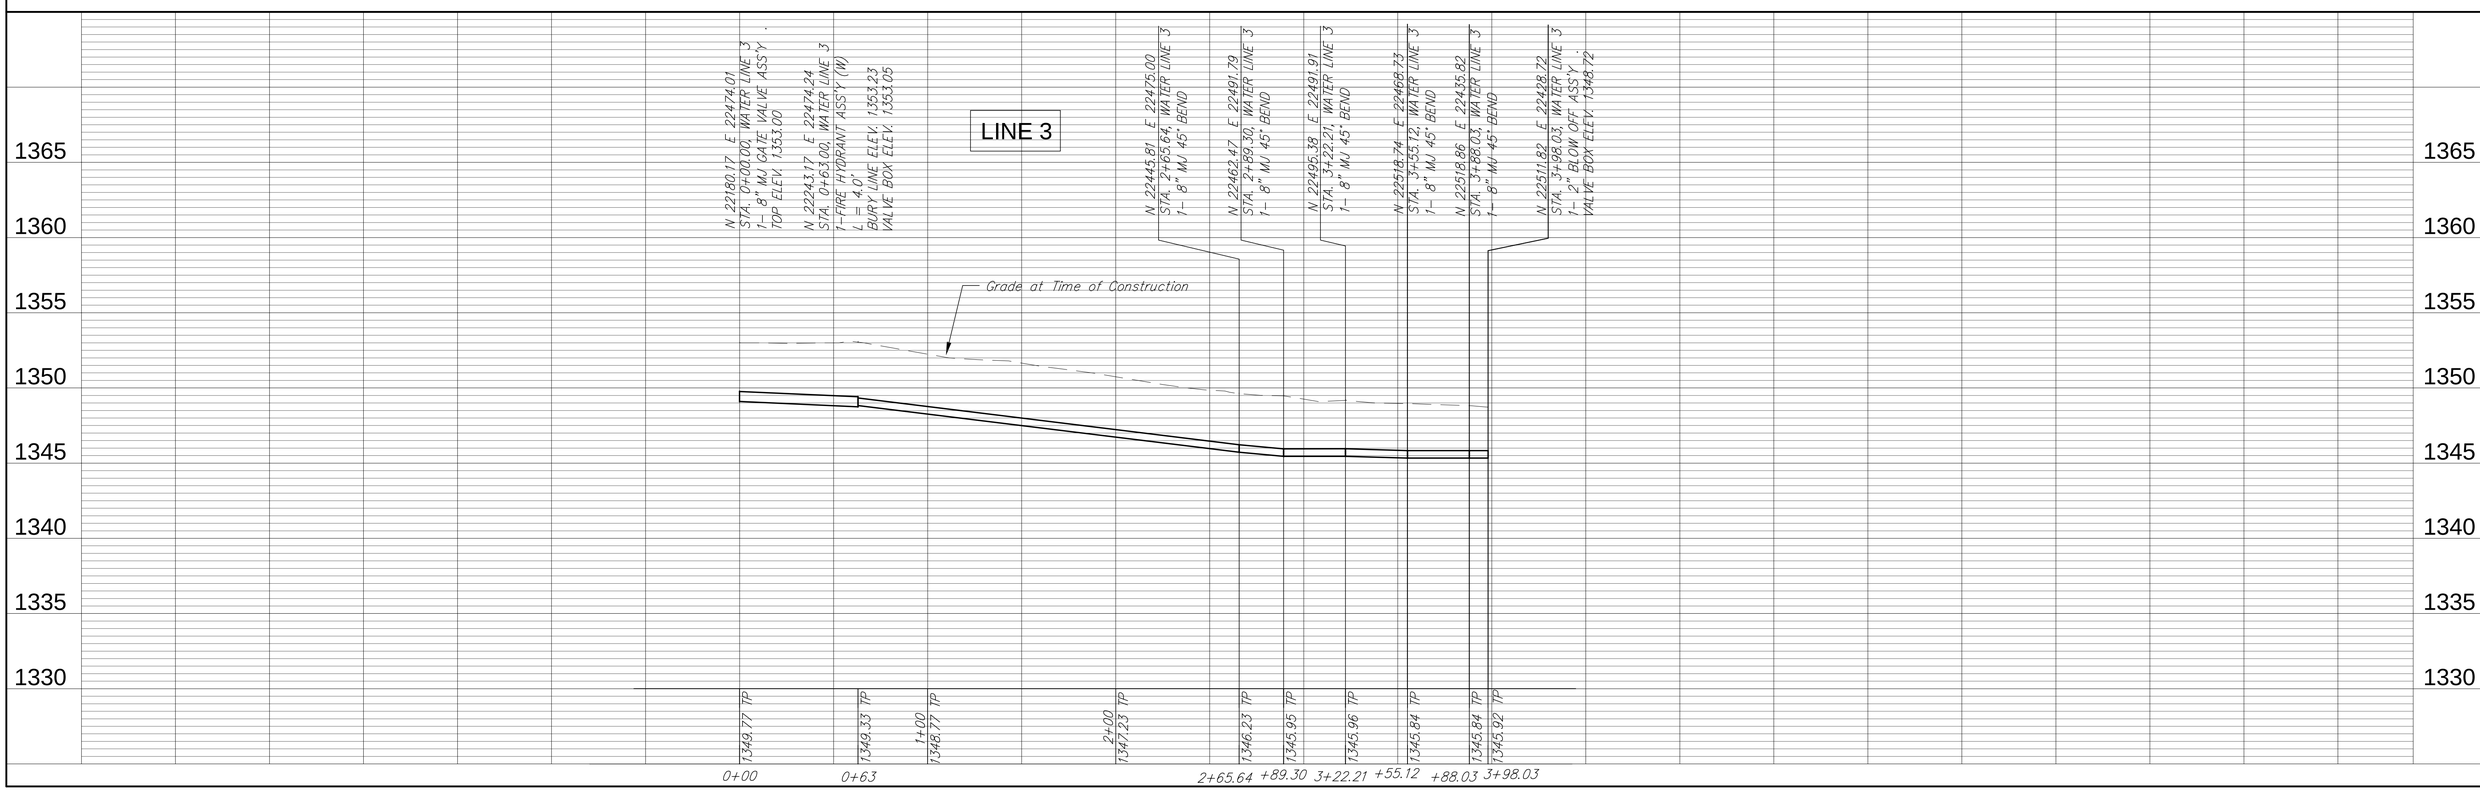

Ruggles & Bohm, P.A.
Engineering, Surveying, Land Planning
824 North Main
Wichita, Kansas 67203
(316) 264-4421
(316) 264-8021 fax
E-mail: info@rbkansas.com
www.rbkansas.com

DESIGN CMB	DRAWN RA
DATE Oct. 22, 2007	REVISED
UTILITY	REVIEW
PROJECT NUMBER 448-90297	DRAWING FILE Water Line 3

TARA CREEK ADDITION
WATER LINE 3
WICHITA KANSAS

RB JOB 3032E

SHEET 5 of 13