1942
N. ½ MARION RD. – E. L. MOSLEY TO W.L. WASHINGTON
CB + GTR ONLY
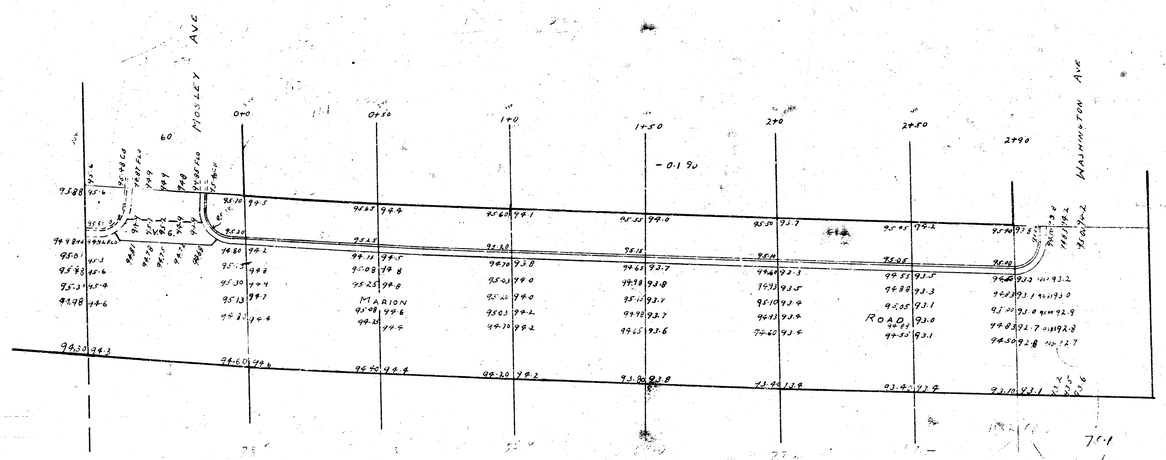
These are not intended to be a full & detailed survey but should be fairly accurate.