

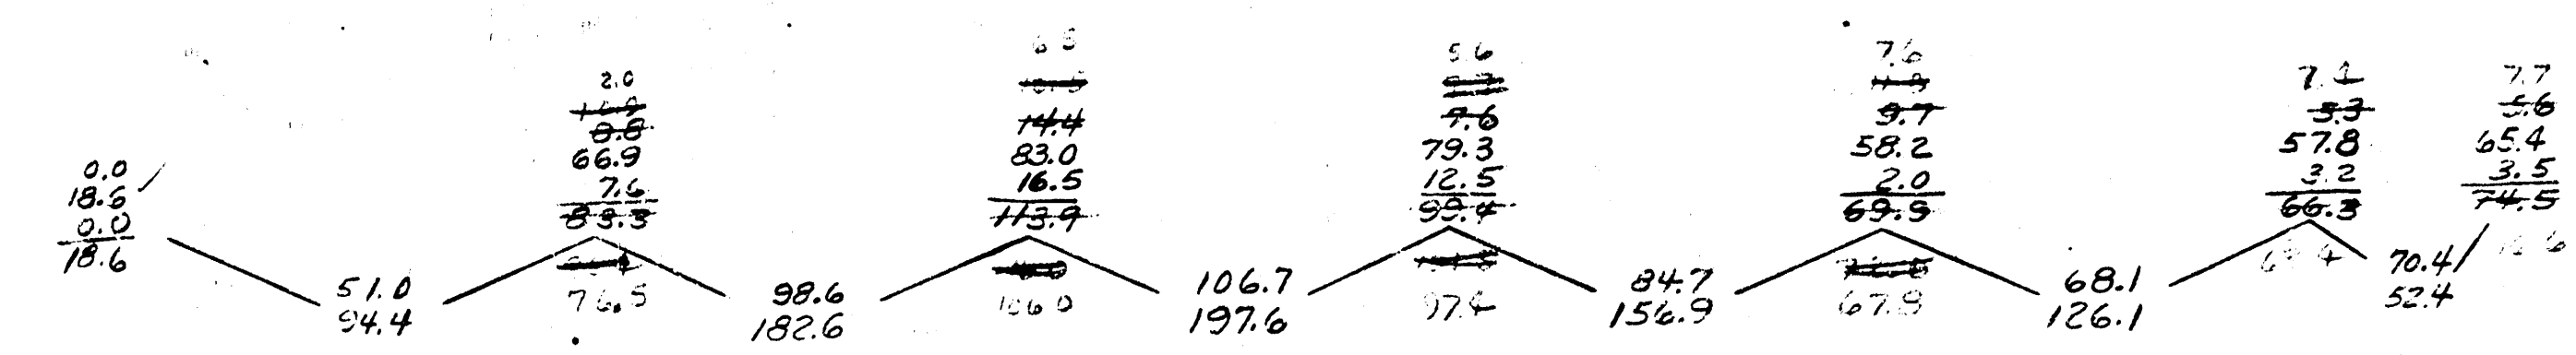
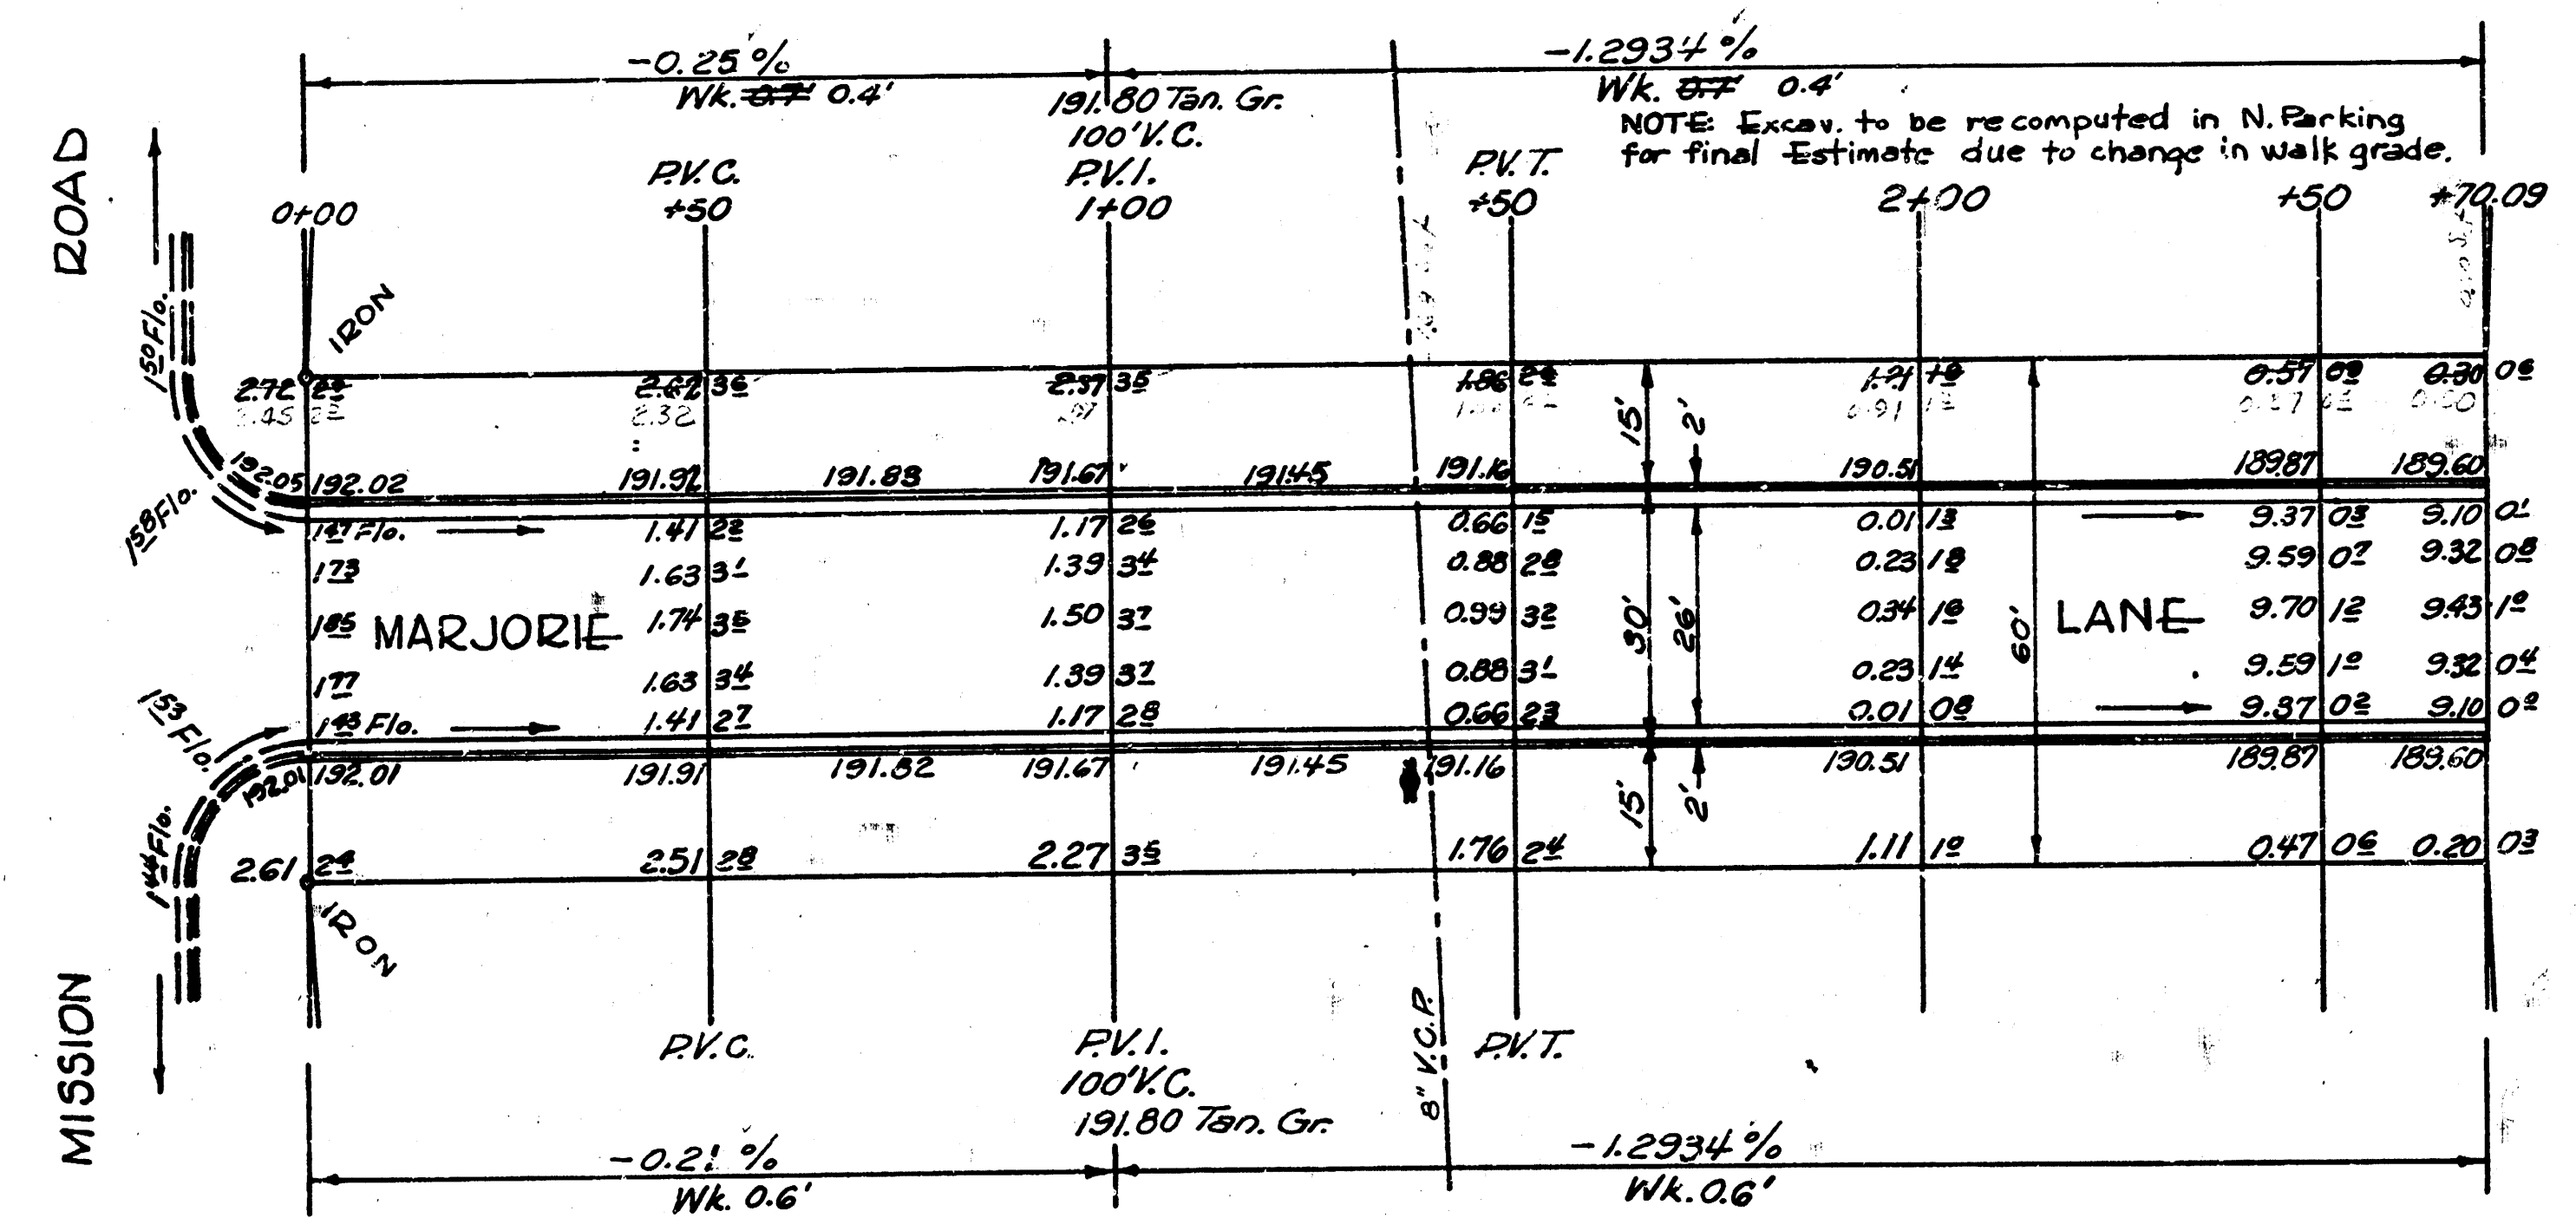


B.M. 188.49 RR Spike S.S. HLP N.S. Cresthill
150' W. of W.L. Brookfield.

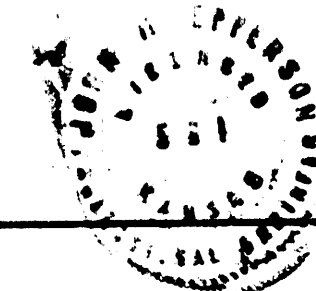

TOTAL EXCAV.	
PROP.	CITY
810.0	0
810.0	0
891.0 Cu.Yb.	0 Cu.Yb.

MARJORIE LANE
E.L. MISSION ROAD-W.L. BROOKFIELD ROAD
26'-2'-30' A.C.
CITY OF WICHITA, KANS.
B.E. SMITH CITY ENGINEER
MARCH 1957 PROJ. NO. C14-321

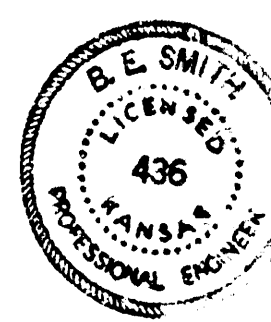

Surveyed by
Checked by
Bk 1367