


B.M. 198.71 S.E. Cor. Conc. Pk. South Side Stables
 B.M. 198.18 Spike in W. Face P.P. N. of Murdock
 B.M. 201.37 E.P. Spike W. Face P.P. S.W. Corner Woodlawn & 8th

Chaining From S. to N. & W. to E. on W. & N. 12.


NOTE:
 VERTICAL CURVE AT STA 4+50 WAS INCREASED
 TO 100' (ON JULY 15, 1954) TO ELIMINATE
 FLAT SPOT AT TOP OF CURVE.

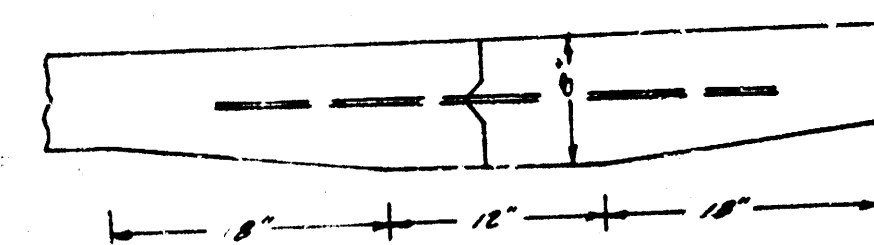

Use 1/4" bars, 3' long on 2'-6" centers

DETAIL OF MASTIC JOINT

Survey
 From
 1952
 Check
 1954

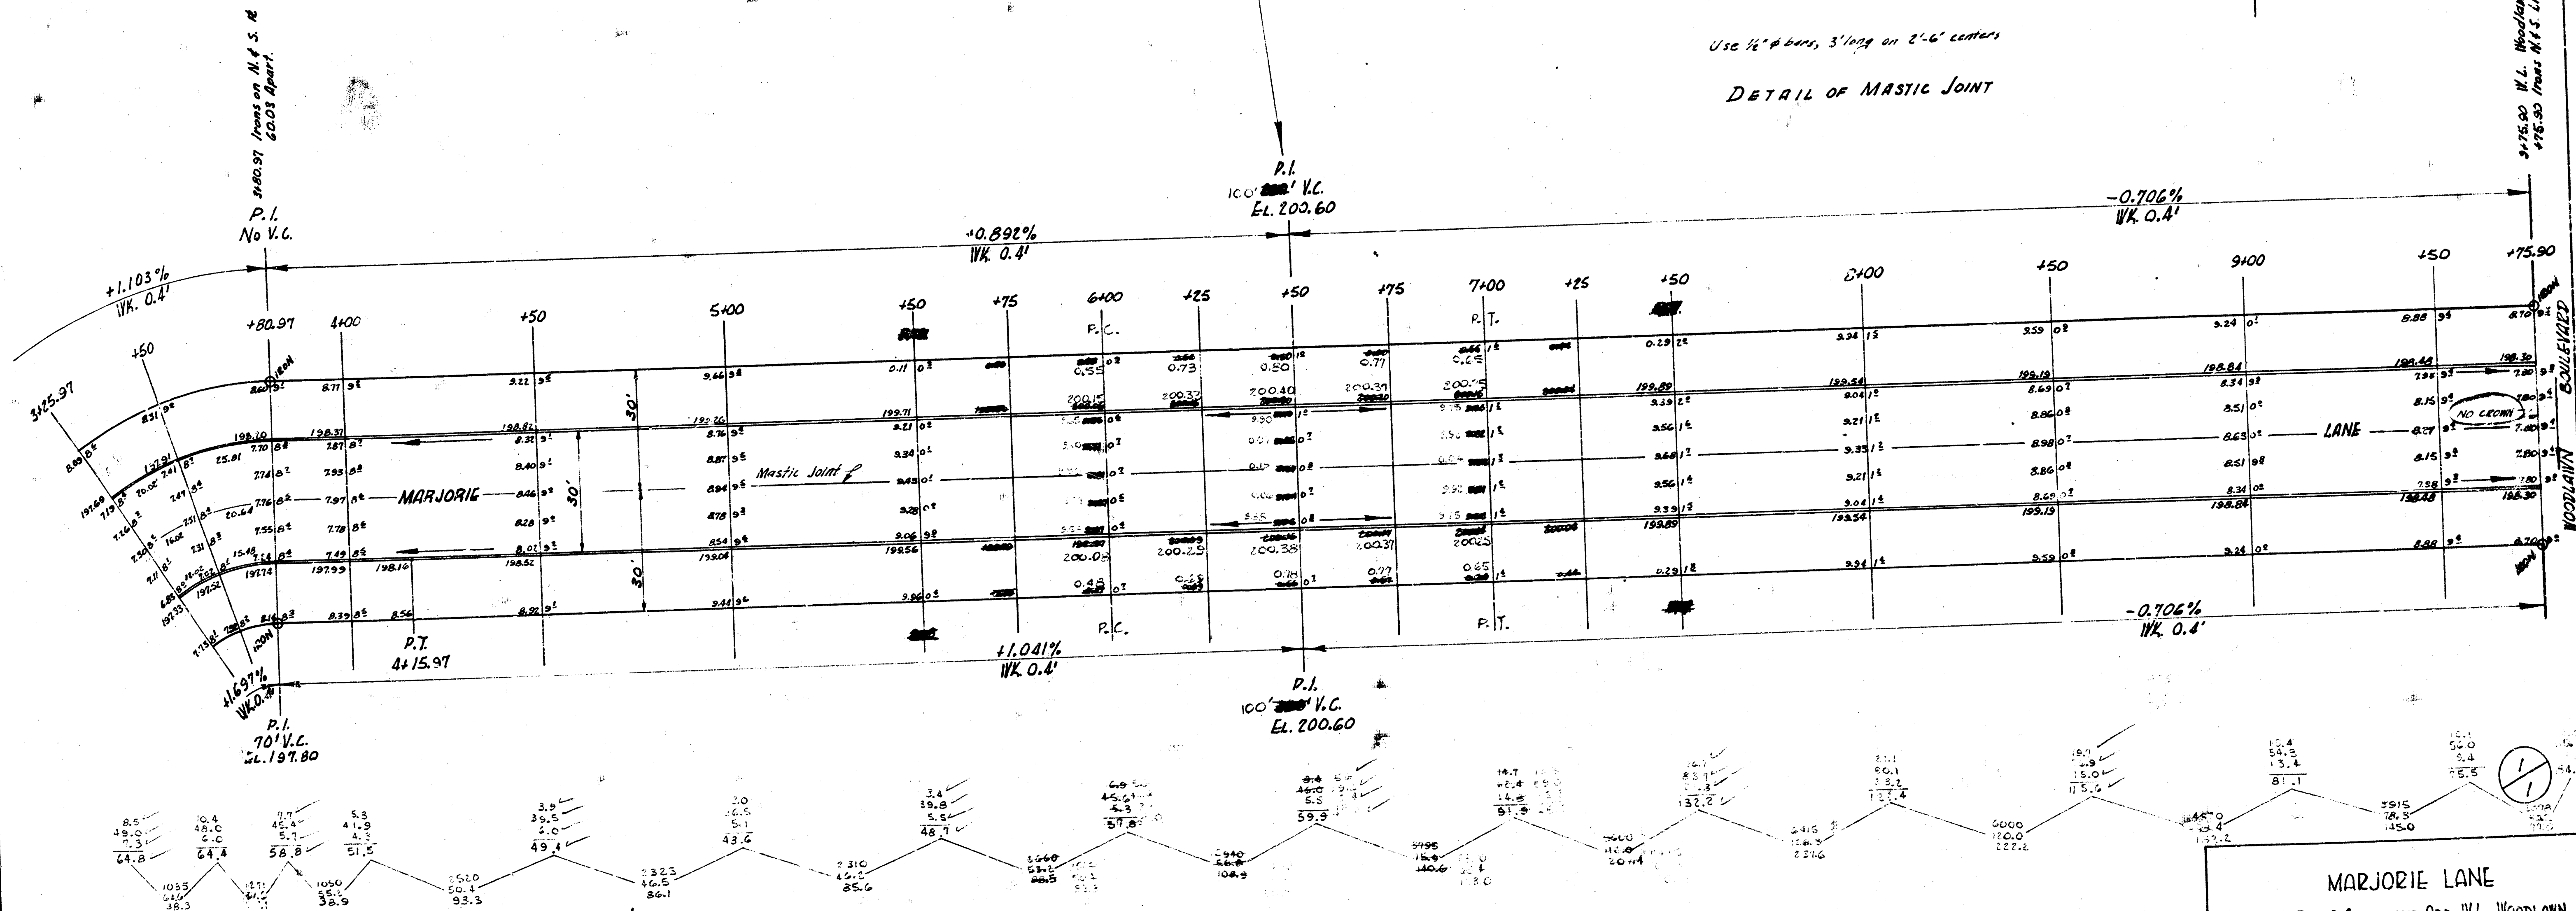

MARJORIE LANE
 W.L. Lot 22 Blk. 6 Courtland Add. - W.L. Woodlawn
 30' CONC. & CB.
 CITY OF WICHITA, KANS.
 B.E. SMITH CITY ENGINEER
 APRIL, 1954 PROJ. NO. C14-64



TOTAL EXCAV.
 1800.7
