



 722.6 cu. yds.

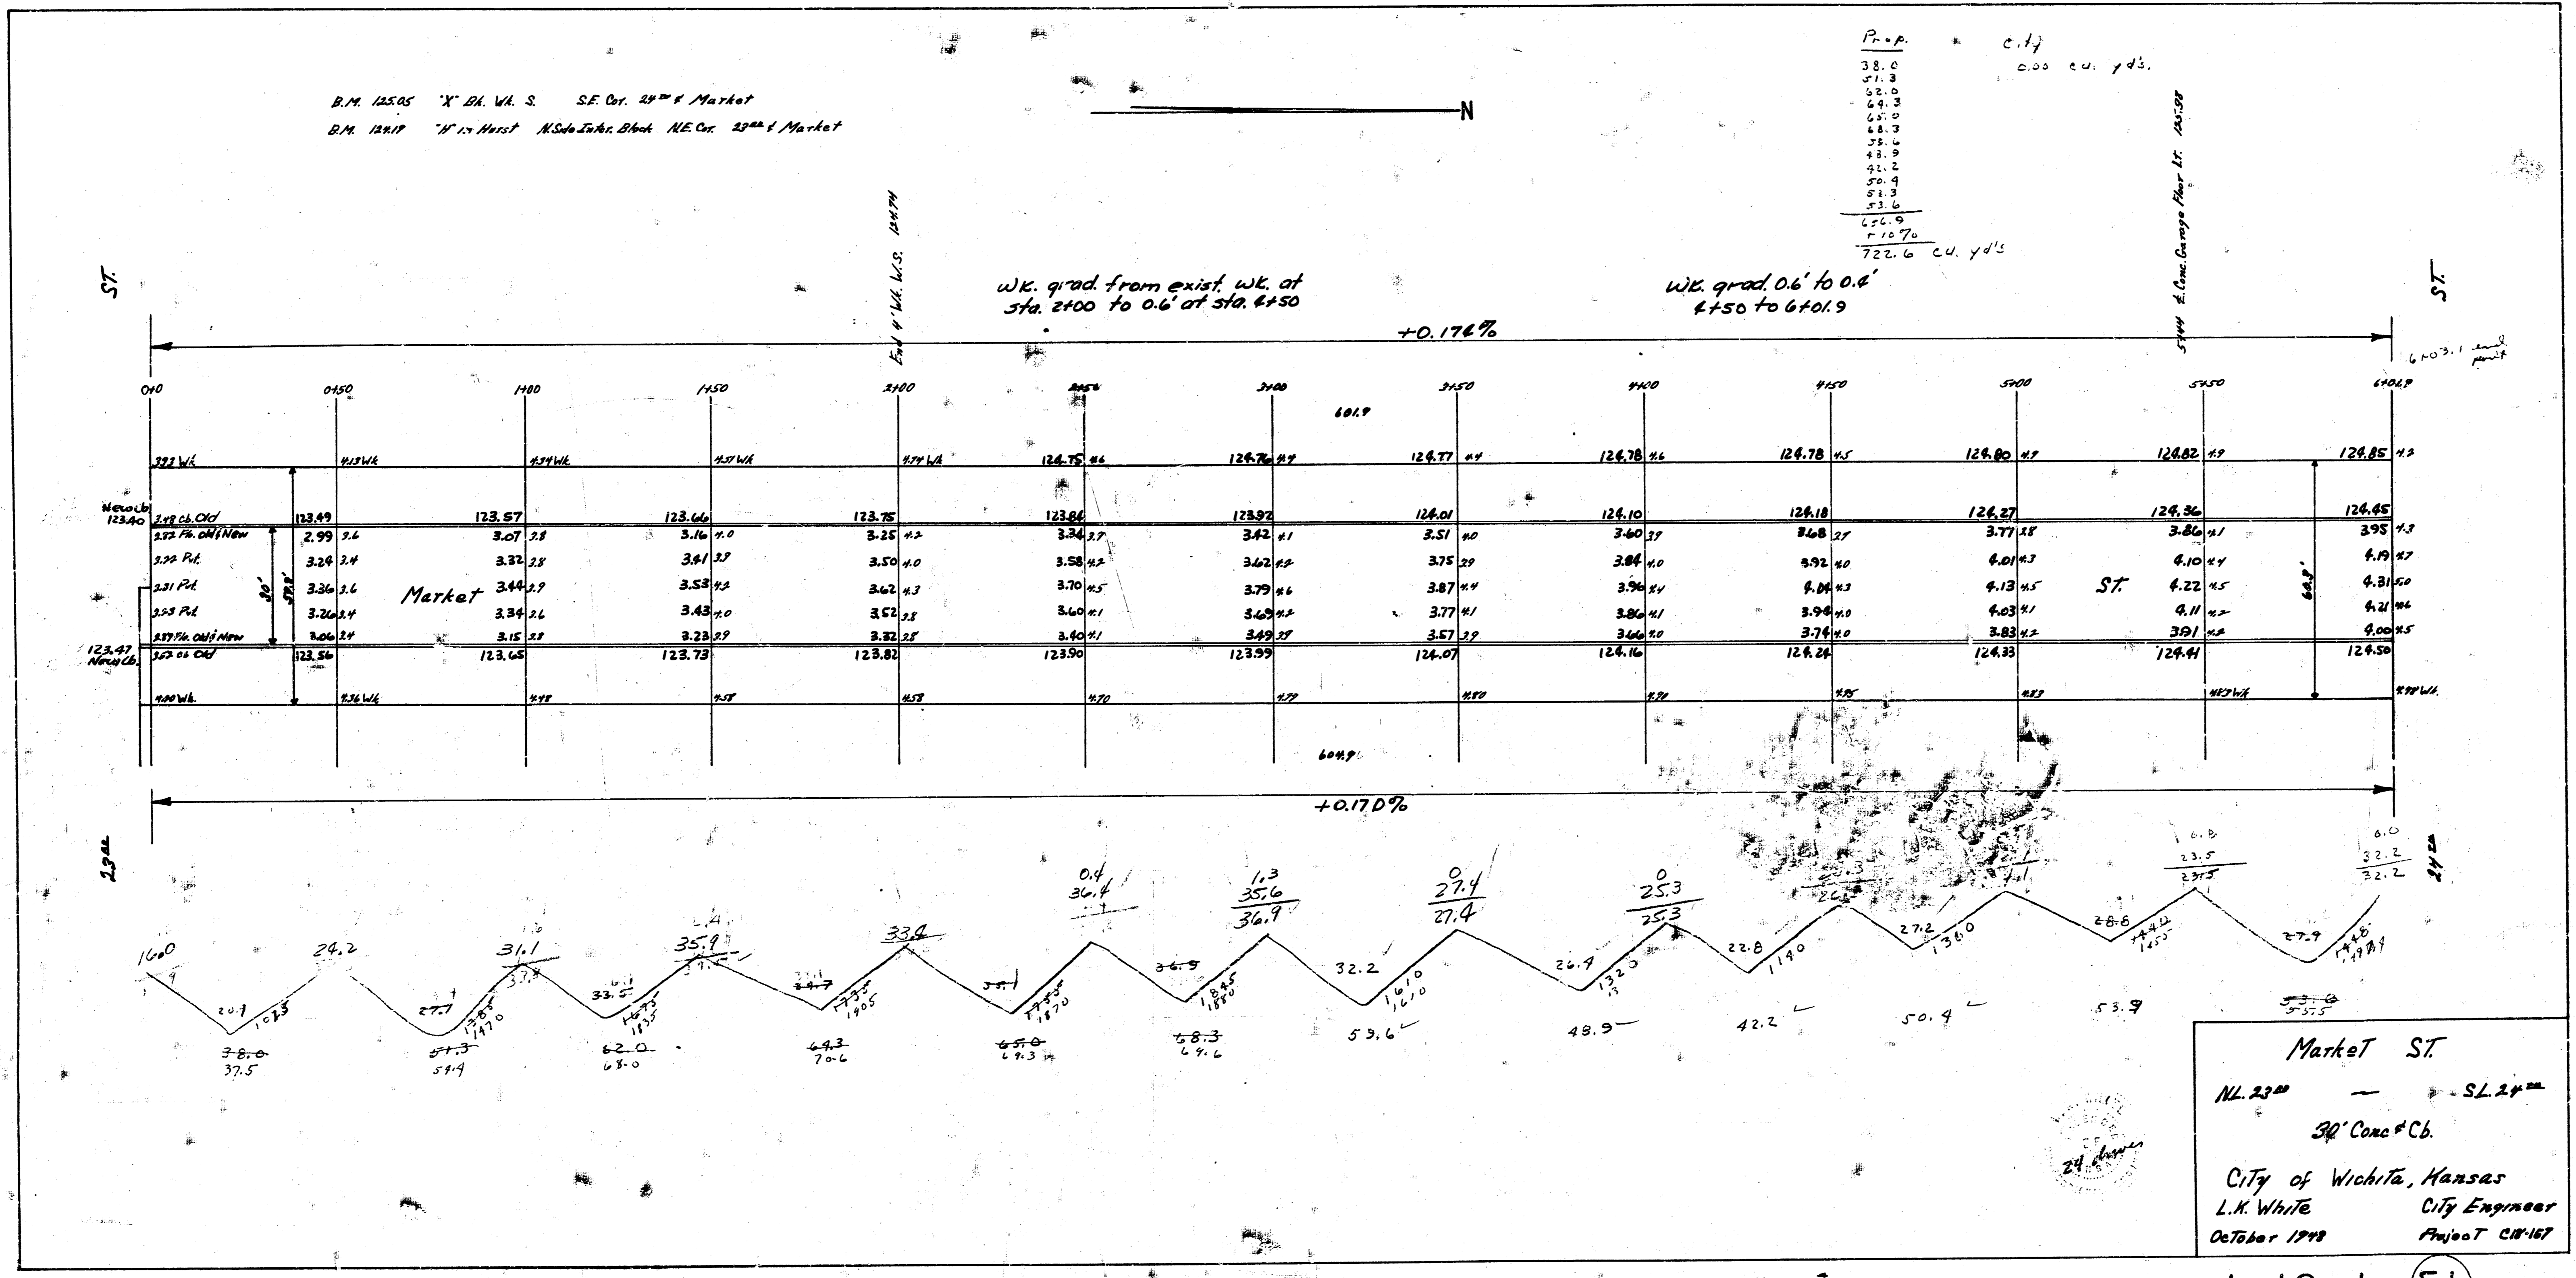

Market St  
 N.L. 23<sup>rd</sup> - S.L. 24<sup>th</sup>  
 30' Conc. & Cb.  
 City of Wichita, Kansas  
 L.K. White City Engineer  
 October 1948 Project CR-167

4 12 1 (51)