


B.M. 9730 S.E. Cor. Conc. Porch No. #1502 W 30th St. So.
B.M. 9902 S.E. Cor. Conc. Porch No. #2915 S. Elizabeth.

Sta. 4 Baseline on W. 12 of Martinson from Sta. 0+00 to Sta. 14+64.50;
Sta. on 6' Offset from W. Co. Sta. 14+64.90 to Sta. 16+17.56

PROP. EXCAV.
13371.5 Cu Yd.

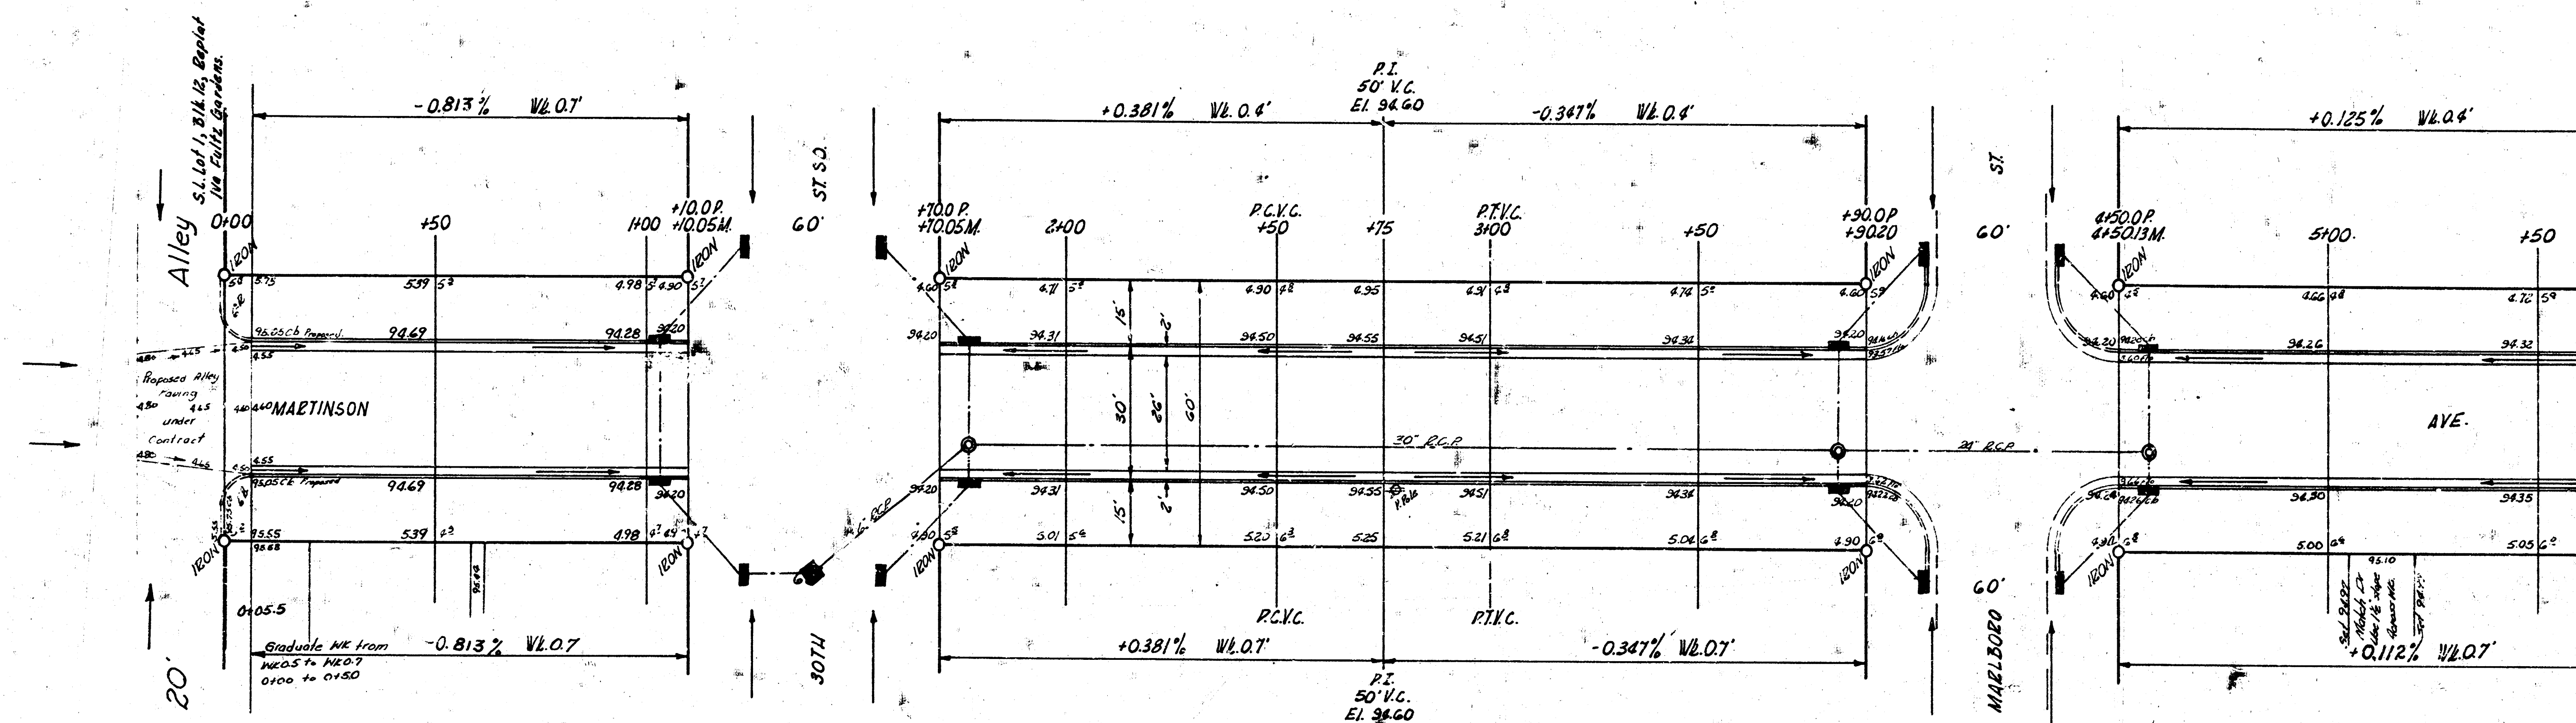

MARTINSON AVE.
S.L. REGAL - S.L. LOT 1, BLK. 12,
REPLAT IVA FULTZ GARDENS
26'-2'-30' A.C.

CITY OF WICHITA, KANS.

B.E. SMITH


CITY ENGINEER

Aug., 1956

PROJ. NO. C14-204


TOTAL PROP. EXCAV.
13371.5
-10% 1227.6
1227.6



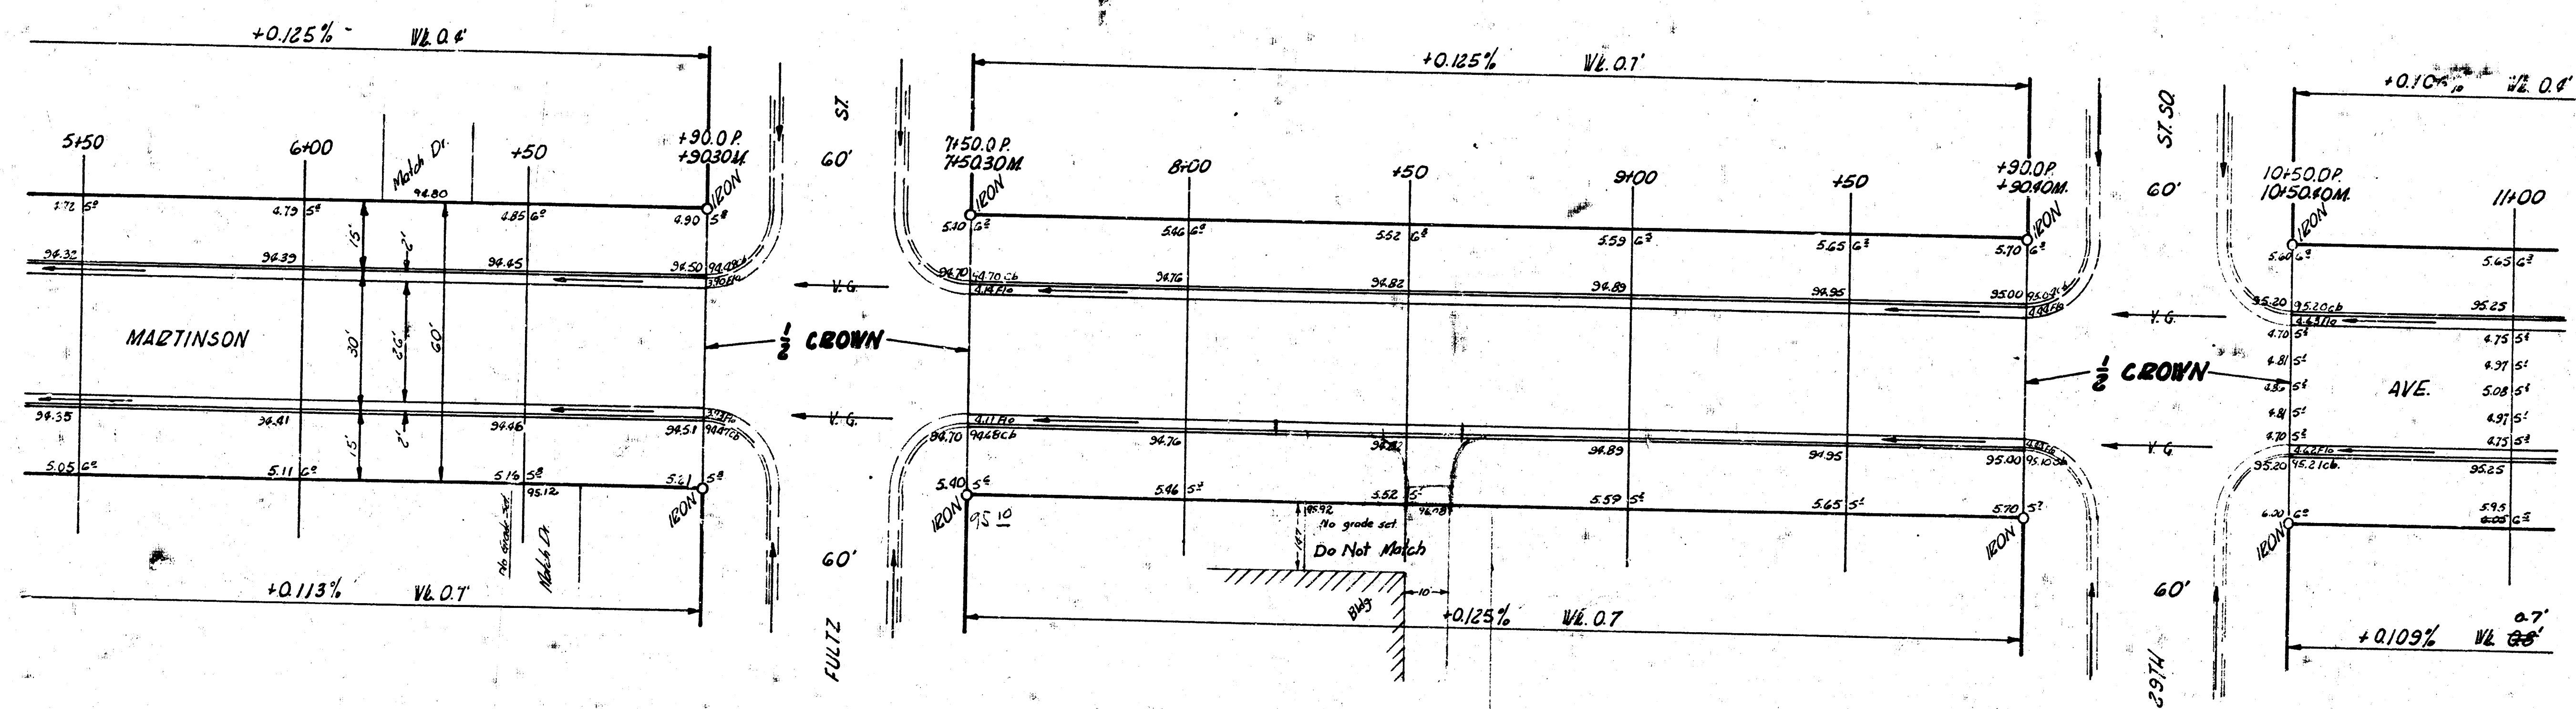

MARTINSON AVE.
PROJ. NO. C14-204

NOTE: Original walk grade set 0.4 raised walk grade to 0.7 to help drives poured to high.

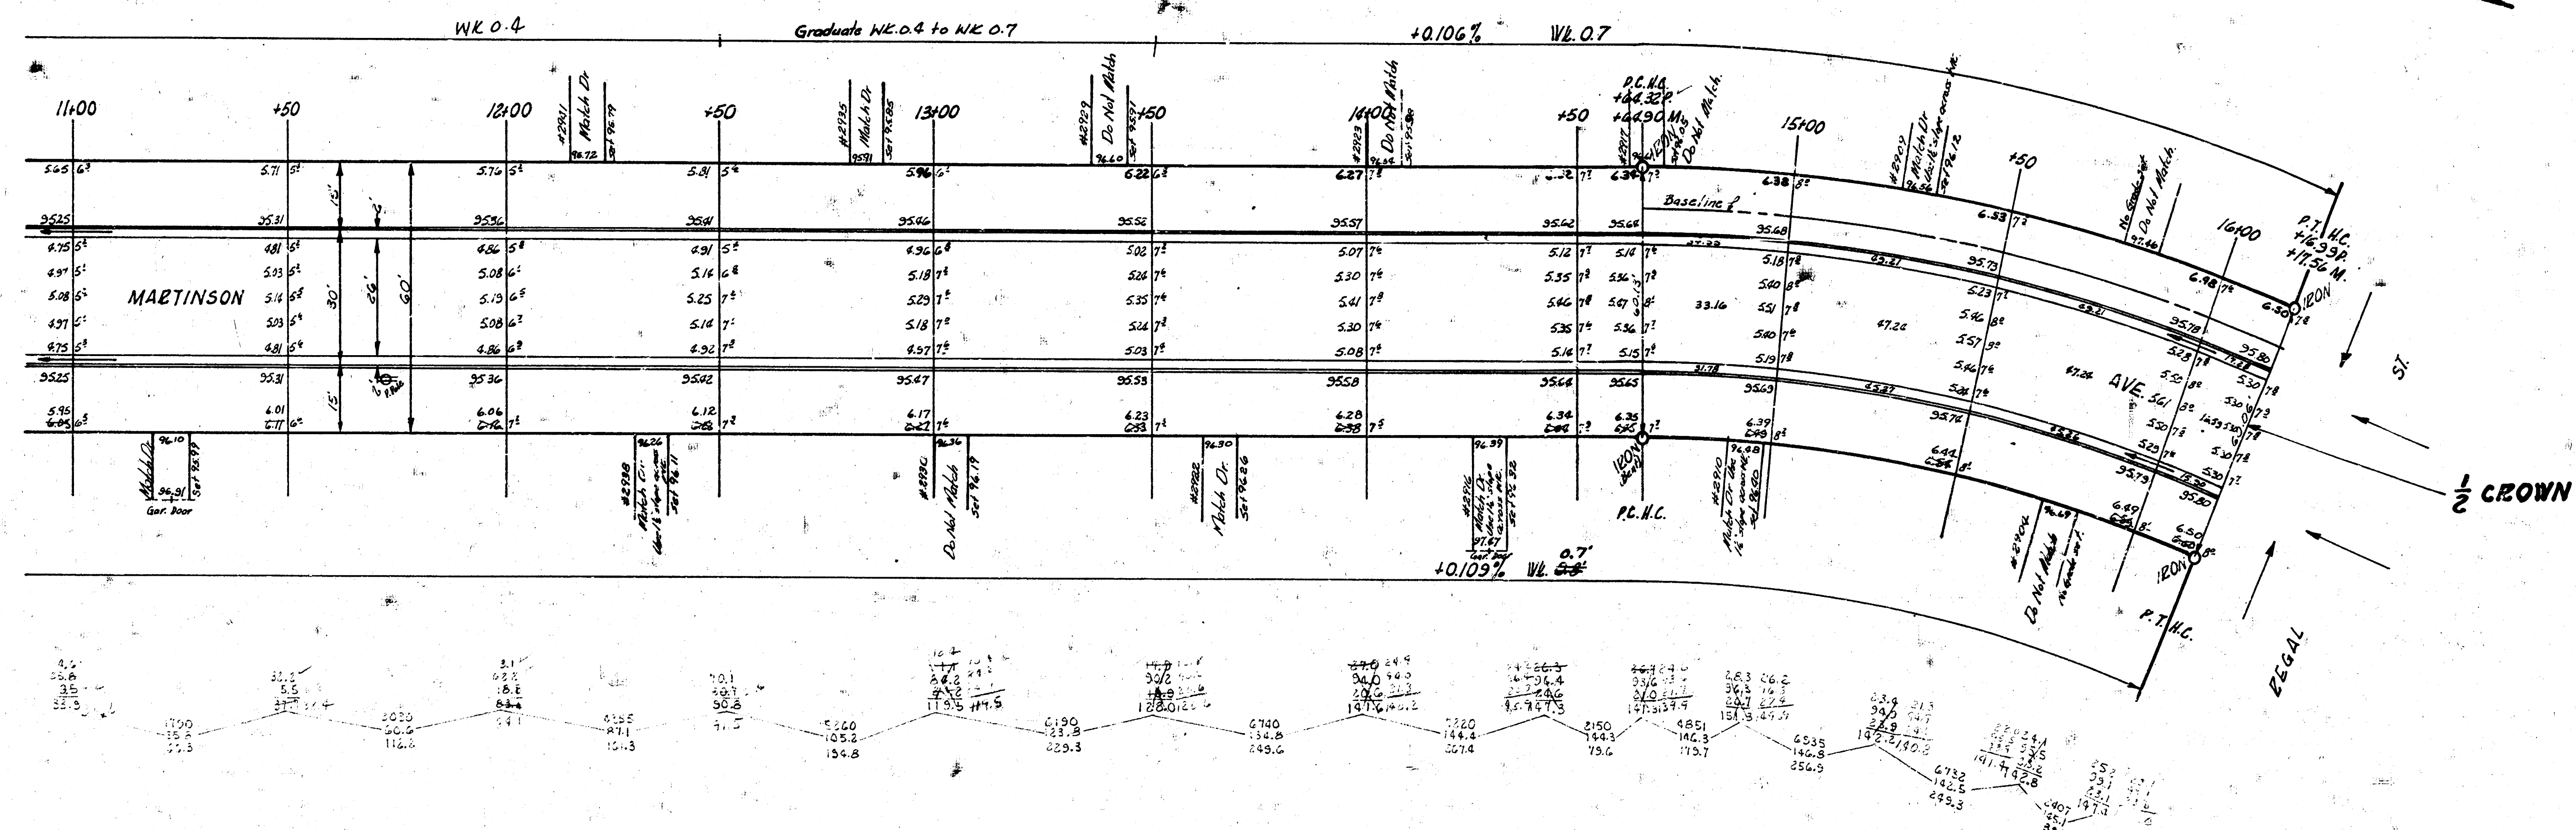

CURVE DATA FROM STA 14+64.30 TO STA 14+175.6					
Sta on S Offset M.C. 2+380.5, 1" = 25'					
Sta	Chord Length	Chord Offset	Deflection Angle	Tan. Length	Deflection
14+64.30					
15+00	35.09	3/21	2° 38' 33"	2° 38' 33"	
150	43.52	46.45	3° 45' 59"	2° 54' 38"	
1610'	43.37	44.45	3° 46' 00"	10° 10' 38"	
1756	17.54	15.02	1° 12' 22"	11° 30' 00"	

MARTINSON AVE
FEB 1954