

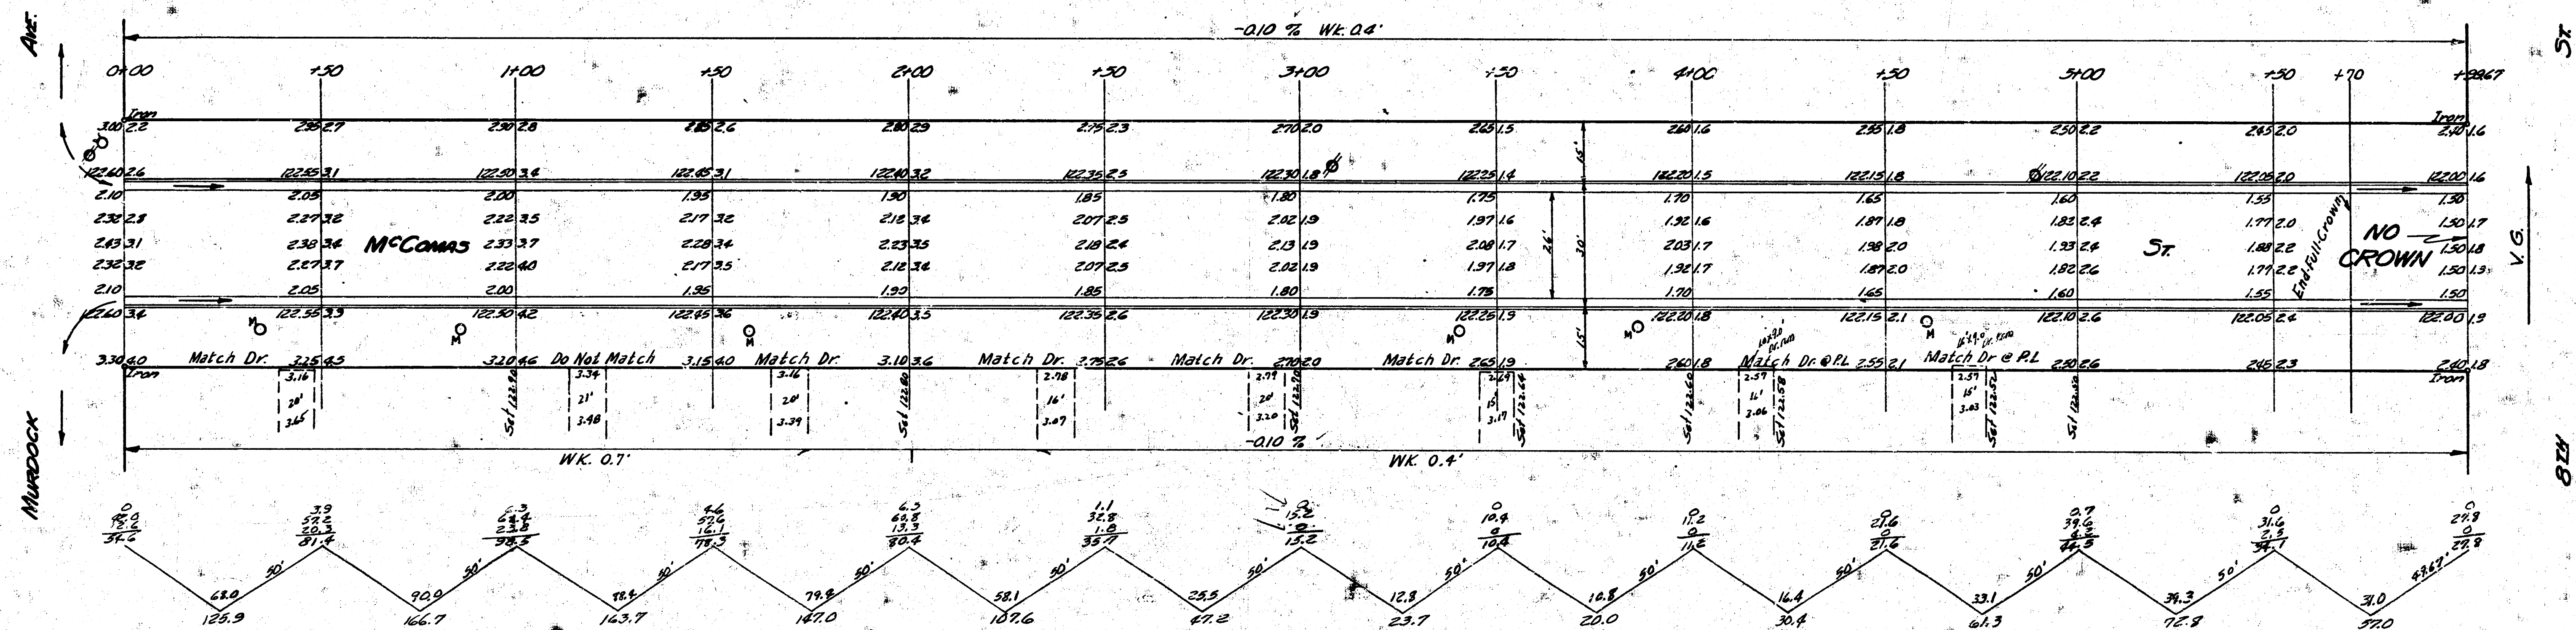


B.M. 12324 S.E. Cor. Conc. Patch House #3830 N. 8th
Stationing on W.E.

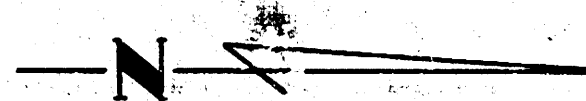

Excavation City Prop. City
10233 182.3 1123.6 cu yds

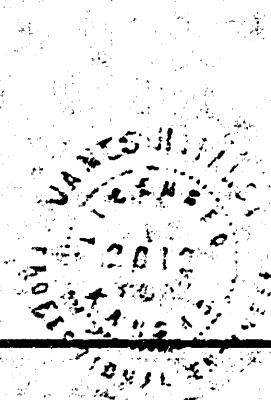

MCCOMAS
N.L. MURDOCK TO S.L. 8TH
26-2-30 A.C.
CITY OF WICHITA KANSAS
B.E. SMITH CITY ENGINEER
JAN. 1955 Plan No. CM-228