

Stationing on E


Ties to L. n. & McCormick & WLM S. Lean
5.45 E.N.E. to + in pvt. on E west
22.70 S.E. to + on top of curb
23.40 N.E. to + on top of curb

Ties to witness iron on true E McCormick 7541 W. of E. Rt/Wy iron.
327 W to Edge E rail Midland Valley RR.
1147 N.W. to joint E rail of RR



Survey JX Bk 93Y
Plan DS.
Exc DS.
Checked H

John - 6-2-2-79
Sporon - 6-2-2-14.

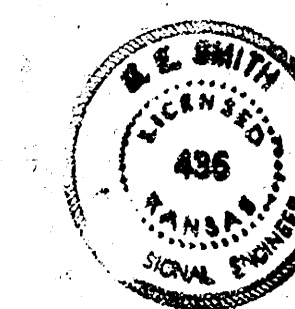

MCCORMICK
WLMLEAN TO ELMIDLAND VALLEY
30' CONCRETE+CURB
CITY OF WICHITA
BESMITH CITY ENGINEER
APRIL 1954 PROJECT C13-248

