


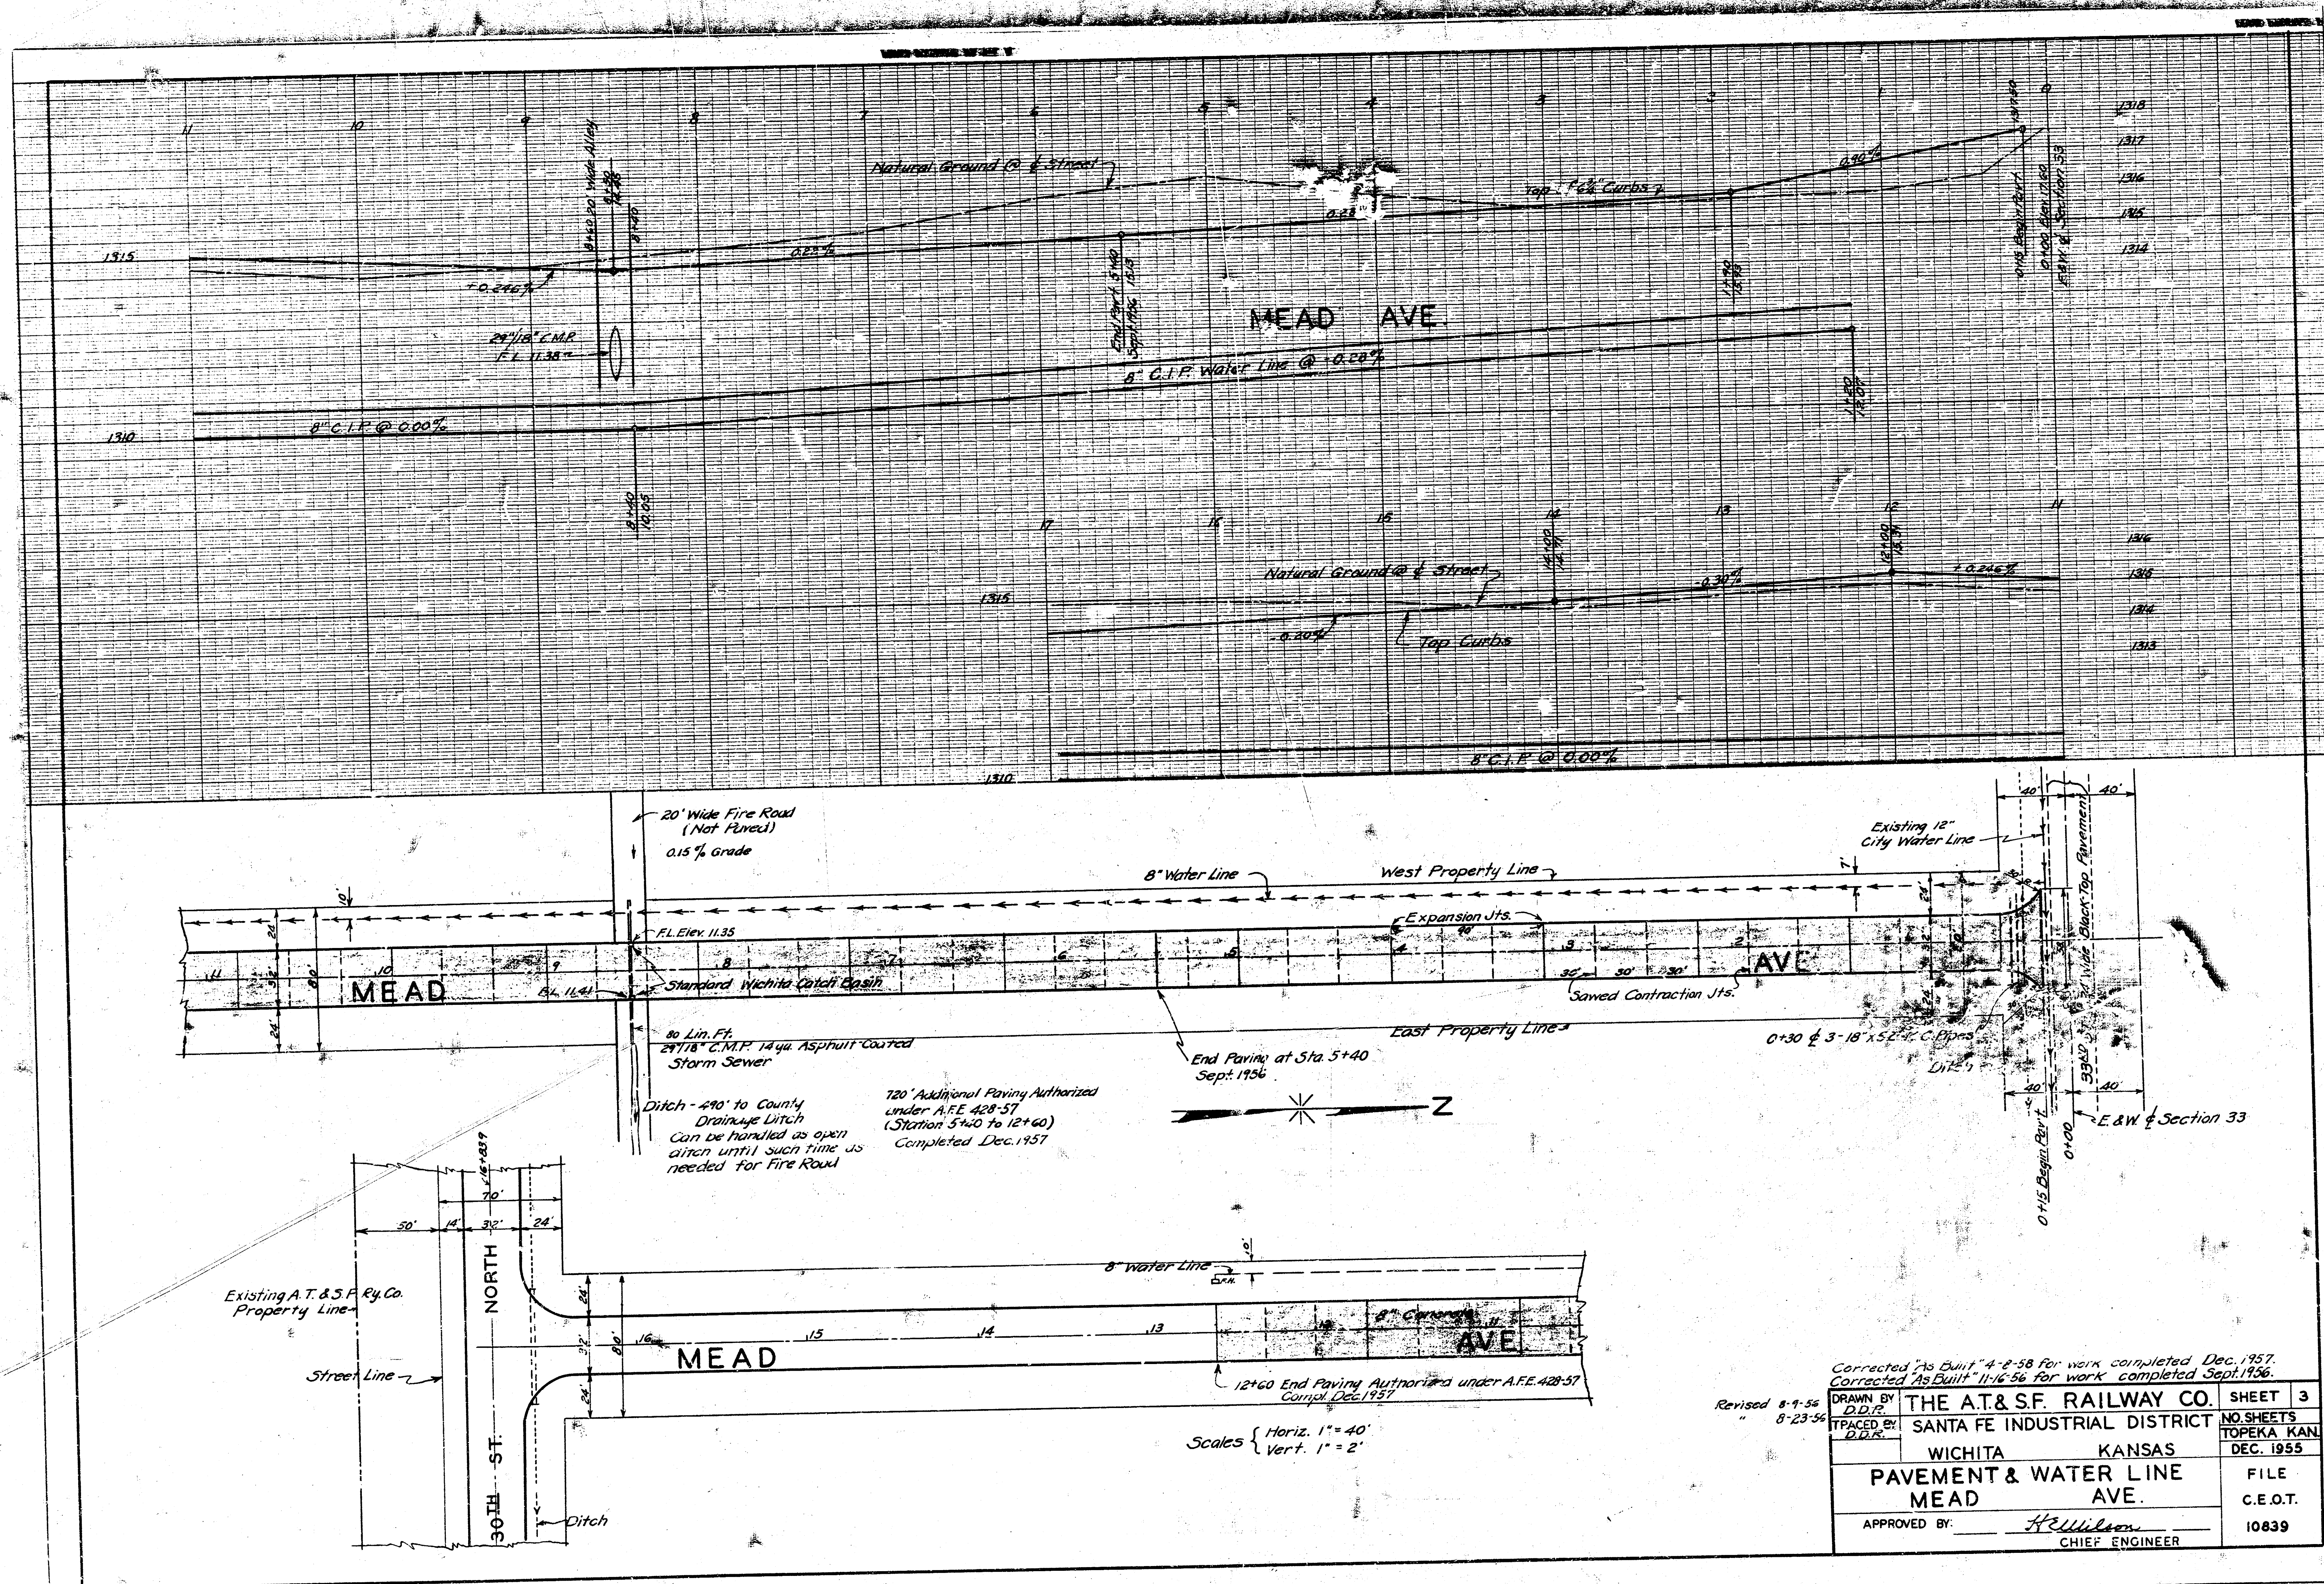

Santa Fe - THE ATCHISON, TOPEKA AND SANTA FE RAILWAY COMPANY

OPERATING DEPARTMENT - P.O. Box 1738 900 Jackson Street, Topeka, Kansas 66601 - S13 234 0481

September 8, 1972
210441

Mr. Darrell R. Brewer
Right-of-Way & Estimating Engineer
City of Wichita
104 South Main
Wichita, Kansas 67202

Dear Mr. Brewer:

Enclosed as per your request are "as built" plans of
Mead Avenue, C.E.O.T. Drawing No. 10339, Sheets 3 and 7.

Very truly yours,
C. L. Holman
Asst. Gen. Mgr.-Engr.

encl.

cc: Mr. W. C. Merritt

