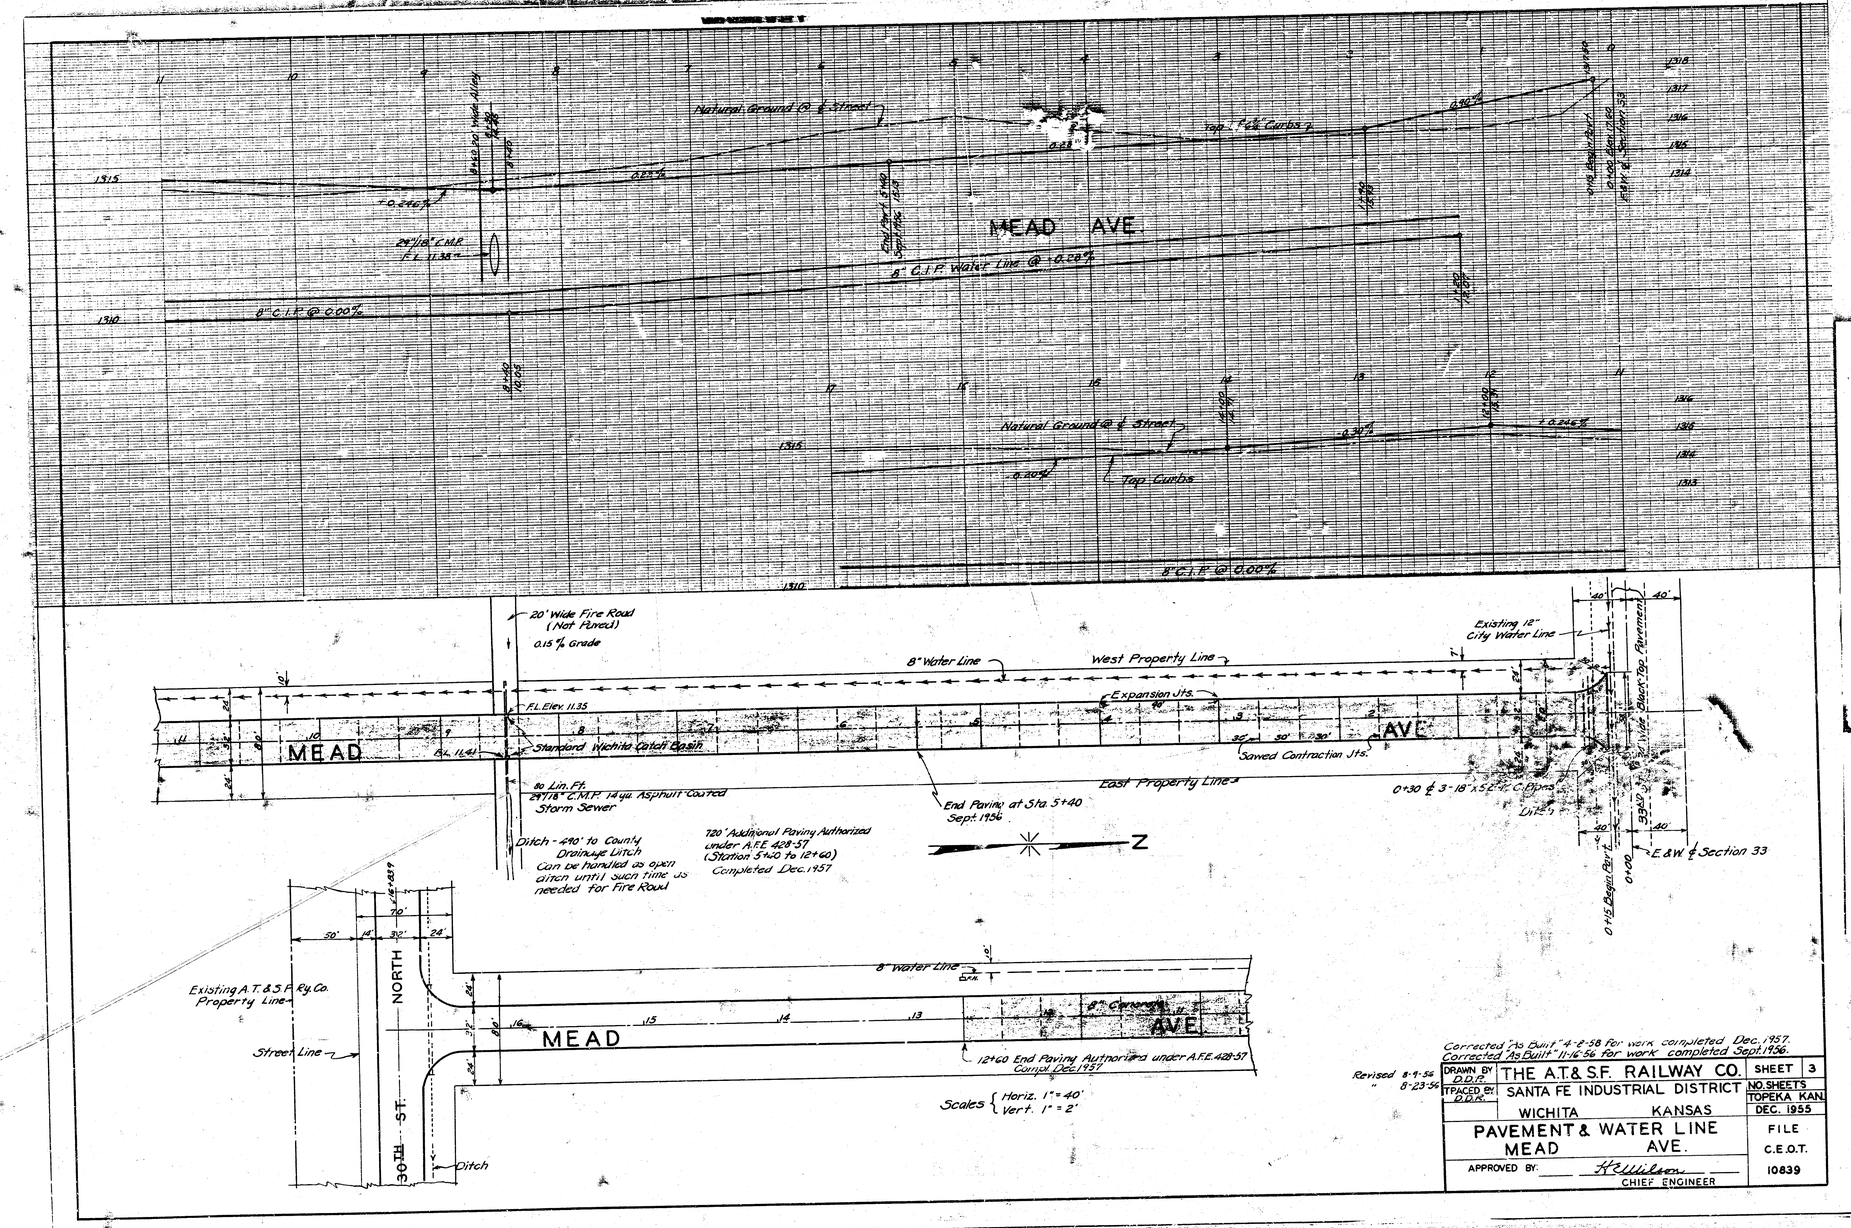

Santa Fe – THE ATCHISON, TOPEKA AND SANTA FE RAILWAY COMPANY

OPERATING DEPARTMENT • P.O. Box 1738 900 Jackson Street, Topeka, Kansas 66601 • 913 234-0481

September 8, 1972

210441

Mr. Darrell R. Brewer
Right-of-Way & Estimating Engineer
City of Wichita
104 South Main
Wichita, Kansas 67202

Dear Mr. Brewer:

Enclosed as per your request are "as built" plans of Meade Avenue, C.E.O.T. Drawing No. 10339, Sheets 3 and 7.

Very truly yours,

C. L. Holman

C. L. Holman
Asst. Gen. Mgr.-Engr.

encl.

cc: Mr. W. C. Merritt

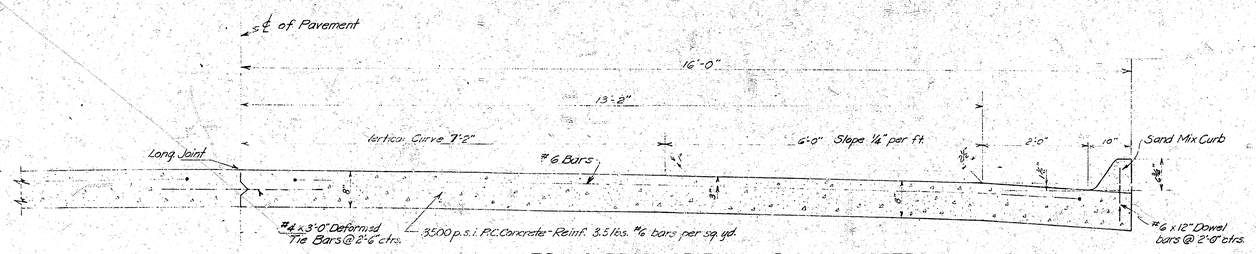

TRANSVERSE SECTION — P.C. CONCRETE
NO SCALE

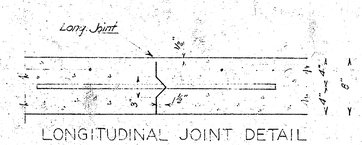

LONGITUDINAL JOINT DETAIL

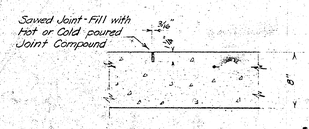

CONTRACTION JOINT DETAIL

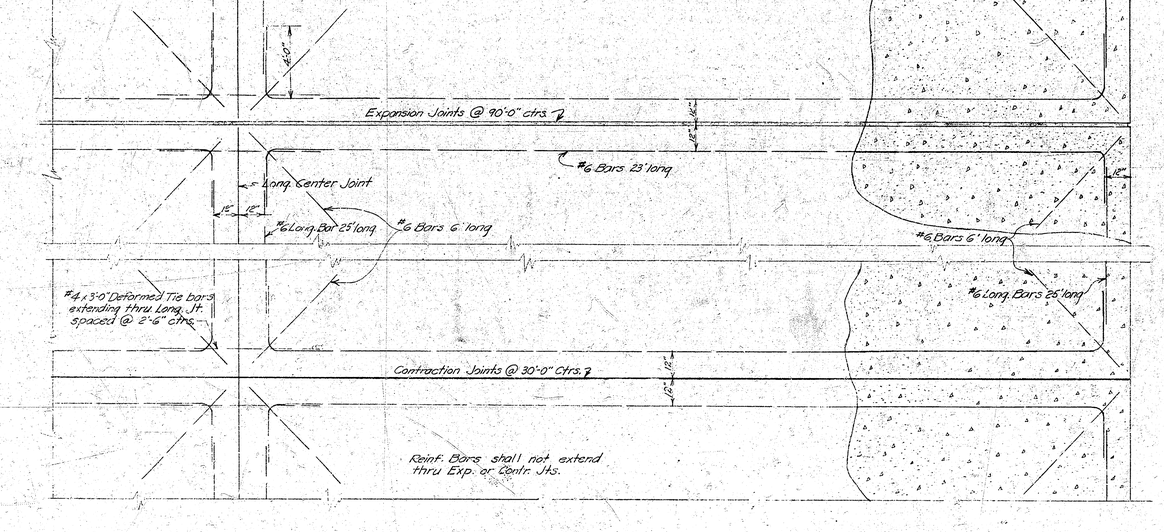

PLAN
NO SCALE

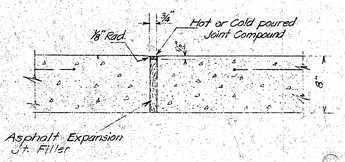

EXPANSION JOINT DETAIL

NOTE: All work in connection with this paving shall comply with Standard Specifications of the City of Wichita, Kansas for 3" concrete pavement.

Corrected for work Completed Dec. 1957
Corrected "As Built" 11-17-1958 (Contract No. [illegible])

Revised July 21, 1957

DRAWN BY D.D.R.	THE A.T.&S.F. RAILWAY CO.	SHEET 7
	SANTA FE INDUSTRIAL DISTRICT	NO. SHEETS
	WICHITA KANSAS	TOPEKA, KANSAS AUGUST 1956
	PAVEMENT DETAILS	FILE C.E.O.T. 10-33.
APPROVED:	A. E. Williams CHIEF ENGINEER	