

NOTE
 This sheet to be used for
 Vertical Curve at R.R. only

2-A
 2


MERIDIAN AVE
 ST. MARIE TO AL. UNIVERSITY
 30' CONC. & C.C.
 CITY OF WICHITA KANS
 L. WHITE CITY ENGR.

153

Book 19

BM 11137 STANDARD NE CORNER MERIDIAN & MAPLE
BM 11325 " IN TROY TOP FIRE PLUG N.W. COR. UNIVERSITY & MERIDIAN

Property	City	Property
13.5	162.2	2770
30.4	217	816.5
45.4	11.8	710.5
41.7	10.4	710.9

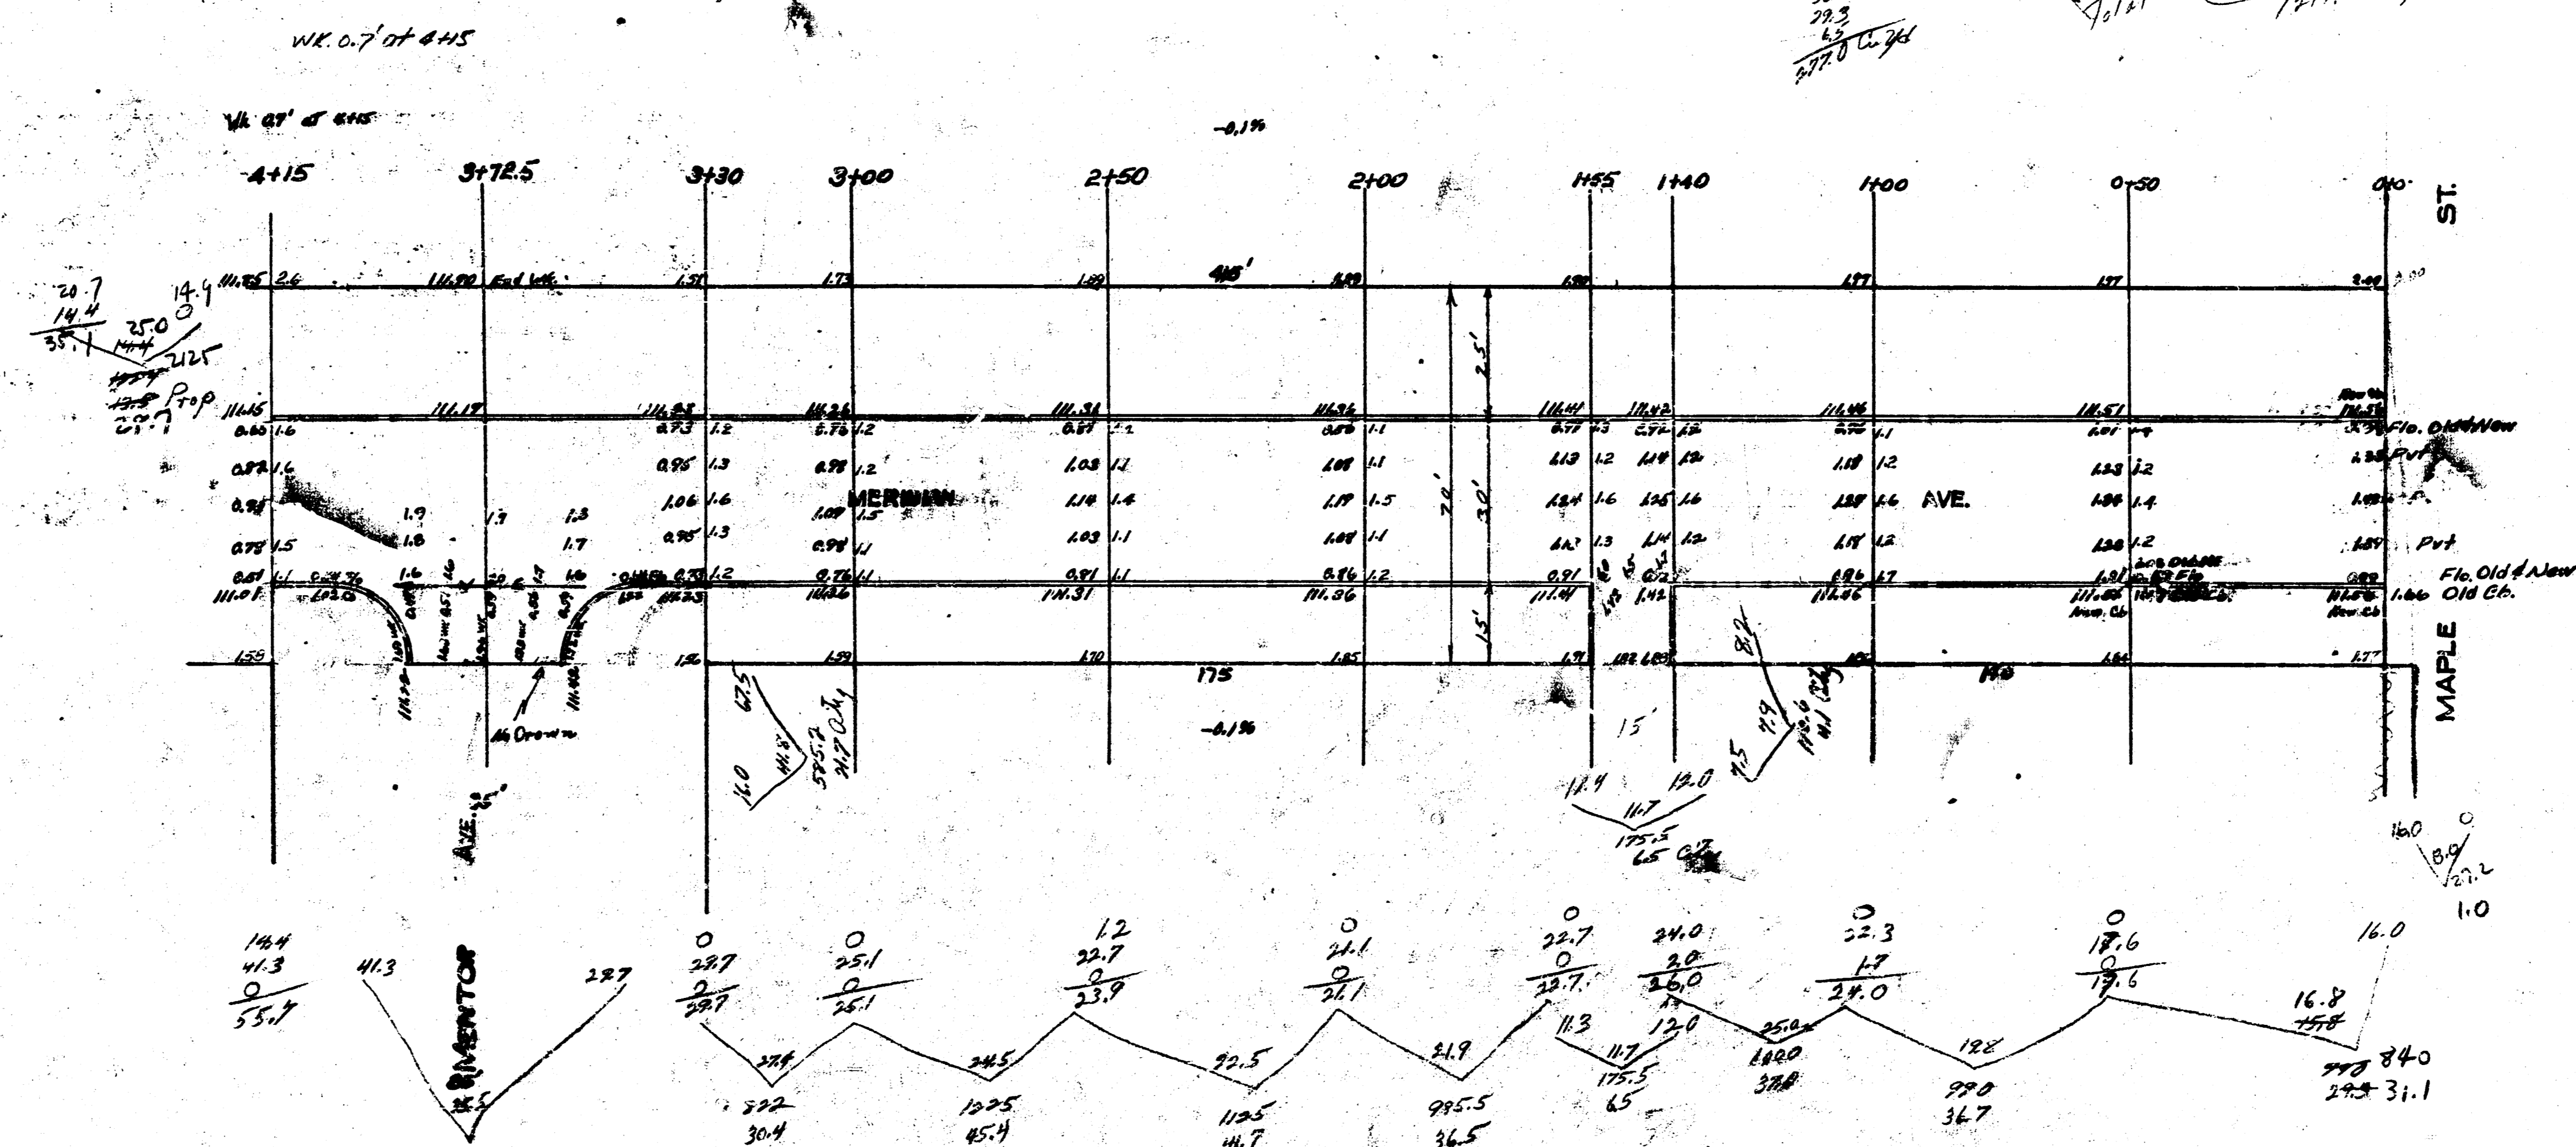

MERIDIAN AVE
 30' CONC. CURB
 CITY OF WICHITA, KANSAS
 L.K. WHITE
 CITY ENGINEER
 JULY 1997

1
2

12 sheets

