


B.M. 103.87 W.L. Geo. Wash. Ave. @ Mesita "G" in Globe S. Co.  
 B.M. 104.10 Geo. Wash. Blvd @ N.L. Rivers "X" on W. Edge Prt.

-0.107%  
 WK 0.4'

171.4  
 17.1  
 +1.1 188.5 c/ds.

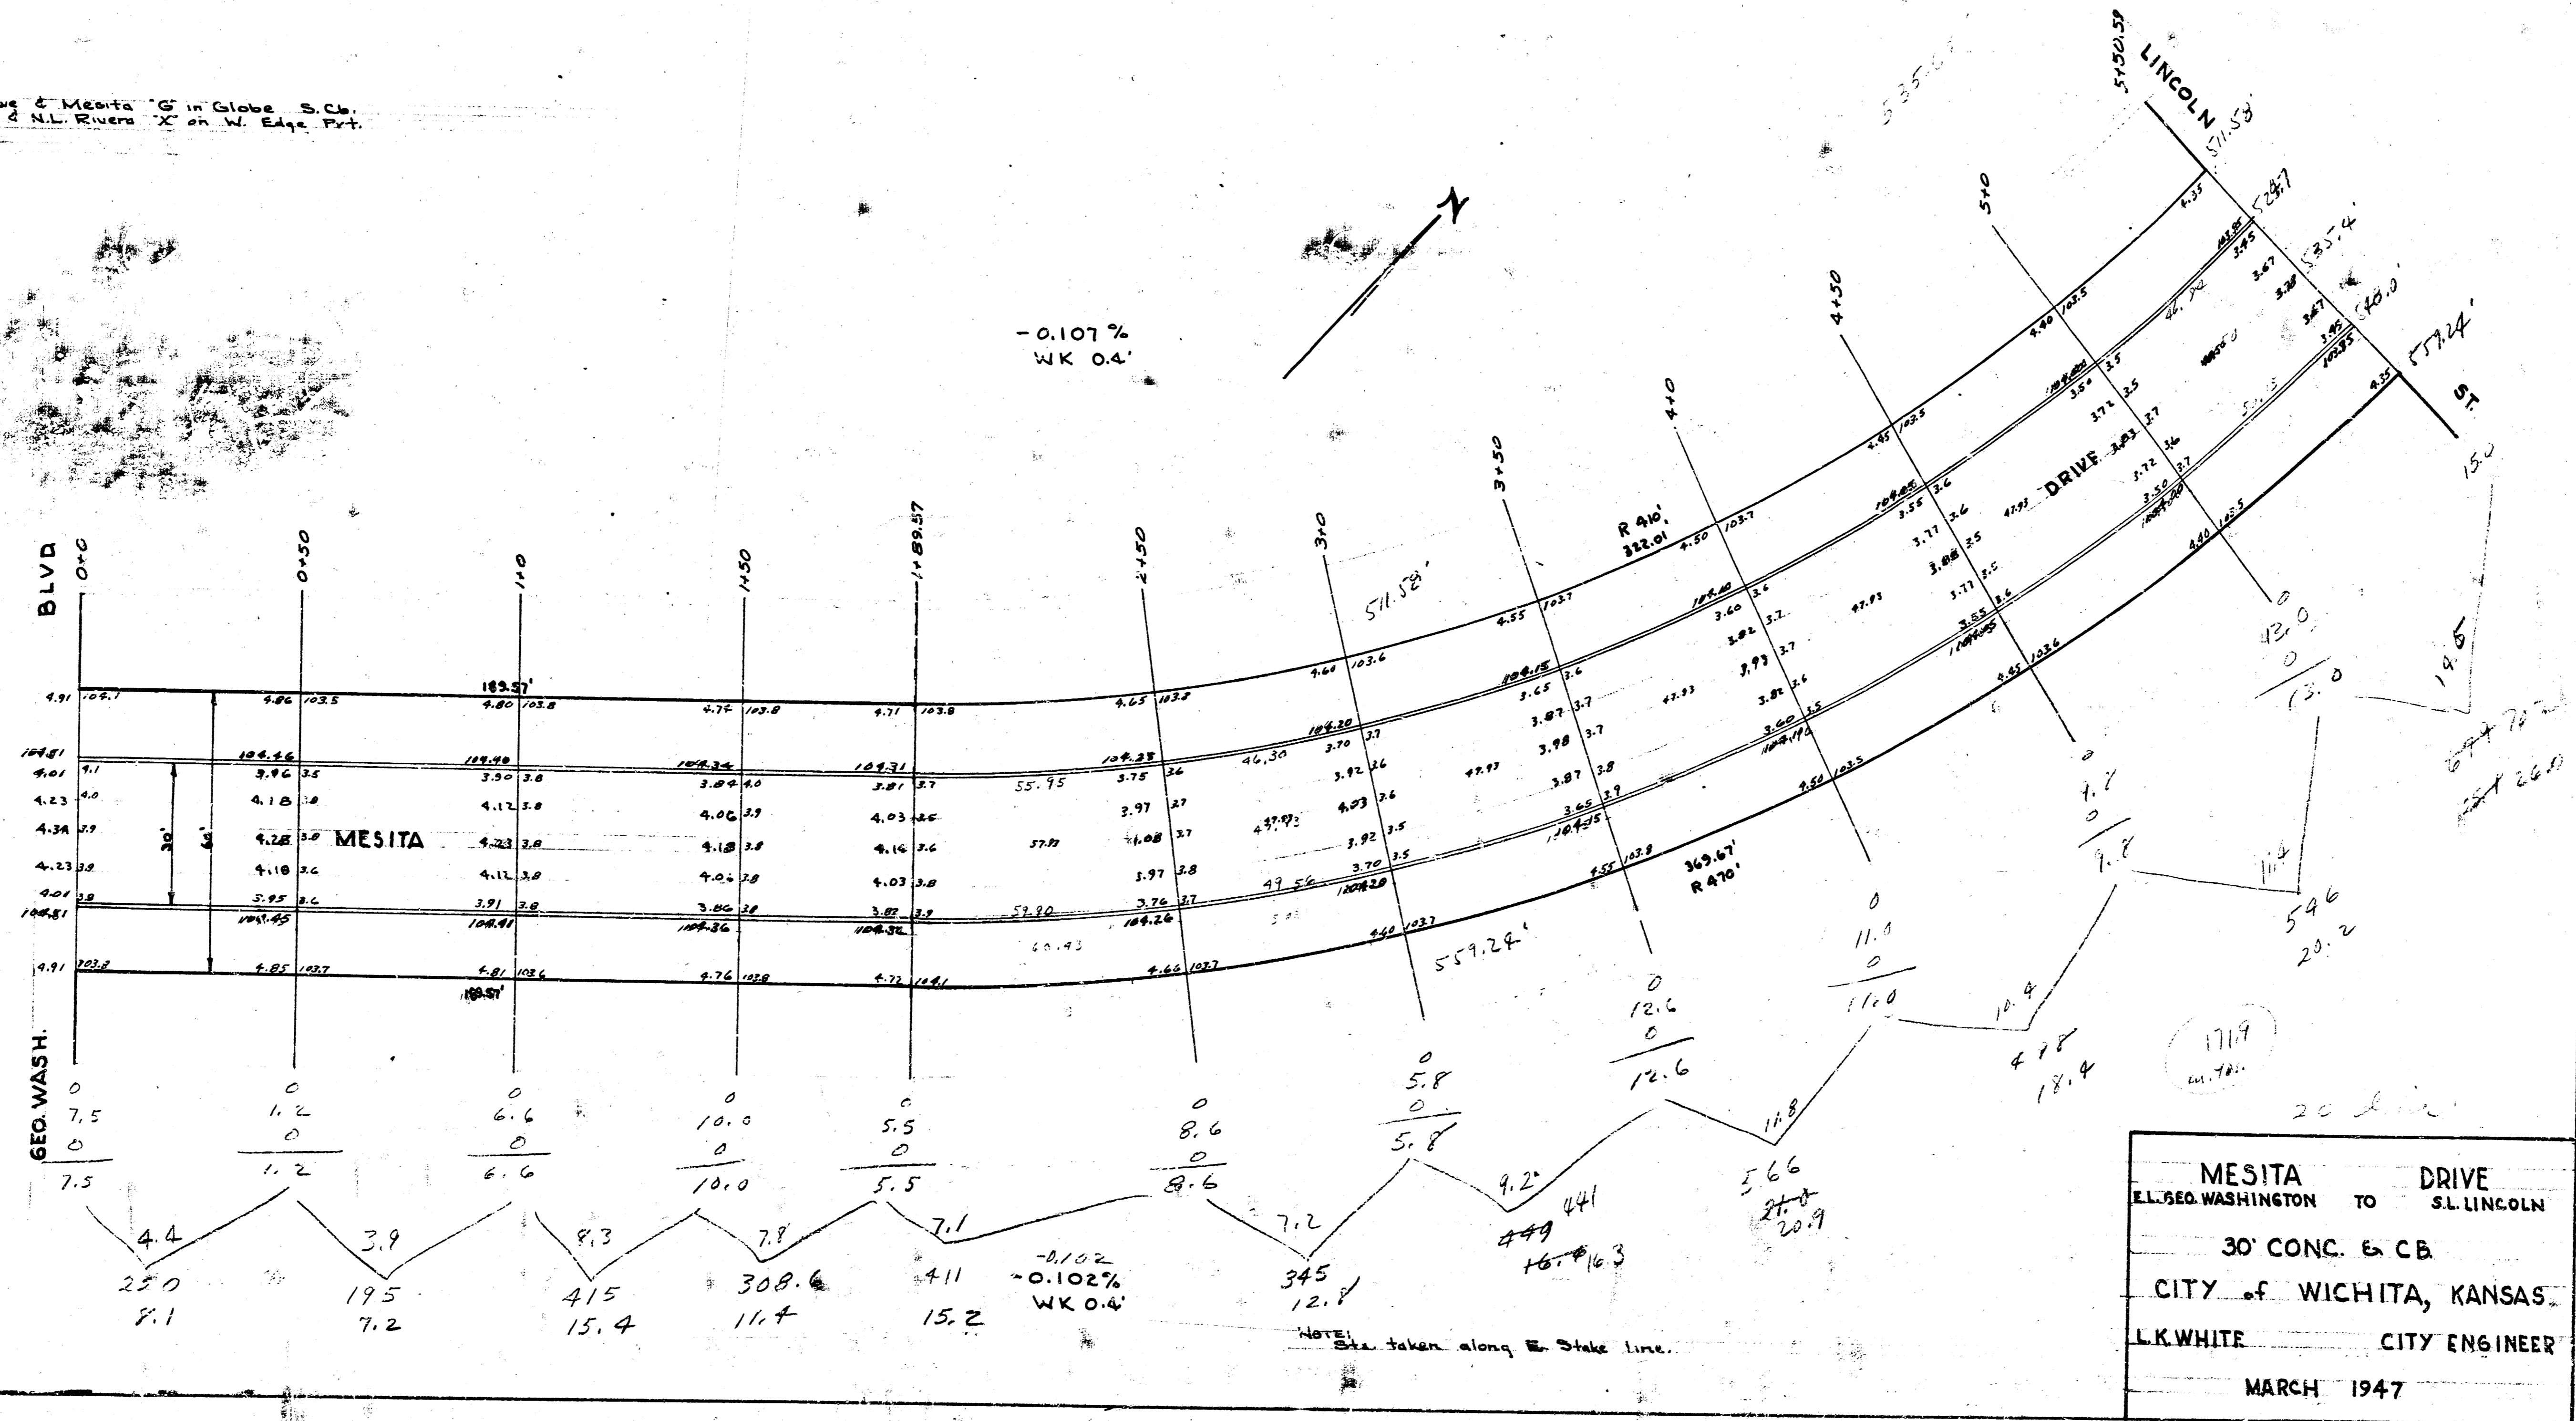

MESITA DRIVE  
 EL. GEO. WASHINGTON TO S.L. LINCOLN  
 30' CONC. & CB  
 CITY OF WICHITA, KANSAS  
 L.K. WHITE CITY ENGINEER  
 MARCH 1947