



B.M. 102 79' 6" in Globe Wcb. Millwood N.L. May.

B.M. 103 45' 0" in Globe E. cb. Millwood N.L. Dora.

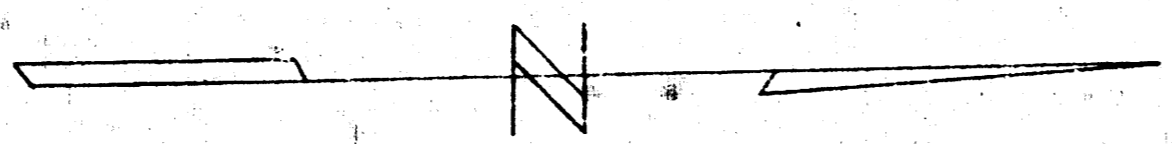


Note: Y.B. Hf. 3. Both sides of Millwood.

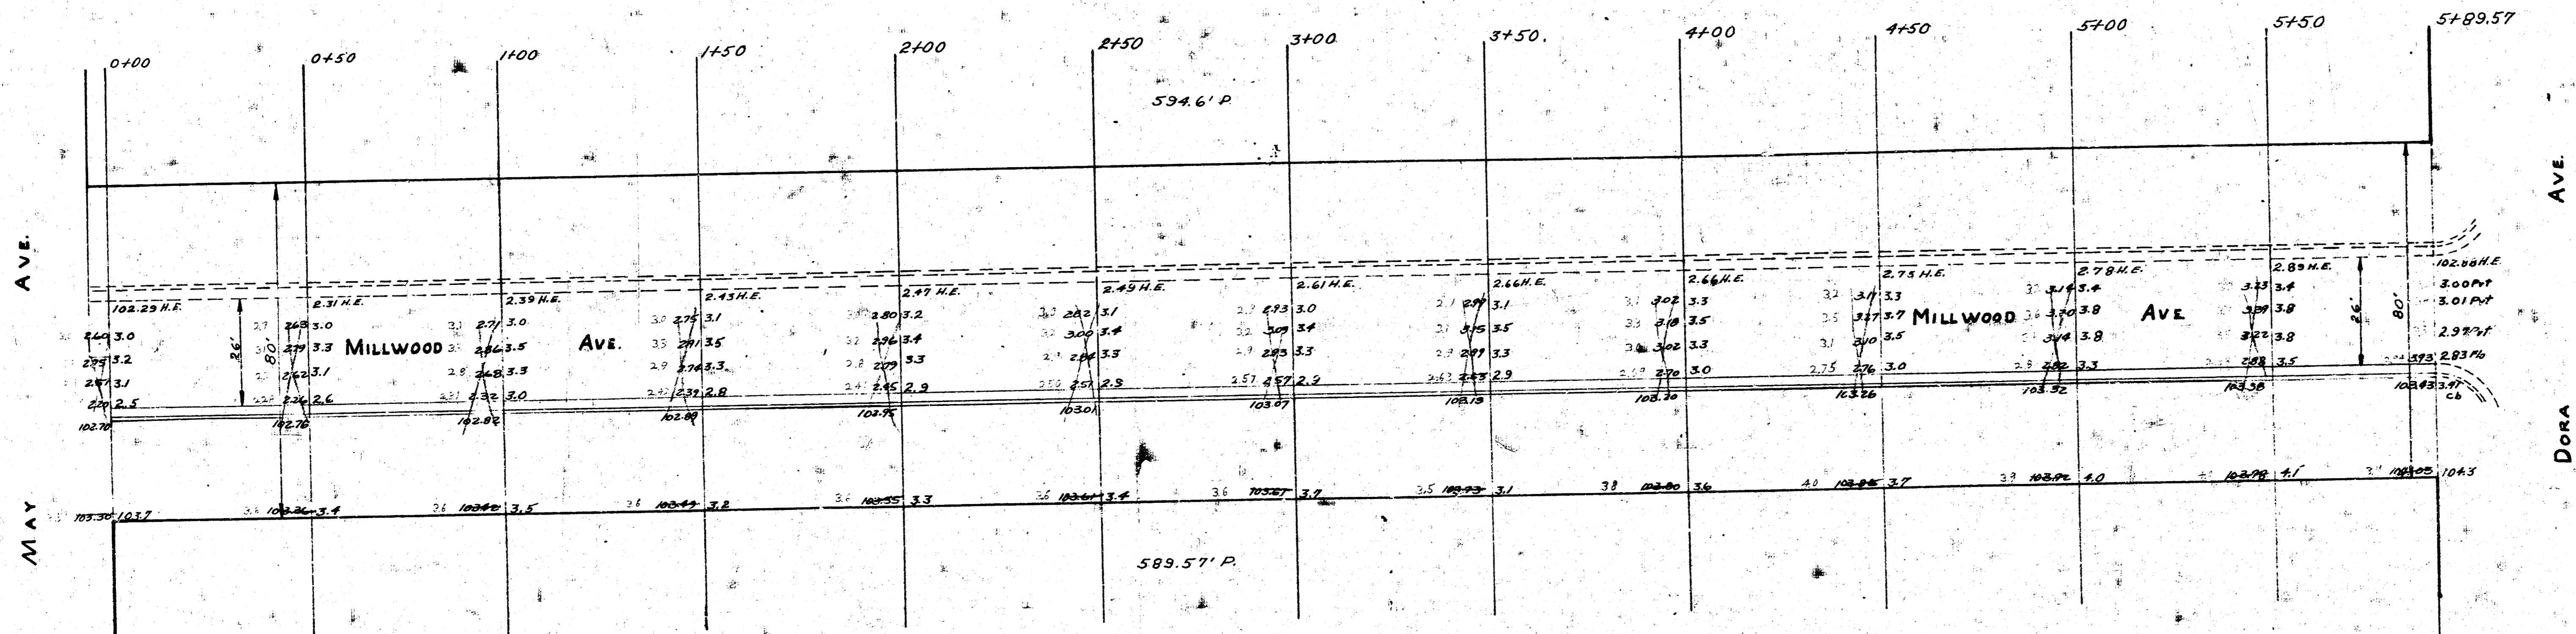

MAY AVE.


DORA AVE.

+0.12%
N.C. 0.6'

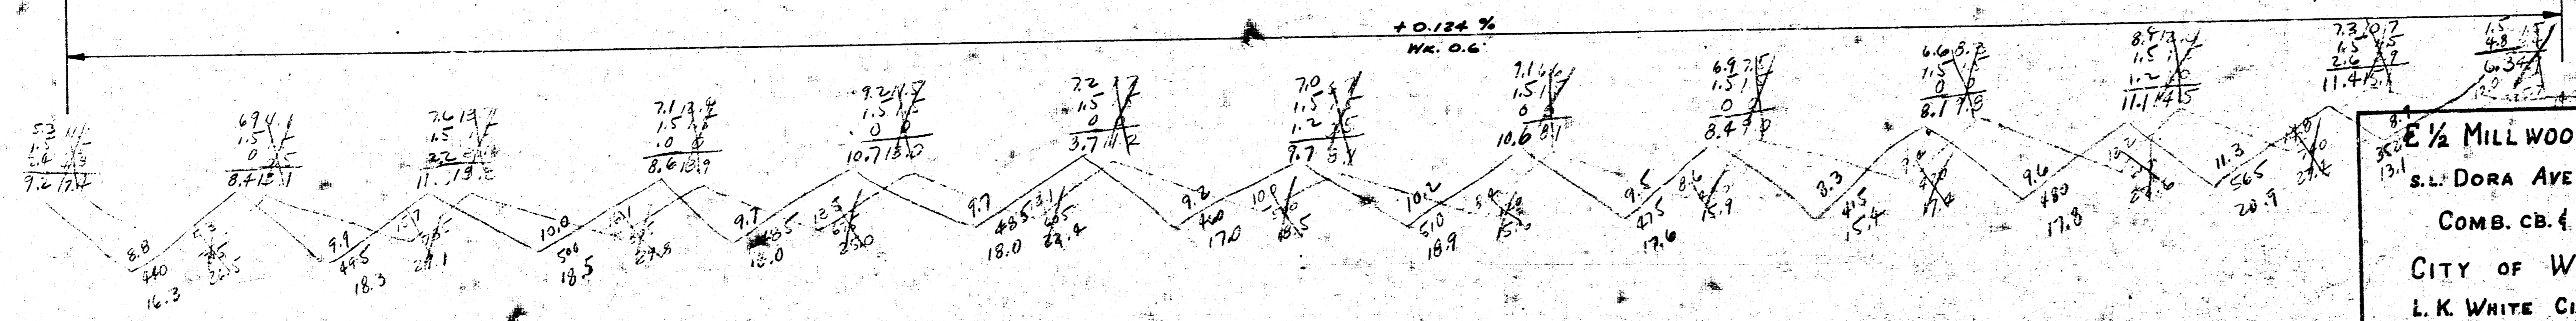

E 1/2 MILLWOOD AVE.
 S.L. DORA AVE - N.L. MAY AVE.
 COMB. CB. & GUTTER
 CITY OF WICHITA, KANSAS
 L. K. WHITE CITY ENGINEER
 APRIL, 1950 PROJECT No. C10-19

B.M. 102.79 "6" in Globe Ncb. Millwood N.L. May.

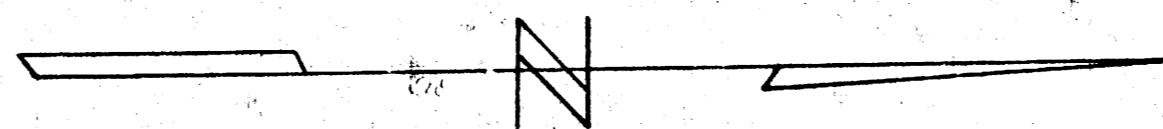

B.M. 103.95 "0" in Globe E.cb. Millwood N.L. Dora.

PROF. 2772

26.7
27.0
27.2
27.5
1941
 N.S. MILLWOOD AVE - N.L. MAY TO S.L. DORA
~~MILLWOOD AVE - S.L. DORA TO S.L. ESTIMER~~
 CB + GTR ONLY

