



MINNEAPOLIS  
S.L. NORTHERN TO N.L. INDUSTRIAL

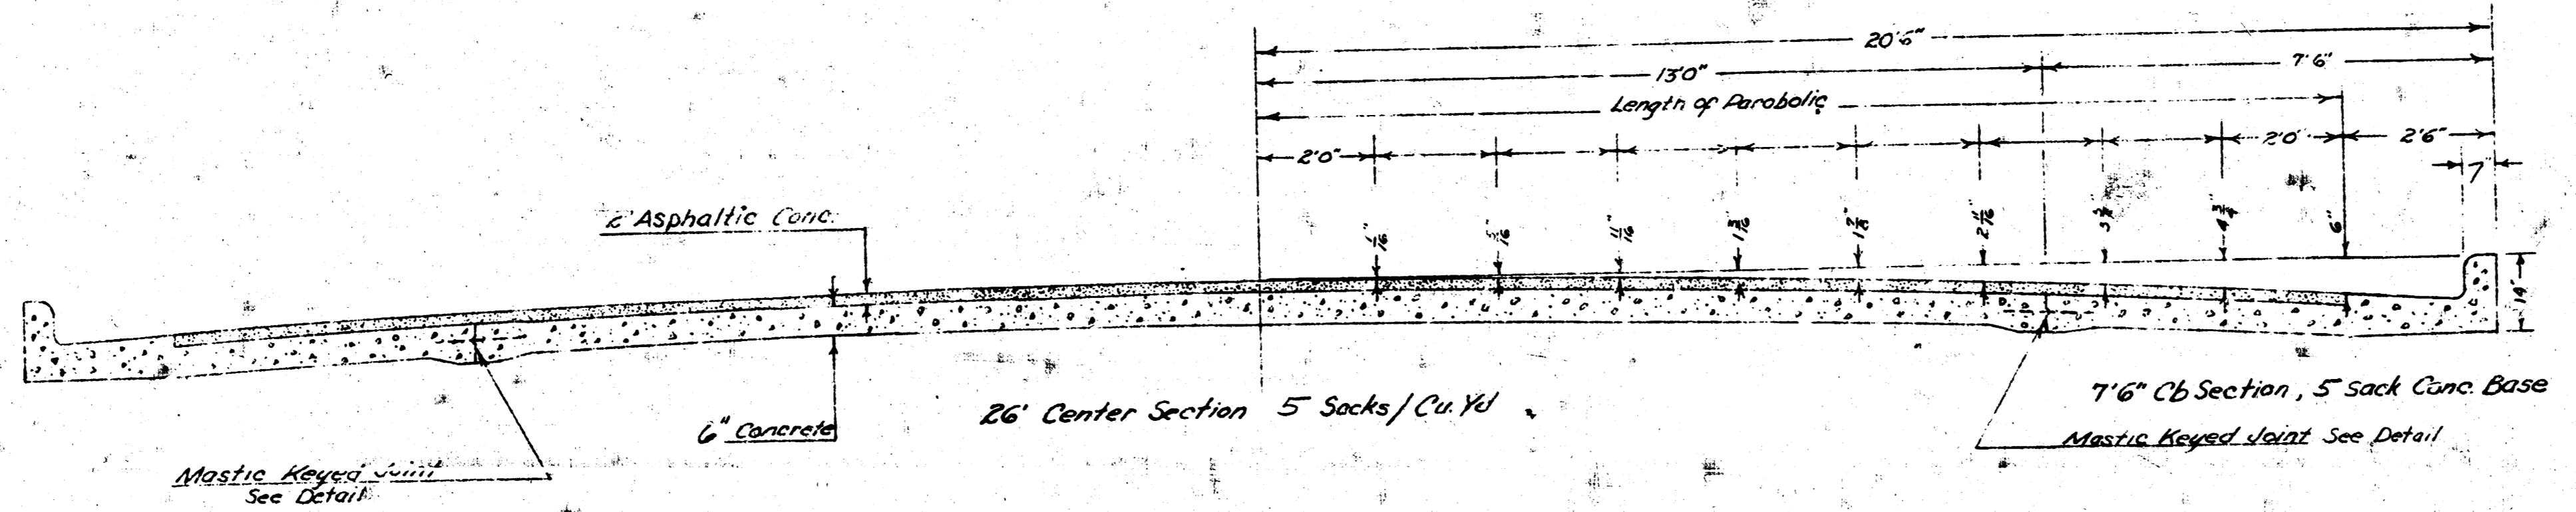


TYPICAL SECTION

Scale  $\frac{1}{2}'' = 1'$

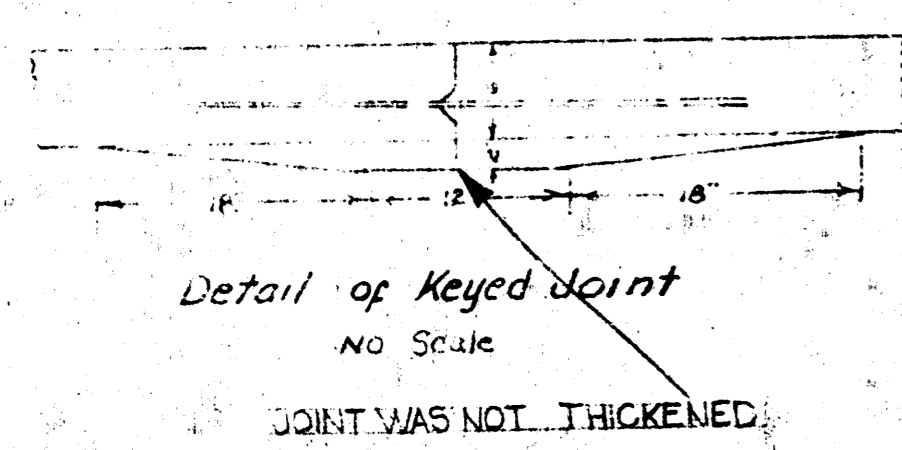


Detail of Keyed Joint  
NO SCALE  
JOINT WAS NOT THICKENED

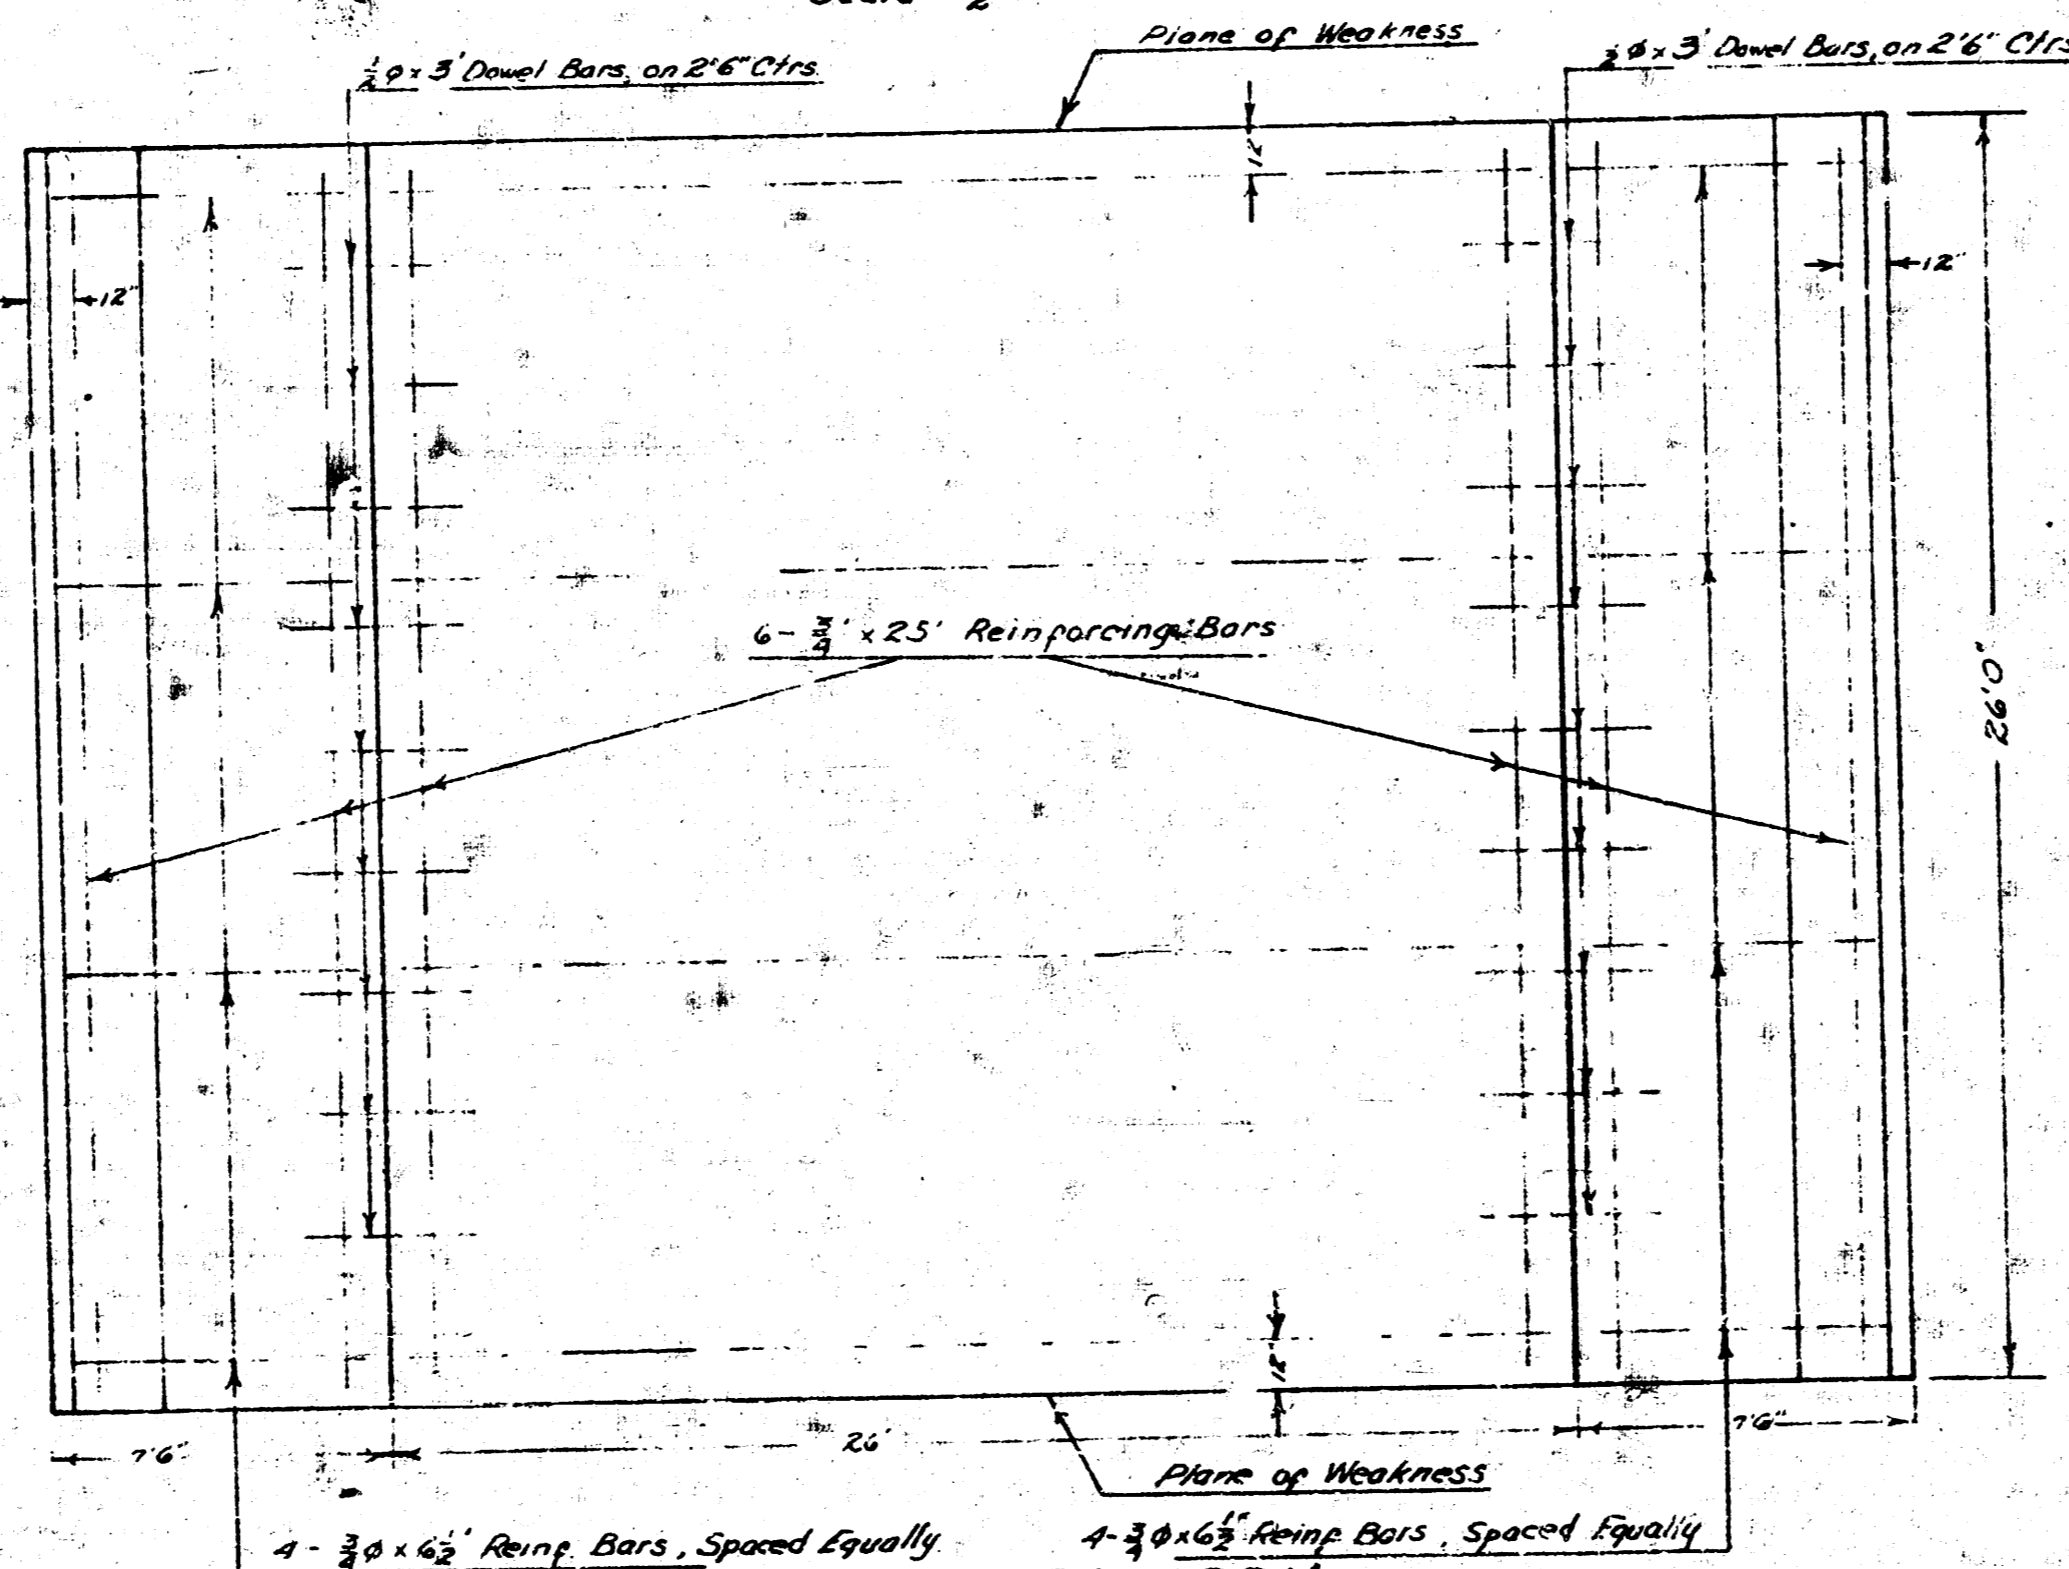

STEEL PATTERN

Scale  $\frac{1}{4}'' = 1'$

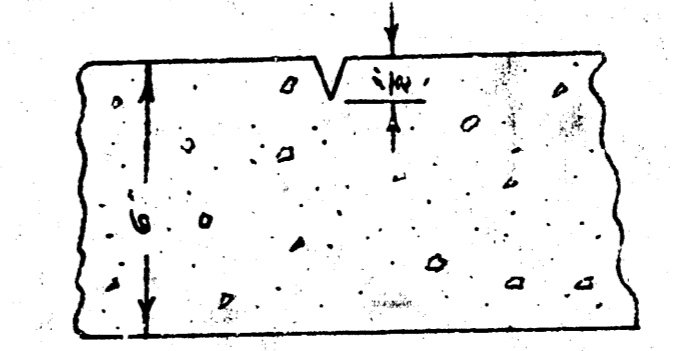




Detail Plane of Weakness  
Plane of Weakness to be cut with  
Double-Edge Groover to Depth as  
Shown in a Straight Line from  
Curb to Curb 20' Ctr. to Ctr.




S-18


185.5  
185.6  
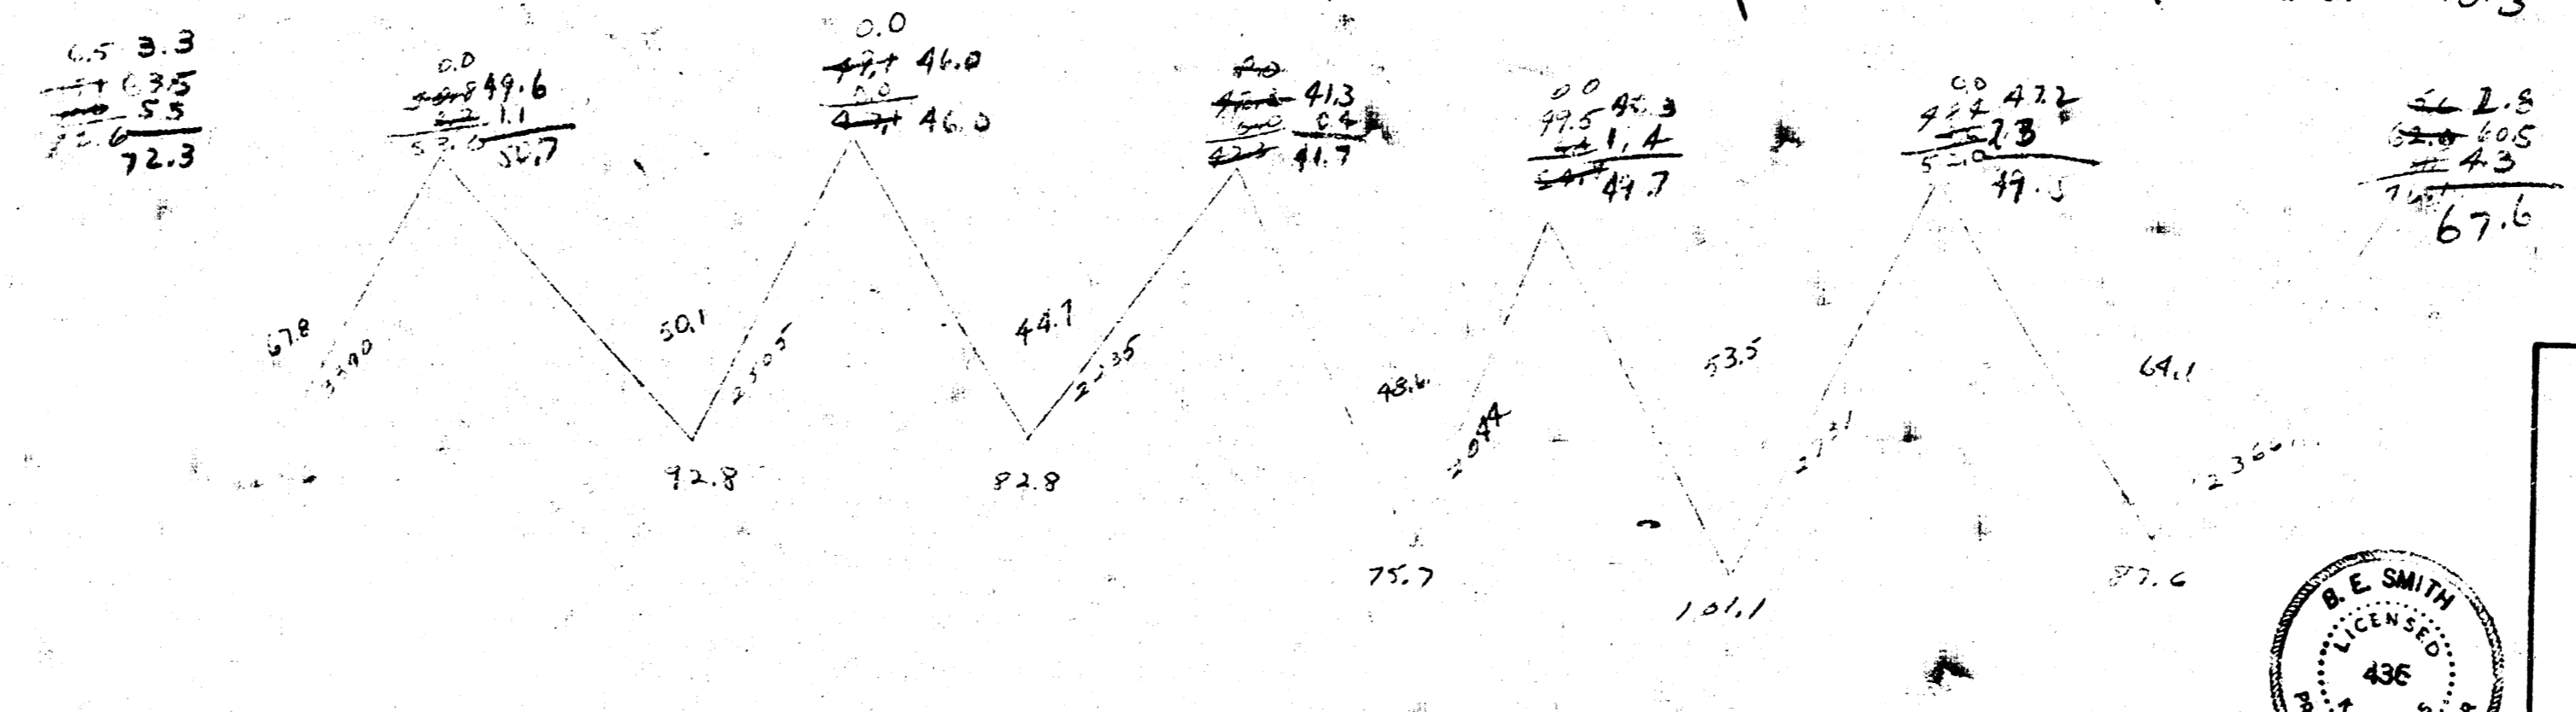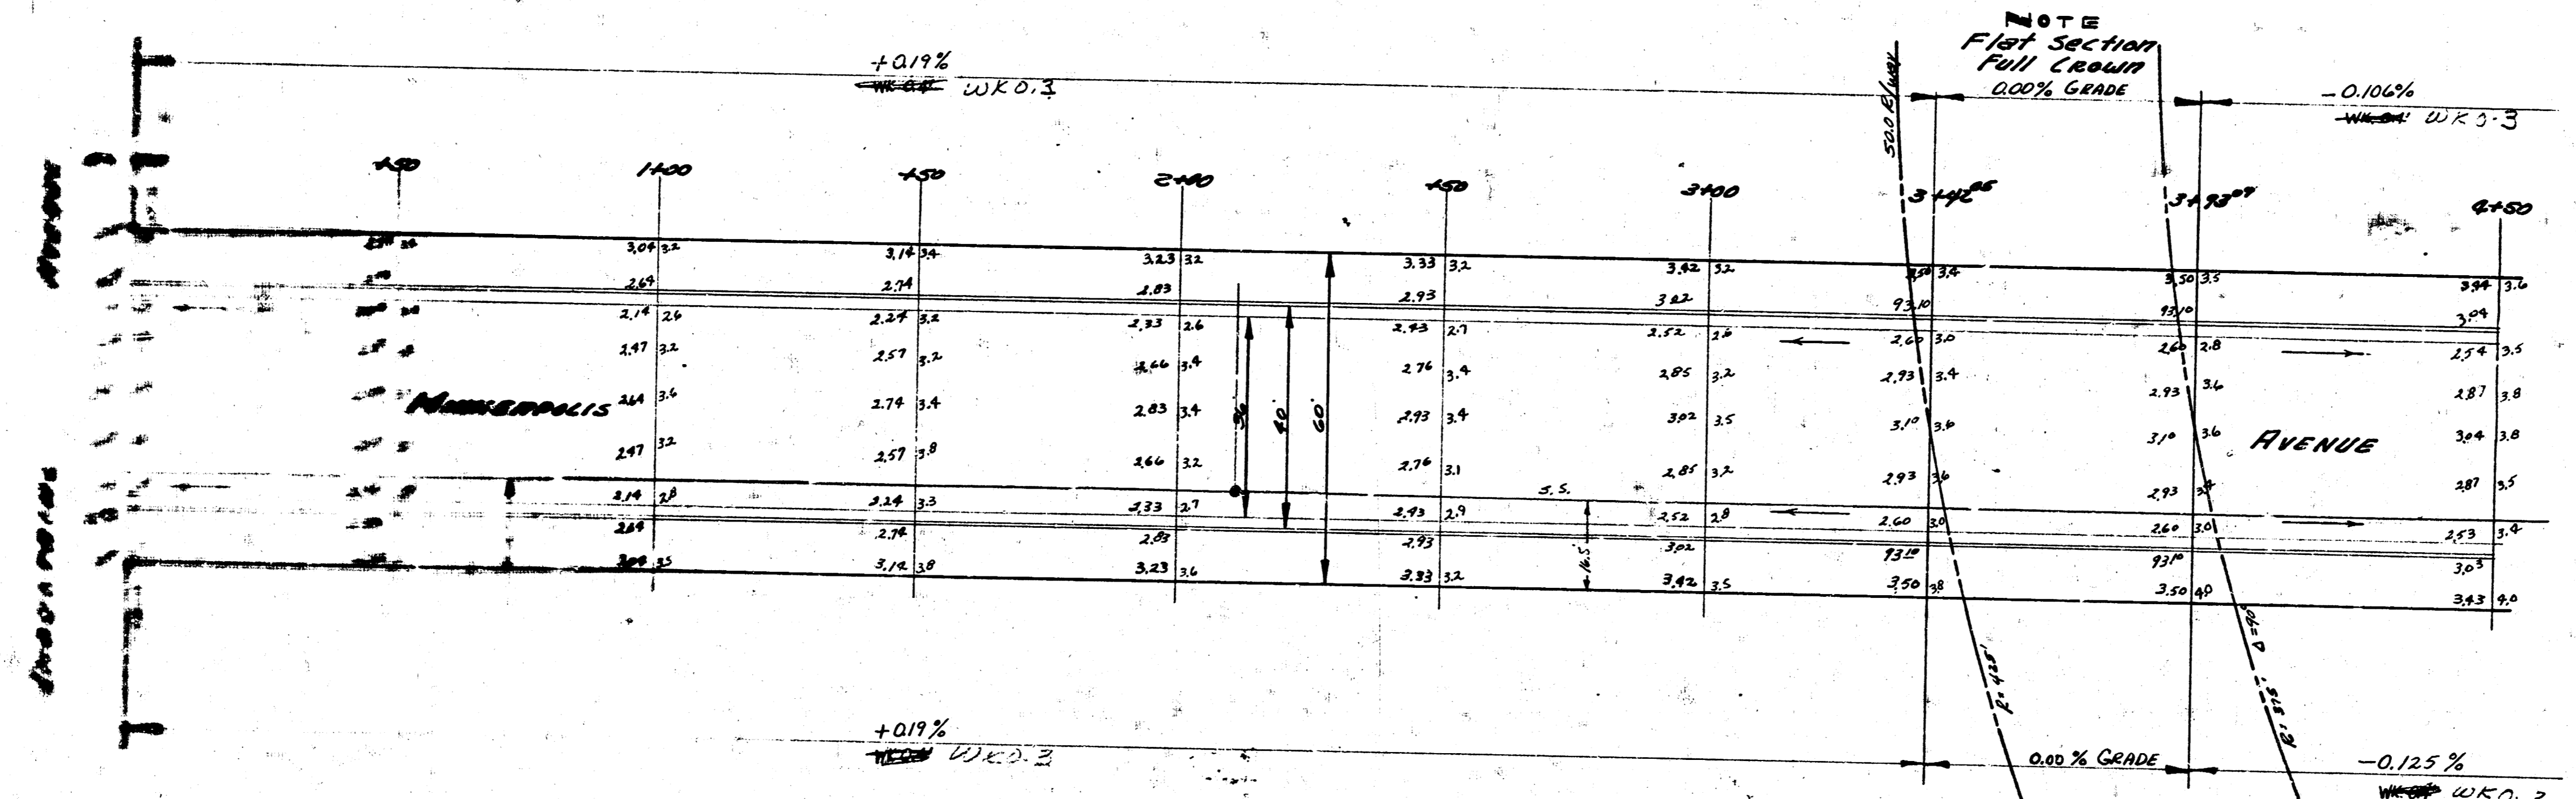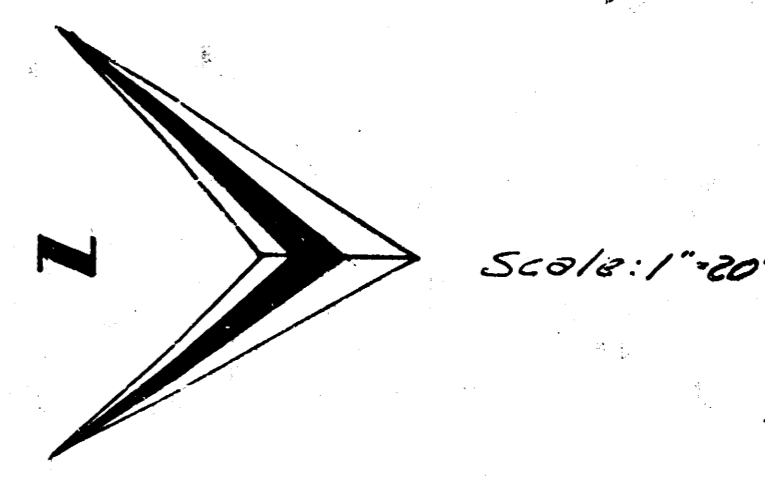

MINNEAPOLIS  
S.L. NORTHERN TO N.L. INDUSTRIAL  
36-2-40 P.C.  
6' BASE  
CITY OF WICHITA, KANSAS  
L. K. WHITE CITY ENGINEER  
AUGUST 1952 Plan No. C12-111

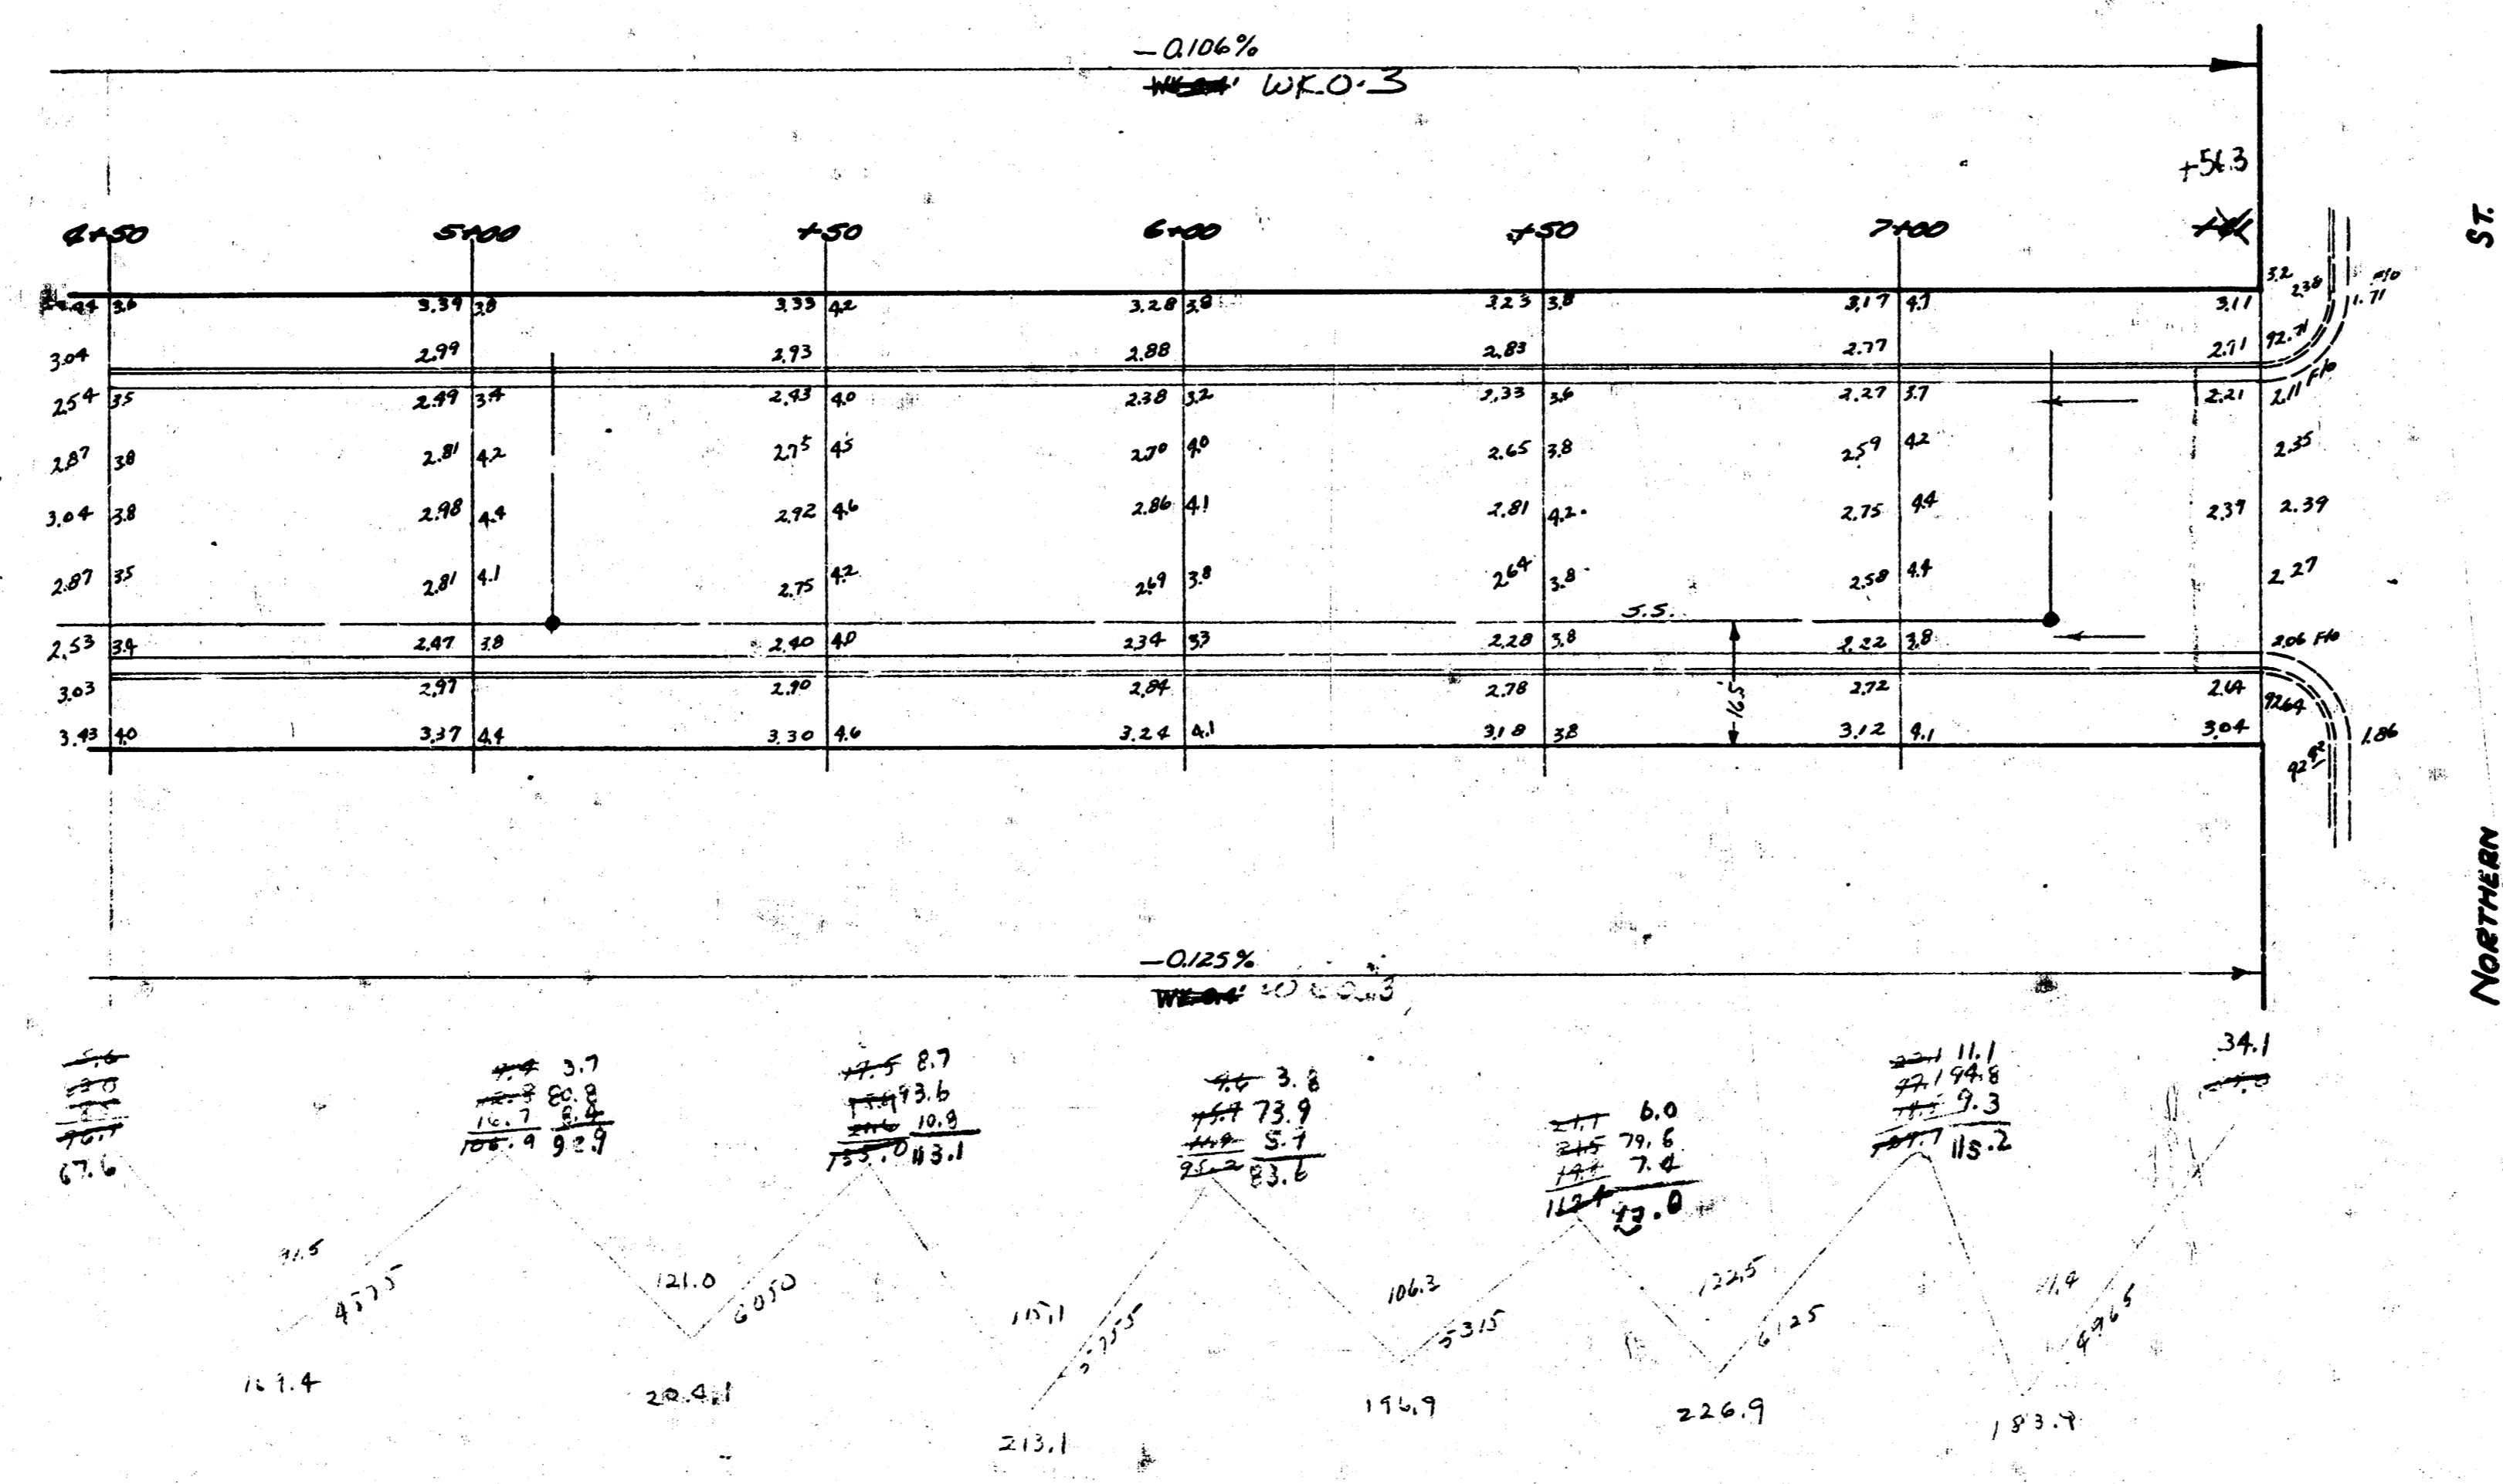

MINNEAPOLIS  
 2  
 2  
 PROJ. No. C-12-113