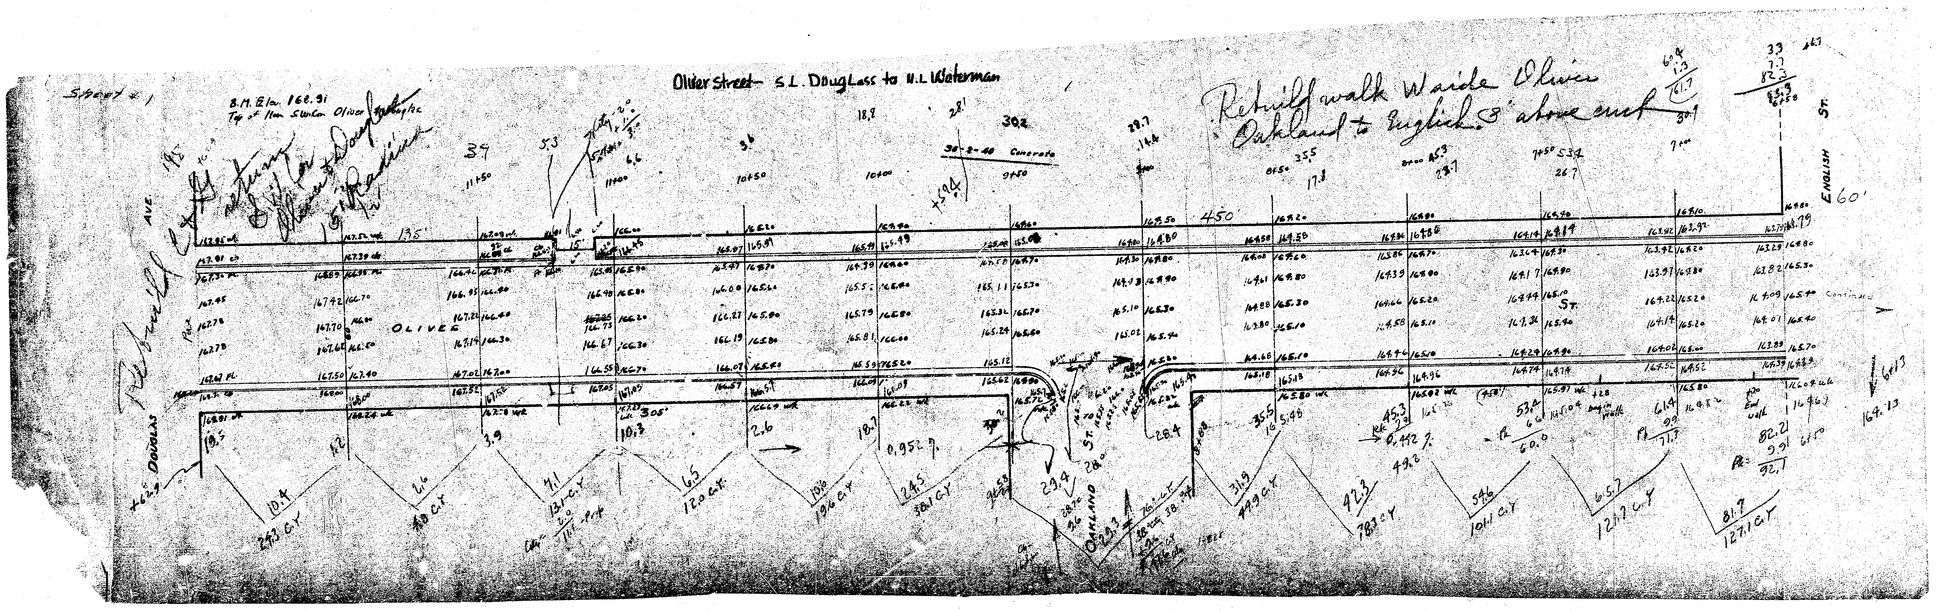
Oliver Street – S.L. Douglass to N.L. Waterman
Rebuild walk W side Oliver Oakland to English 3' above crest
OLIVER
DOUGLAS AVE
OAKLAND
ENGLISH ST.
450'
195'
305'
60'

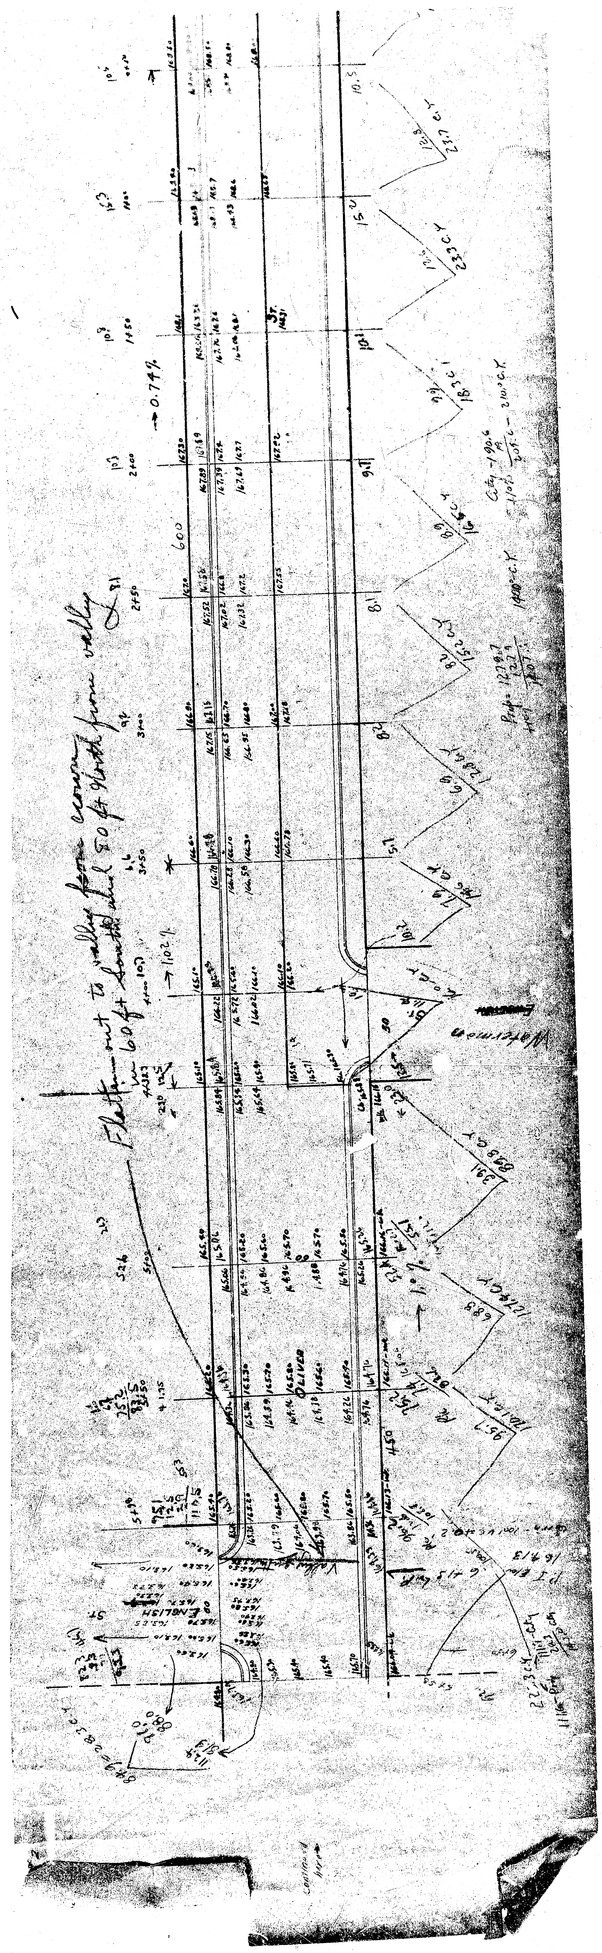
→ 0.74%
600
ENGLISH
OLIVER
1900 c.y.