
B.M. 156.93 "G" IN GLOBE J. Ga. GILBERT W.L. OLIVER

NOTE: STATIONING IS ON ℄

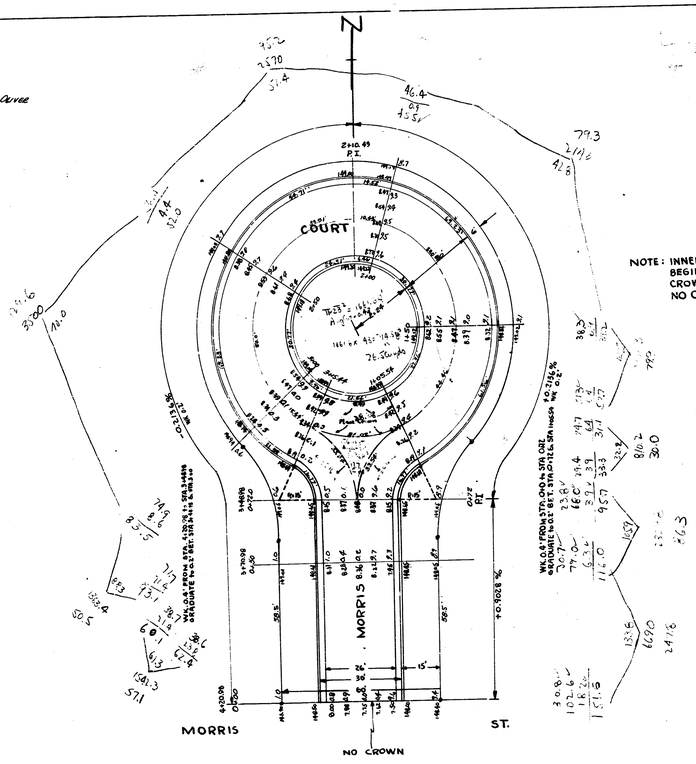

NOTE: INNER CURB IS 0.3' HIGHER THAN OUTER CURB
BEGIN WITH NOCROWN AT 0+0. END FLATTENED
CROWN AT STA. 0+30.
NO CROWN FROM 1+05.54 TO STA. 3+15.44

MORRIS COURT
MORRIS STREET NORTH
26-2-30 A.C.
CITY of WICHITA, KANSAS
L.K. WHITE CITY ENGINEER
APRIL 1949 PROJ. NO. C19-58