
B.M. 1603 S.E. COR. STEP HO.# 755 SO. CRESTWAY

B.M. 102.62 "G" IN GLOBE SO. END S.W. RET. MORRIS & TERRACE DR.

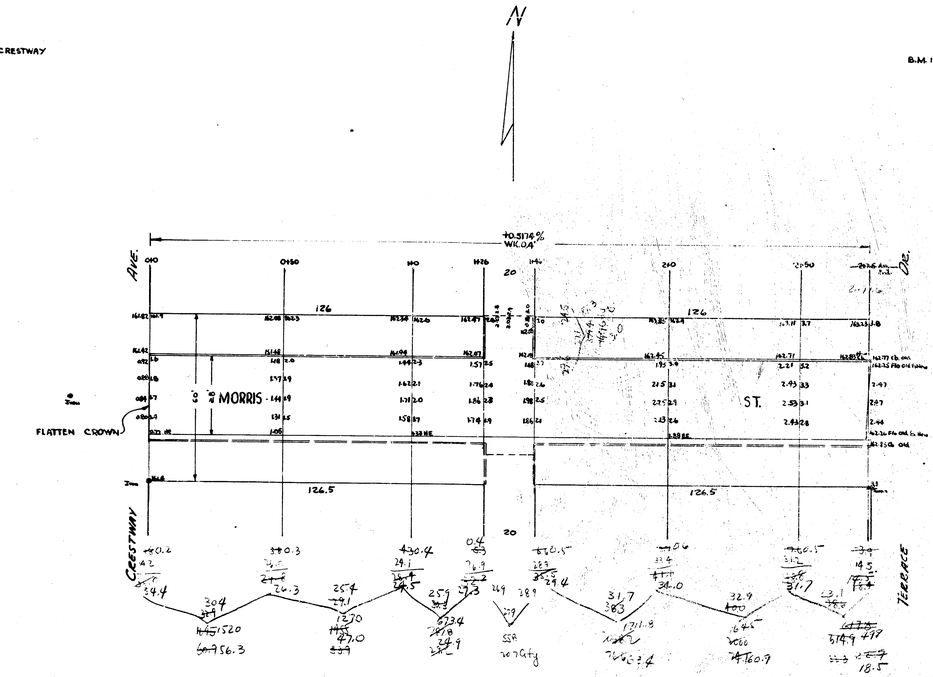

MORRIS ST.
E.L. CRESTWAY TO W.L. TERRACE DR.
28' CONC. & CB. N.S.
CITY OF WICHITA, KANSAS
L.K. WHITE CITY ENGINEER
4-14-49 PROJ. C19-51

4 12 2 8