


B.M. 163.03 S.E. COR. STEP HO # 755 SO. CRESTWAY

B.M. 162.62 "G" IN GLOBE SO. END S.W. RET. MORRIS & TERRACE DR.

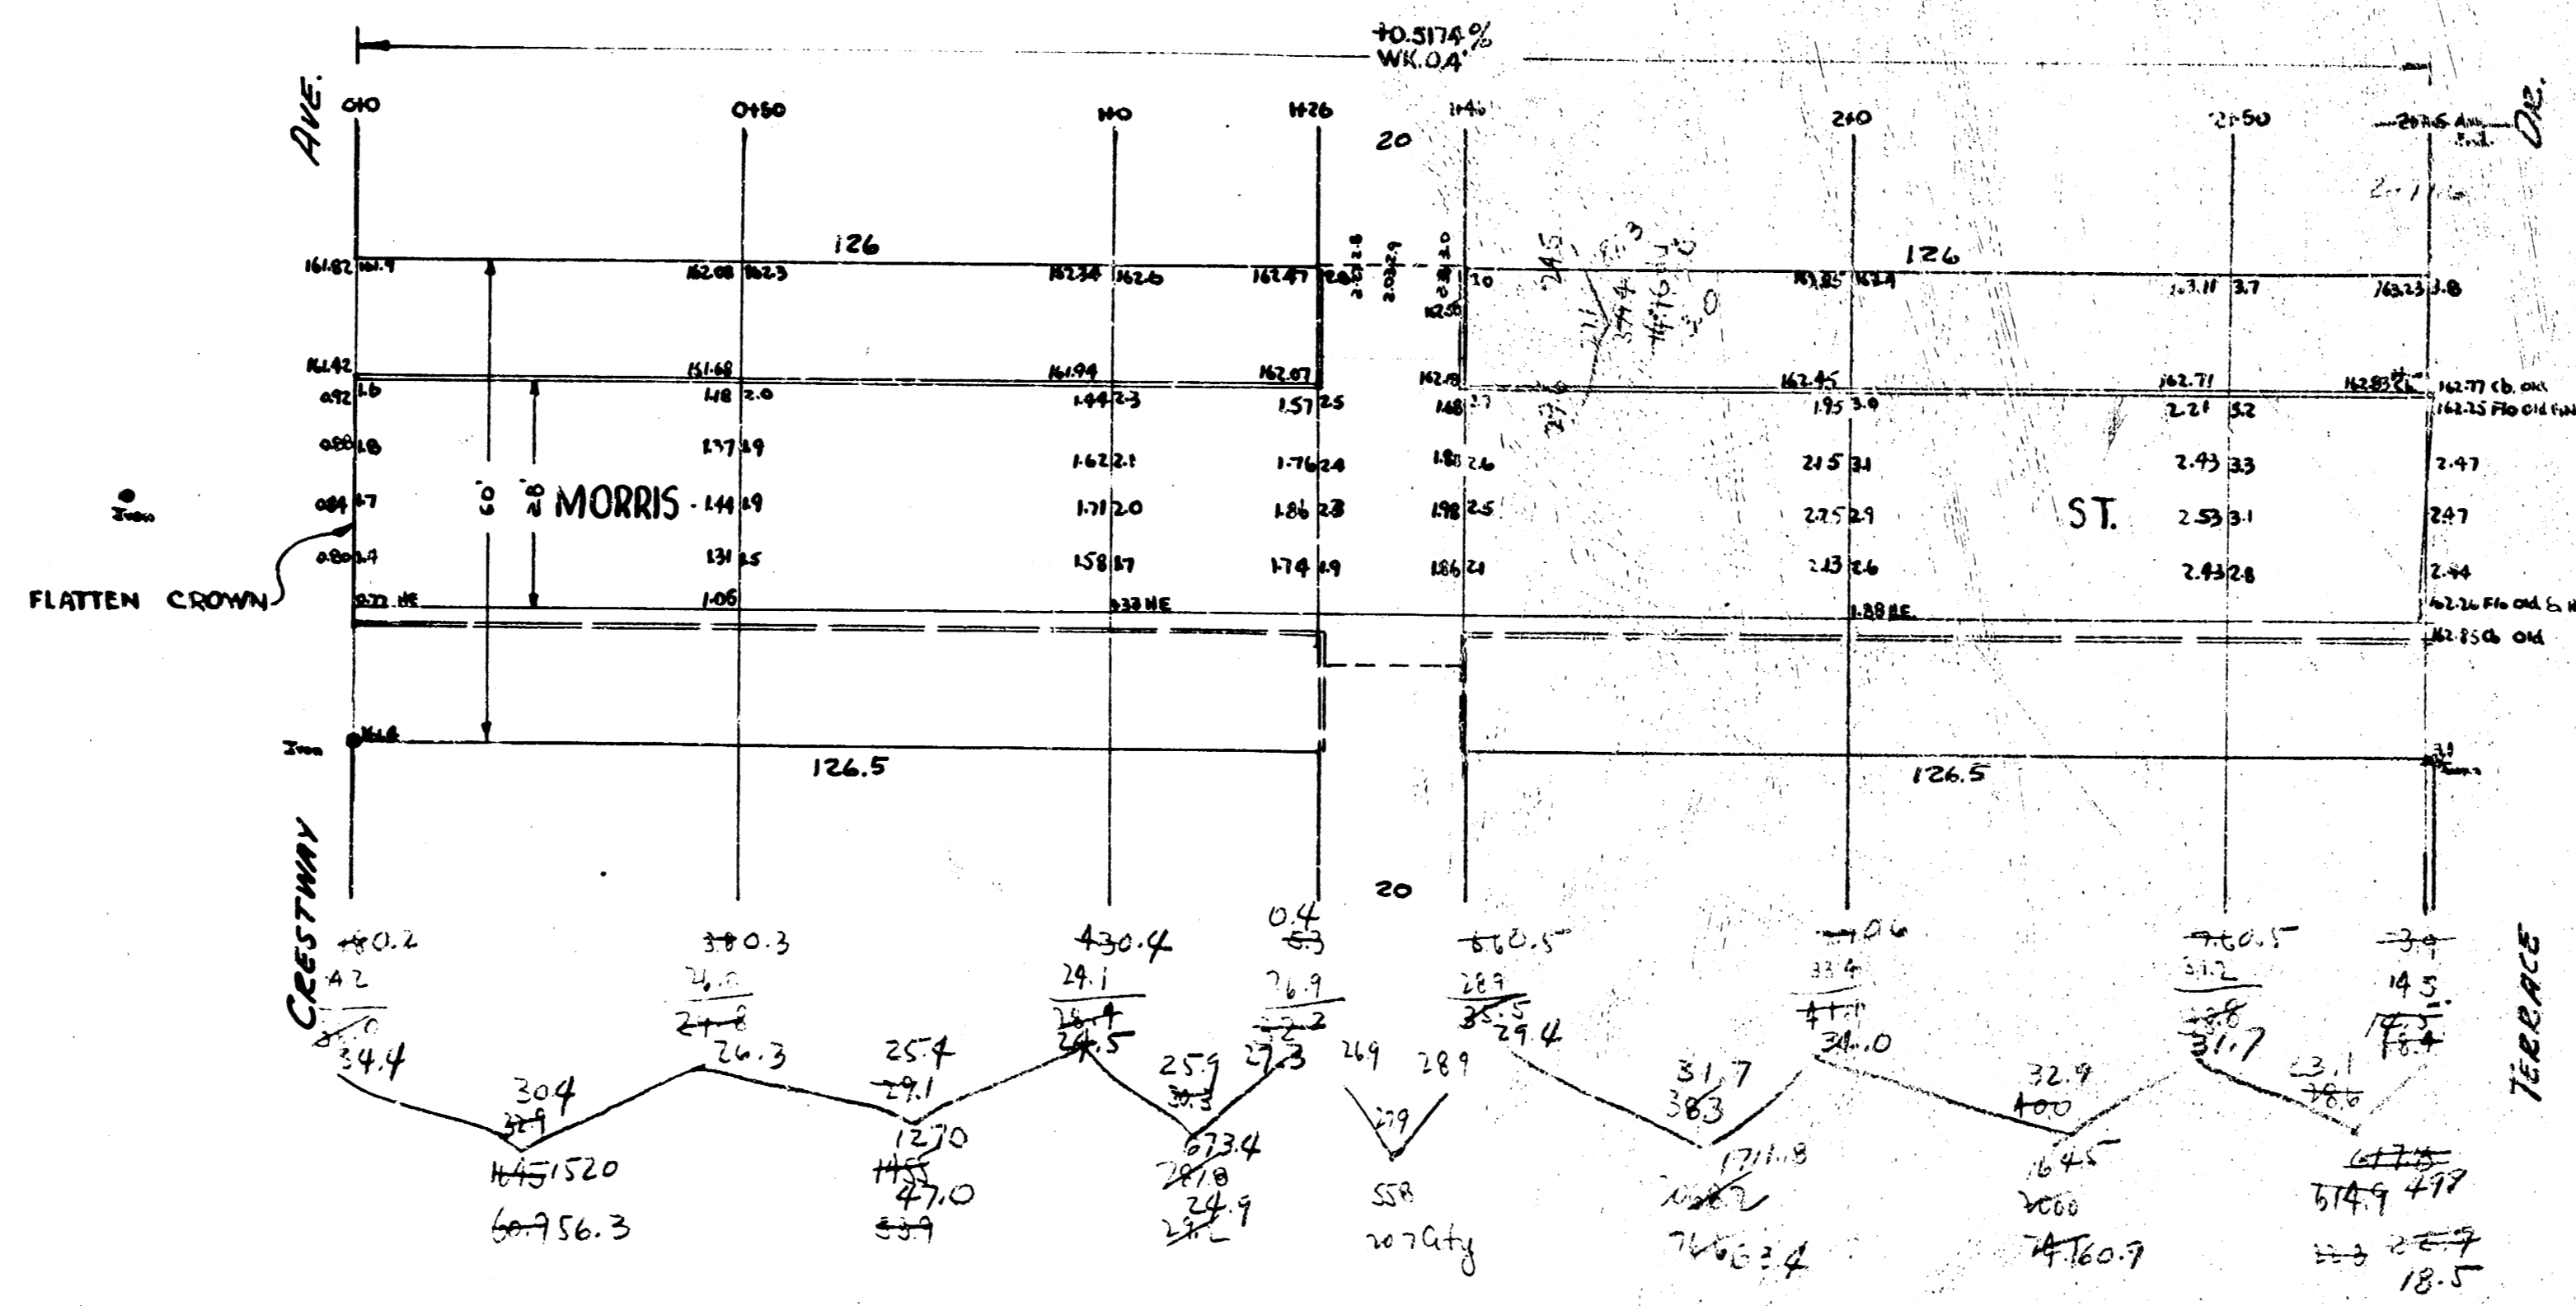

MORRIS ST.
E. L. CRESTWAY TO W. TERRACE DR.
28' CONC. & C&G. N.S.
CITY OF WICHITA, KANSAS
L. K. WHITE CITY ENGINEER
4-14-49 PROJ. C19-51