B.M. 1673.7' T in TROY TOP F.HYD. N.W. COR. PERSHING & MORRIS

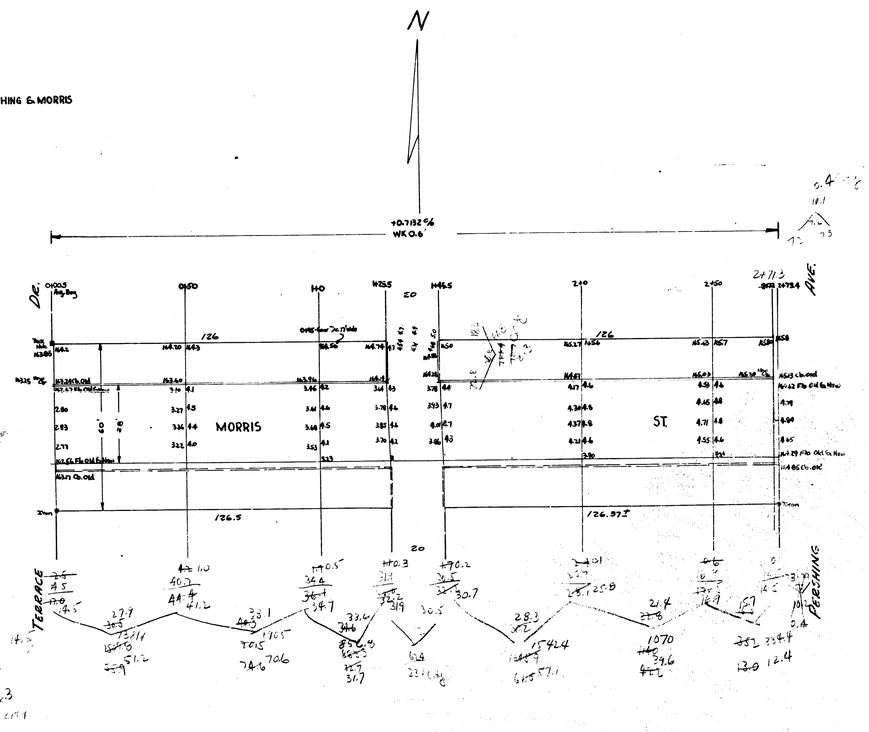

MORRIS ST.
E.L. TERRACE DR. TO W.L. PERSHING
28' CONC. & CB. N.S.
CITY OF WICHITA, KANSAS
L.K. WHITE CITY ENGINEER
4-14-49 PROJ. C19-50