
B.M. 167.37' T in TROY TOP F. HYD. N.W. COR. PERSHING & MORRIS

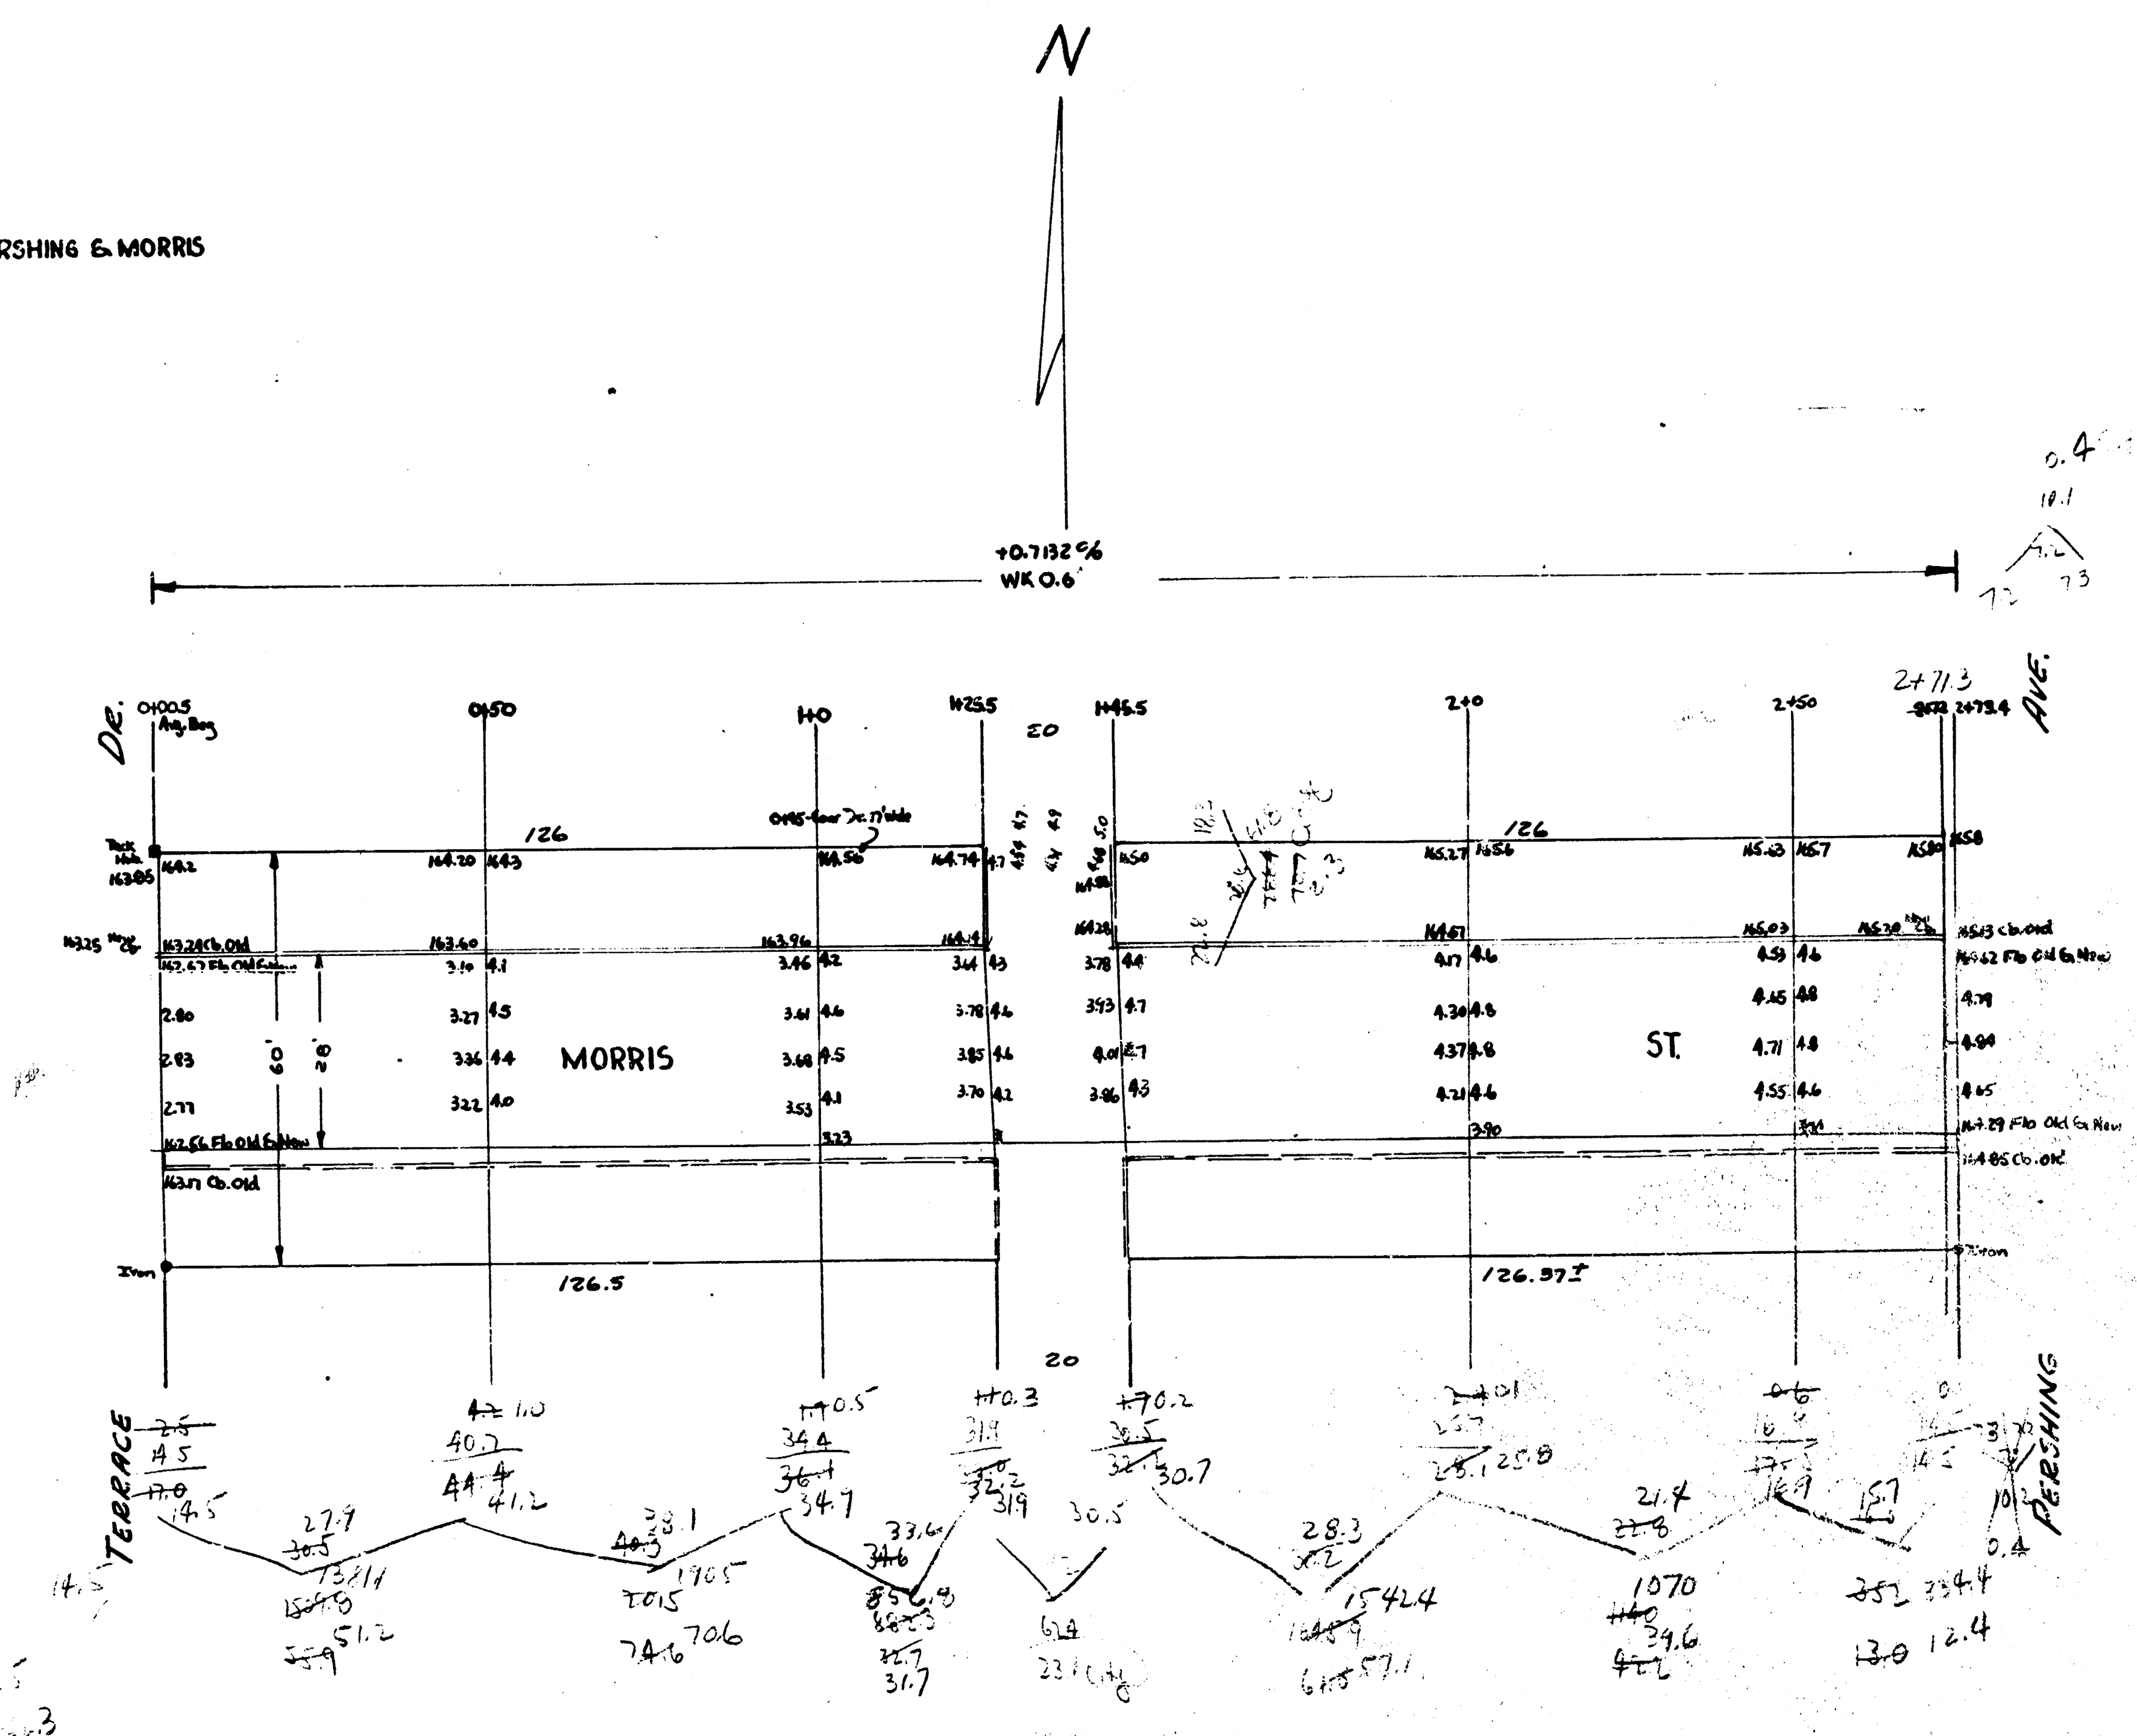

MORRIS ST.

E.L. TERRACE DR. TO W.L. PERSHING

28' CONC. & CB. N.S.

CITY OF WICHITA, KANSAS

L.K. WHITE CITY ENGINEER

4-14-49 PROJ. C19-50

4 12 3 8