B.M. 104.35 "G" in Globe E end Rod E.L. Kansas f S.B. Morris

B.M. 104.29 "G" in Globe and Radius W.L. Minneapolis f S.B. Morris


NOTE: STATIONED ON CENTER LINE

DEFLECTIONS

0+00	0°	00' 00"
0+78	4°	03' 00"
1+00	5°	07' 24"
1+25	5°	11' 42"
1+30	4°	10' 32"

PROPERTY

96.9
127.0
91.1
61.5
25.1
401.6
40.2 +10%
441.8 Total Cu Yds Excavation

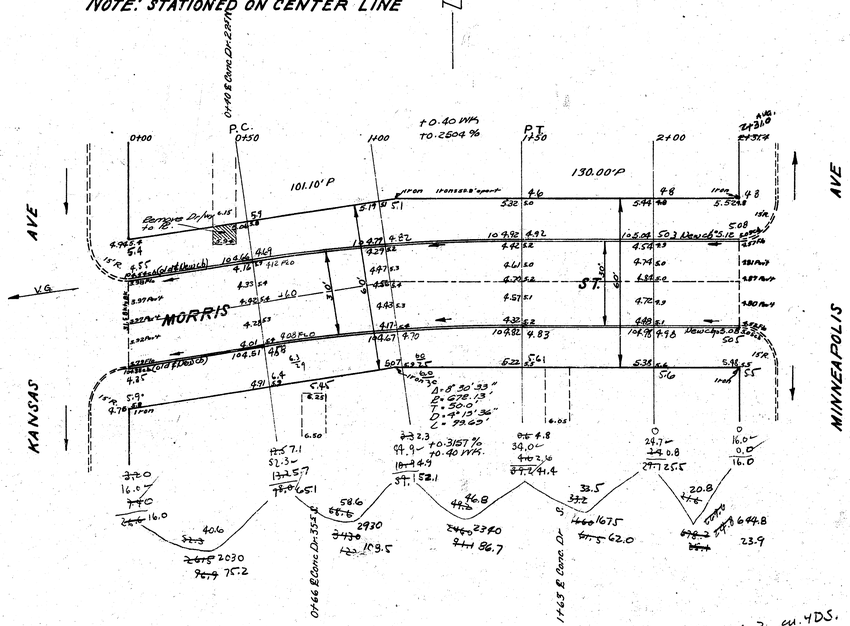

356.3 cu. YDS.

10 dr

MORRIS ST.
E.L. KANSAS AVE. W.L. MINNEAPOLIS
30' CONC. & C.B.
CITY OF WICHITA, KANSAS
L.K. WHITE CITY ENGINEER
JANUARY 19, 1951 PROJ. NO. C10205

L.K. WHITE LICENSED KANSAS PROFESSIONAL ENGINEER 55